

Exam Date:09/13/2010

Engstrom Bean and Seed, Inc.

Page: 1

Examiner: 2

6131 57th Ave NE

Leeds , ND

County:

Phone: 701-466-2398

CCC Number:

Location/Container Numbers/Comments	Section	Capacity
PART A - ADDITIONAL SPACE TO BE INCLUDED UNDER LICENSE		
020	A	55,061
001	G	32,962
019	A	55,061
025	A	49,348
002	G	32,962
103	A-P	3,933
104	A-P	3,933
004	M	9,390
005	M	9,390
007	M	46,242
301	T	8,058
302	T	8,058
303	T	8,058
304	T	8,058
001	T	29,757
		Total:
		360,271

PART B - SPACE TO BE DELETED UNDER LICENSE

024	A	49,348
003	G	38,721
004	G	38,721
005	G	56,322
006	G	56,322
200	E	6,517
201	E	2,910
202	E	2,910
203	E	2,910
204	E	2,910
205	E	2,910
206	E	2,910
207	E	2,910
208	E	6,256
209	E	6,190
210	E	2,910
211	E	2,910
212	E	2,910
213	E	2,910
214	E	2,910
215	E	2,910
216	E	2,910
217	E	2,910
218	E	2,510

Location/Container Numbers/Comments	Section	Capacity
219	E	12,909
220	E	24,670
221	E	24,670
222	E	10,346
Total:		377,152

PART C - ALL SPACE TO BE INCLUDED UNDER LICENSE

A	655,000
A-P	336,000
B	10,000
B-P	9,000
G	66,000
M	66,000
T	62,000
Total:	1,204,000

PART D - TOTAL CAPACITY BY FUNCTIONAL UNIT

Cando 1106	G	66,000
Grace City 1002	T	62,000
Leeds 1076	A B	665,000
Maddock 1001	M	66,000
Petersburg 1163	A-P B-P	345,000
Total:		1,204,000

Client ID: 2586

NDPSC Bin Capacity Chart

09/13/2010 04:00:04 PM

Exam Date:09/13/2010

Engstrom Bean and Seed, Inc.
6131 57th Ave NE
Leeds , ND
County:

Page: 1

Examiner: 2

Status	Section	Bin Number	Bin Type	Base Point	Diameter or Bu/Ft (Irreg.)	Length	Width	Side wall	Add for Hopper	Ded. for Obst.	Effective Depth	Add for Peak	Depth for Capac.	Bushels per Foot	Base Pack%	Bushel Capacity with Pack
--------	---------	------------	----------	------------	-------------------------------	--------	-------	--------------	----------------------	----------------------	--------------------	--------------------	------------------------	------------------------	---------------	------------------------------

Facility: Cando

Section: G

Added	G	001	Peaked	top of sidewall	48.000	0.000	0.000	17.20	0.00	0.00	17.200	3.400	20.6	1454.6	10.0	32,962
Added	G	002	Peaked	top of sidewall	48.000	0.000	0.000	17.20	0.00	0.00	17.200	3.400	20.6	1454.6	10.0	32,962

Bin count: 2

Facility: Cando Section: G Total: 65,924

To Even: 66,000

Client ID: 2586

NDPSC Bin Capacity Chart

09/13/2010 04:00:08 PM

Exam Date:09/13/2010

Engstrom Bean and Seed, Inc.

Page: 2

Examiner: 2

6131 57th Ave NE

Leeds , ND

County:

Status	Section	Bin Number	Bin Type	Base Point	Diameter or Bu/Ft (Irreg).		Side wall	Add for Hopper	Ded. for Obst.	Effective Depth	Add for Peak	Depth for Capac.	Bushels per Foot	Base Pack%	Bushel Capacity with Pack
					Length	Width									

Facility: Grace City**Section: T**

Added	T	001	Quonset	top of sidewall	0.000	51.00	83.00	8.000	0.00	0.00	8.000	0.000	8.0	3381.5	10.0	29,757
Added	T	301	Peaked	top of sidewall	21.000	0.000	0.000	23.00	2.80	0.00	25.800	1.300	27.1	278.4	6.80	8,058
Added	T	302	Peaked	top of sidewall	21.000	0.000	0.000	23.00	2.80	0.00	25.800	1.300	27.1	278.4	6.80	8,058
Added	T	303	Peaked	top of sidewall	21.000	0.000	0.000	23.00	2.80	0.00	25.800	1.300	27.1	278.4	6.80	8,058
Added	T	304	Peaked	top of sidewall	21.000	0.000	0.000	23.00	2.80	0.00	25.800	1.300	27.1	278.4	6.80	8,058

Bin count: 5**Facility: Grace City Section: T Total: 61,989****To Even: 62,000**

Exam Date:09/13/2010

Engstrom Bean and Seed, Inc.

Page: 3

Examiner: 2

6131 57th Ave NE

Leeds , ND

County:

Status	Section	Bin Number	Bin Type	Base Point	Diameter or Bu/Ft (Irreg).		Side wall	Add for Hopper	Ded. for Obst.	Effective Depth	Add for Peak	Depth for Capac.	Bushels per Foot	Base Pack%	Bushel Capacity with Pack
					Length	Width									

Facility: Leeds

Section: A

	A	001	Peaked	top of sidewall	16.000	0.000	0.000	20.00	2.20	0.00	22.200	1.000	23.2	161.6	5.80	3,966
	A	002	Peaked	top of sidewall	16.000	0.000	0.000	20.00	2.20	0.00	22.200	1.000	23.2	161.6	5.80	3,966
	A	007	Peaked	top of sidewall	21.000	0.000	0.000	22.00	2.70	0.00	24.700	1.300	26.0	278.4	6.80	7,730
	A	008	Peaked	top of sidewall	41.900	0.000	0.000	24.70	0.00	0.00	24.700	2.500	27.2	1108.4	10.0	33,163
	A	009	Peaked	top of sidewall	41.900	0.000	0.000	24.70	0.00	0.00	24.700	2.500	27.2	1108.4	10.0	33,163
	A	010	Peaked	top of sidewall	41.900	0.000	0.000	24.70	0.00	0.00	24.700	2.500	27.2	1108.4	10.0	33,163
	A	011	Peaked	top of sidewall	30.000	0.000	0.000	18.30	3.50	0.00	21.800	1.800	23.6	568.2	9.00	14,617
	A	012	Peaked	top of sidewall	30.000	0.000	0.000	18.30	3.50	0.00	21.800	1.800	23.6	568.2	9.00	14,617
	A	016	Peaked	top of sidewall	47.800	0.000	0.000	31.80	0.00	0.00	31.800	2.900	34.7	1442.5	10.0	55,061
	A	017	Peaked	top of sidewall	47.800	0.000	0.000	31.80	0.00	0.00	31.800	2.900	34.7	1442.5	10.0	55,061
	A	018	Peaked	top of sidewall	47.800	0.000	0.000	31.80	0.00	0.00	31.800	2.900	34.7	1442.5	10.0	55,061
Added	A	019	Peaked	top of sidewall	47.800	0.000	0.000	31.80	0.00	0.00	31.800	2.900	34.7	1442.5	10.0	55,061
Added	A	020	Peaked	top of sidewall	47.800	0.000	0.000	31.80	0.00	0.00	31.800	2.900	34.7	1442.5	10.0	55,061
	A	021	Peaked	top of sidewall	47.800	0.000	0.000	28.20	0.00	0.00	28.200	2.900	31.1	1442.5	10.0	49,348
	A	022	Peaked	top of sidewall	47.800	0.000	0.000	28.20	0.00	0.00	28.200	2.900	31.1	1442.5	10.0	49,348
	A	023	Peaked	top of sidewall	47.800	0.000	0.000	28.20	0.00	0.00	28.200	2.900	31.1	1442.5	10.0	49,348
Added	A	025	Peaked	top of sidewall	47.800	0.000	0.000	28.20	0.00	0.00	28.200	2.900	31.1	1442.5	10.0	49,348
	A	032	Peaked	top of sidewall	16.000	0.000	0.000	20.00	2.00	0.00	22.000	1.000	23.0	161.6	5.80	3,933
	A	033	Peaked	top of sidewall	16.000	0.000	0.000	20.00	2.00	0.00	22.000	1.000	23.0	161.6	5.80	3,933
	A	034	Peaked	top of sidewall	16.000	0.000	0.000	20.00	2.00	0.00	22.000	1.000	23.0	161.6	5.80	3,933
	A	035	Peaked	top of sidewall	14.800	0.000	0.000	12.00	2.00	0.00	14.000	0.900	14.9	138.3	5.50	2,174

Exam Date:09/13/2010

Engstrom Bean and Seed, Inc.
6131 57th Ave NE
Leeds , ND
County:

Examiner: 2

Status	Section	Bin Number	Bin Type	Base Point	Diameter or Bu/Ft (Irreg).		Side wall	Add for Hopper	Ded. for Obst.	Effective Depth	Add for Peak	Depth for Capac.	Bushels per Foot	Base Pack%	Bushel Capacity with Pack
					Length	Width									

Facility: Leeds

Section: A

A	036	Peaked	top of sidewall	14.000	0.000	0.000	12.00	2.00	0.00	14.000	0.800	14.8	123.7	5.50	1,932
A	037	Peaked	top of sidewall	14.000	0.000	0.000	12.00	2.00	0.00	14.000	0.800	14.8	123.7	5.50	1,932
A	038	Peaked	top of sidewall	16.000	0.000	0.000	15.00	2.00	0.00	17.000	1.000	18.0	161.6	5.80	3,078
A	039	Peaked	top of sidewall	16.000	0.000	0.000	15.00	2.00	0.00	17.000	1.000	18.0	161.6	5.80	3,078
A	040	Peaked	top of sidewall	16.000	0.000	0.000	15.00	2.00	0.00	17.000	1.000	18.0	161.6	5.80	3,078
A	041	Peaked	top of sidewall	16.000	0.000	0.000	15.00	2.00	0.00	17.000	1.000	18.0	161.6	5.80	3,078
A	042	Peaked	top of sidewall	16.000	0.000	0.000	15.00	2.00	0.00	17.000	1.000	18.0	161.6	5.80	3,078
A	043	Peaked	top of sidewall	16.000	0.000	0.000	20.00	2.00	0.00	22.000	1.000	23.0	161.6	5.80	3,933

Bin count: 29

Facility: Leeds Section: A Total: 654,242

To Even: 655,000

Section: B

B	001	Flat	flat warehouse	0.000	60.00	50.00	3.500	0.00	0.00	3.500	0.000	3.5	2411.6	10.0	9,285
---	-----	------	----------------	-------	-------	-------	-------	------	------	-------	-------	-----	--------	------	-------

Bin count: 1

Facility: Leeds Section: B Total: 9,285

To Even: 10,000

Client ID: 2586

NDPSC Bin Capacity Chart

09/13/2010 04:00:10 PM

Exam Date:09/13/2010

Engstrom Bean and Seed, Inc.

Page: 5

Examiner: 2

6131 57th Ave NE

Leeds , ND

County:

Status	Section	Bin Number	Bin Type	Base Point	Diameter or Bu/Ft (Irreg.) Length	Width	Side wall	Add for Hopper	Ded. for Obst.	Effective Depth	Add for Peak	Depth for Capac.	Bushels per Foot	Base Pack%	Bushel Capacity with Pack
--------	---------	------------	----------	------------	-----------------------------------------	-------	--------------	----------------------	----------------------	--------------------	--------------------	------------------------	------------------------	---------------	------------------------------

Facility: Maddock**Section: M**

Added	M	004	Peaked	top of sidewall	27.000	0.000	0.000	17.20	0.00	0.00	17.200	1.600	18.8	460.3	8.50	9,390
Added	M	005	Peaked	top of sidewall	27.000	0.000	0.000	17.20	0.00	0.00	17.200	1.600	18.8	460.3	8.50	9,390
Added	M	007	Peaked	top of sidewall	48.000	0.000	0.000	25.50	0.00	0.00	25.500	3.400	28.9	1454.6	10.0	46,242

Bin count: 3

Facility: Maddock Section: M Total: **65,022**To Even: **66,000**

Exam Date:09/13/2010

Engstrom Bean and Seed, Inc.

Page: 6

Examiner: 2

6131 57th Ave NE

Leeds , ND

County:

Status	Section	Bin Number	Bin Type	Base Point	Diameter or Bu/Ft (Irreg).		Side wall	Add for Hopper	Ded. for Obst.	Effective Depth	Add for Peak	Depth for Capac.	Bushels per Foot	Base Pack%	Bushel Capacity with Pack
					Length	Width									

Facility: Petersburg

Section: A-P

A-P	001	Square	work floor		0.000	6.900	6.500	53.50	0.00	0.00	53.500	0.000	53.5	36.1	3.00	1,989
A-P	002	Square	work floor		0.000	6.900	6.400	53.50	0.00	0.00	53.500	0.000	53.5	35.5	3.00	1,956
A-P	003	Square	work floor		0.000	6.900	4.000	53.50	0.00	0.00	53.500	0.000	53.5	22.2	2.00	1,212
A-P	004 T	Square	work floor		0.000	6.900	4.100	8.000	0.00	0.00	8.000	0.000	8.0	22.7	2.00	186
A-P	004 B	Square	work floor - top 8'		0.000	10.90	4.100	43.50	0.00	0.00	43.500	0.000	43.5	35.9	3.00	1,609
A-P	005	Square	work floor		0.000	6.900	6.600	53.50	0.00	0.00	53.500	0.000	53.5	36.6	3.00	2,017
A-P	006	Square	work floor		0.000	6.900	6.700	53.50	0.00	0.00	53.500	0.000	53.5	37.2	3.00	2,050
A-P	007 T	Square	work floor		0.000	13.10	3.600	53.00	0.00	0.00	53.000	0.000	53.0	37.9	3.00	2,069
A-P	007 B	Square	work floor - top 53'		0.000	12.70	10.70	21.80	0.00	0.00	21.800	0.000	21.8	109.2	6.20	2,529
A-P	008 T	Square	scale well floor		0.000	4.100	3.700	12.50	0.00	0.00	12.500	0.000	12.5	12.2	2.00	156
A-P	008 B	Square	scale well floor - top 12.5'		0.000	10.30	3.700	35.50	0.00	0.00	35.500	0.000	35.5	30.6	2.50	1,113
A-P	009 T	Square	work floor		0.000	13.10	3.600	53.00	0.00	0.00	53.000	0.000	53.0	37.9	3.00	2,069
A-P	009 B	Square	work floor - top 53'		0.000	12.70	10.70	21.80	0.00	0.00	21.800	0.000	21.8	109.2	6.20	2,529
A-P	010	Square	work floor		0.000	6.800	6.500	53.00	0.00	0.00	53.000	0.000	53.0	35.5	3.00	1,938
A-P	011	Square	work floor		0.000	6.800	6.400	56.00	0.00	0.00	56.000	0.000	56.0	35.0	3.00	2,019
A-P	012	Square	scale well floor		0.000	7.200	6.800	47.50	0.00	0.00	47.500	0.000	47.5	39.4	3.00	1,928
A-P	013	Square	scale well floor		0.000	7.200	6.800	47.50	0.00	0.00	47.500	0.000	47.5	39.4	3.00	1,928
A-P	014	Square	work floor		0.000	6.800	6.600	56.00	0.00	0.00	56.000	0.000	56.0	36.1	3.00	2,083
A-P	015	Square	work floor		0.000	6.800	6.700	56.00	0.00	0.00	56.000	0.000	56.0	36.6	3.00	2,112
A-P	016	Square	work floor		0.000	7.200	6.500	53.00	0.00	0.00	53.000	0.000	53.0	37.6	3.00	2,053
A-P	017	Square	work floor		0.000	7.200	6.400	56.00	0.00	0.00	56.000	0.000	56.0	37.0	3.00	2,134

Exam Date:09/13/2010

Engstrom Bean and Seed, Inc.

Page: 7

Examiner: 2

6131 57th Ave NE

Leeds , ND

County:

Status	Section	Bin Number	Bin Type	Base Point	Diameter or Bu/Ft (Irreg.)	Length	Width	Side wall	Add for Hopper	Ded. for Obst.	Effective Depth	Add for Peak	Depth for Capac.	Bushels per Foot	Base Pack%	Bushel Capacity with Pack
--------	---------	------------	----------	------------	-------------------------------	--------	-------	--------------	----------------------	----------------------	--------------------	--------------------	------------------------	------------------------	---------------	------------------------------

Facility: Petersburg

Section: A-P

A-P	018	Square	work floor		0.000	7.200	7.200	56.00	0.00	0.00	56.000	0.000	56.0	41.7	3.50	2,417
A-P	019	Square	work floor		0.000	7.200	7.200	56.00	0.00	0.00	56.000	0.000	56.0	41.7	3.50	2,417
A-P	020	Square	work floor		0.000	7.200	6.600	56.00	0.00	0.00	56.000	0.000	56.0	38.2	3.00	2,203
A-P	021	Square	work floor		0.000	7.200	6.700	56.00	0.00	0.00	56.000	0.000	56.0	38.8	3.00	2,238
A-P	022	Square	work floor		0.000	10.50	7.000	25.50	0.00	0.00	25.500	0.000	25.5	59.1	4.80	1,579
A-P	023 T	Square	work floor		0.000	10.90	2.100	25.50	0.00	0.00	25.500	0.000	25.5	18.4	2.00	478
A-P	023 B	Square	work floor		0.000	12.70	10.60	49.30	0.00	0.00	49.300	0.000	49.3	108.2	6.20	5,665
A-P	024 T	Square	work floor		0.000	13.00	2.000	54.00	0.00	0.00	54.000	0.000	54.0	20.9	2.00	1,152
A-P	024 B	Square	work floor - top 54'		0.000	12.70	10.60	20.80	0.00	0.00	20.800	0.000	20.8	108.2	6.20	2,391
A-P	025	Square	work floor		0.000	10.50	3.600	24.00	0.00	0.00	24.000	0.000	24.0	30.4	2.50	748
A-P	026	Square	work floor		0.000	7.200	3.800	55.50	0.00	0.00	55.500	0.000	55.5	22.0	2.00	1,245
A-P	027	Square	work floor		0.000	7.200	3.800	55.50	0.00	0.00	55.500	0.000	55.5	22.0	2.00	1,245
A-P	028	Square	work floor		0.000	9.300	6.600	52.50	0.00	0.00	52.500	0.000	52.5	49.3	4.20	2,697
A-P	029	Square	work floor		0.000	9.300	6.700	52.50	0.00	0.00	52.500	0.000	52.5	50.1	4.50	2,748
A-P	031	Square	work floor		0.000	12.00	11.00	44.00	0.00	0.00	44.000	0.000	44.0	106.1	6.20	4,957
A-P	032 T	Square	work floor		0.000	12.00	2.600	44.00	0.00	0.00	44.000	0.000	44.0	25.1	2.50	1,132
A-P	032 B	Square	work floor - top 44'		0.000	13.90	12.00	28.00	0.00	0.00	28.000	0.000	28.0	134.1	6.50	3,999
A-P	033 T	Square	work floor		0.000	14.20	12.00	61.70	0.00	0.00	61.700	0.000	61.7	137.0	6.50	9,002
A-P	033 B	Square	work floor - top 61.7'		0.000	11.90	9.100	11.50	0.00	0.00	11.500	0.000	11.5	87.0	5.80	1,059
A-P	034 T	Square	work floor		0.000	14.90	12.00	61.70	0.00	0.00	61.700	0.000	61.7	143.7	6.80	9,469
A-P	034 B	Square	work floor - top 61.7'		0.000	11.90	9.100	11.50	0.00	0.00	11.500	0.000	11.5	87.0	5.80	1,059

Exam Date:09/13/2010

Engstrom Bean and Seed, Inc.

Page: 8

Examiner: 2

6131 57th Ave NE

Leeds , ND

County:

Status	Section	Bin Number	Bin Type	Base Point	Diameter or Bu/Ft (Irreg). Length	Width	Side wall	Add for Hopper	Ded. for Obst.	Effective Depth	Add for Peak	Depth for Capac.	Bushels per Foot	Base Pack%	Bushel Capacity with Pack
--------	---------	------------	----------	------------	-----------------------------------------	-------	--------------	----------------------	----------------------	--------------------	--------------------	------------------------	------------------------	---------------	------------------------------

Facility: Petersburg

Section: A-P

A-P	035	Square	work floor		0.000	14.10	12.00	72.00	0.00	0.00	72.000	0.000	72.0	136.0	6.50	10,428
A-P	036	Square	work floor		0.000	12.60	11.00	44.00	0.00	0.00	44.000	0.000	44.0	111.4	6.20	5,206
A-P	037 T	Square	work floor		0.000	12.60	2.600	44.00	0.00	0.00	44.000	0.000	44.0	26.3	2.50	1,186
A-P	037 B	Square	work floor - top 44'		0.000	13.90	12.60	28.00	0.00	0.00	28.000	0.000	28.0	140.8	6.80	4,210
A-P	038 T	Square	work floor		0.000	14.20	12.60	61.70	0.00	0.00	61.700	0.000	61.7	143.8	6.80	9,475
A-P	038 B	Square	work floor - top 61.7'		0.000	12.40	9.100	11.50	0.00	0.00	11.500	0.000	11.5	90.7	5.80	1,103
A-P	039 T	Square	work floor		0.000	14.90	12.60	61.70	0.00	0.00	61.700	0.000	61.7	150.9	6.80	9,944
A-P	039 B	Square	work floor - top 61.7'		0.000	12.40	9.100	11.50	0.00	0.00	11.500	0.000	11.5	90.7	5.80	1,103
A-P	040	Square	work floor		0.000	14.10	12.60	72.00	0.00	0.00	72.000	0.000	72.0	142.8	6.80	10,981
A-P	041	Square	work floor		0.000	12.50	11.00	44.00	0.00	0.00	44.000	0.000	44.0	110.5	6.20	5,163
A-P	042 T	Square	work floor		0.000	12.50	2.600	44.00	0.00	0.00	44.000	0.000	44.0	26.1	2.50	1,177
A-P	042 B	Square	work floor -top 44'		0.000	13.90	12.50	28.00	0.00	0.00	28.000	0.000	28.0	139.7	6.80	4,178
A-P	043 T	Square	work floor		0.000	14.20	12.50	61.70	0.00	0.00	61.700	0.000	61.7	142.7	6.80	9,404
A-P	043 B	Square	work floor - top 61.7'		0.000	12.30	9.100	11.50	0.00	0.00	11.500	0.000	11.5	90.0	5.80	1,095
A-P	044 T	Square	work floor		0.000	14.90	12.50	61.70	0.00	0.00	61.700	0.000	61.7	149.7	6.80	9,864
A-P	044 B	Square	work floor - top 61.7'		0.000	12.30	9.100	11.50	0.00	0.00	11.500	0.000	11.5	90.0	5.80	1,095
A-P	045	Square	work floor		0.000	14.10	12.50	72.00	0.00	0.00	72.000	0.000	72.0	141.7	6.80	10,896
A-P	046	Square	work floor		0.000	12.50	11.00	44.00	0.00	0.00	44.000	0.000	44.0	110.5	6.20	5,163
A-P	047 T	Square	work floor		0.000	12.50	2.600	44.00	0.00	0.00	44.000	0.000	44.0	26.1	2.50	1,177
A-P	047 B	Square	work floor - top 44'		0.000	13.90	12.50	28.00	0.00	0.00	28.000	0.000	28.0	139.7	6.80	4,178
A-P	048 T	Square	work floor		0.000	14.20	12.50	61.70	0.00	0.00	61.700	0.000	61.7	142.7	6.80	9,404

Exam Date:09/13/2010

Engstrom Bean and Seed, Inc.
6131 57th Ave NE
Leeds , ND
County:

Examiner: 2

Page: 9

Status	Section	Bin Number	Bin Type	Base Point	Diameter or Bu/Ft (Irreg).		Side wall	Add for Hopper	Ded. for Obst.	Effective Depth	Add for Peak	Depth for Capac.	Bushels per Foot	Base Pack%	Bushel Capacity with Pack
					Length	Width									

Facility: Petersburg

Section: A-P

A-P	048 B	Square	work floor - top 61.7'	0.000	12.30	9.100	11.50	0.00	0.00	11.500	0.000	11.5	90.0	5.80	1,095
A-P	049 T	Square	work floor	0.000	14.90	12.50	61.70	0.00	0.00	61.700	0.000	61.7	149.7	6.80	9,864
A-P	049 B	Square	work floor - top 61.7	0.000	12.30	9.100	11.50	0.00	0.00	11.500	0.000	11.5	90.0	5.80	1,095
A-P	050	Square	work floor	0.000	14.10	12.50	72.00	0.00	0.00	72.000	0.000	72.0	141.7	6.80	10,896
A-P	051	Square	work floor	0.000	12.50	11.00	44.00	0.00	0.00	44.000	0.000	44.0	110.5	6.20	5,163
A-P	052 T	Square	work floor	0.000	12.50	2.600	44.00	0.00	0.00	44.000	0.000	44.0	26.1	2.50	1,177
A-P	052 B	Square	work floor - top 44'	0.000	13.90	12.50	28.00	0.00	0.00	28.000	0.000	28.0	139.7	6.80	4,178
A-P	053 T	Square	work floor	0.000	14.20	12.50	61.70	0.00	0.00	61.700	0.000	61.7	142.7	6.80	9,404
A-P	053 B	Square	work floor - top 61.7'	0.000	12.40	9.100	11.50	0.00	0.00	11.500	0.000	11.5	90.7	5.80	1,103
A-P	054 T	Square	work floor	0.000	14.90	12.50	61.70	0.00	0.00	61.700	0.000	61.7	149.7	6.80	9,864
A-P	054 B	Square	work floor - top 61.7'	0.000	12.40	9.100	11.50	0.00	0.00	11.500	0.000	11.5	90.7	5.80	1,103
A-P	055	Square	work floor	0.000	14.10	12.50	72.00	0.00	0.00	72.000	0.000	72.0	141.7	6.80	10,896
A-P	056	Square	work floor	0.000	12.30	11.00	44.00	0.00	0.00	44.000	0.000	44.0	108.8	6.20	5,084
A-P	057 T	Square	work floor	0.000	12.30	2.600	44.00	0.00	0.00	44.000	0.000	44.0	25.7	2.50	1,159
A-P	057 B	Square	work floor - top 44'	0.000	13.90	12.30	27.00	0.00	0.00	27.000	0.000	27.0	137.4	6.50	3,951
A-P	058 T	Square	work floor	0.000	14.20	12.30	61.70	0.00	0.00	61.700	0.000	61.7	140.4	6.80	9,252
A-P	058 B	Square	work floor - top 61.7'	0.000	12.00	9.100	10.00	0.00	0.00	10.000	0.000	10.0	87.8	5.80	929
A-P	059 T	Square	work floor	0.000	14.90	12.30	61.70	0.00	0.00	61.700	0.000	61.7	147.3	6.80	9,706
A-P	059 B	Square	work floor - top 61.7'	0.000	12.00	9.100	10.00	0.00	0.00	10.000	0.000	10.0	87.8	5.80	929
A-P	060	Square	work floor	0.000	14.10	12.30	71.00	0.00	0.00	71.000	0.000	71.0	139.4	6.80	10,570
A-P	101	Peaked	top of sidewall	16.000	0.000	0.000	15.00	2.00	0.00	17.000	1.000	18.0	161.6	5.80	3,078

Client ID: 2586

NDPSC Bin Capacity Chart

09/13/2010 04:00:17 PM

Exam Date:09/13/2010

Engstrom Bean and Seed, Inc.
6131 57th Ave NE
Leeds , ND
County:

Page: 10

Examiner: 2

Status	Section	Bin Number	Bin Type	Base Point	Diameter or Bu/Ft (Irreg.) Length	Width	Side wall	Add for Hopper	Ded. for Obst.	Effective Depth	Add for Peak	Depth for Capac.	Bushels per Foot	Base Pack%	Bushel Capacity with Pack
--------	---------	------------	----------	------------	-----------------------------------------	-------	--------------	----------------------	----------------------	--------------------	--------------------	------------------------	------------------------	---------------	------------------------------

Facility: Petersburg**Section: A-P**

	A-P	102	Peaked	top of sidewall	16.000	0.000	0.000	15.00	2.00	0.00	17.000	1.000	18.0	161.6	5.80	3,078
Added	A-P	103	Peaked	top of sidewall	16.000	0.000	0.000	20.00	2.00	0.00	22.000	1.000	23.0	161.6	5.80	3,933
Added	A-P	104	Peaked	top of sidewall	16.000	0.000	0.000	20.00	2.00	0.00	22.000	1.000	23.0	161.6	5.80	3,933

Bin count: 87

Facility: Petersburg Section: A-P Total: 335,449To Even: 336,000**Section: B-P**

	B-P	100	Flat	bag storage area	0.000	50.00	50.00	4.000	0.00	0.00	4.000	0.000	4.0	2009.6	10.0	8,842
--	-----	-----	------	------------------	-------	-------	-------	-------	------	------	-------	-------	-----	--------	------	-------

Bin count: 1


Facility: Petersburg Section: B-P Total: 8,842To Even: 9,000**Overall Licensed Bin Capacity for:**

Engstrom Bean and Seed, Inc.


Bin count: 128

Licensed Capacity:
(includes pack)1,200,753 Bu.**Licensed Capacity (to even):**
(includes pack and section totals are
rounded up to next highest 1000)1,204,000 Bu.

ENGSTROM SEED & BEAN
LEEDS ND
SECTION B
located west of north water tower in Leeds by rail service

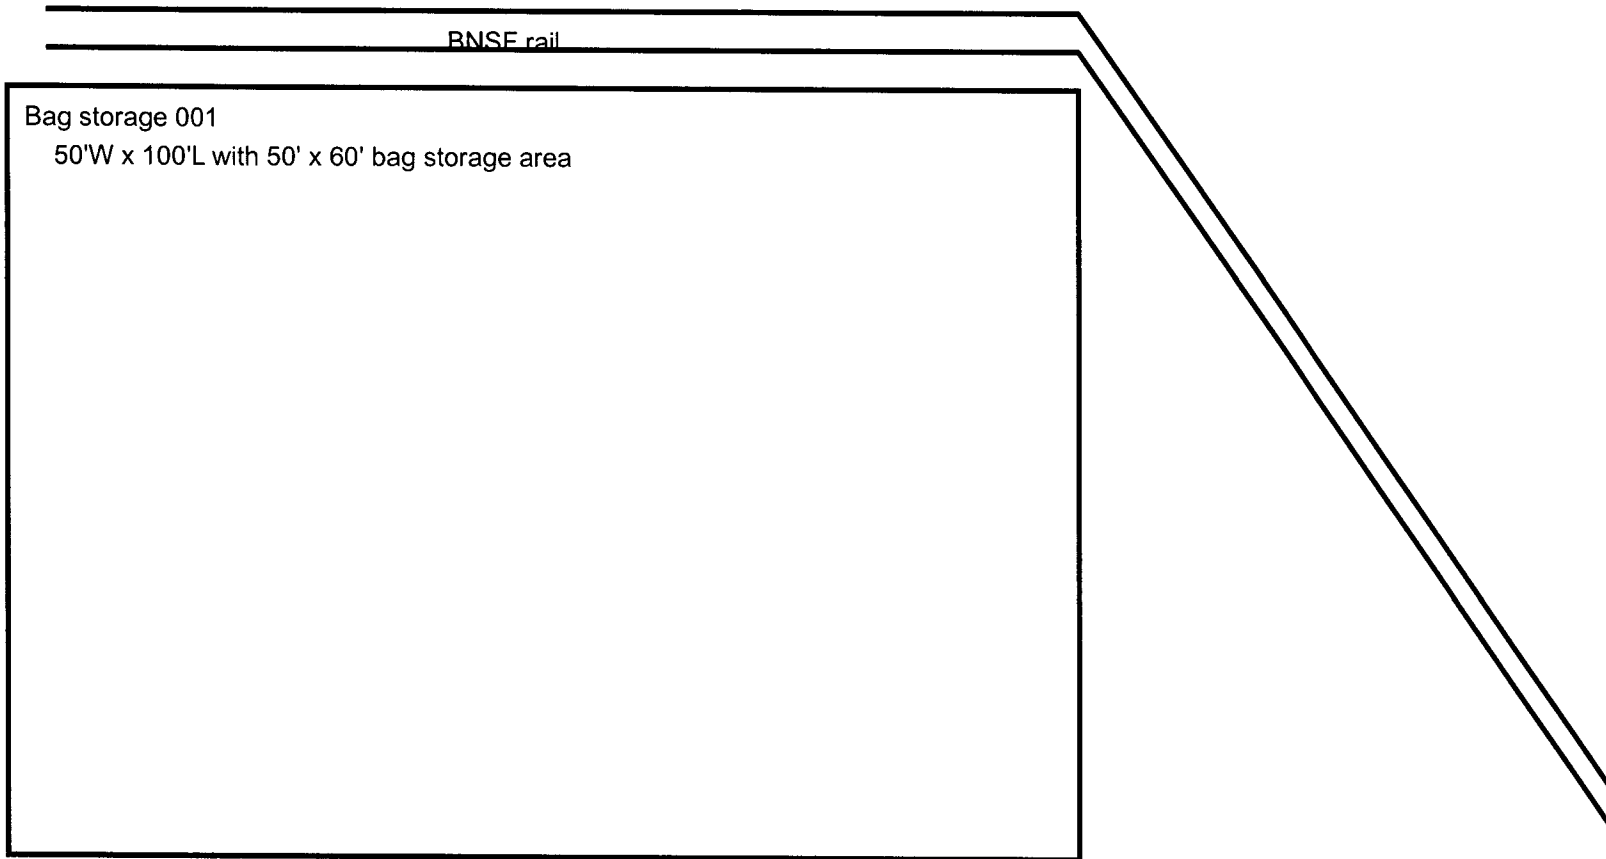



SECTION A

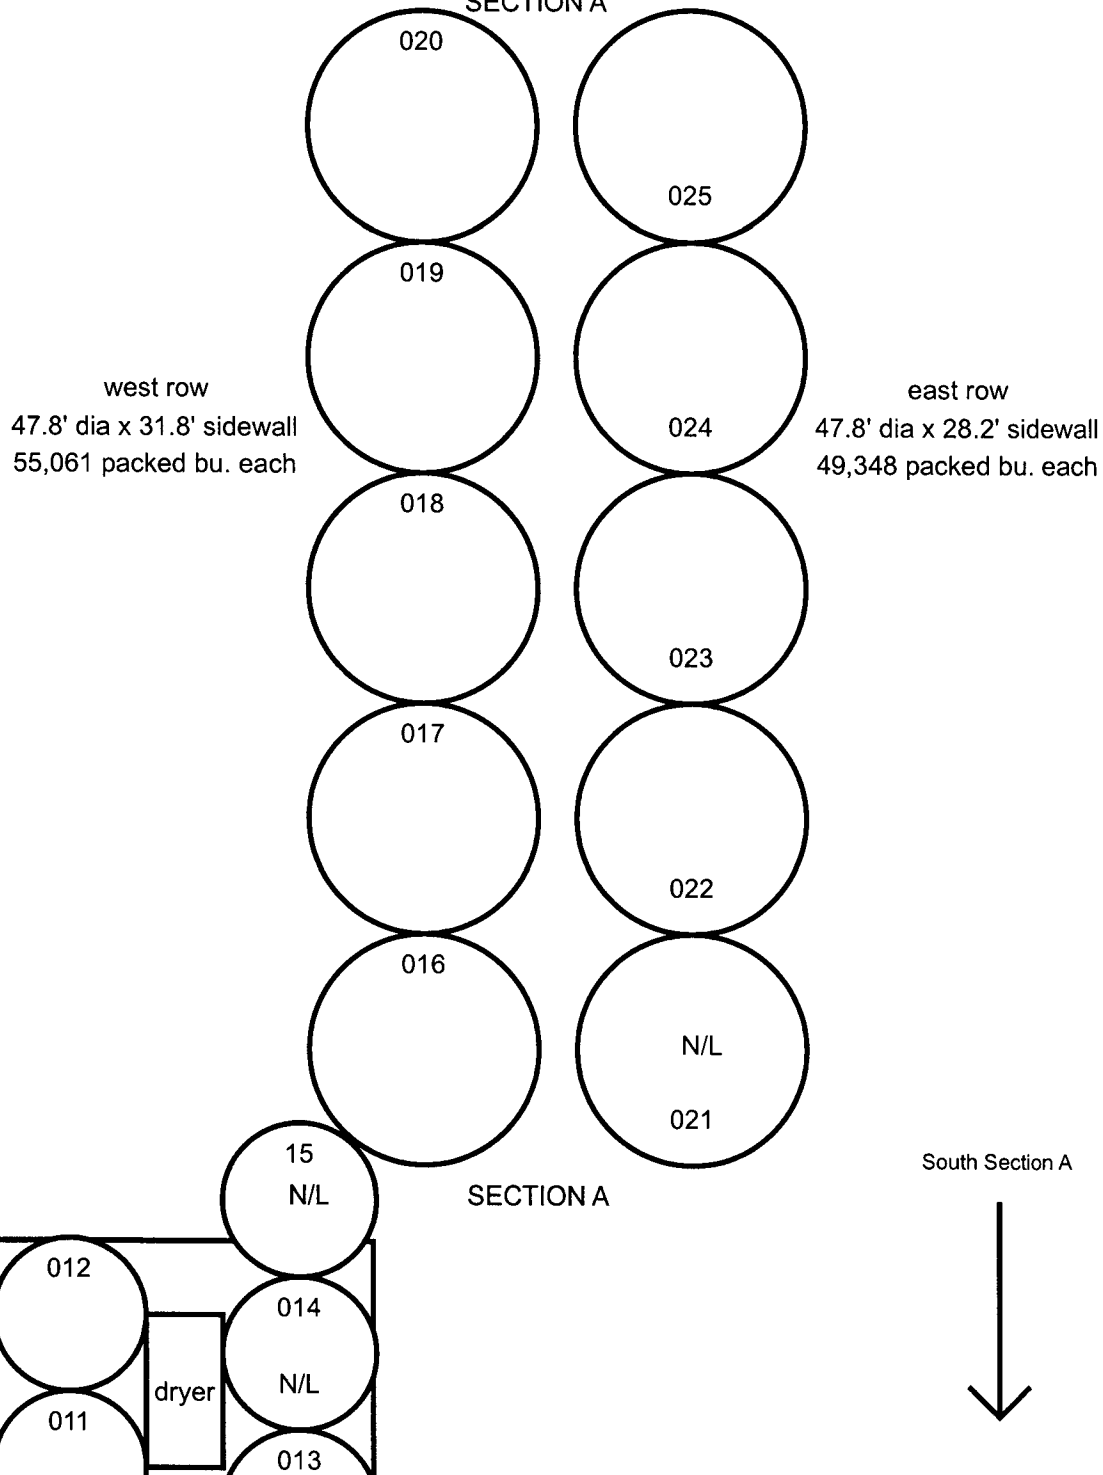


ENGSTROM SEED & BEAN
LEEDS N.D.
located from airstrip east of town on hwy 2
1.5 miles north on east side of road

ENGSTROM SEED & BEAN
LEEDS N.D.
PETERSBURG LOCATION


Burlington Northern Railroad

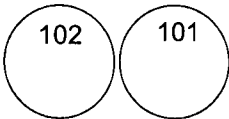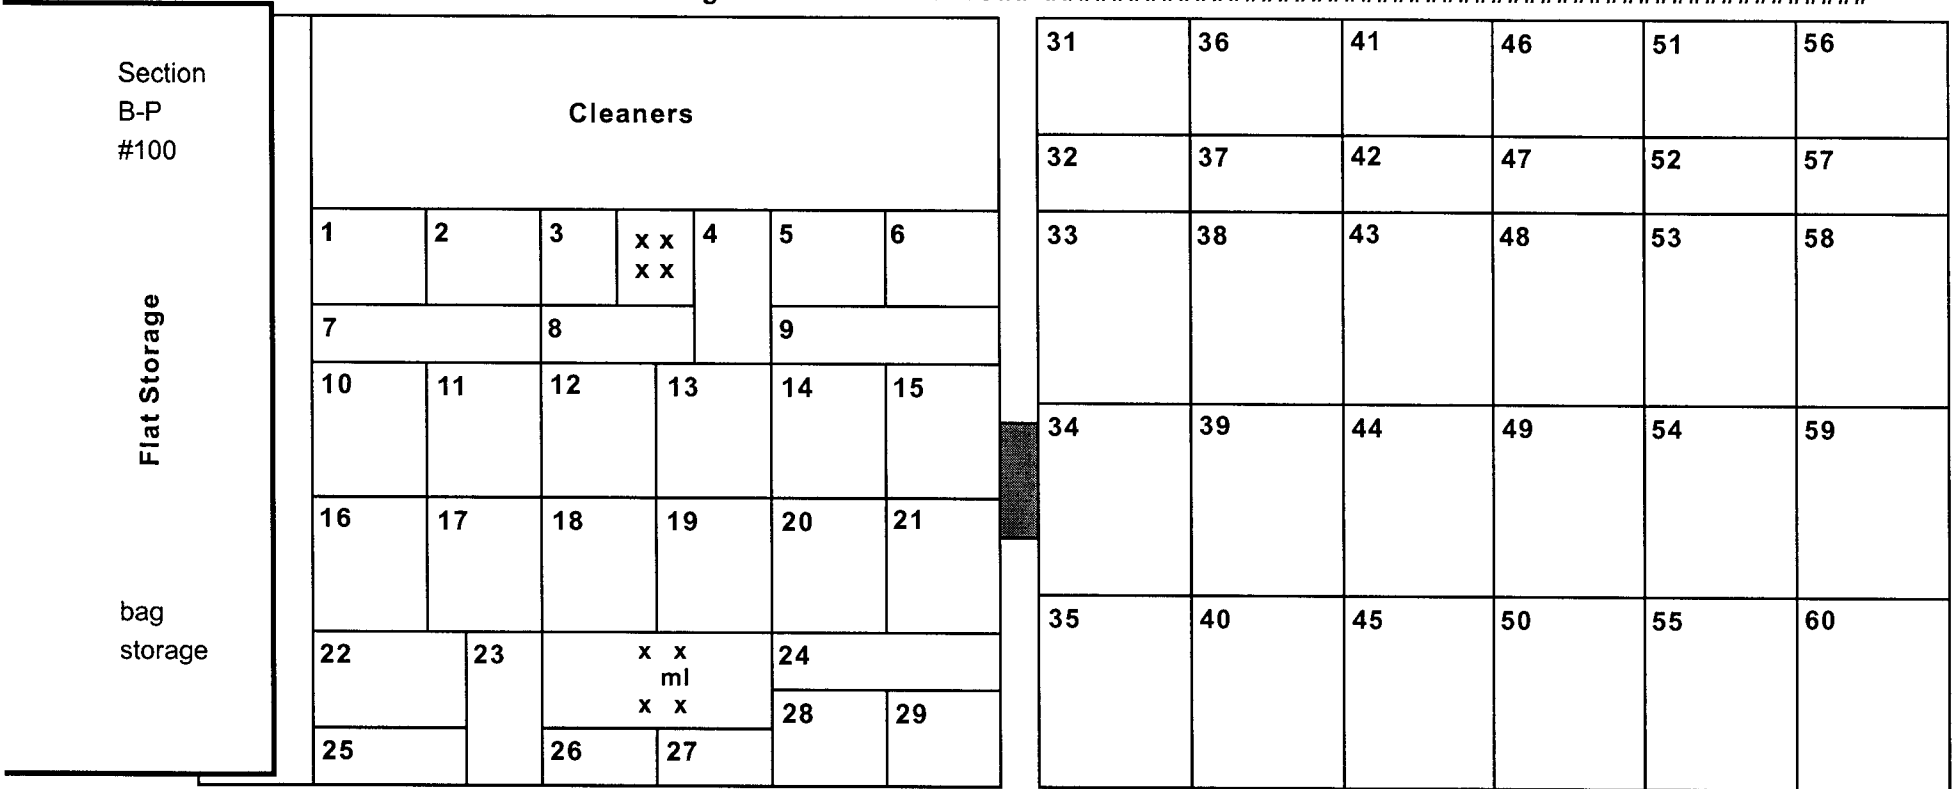

located west of bag whse


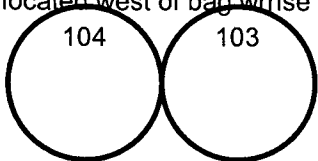


SECTION A-P

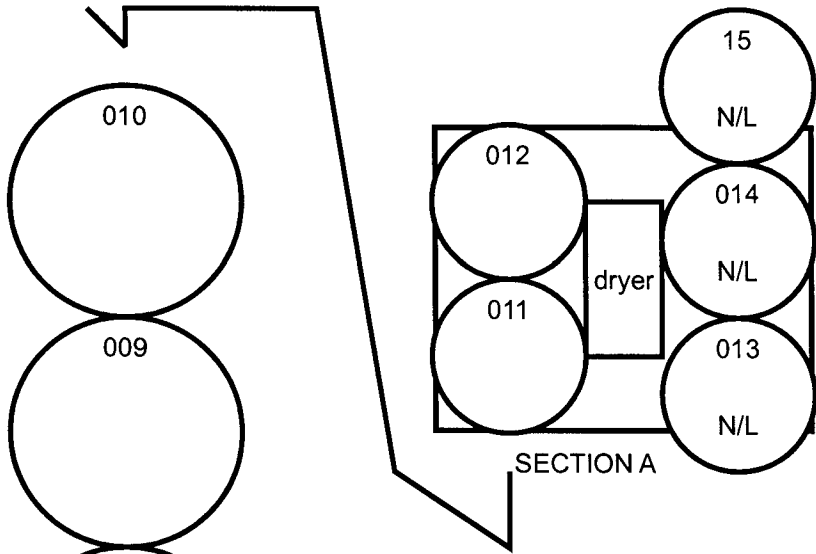


north
↑
continued on page 2

ENGSTROM SEED & BEAN
LEEDS N.D.
located from airstrip east of town on hwy 2
1.5 miles north on east side of road

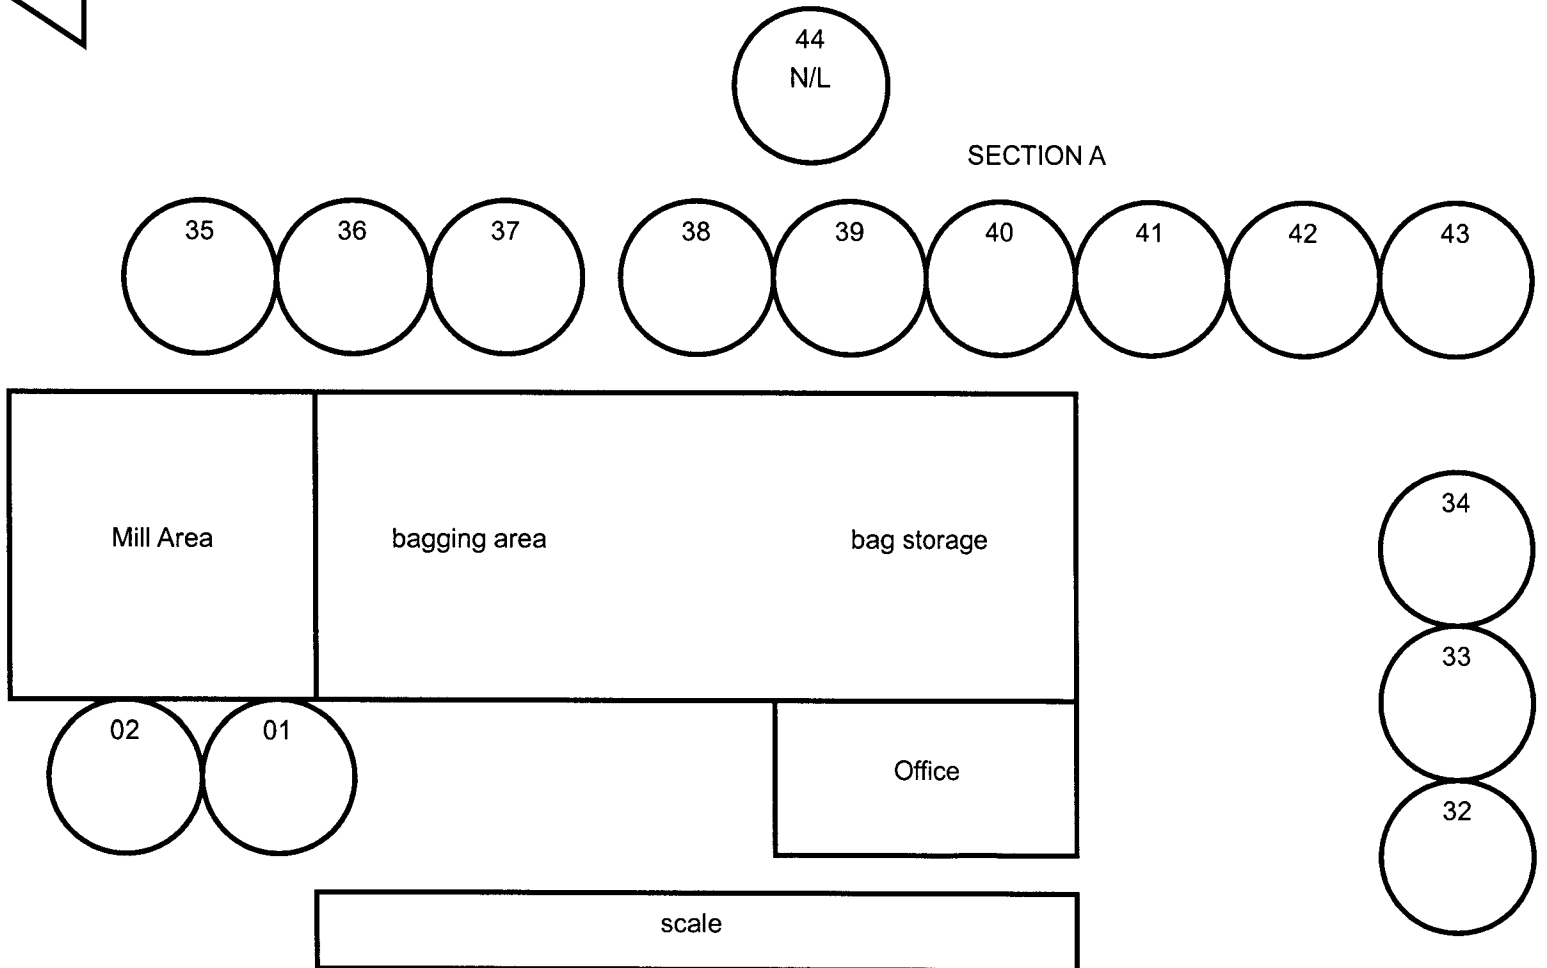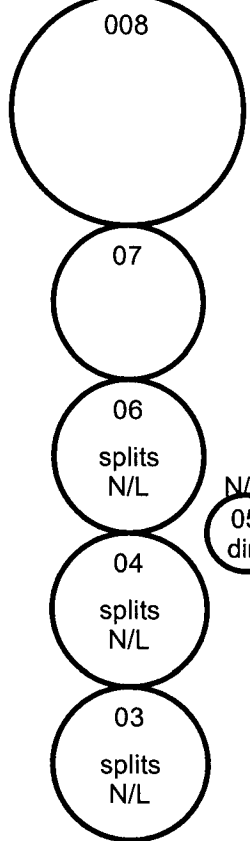


SCOTT G. FOSS dba
LONE PRAIRIE GRAIN
TUNBRIDGE ND.
Maddock location
SECTION M




NW corner of town along Hwy 30

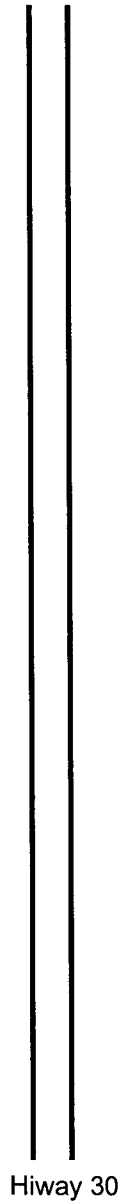




TANKS #4-5-7 ENGSTROM SEED & BEAN
Tank # 7 new not on Lone Prairie license

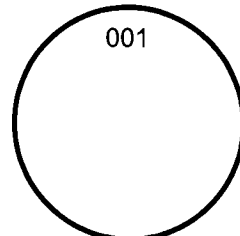


tanks #1 & 2
48' dia x 46.5' sidewall

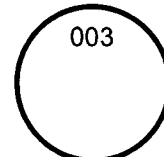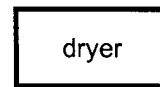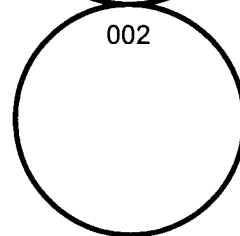

tanks #3-4-5-6
27' dia x 17.2' sidewall

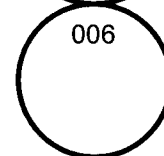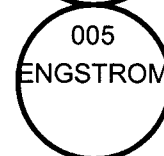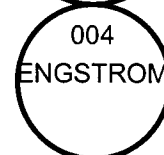


48' dia x 25.5' sidewall (26.75' less aeration 1.5')
exact location unknown

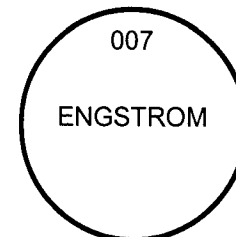


FARMERS ELEVATOR INC. OF GRACE CITY
GRACE CITY N.D.

BNSF RAIL

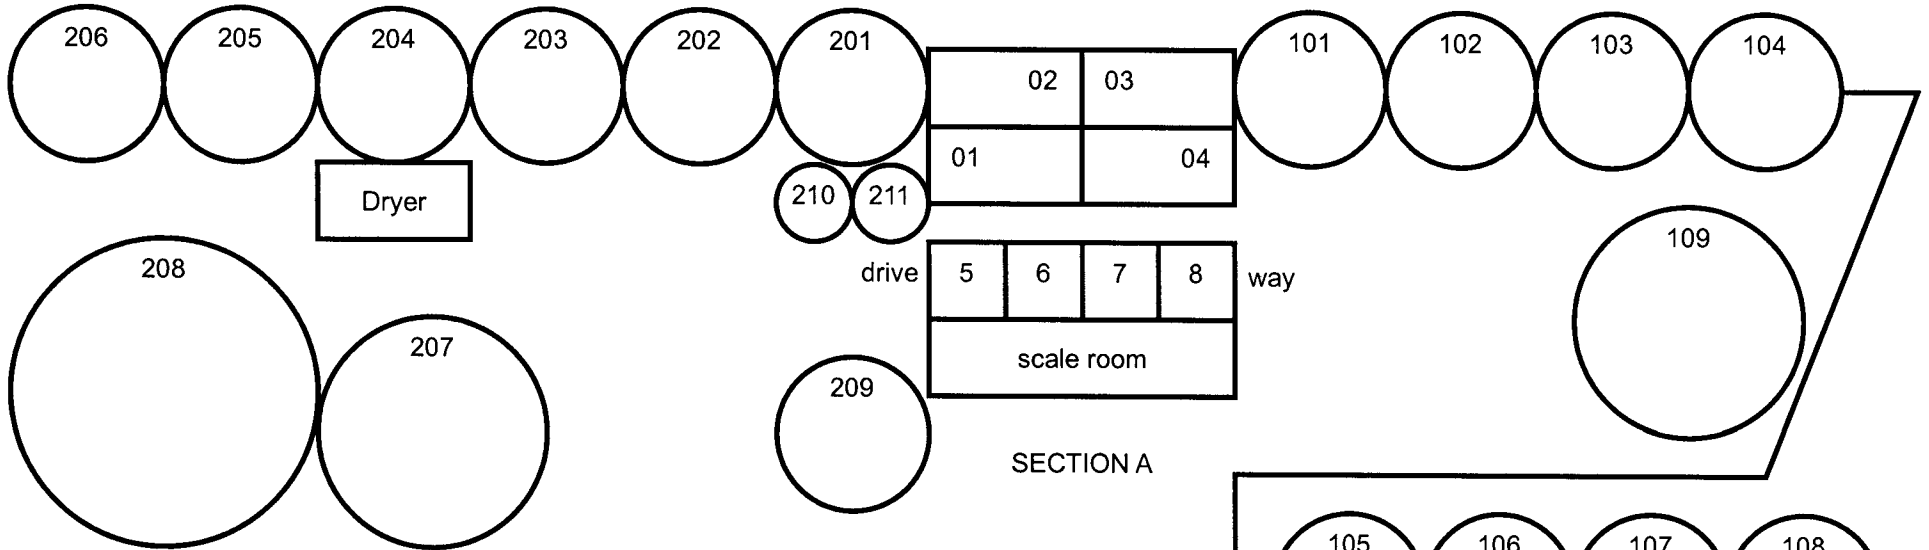

SECTION A

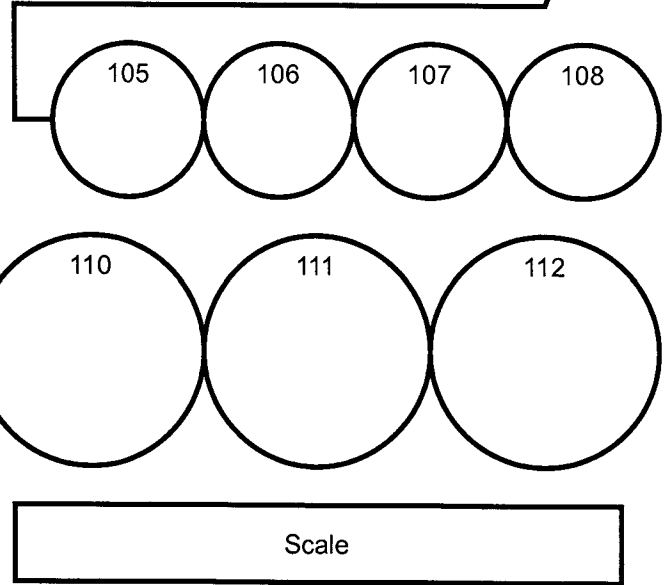

ENGSTROM SEED & BEAN
Tanks 301-2-3-4 and
Off site quonset 51W x 83L x 8' grain depth
30,000 bushel capacity
quonset not on Grace City License
tanks located 150'
SE of main Elev.

