

Exam Date:09/02/2010

Farmers Elevator Company of Cooperstown

Page: 1

Examiner: 1

Box 587

Cooperstown , ND

County:

Phone: 701-797-2631

CCC Number: 2-4279

Location/Container Numbers/Comments	Section	Capacity
PART A - ADDITIONAL SPACE TO BE INCLUDED UNDER LICENSE		
118	C	3,591
004	D	3,078
003	D	3,078
002	D	3,078
001	D	3,078
017	D	2,975
016	D	2,975
015	D	2,975
014	D	2,975
011	B	98,594
012	B	54,967
	Total:	181,364

PART B - SPACE TO BE DELETED UNDER LICENSE

101	C	1,259
102	C	2,258
103	C	2,258
104	C	1,383
105	C	1,383
106	C	4,550
107 T	C	1,309
107 B	C	179
110	C	4,550
111	C	2,231
112	C	2,367
201	C	2,312
202 T	C	463
202 B	C	614
202TB	C	307
203	C	2,506
204	C	2,406
205	C	850
206	C	850
207 T	C	3,355
207 B	C	883
209	C	1,231
210	C	3,397
212	C	2,386
301 T	C	5,692
301 B	C	325
302 T	C	5,692
302 B	C	464

Location/Container Numbers/Comments	Section	Capacity
303 T	C	5,597
303 B	C	318
304 T	C	5,597
304 B	C	456
305 T	C	5,692
305 B	C	325
306 T	C	5,692
306 B	C	464
		Total: 81,601

PART C - ALL SPACE TO BE INCLUDED UNDER LICENSE

B	681,000
C	182,000
D	50,000
Total:	913,000

PART D - TOTAL CAPACITY BY FUNCTIONAL UNIT

Cooperstown	462	B C D	913,000
			Total: 913,000

Exam Date:09/02/2010

Farmers Elevator Company of Cooperstown
 Box 587
 Cooperstown , ND
 County:

Examiner: 1

Status	Section	Bin Number	Bin Type	Base Point	Diameter or Bu/Ft (Irreg).		Side wall	Add for Hopper	Ded. for Obst.	Effective Depth	Add for Peak	Depth for Capac.	Bushels per Foot	Base Pack%	Bushel Capacity with Pack
					Length	Width									

Facility: Cooperstown

Section: B

	B	001	Peaked	top of sidewall	48.000	0.000	0.000	30.85	0.00	0.00	30.850	3.400	34.3	1454.6	10.0	54,882
	B	002	Peaked	top of sidewall	48.000	0.000	0.000	32.10	0.00	0.00	32.100	3.400	35.5	1454.6	10.0	56,802
	B	003	Peaked	top of sidewall	48.000	0.000	0.000	30.85	0.00	0.00	30.850	3.400	34.3	1454.6	10.0	54,882
	B	004	Peaked	top of sidewall	48.000	0.000	0.000	32.10	0.00	0.00	32.100	3.400	35.5	1454.6	10.0	56,802
	B	005	Peaked	top of sidewall	48.000	0.000	0.000	30.85	0.00	0.00	30.850	3.400	34.3	1454.6	10.0	54,882
	B	006	Peaked	top of sidewall	48.000	0.000	0.000	32.10	0.00	0.00	32.100	3.400	35.5	1454.6	10.0	56,802
	B	007	Peaked	top of sidewall	48.000	0.000	0.000	30.85	0.00	0.00	30.850	3.400	34.3	1454.6	10.0	54,882
	B	008	Peaked	top of sidewall	48.000	0.000	0.000	32.10	0.00	0.00	32.100	3.400	35.5	1454.6	10.0	56,802
	B	009	Peaked	top of sidewall	13.900	0.000	0.000	12.50	2.00	0.00	14.500	0.800	15.3	122.0	5.20	1,964
	B	010	Peaked	top of sidewall	53.700	0.000	0.000	35.50	0.00	0.00	35.500	3.800	39.3	1820.6	10.0	78,705
Added	B	011	Peaked	top of sidewall	59.800	0.000	0.000	35.50	0.00	0.00	35.500	4.200	39.7	2257.7	10.0	98,594
Added	B	012	Peaked	top of sidewall	41.800	0.000	0.000	42.80	0.00	0.00	42.800	2.500	45.3	1103.1	10.0	54,967

Bin count: 12

Facility: Cooperstown Section: B Total: **680,966**

To Even: **681,000**

Section: C

	C	001 T	Square	work floor	0.000	11.00	6.900	55.00	0.00	0.00	55.000	0.000	55.0	61.0	4.80	3,516
	C	001 B	Square	work floor- top 55'	0.000	14.50	11.00	17.00	0.00	0.00	17.000	0.000	17.0	128.2	6.50	2,321
	C	002 T	Square	work floor	0.000	11.00	6.900	55.00	0.00	0.00	55.000	0.000	55.0	61.0	4.80	3,516
	C	002 B	Square	work floor - top 55'	0.000	14.50	11.00	17.00	0.00	0.00	17.000	0.000	17.0	128.2	6.50	2,321

Exam Date:09/02/2010

Farmers Elevator Company of Cooperstown
Box 587
Cooperstown , ND
County:

Page: 2

Examiner: 1

Status	Section	Bin Number	Bin Type	Base Point	Diameter or Bu/Ft (Irreg).	Length	Width	Side wall	Add for Hopper	Ded. for Obst.	Effective Depth	Add for Peak	Depth for Capac.	Bushels per Foot	Base Pack%	Bushel Capacity with Pack
--------	---------	------------	----------	------------	-------------------------------	--------	-------	--------------	----------------------	----------------------	--------------------	--------------------	------------------------	------------------------	---------------	------------------------------

Facility: Cooperstown

Section: C

C	003 T	Square	work floor		0.000	11.00	6.900	55.00	0.00	0.00	55.000	0.000	55.0	61.0	4.80	3,516
C	003 B	Square	work floor - top 55'		0.000	14.50	11.00	17.00	0.00	0.00	17.000	0.000	17.0	128.2	6.50	2,321
C	004 T	Square	work floor		0.000	11.00	6.900	55.00	0.00	0.00	55.000	0.000	55.0	61.0	4.80	3,516
C	004 B	Square	work floor - tolp 55'		0.000	14.50	11.00	17.00	0.00	0.00	17.000	0.000	17.0	128.2	6.50	2,321
C	007 T	Irregular	work floor - 11 x 6.8 less 2.8		54.500	0.000	0.000	15.00	0.00	0.00	15.000	0.000	15.0	54.5	4.50	855
C	007 B	Square	work floor - top 15'		0.000	11.00	6.800	39.00	0.00	0.00	39.000	0.000	39.0	60.1	4.80	2,457
C	008	Square	work floor		0.000	11.00	7.300	54.00	0.00	0.00	54.000	0.000	54.0	64.5	5.00	3,657
C	009	Square	work floor		0.000	12.20	6.900	54.00	0.00	0.00	54.000	0.000	54.0	67.7	5.20	3,846
C	010	Square	work floor		0.000	6.700	4.200	29.00	0.00	0.00	29.000	0.000	29.0	22.6	2.00	668
C	011	Square	work floor		0.000	12.20	6.900	54.00	0.00	0.00	54.000	0.000	54.0	67.7	5.20	3,846
C	012	Square	work floor		0.000	8.200	7.300	54.00	0.00	0.00	54.000	0.000	54.0	48.1	4.20	2,706
C	013 T	Square	work floor		0.000	8.400	6.800	15.00	0.00	0.00	15.000	0.000	15.0	45.9	4.00	717
C	013 B	Square	work floor - top 15'		0.000	11.00	6.800	39.00	0.00	0.00	39.000	0.000	39.0	60.1	4.80	2,457
C	014	Square	work floor		0.000	11.00	7.300	54.00	0.00	0.00	54.000	0.000	54.0	64.5	5.00	3,657
C	015	Square	work floor		0.000	11.00	7.300	54.00	0.00	0.00	54.000	0.000	54.0	64.5	5.00	3,657
C	016	Square	work floor		0.000	7.300	3.800	54.00	0.00	0.00	54.000	0.000	54.0	22.3	2.00	1,228
C	017	Square	work floor		0.000	11.00	7.300	54.00	0.00	0.00	54.000	0.000	54.0	64.5	5.00	3,657
C	018	Square	work floor		0.000	12.20	7.300	54.00	0.00	0.00	54.000	0.000	54.0	71.6	5.20	4,067
C	019 T	Irregular	work floor - 12.2 x 6.8 less		59.900	0.000	0.000	15.00	0.00	0.00	15.000	0.000	15.0	59.9	4.80	942
C	019 B	Square	work floor - top 15'		0.000	12.20	6.800	39.00	0.00	0.00	39.000	0.000	39.0	66.7	5.00	2,731
C	020	Square	work floor		0.000	11.00	3.400	53.00	0.00	0.00	53.000	0.000	53.0	30.1	2.50	1,635

Exam Date:09/02/2010

Farmers Elevator Company of Cooperstown
 Box 587
 Cooperstown , ND
 County:

Examiner: 1

Status	Section	Bin Number	Bin Type	Base Point	Diameter or Bu/Ft (Irreg).		Side wall	Add for Hopper	Ded. for Obst.	Effective Depth	Add for Peak	Depth for Capac.	Bushels per Foot	Base Pack%	Bushel Capacity with Pack
					Length	Width									

Facility: Cooperstown

Section: C

	C	021 T	Square	work floor	0.000	6.800	6.000	15.00	0.00	0.00	15.000	0.000	15.0	32.8	2.50	504
	C	021 B	Square	work floor - top 15'	0.000	9.800	6.800	39.00	0.00	0.00	39.000	0.000	39.0	53.6	4.50	2,184
	C	022 T	Square	work floor	0.000	4.200	4.000	29.00	0.00	0.00	29.000	0.000	29.0	13.5	2.00	400
	C	022 B	Square	work floor - top 29'	0.000	11.00	4.200	24.00	0.00	0.00	24.000	0.000	24.0	37.1	3.00	917
Added	C	118	Peaked	eave	16.000	0.000	0.000	20.00	0.00	0.00	20.000	1.000	21.0	161.6	5.80	3,591
	C	401	Quonset	u-trough to floor 20'	0.000	201.3	47.20	13.60	0.00	0.00	13.600	0.000	13.6	7190.9	10.0	107,577

Bin count: 31

Facility: Cooperstown Section: C Total: 181,304

To Even: 182,000

Section: D

Added	D	001	Peaked	top of sidewall	16.000	0.000	0.000	15.00	2.00	0.00	17.000	1.000	18.0	161.6	5.80	3,078
Added	D	002	Peaked	top of sidewall	16.000	0.000	0.000	15.00	2.00	0.00	17.000	1.000	18.0	161.6	5.80	3,078
Added	D	003	Peaked	top of sidewall	16.000	0.000	0.000	15.00	2.00	0.00	17.000	1.000	18.0	161.6	5.80	3,078
Added	D	004	Peaked	top of sidewall	16.000	0.000	0.000	15.00	2.00	0.00	17.000	1.000	18.0	161.6	5.80	3,078
	D	005	Peaked	top of sidewall	15.500	0.000	0.000	15.00	2.00	0.00	17.000	0.900	17.9	151.7	5.50	2,864
	D	006	Peaked	top of sidewall	15.500	0.000	0.000	15.00	2.00	0.00	17.000	0.900	17.9	151.7	5.50	2,864
	D	007	Peaked	top of sidewall	15.500	0.000	0.000	15.00	2.00	0.00	17.000	0.900	17.9	151.7	5.50	2,864
	D	008	Peaked	top of sidewall	13.500	0.000	0.000	12.50	2.00	0.00	14.500	0.800	15.3	115.1	5.20	1,853
	D	009	Peaked	top of sidewall	13.500	0.000	0.000	12.50	2.00	0.00	14.500	0.800	15.3	115.1	5.20	1,853
	D	010	Peaked	top of sidewall	13.500	0.000	0.000	12.50	2.00	0.00	14.500	0.800	15.3	115.1	5.20	1,853

Exam Date:09/02/2010

Farmers Elevator Company of Cooperstown
 Box 587
 Cooperstown , ND
 County:

Examiner: 1

Status	Section	Bin Number	Bin Type	Base Point	Diameter or Bu/Ft (Irreg).		Side wall	Add for Hopper	Ded. for Obst.	Effective Depth	Add for Peak	Depth for Capac.	Bushels per Foot	Base Pack%	Bushel Capacity with Pack
					Length	Width									

Facility: Cooperstown

Section: D

	D	011	Peaked	top of sidewall	13.500	0.000	0.000	12.50	2.00	0.00	14.500	0.800	15.3	115.1	5.20	1,853
	D	012	Peaked	top of sidewall	13.500	0.000	0.000	12.50	2.00	0.00	14.500	0.800	15.3	115.1	5.20	1,853
	D	013	Peaked	top of sidewall	13.500	0.000	0.000	12.50	2.00	0.00	14.500	0.800	15.3	115.1	5.20	1,853
Added	D	014	Peaked	top of sidewall	14.000	0.000	0.000	20.00	2.00	0.00	22.000	0.800	22.8	123.7	5.50	2,975
Added	D	015	Peaked	top of sidewall	14.000	0.000	0.000	20.00	2.00	0.00	22.000	0.800	22.8	123.7	5.50	2,975
Added	D	016	Peaked	top of sidewall	14.000	0.000	0.000	20.00	2.00	0.00	22.000	0.800	22.8	123.7	5.50	2,975
Added	D	017	Peaked	top of sidewall	14.000	0.000	0.000	20.00	2.00	0.00	22.000	0.800	22.8	123.7	5.50	2,975
	D	018	Peaked	top of sidewall	13.500	0.000	0.000	12.50	2.00	0.00	14.500	0.800	15.3	115.1	5.20	1,853
	D	019	Peaked	top of sidewall	13.500	0.000	0.000	12.50	2.00	0.00	14.500	0.800	15.3	115.1	5.20	1,853
	D	020	Peaked	top of sidewall	13.500	0.000	0.000	12.50	2.00	0.00	14.500	0.800	15.3	115.1	5.20	1,853

Bin count: 20

Facility: Cooperstown Section: D Total: 49,481

To Even: 50,000

Overall Licensed Bin Capacity for:

Farmers Elevator Company of Cooperstown

Bin count: 63


Licensed Capacity:
(includes pack)

911,751 Bu.



Licensed Capacity (to even):
(includes pack and section totals are rounded up to next highest 1000)

913,000 Bu.


FARMERS ELEVATOR CO. of COOPERSTOWN
COOPERSTOWN N.D.
SECTION D

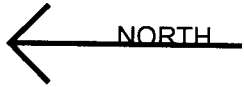

SECTION D
hopper tanks

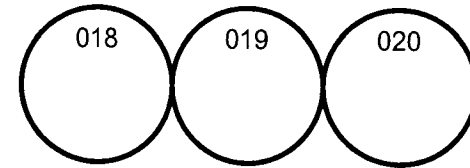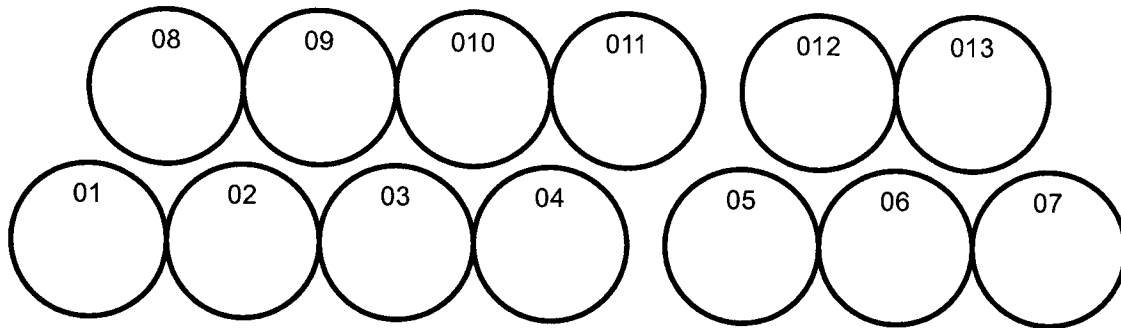

SECTION D
hopper tanks

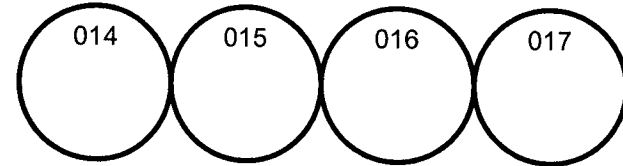

SECTION C #401
quonset 201.3' L x 47.2' W
bttm center u-trough to floor 20'

FARMERS ELEVATOR CO. of COOPERSTOWN
 COOPERSTOWN N.D.
 SECTION C

Annex TO BE DESTROYED

DELETED 06/2010		
305	303	301
306	304	302
DELETED 06/2010		

Elev. 3 TO BE DESTROYED

DELETED 06/2010		DELETED 06/2010	
204	205	206	207
203	209		210
DELETED 06/2010		DELETED 06/2010	
XXXXXX			
202	201		212
TB	DELETED 06/2010		

Elev. 2 TO BE DESTROYED

DELETED 06/2010		DELETED 06/2010	
106	105	104	103
107		102	
DELETED 06/2010		DELETED 06/2010	
XXXXXX			
DELETED 06/2010		DELETED 06/2010	
111	112	101	

Elev. 1

003
011
002

driveway

Feed Mill

SECTION C

FARMERS ELEVATOR CO. of COOPERSTOWN
 COOPERSTOWN N.D.

