

Exam Date:09/13/2010

North Central Grain Cooperative

Page: 1

Examiner: 1

PO Box 8

Bisbee , ND

County:

Phone: 701-656-3263

CCC Number:

| Location/Container Numbers/Comments | Section | Capacity |
|--|---------|----------|
| PART A - ADDITIONAL SPACE TO BE INCLUDED UNDER LICENSE | | |
| ground | X-1 | 99,477 |
| 201 | M | 50,648 |
| 202 | M | 50,648 |
| 048 | Y | 325,025 |
| 049 | Y | 325,025 |
| | Total: | 850,823 |

PART B - SPACE TO BE DELETED UNDER LICENSE

| | | |
|--------|--------|---------|
| 000 | W | 590 |
| 002 T | W | 2,337 |
| 002 B | W | 1,403 |
| 003 | W | 5,775 |
| 004 | W | 2,293 |
| 006 | W | 5,775 |
| 007 | W | 590 |
| 008 | W | 2,619 |
| 009 | W | 590 |
| 010 | W | 2,619 |
| 011 | W | 1,391 |
| 012 | W | 1,391 |
| 013 | W | 1,391 |
| 015 | W | 590 |
| 016 | W | 2,337 |
| 017 | W | 5,775 |
| 018 | W | 5,775 |
| 019 | W | 2,337 |
| 020 | W | 1,391 |
| ground | X | 328,940 |
| | Total: | 375,909 |

PART C - ALL SPACE TO BE INCLUDED UNDER LICENSE

| | |
|-----|-----------|
| D | 260,000 |
| E | 165,000 |
| G | 32,000 |
| H | 32,000 |
| I | 33,000 |
| K | 44,000 |
| M | 241,000 |
| Q | 102,000 |
| W | 62,000 |
| X-1 | 100,000 |
| Y | 2,756,000 |

| Location/Container Numbers/Comments | Section | Capacity |
|-------------------------------------|---------|-----------|
| | Z | 33,000 |
| | Total: | 3,860,000 |

PART D - TOTAL CAPACITY BY FUNCTIONAL UNIT

| | | |
|--------------|-----------------|-----------|
| Bisbee 630 | W Y Z | 2,851,000 |
| Perth 628 | Q | 102,000 |
| Rock Lake 25 | D E G H I K X-1 | 666,000 |
| Rolette 568 | M | 241,000 |
| | Total: | 3,860,000 |

Exam Date:09/13/2010

North Central Grain Cooperative

Page: 1

Examiner: 1

PO Box 8
Bisbee, ND
County:

| Status | Section | Bin Number | Bin Type | Base Point | Diameter or Bu/Ft (Irreg). | Length | Width | Side wall | Add for Hopper | Ded. for Obst. | Effective Depth | Add for Peak | Depth for Capac. | Bushels per Foot | Base Pack% | Bushel Capacity with Pack |
|--------|---------|------------|----------|------------|-------------------------------|--------|-------|--------------|----------------------|----------------------|--------------------|--------------------|------------------------|------------------------|---------------|------------------------------|
|--------|---------|------------|----------|------------|-------------------------------|--------|-------|--------------|----------------------|----------------------|--------------------|--------------------|------------------------|------------------------|---------------|------------------------------|

Facility: Bisbee

Section: W

| | | | | | | | | | | | | | | | | |
|---|-----|--------|-----------------|--|--------|-------|-------|-------|------|------|--------|-------|------|-------|------|--------|
| W | 201 | Peaked | top of sidewall | | 26.900 | 0.000 | 0.000 | 39.60 | 0.00 | 0.00 | 39.600 | 1.600 | 41.2 | 456.9 | 8.50 | 20,424 |
| W | 202 | Peaked | top of sidewall | | 26.900 | 0.000 | 0.000 | 39.60 | 0.00 | 0.00 | 39.600 | 1.600 | 41.2 | 456.9 | 8.50 | 20,424 |
| W | 203 | Peaked | top of sidewall | | 26.900 | 0.000 | 0.000 | 39.60 | 0.00 | 0.00 | 39.600 | 1.600 | 41.2 | 456.9 | 8.50 | 20,424 |

Bin count: 3

Facility: Bisbee Section: W Total: **61,272**To Even: **62,000**

Section: Y

| | | | | | | | | | | | | | | | | |
|---|-----|-----------|------------------------|--|--------|-------|-------|-------|------|------|--------|-------|-------|-------|------|--------|
| Y | 001 | Round | top of slab | | 30.000 | 0.000 | 0.000 | 125.8 | 0.00 | 0.00 | 125.80 | 0.000 | 125.8 | 568.2 | 9.00 | 77,913 |
| Y | 002 | Round | top of slab | | 30.000 | 0.000 | 0.000 | 125.8 | 0.00 | 0.00 | 125.80 | 0.000 | 125.8 | 568.2 | 9.00 | 77,913 |
| Y | 003 | Round | top of slab | | 30.000 | 0.000 | 0.000 | 124.0 | 0.00 | 0.00 | 124.00 | 0.000 | 124.0 | 568.2 | 9.00 | 76,798 |
| Y | 004 | Round | top of slab | | 30.000 | 0.000 | 0.000 | 120.5 | 0.00 | 0.00 | 120.50 | 0.000 | 120.5 | 568.2 | 9.00 | 74,630 |
| Y | 005 | Irregular | top of slab-interstice | | 61.000 | 0.000 | 0.000 | 92.00 | 0.00 | 0.00 | 92.000 | 0.000 | 92.0 | 61.0 | 4.80 | 5,881 |
| Y | 006 | Irregular | top of slab-interstice | | 61.000 | 0.000 | 0.000 | 92.00 | 0.00 | 0.00 | 92.000 | 0.000 | 92.0 | 61.0 | 4.80 | 5,881 |
| Y | 007 | Irregular | top of slab-interstice | | 56.700 | 0.000 | 0.000 | 99.00 | 0.00 | 0.00 | 99.000 | 0.000 | 99.0 | 56.7 | 4.80 | 5,882 |
| Y | 008 | Irregular | top of slab-interstice | | 56.700 | 0.000 | 0.000 | 99.00 | 0.00 | 0.00 | 99.000 | 0.000 | 99.0 | 56.7 | 4.80 | 5,882 |
| Y | 009 | Irregular | top of slab-interstice | | 59.600 | 0.000 | 0.000 | 99.00 | 0.00 | 0.00 | 99.000 | 0.000 | 99.0 | 59.6 | 4.80 | 6,183 |
| Y | 010 | Irregular | top of slab-interstice | | 59.600 | 0.000 | 0.000 | 99.00 | 0.00 | 0.00 | 99.000 | 0.000 | 99.0 | 59.6 | 4.80 | 6,183 |
| Y | 011 | Irregular | top of slab-interstice | | 69.700 | 0.000 | 0.000 | 99.00 | 0.00 | 0.00 | 99.000 | 0.000 | 99.0 | 69.7 | 5.20 | 7,259 |
| Y | 012 | Irregular | top of slab-interstice | | 68.700 | 0.000 | 0.000 | 99.00 | 0.00 | 0.00 | 99.000 | 0.000 | 99.0 | 68.7 | 5.20 | 7,155 |
| Y | 013 | Irregular | top of slab-interstice | | 68.700 | 0.000 | 0.000 | 99.00 | 0.00 | 0.00 | 99.000 | 0.000 | 99.0 | 68.7 | 5.20 | 7,155 |

Exam Date:09/13/2010

North Central Grain Cooperative

Page: 2

Examiner: 1

PO Box 8
Bisbee , ND
County:

| Status | Section | Bin Number | Bin Type | Base Point | Diameter or Bu/Ft (Irreg). | | Side wall | Add for Hopper | Ded. for Obst. | Effective Depth | Add for Peak | Depth for Capac. | Bushels per Foot | Base Pack% | Bushel Capacity with Pack |
|--------|---------|------------|----------|------------|-------------------------------|-------|--------------|----------------------|----------------------|--------------------|--------------------|------------------------|------------------------|---------------|------------------------------|
| | | | | | Length | Width | | | | | | | | | |

Facility: Bisbee

Section: Y

| | | | | | | | | | | | | | | | |
|---|-----|-----------|------------------------|--------|-------|-------|-------|------|------|--------|-------|-------|-------|------|--------|
| Y | 014 | Irregular | top of slab-interstice | 69.700 | 0.000 | 0.000 | 99.00 | 0.00 | 0.00 | 99.000 | 0.000 | 99.0 | 69.7 | 5.20 | 7,259 |
| Y | 015 | Irregular | top of slab-interstice | 94.500 | 0.000 | 0.000 | 44.00 | 0.00 | 0.00 | 44.000 | 0.000 | 44.0 | 94.5 | 6.00 | 4,407 |
| Y | 016 | Irregular | top of slab-interstice | 94.500 | 0.000 | 0.000 | 44.00 | 0.00 | 0.00 | 44.000 | 0.000 | 44.0 | 94.5 | 6.00 | 4,407 |
| Y | 017 | Irregular | top of slab-interstice | 74.500 | 0.000 | 0.000 | 46.00 | 0.00 | 0.00 | 46.000 | 0.000 | 46.0 | 74.5 | 5.50 | 3,615 |
| Y | 025 | Round | top of slab | 30.100 | 0.000 | 0.000 | 125.0 | 0.00 | 0.00 | 125.00 | 0.000 | 125.0 | 572.0 | 9.00 | 77,935 |
| Y | 026 | Round | top of slab | 30.100 | 0.000 | 0.000 | 125.0 | 0.00 | 0.00 | 125.00 | 0.000 | 125.0 | 572.0 | 9.00 | 77,935 |
| Y | 027 | Round | top of slab | 30.100 | 0.000 | 0.000 | 125.0 | 0.00 | 0.00 | 125.00 | 0.000 | 125.0 | 572.0 | 9.00 | 77,935 |
| Y | 028 | Round | top of slab | 30.100 | 0.000 | 0.000 | 125.0 | 0.00 | 0.00 | 125.00 | 0.000 | 125.0 | 572.0 | 9.00 | 77,935 |
| Y | 029 | Round | top of slab | 30.100 | 0.000 | 0.000 | 125.0 | 0.00 | 0.00 | 125.00 | 0.000 | 125.0 | 572.0 | 9.00 | 77,935 |
| Y | 030 | Round | top of slab | 30.100 | 0.000 | 0.000 | 125.0 | 0.00 | 0.00 | 125.00 | 0.000 | 125.0 | 572.0 | 9.00 | 77,935 |
| Y | 031 | Round | top of slab | 30.100 | 0.000 | 0.000 | 125.0 | 0.00 | 0.00 | 125.00 | 0.000 | 125.0 | 572.0 | 9.00 | 77,935 |
| Y | 032 | Round | top of slab | 30.100 | 0.000 | 0.000 | 125.0 | 0.00 | 0.00 | 125.00 | 0.000 | 125.0 | 572.0 | 9.00 | 77,935 |
| Y | 033 | Irregular | top of slab-interstice | 144.30 | 0.000 | 0.000 | 126.0 | 0.00 | 0.00 | 126.00 | 0.000 | 126.0 | 144.3 | 6.80 | 19,418 |
| Y | 034 | Irregular | top of slab-interstice | 144.30 | 0.000 | 0.000 | 126.0 | 0.00 | 0.00 | 126.00 | 0.000 | 126.0 | 144.3 | 6.80 | 19,418 |
| Y | 035 | Irregular | top of slab-interstice | 144.30 | 0.000 | 0.000 | 126.0 | 0.00 | 0.00 | 126.00 | 0.000 | 126.0 | 144.3 | 6.80 | 19,418 |
| Y | 036 | Round | top of slab | 30.000 | 0.000 | 0.000 | 128.7 | 0.00 | 0.00 | 128.70 | 0.000 | 128.7 | 568.2 | 9.00 | 79,708 |
| Y | 037 | Round | top of slab | 30.000 | 0.000 | 0.000 | 128.7 | 0.00 | 0.00 | 128.70 | 0.000 | 128.7 | 568.2 | 9.00 | 79,708 |
| Y | 038 | Round | top of slab | 30.000 | 0.000 | 0.000 | 128.7 | 0.00 | 0.00 | 128.70 | 0.000 | 128.7 | 568.2 | 9.00 | 79,708 |
| Y | 039 | Round | top of slab | 30.000 | 0.000 | 0.000 | 128.7 | 0.00 | 0.00 | 128.70 | 0.000 | 128.7 | 568.2 | 9.00 | 79,708 |
| Y | 040 | Round | top of slab | 30.000 | 0.000 | 0.000 | 128.7 | 0.00 | 0.00 | 128.70 | 0.000 | 128.7 | 568.2 | 9.00 | 79,708 |
| Y | 041 | Round | top of slab | 30.000 | 0.000 | 0.000 | 128.7 | 0.00 | 0.00 | 128.70 | 0.000 | 128.7 | 568.2 | 9.00 | 79,708 |

NDPSC Bin Capacity Chart

Exam Date:09/13/2010

North Central Grain Cooperative

Page: 3

Examiner: 1

PO Box 8
Bisbee , ND
County:

| Status | Section | Bin Number | Bin Type | Base Point | Diameter or Bu/Ft (Irreg). | Length | Width | Side wall | Add for Hopper | Ded. for Obst. | Effective Depth | Add for Peak | Depth for Capac. | Bushels per Foot | Base Pack% | Bushel Capacity with Pack |
|--------|---------|------------|----------|------------|-------------------------------|--------|-------|--------------|----------------------|----------------------|--------------------|--------------------|------------------------|------------------------|---------------|------------------------------|
|--------|---------|------------|----------|------------|-------------------------------|--------|-------|--------------|----------------------|----------------------|--------------------|--------------------|------------------------|------------------------|---------------|------------------------------|

Facility: Bisbee**Section: Y**

| | | | | | | | | | | | | | | | | |
|-------|---|-----|-----------|-------------------------|--------|-------|-------|-------|------|------|--------|-------|-------|--------|------|---------|
| | Y | 042 | Round | top of slab | 30.000 | 0.000 | 0.000 | 128.7 | 0.00 | 0.00 | 128.70 | 0.000 | 128.7 | 568.2 | 9.00 | 79,708 |
| | Y | 043 | Round | top of slab | 30.000 | 0.000 | 0.000 | 128.7 | 0.00 | 0.00 | 128.70 | 0.000 | 128.7 | 568.2 | 9.00 | 79,708 |
| | Y | 044 | Irregular | top of slab-interstice | 52.700 | 0.000 | 0.000 | 128.0 | 0.00 | 0.00 | 128.00 | 0.000 | 128.0 | 52.7 | 4.50 | 7,050 |
| | Y | 045 | Irregular | top of slab-interstice | 138.40 | 0.000 | 0.000 | 127.0 | 0.00 | 0.00 | 127.00 | 0.000 | 127.0 | 138.4 | 6.50 | 18,720 |
| | Y | 046 | Irregular | top of slab-interstice | 138.40 | 0.000 | 0.000 | 127.0 | 0.00 | 0.00 | 127.00 | 0.000 | 127.0 | 138.4 | 6.50 | 18,720 |
| | Y | 047 | Irregular | top of slab-interstice | 138.40 | 0.000 | 0.000 | 127.0 | 0.00 | 0.00 | 127.00 | 0.000 | 127.0 | 138.4 | 6.50 | 18,720 |
| Added | Y | 048 | Round | silos - bottom of slab | 60.000 | 0.000 | 0.000 | 130.0 | 0.00 | 0.00 | 130.00 | 0.000 | 130.0 | 2272.9 | 10.0 | 325,025 |
| Added | Y | 049 | Round | silos - bottom of slab | 60.000 | 0.000 | 0.000 | 130.0 | 0.00 | 0.00 | 130.00 | 0.000 | 130.0 | 2272.9 | 10.0 | 325,025 |
| | Y | 101 | Peaked | top of sidewall at eave | 47.800 | 0.000 | 0.000 | 31.60 | 0.00 | 0.00 | 31.600 | 2.900 | 34.5 | 1442.5 | 10.0 | 54,743 |
| | Y | 102 | Peaked | top of sidewall at eave | 47.800 | 0.000 | 0.000 | 31.60 | 0.00 | 0.00 | 31.600 | 2.900 | 34.5 | 1442.5 | 10.0 | 54,743 |
| | Y | 103 | Peaked | top of sidewall at eave | 47.800 | 0.000 | 0.000 | 31.60 | 0.00 | 0.00 | 31.600 | 2.900 | 34.5 | 1442.5 | 10.0 | 54,743 |
| | Y | 104 | Peaked | top of sidewall at eave | 47.800 | 0.000 | 0.000 | 31.60 | 0.00 | 0.00 | 31.600 | 2.900 | 34.5 | 1442.5 | 10.0 | 54,743 |
| | Y | 105 | Peaked | top of sidewall at eave | 47.800 | 0.000 | 0.000 | 31.60 | 0.00 | 0.00 | 31.600 | 2.900 | 34.5 | 1442.5 | 10.0 | 54,743 |
| | Y | 106 | Peaked | top of sidewall at eave | 47.800 | 0.000 | 0.000 | 31.60 | 0.00 | 0.00 | 31.600 | 2.900 | 34.5 | 1442.5 | 10.0 | 54,743 |
| | Y | 107 | Peaked | top of sidewall at eave | 16.000 | 0.000 | 0.000 | 25.00 | 2.00 | 0.00 | 27.000 | 1.000 | 28.0 | 161.6 | 5.80 | 4,787 |
| | Y | 108 | Peaked | top of sidewall at eave | 16.000 | 0.000 | 0.000 | 25.00 | 2.00 | 0.00 | 27.000 | 1.000 | 28.0 | 161.6 | 5.80 | 4,787 |

Bin count: 50

Facility: Bisbee Section: Y Total: 2,755,093

To Even: 2,756,000

Exam Date:09/13/2010

North Central Grain Cooperative
 PO Box 8
 Bisbee , ND
 County:

Examiner: 1

| Status | Section | Bin Number | Bin Type | Base Point | Diameter or Bu/Ft (Irreg.) Length | Width | Side wall | Add for Hopper | Ded. for Obst. | Effective Depth | Add for Peak | Depth for Capac. | Bushels per Foot | Base Pack% | Bushel Capacity with Pack |
|--------|---------|------------|----------|------------|---|-------|--------------|----------------------|----------------------|--------------------|--------------------|------------------------|------------------------|---------------|------------------------------|
|--------|---------|------------|----------|------------|---|-------|--------------|----------------------|----------------------|--------------------|--------------------|------------------------|------------------------|---------------|------------------------------|

Facility: Bisbee

Section: Z

| | | | | | | | | | | | | | | | | |
|---|-----|--------|-----------------------------|--|--------|-------|-------|-------|------|------|--------|-------|------|-------|------|-------|
| Z | 001 | Peaked | top of sidewall | | 16.000 | 0.000 | 0.000 | 22.90 | 0.00 | 0.00 | 22.900 | 1.000 | 23.9 | 161.6 | 5.80 | 4,086 |
| Z | 002 | Peaked | top of sidewall | | 16.000 | 0.000 | 0.000 | 22.90 | 0.00 | 0.00 | 22.900 | 1.000 | 23.9 | 161.6 | 5.80 | 4,086 |
| Z | 003 | Peaked | top of sidewall | | 16.000 | 0.000 | 0.000 | 22.90 | 0.00 | 0.00 | 22.900 | 1.000 | 23.9 | 161.6 | 5.80 | 4,086 |
| Z | 004 | Peaked | top of sidewall | | 16.000 | 0.000 | 0.000 | 22.90 | 0.00 | 0.00 | 22.900 | 1.000 | 23.9 | 161.6 | 5.80 | 4,086 |
| Z | 005 | Peaked | top sdewall - door 5' above | | 15.500 | 0.000 | 0.000 | 22.50 | 2.30 | 0.00 | 24.800 | 0.900 | 25.7 | 151.7 | 5.50 | 4,113 |
| Z | 006 | Peaked | top sdewall - door 5' above | | 15.500 | 0.000 | 0.000 | 22.50 | 2.30 | 0.00 | 24.800 | 0.900 | 25.7 | 151.7 | 5.50 | 4,113 |
| Z | 007 | Peaked | top sdewall - door 5' above | | 15.500 | 0.000 | 0.000 | 22.50 | 2.30 | 0.00 | 24.800 | 0.900 | 25.7 | 151.7 | 5.50 | 4,113 |
| Z | 008 | Peaked | top sdewall - door 5' above | | 15.500 | 0.000 | 0.000 | 22.50 | 2.30 | 0.00 | 24.800 | 0.900 | 25.7 | 151.7 | 5.50 | 4,113 |

Bin count: 8

Facility: Bisbee Section: Z Total: 32,796

To Even: 33,000

Exam Date:09/13/2010

North Central Grain Cooperative

Page: 5

Examiner: 1

PO Box 8
Bisbee , ND
County:

| Status | Section | Bin Number | Bin Type | Base Point | Diameter or Bu/Ft (Irreg). | Length | Width | Side wall | Add for Hopper | Ded. for Obst. | Effective Depth | Add for Peak | Depth for Capac. | Bushels per Foot | Base Pack% | Bushel Capacity with Pack |
|--------|---------|------------|----------|------------|-------------------------------|--------|-------|--------------|----------------------|----------------------|--------------------|--------------------|------------------------|------------------------|---------------|------------------------------|
|--------|---------|------------|----------|------------|-------------------------------|--------|-------|--------------|----------------------|----------------------|--------------------|--------------------|------------------------|------------------------|---------------|------------------------------|

Facility: Perth

Section: Q

| | | | | | | | | | | | | | | | | |
|---|-------|-----------|------------------------------|--|--------|-------|-------|-------|------|------|--------|-------|------|-------|------|-------|
| Q | 003 T | Square | work floor | | 0.000 | 11.30 | 13.70 | 53.00 | 0.00 | 0.00 | 53.000 | 0.000 | 53.0 | 124.4 | 6.50 | 7,022 |
| Q | 003 B | Square | work floor - top 53' | | 0.000 | 10.60 | 18.50 | 18.00 | 0.00 | 0.00 | 18.000 | 0.000 | 18.0 | 157.6 | 7.00 | 3,036 |
| Q | 004 T | Square | work floor | | 0.000 | 13.70 | 4.200 | 29.00 | 0.00 | 0.00 | 29.000 | 0.000 | 29.0 | 46.3 | 4.00 | 1,397 |
| Q | 004 M | Square | work floor - top 29' | | 0.000 | 11.40 | 13.70 | 24.00 | 0.00 | 0.00 | 24.000 | 0.000 | 24.0 | 125.5 | 6.50 | 3,208 |
| Q | 004B | Square | work floor -top & middle 53' | | 0.000 | 10.60 | 18.50 | 18.00 | 0.00 | 0.00 | 18.000 | 0.000 | 18.0 | 157.6 | 7.00 | 3,036 |
| Q | 005 | Square | work floor | | 0.000 | 13.20 | 12.10 | 62.00 | 0.00 | 0.00 | 62.000 | 0.000 | 62.0 | 128.4 | 6.50 | 8,478 |
| Q | 007 | Square | work floor | | 0.000 | 13.70 | 12.10 | 52.00 | 0.00 | 0.00 | 52.000 | 0.000 | 52.0 | 133.3 | 6.50 | 7,383 |
| Q | 008 | Square | work floor | | 0.000 | 3.800 | 7.400 | 54.00 | 0.00 | 0.00 | 54.000 | 0.000 | 54.0 | 22.6 | 2.00 | 1,244 |
| Q | 009 T | Square | work floor | | 0.000 | 13.20 | 11.30 | 62.00 | 0.00 | 0.00 | 62.000 | 0.000 | 62.0 | 119.9 | 6.20 | 7,895 |
| Q | 009 B | Square | work floor -top 62' | | 0.000 | 14.80 | 13.20 | 7.000 | 0.00 | 0.00 | 7.000 | 0.000 | 7.0 | 157.0 | 6.80 | 1,174 |
| Q | 010 T | Square | work floor | | 0.000 | 11.40 | 13.20 | 62.00 | 0.00 | 0.00 | 62.000 | 0.000 | 62.0 | 121.0 | 6.50 | 7,990 |
| Q | 010 B | Square | work floor -top 62' | | 0.000 | 14.70 | 13.20 | 7.000 | 0.00 | 0.00 | 7.000 | 0.000 | 7.0 | 156.0 | 6.80 | 1,166 |
| Q | 012 | Square | work floor | | 0.000 | 13.70 | 6.600 | 29.00 | 0.00 | 0.00 | 29.000 | 0.000 | 29.0 | 72.7 | 5.20 | 2,218 |
| Q | 013 T | Square | work floor | | 0.000 | 11.30 | 11.20 | 62.00 | 0.00 | 0.00 | 62.000 | 0.000 | 62.0 | 101.7 | 6.00 | 6,683 |
| Q | 013 B | Square | work floor - top 62' | | 0.000 | 14.80 | 10.70 | 10.00 | 0.00 | 0.00 | 10.000 | 0.000 | 10.0 | 127.3 | 6.50 | 1,356 |
| Q | 014 | Square | work floor | | 0.000 | 7.200 | 3.800 | 54.00 | 0.00 | 0.00 | 54.000 | 0.000 | 54.0 | 22.0 | 2.00 | 1,212 |
| Q | 015 T | Irregular | work floor 11.3x7.2 less | | 30.100 | 0.000 | 0.000 | 13.00 | 0.00 | 0.00 | 13.000 | 0.000 | 13.0 | 30.1 | 2.50 | 401 |
| Q | 015 B | Square | work floor -top 13' | | 0.000 | 11.30 | 7.200 | 39.00 | 0.00 | 0.00 | 39.000 | 0.000 | 39.0 | 65.4 | 5.00 | 2,679 |
| Q | 016 | Square | work floor | | 0.000 | 11.40 | 4.200 | 53.00 | 0.00 | 0.00 | 53.000 | 0.000 | 53.0 | 38.5 | 3.00 | 2,102 |
| Q | 017 | Square | work floor | | 0.000 | 12.10 | 11.20 | 62.00 | 0.00 | 0.00 | 62.000 | 0.000 | 62.0 | 108.9 | 6.20 | 7,171 |
| Q | 018 T | Square | work floor | | 0.000 | 11.40 | 11.20 | 62.00 | 0.00 | 0.00 | 62.000 | 0.000 | 62.0 | 102.6 | 6.00 | 6,743 |

Exam Date:09/13/2010

North Central Grain Cooperative

Page: 6

Examiner: 1

PO Box 8
Bisbee , ND
County:

| Status | Section | Bin Number | Bin Type | Base Point | Diameter or Bu/Ft (Irreg.) | Length | Width | Side wall | Add for Hopper | Ded. for Obst. | Effective Depth | Add for Peak | Depth for Capac. | Bushels per Foot | Base Pack% | Bushel Capacity with Pack |
|--------|---------|------------|----------|------------|-------------------------------|--------|-------|--------------|----------------------|----------------------|--------------------|--------------------|------------------------|------------------------|---------------|------------------------------|
|--------|---------|------------|----------|------------|-------------------------------|--------|-------|--------------|----------------------|----------------------|--------------------|--------------------|------------------------|------------------------|---------------|------------------------------|

Facility: Perth

Section: Q

| | | | | | | | | | | | | | | | |
|---|-------|--------|----------------------|-------|-------|-------|-------|------|------|--------|-------|------|-------|------|-------|
| Q | 018 B | Square | work floor - top 62' | 0.000 | 14.70 | 10.70 | 10.00 | 0.00 | 0.00 | 10.000 | 0.000 | 10.0 | 126.4 | 6.50 | 1,346 |
| Q | 019 | Square | work floor | 0.000 | 11.30 | 4.200 | 52.00 | 0.00 | 0.00 | 52.000 | 0.000 | 52.0 | 38.2 | 3.00 | 2,046 |
| Q | 020 | Square | work floor | 0.000 | 5.700 | 4.200 | 55.00 | 0.00 | 0.00 | 55.000 | 0.000 | 55.0 | 19.2 | 2.00 | 1,077 |
| Q | 021 | Square | work floor | 0.000 | 11.30 | 7.400 | 52.00 | 0.00 | 0.00 | 52.000 | 0.000 | 52.0 | 67.2 | 5.20 | 3,676 |
| Q | 022 | Square | work floor | 0.000 | 12.10 | 7.200 | 55.00 | 0.00 | 0.00 | 55.000 | 0.000 | 55.0 | 70.0 | 5.20 | 4,050 |
| Q | 023 | Square | work floor | 0.000 | 6.000 | 4.200 | 55.00 | 0.00 | 0.00 | 55.000 | 0.000 | 55.0 | 20.3 | 2.00 | 1,139 |
| Q | 024 | Square | work floor | 0.000 | 12.10 | 7.400 | 55.00 | 0.00 | 0.00 | 55.000 | 0.000 | 55.0 | 72.0 | 5.20 | 4,166 |

Bin count: 28

Facility: Perth Section: Q Total: 101,094

To Even: 102,000

Exam Date:09/13/2010

North Central Grain Cooperative
PO Box 8
Bisbee , ND
County:

Page: 7

Examiner: 1

| Status | Section | Bin Number | Bin Type | Base Point | Diameter or Bu/Ft (Irreg). | Length | Width | Side wall | Add for Hopper | Ded. for Obst. | Effective Depth | Add for Peak | Depth for Capac. | Bushels per Foot | Base Pack% | Bushel Capacity with Pack |
|--------|---------|------------|----------|------------|-------------------------------|--------|-------|--------------|----------------------|----------------------|--------------------|--------------------|------------------------|------------------------|---------------|------------------------------|
|--------|---------|------------|----------|------------|-------------------------------|--------|-------|--------------|----------------------|----------------------|--------------------|--------------------|------------------------|------------------------|---------------|------------------------------|

Facility: Rock Lake

Section: D

| | | | | | | | | | | | | | | | | |
|---|-------|-----------|-------------------------|--|--------|-------|-------|-------|------|------|--------|-------|------|------|------|-------|
| D | 002 T | Square | work floor | | 0.000 | 4.000 | 3.500 | 35.00 | 0.00 | 0.00 | 35.000 | 0.000 | 35.0 | 11.3 | 2.00 | 404 |
| D | 002 B | Square | work floor -top 35' | | 0.000 | 9.500 | 3.500 | 11.00 | 0.00 | 0.00 | 11.000 | 0.000 | 11.0 | 26.7 | 2.50 | 301 |
| D | 003 | Square | work floor | | 0.000 | 5.000 | 3.500 | 35.00 | 0.00 | 0.00 | 35.000 | 0.000 | 35.0 | 14.1 | 2.00 | 504 |
| D | 005 | Square | work floor | | 0.000 | 12.80 | 9.500 | 65.00 | 0.00 | 0.00 | 65.000 | 0.000 | 65.0 | 97.7 | 6.00 | 6,732 |
| D | 006 | Square | work floor | | 0.000 | 12.80 | 9.500 | 65.00 | 0.00 | 0.00 | 65.000 | 0.000 | 65.0 | 97.7 | 6.00 | 6,732 |
| D | 007 | Square | work floor | | 0.000 | 12.80 | 9.500 | 64.00 | 0.00 | 0.00 | 64.000 | 0.000 | 64.0 | 97.7 | 6.00 | 6,628 |
| D | 008 | Square | work floor | | 0.000 | 9.500 | 6.200 | 50.00 | 0.00 | 0.00 | 50.000 | 0.000 | 50.0 | 47.3 | 4.00 | 2,460 |
| D | 010 | Square | work floor | | 0.000 | 9.500 | 6.200 | 50.00 | 0.00 | 0.00 | 50.000 | 0.000 | 50.0 | 47.3 | 4.00 | 2,460 |
| D | 011 | Square | work floor | | 0.000 | 9.500 | 6.200 | 50.00 | 0.00 | 0.00 | 50.000 | 0.000 | 50.0 | 47.3 | 4.00 | 2,460 |
| D | 012 | Square | work floor | | 0.000 | 12.70 | 9.500 | 65.00 | 0.00 | 0.00 | 65.000 | 0.000 | 65.0 | 97.0 | 6.00 | 6,683 |
| D | 013 | Square | work floor | | 0.000 | 12.70 | 9.500 | 65.00 | 0.00 | 0.00 | 65.000 | 0.000 | 65.0 | 97.0 | 6.00 | 6,683 |
| D | 015 | Square | work floor | | 0.000 | 9.500 | 6.200 | 50.00 | 0.00 | 0.00 | 50.000 | 0.000 | 50.0 | 47.3 | 4.00 | 2,460 |
| D | 017 | Square | work floor | | 0.000 | 12.70 | 9.500 | 65.00 | 0.00 | 0.00 | 65.000 | 0.000 | 65.0 | 97.0 | 6.00 | 6,683 |
| D | 018 | Square | work floor | | 0.000 | 9.500 | 3.500 | 50.00 | 0.00 | 0.00 | 50.000 | 0.000 | 50.0 | 26.7 | 2.50 | 1,368 |
| D | 100 | Square | work floor | | 0.000 | 10.20 | 5.500 | 10.00 | 0.00 | 0.00 | 10.000 | 0.000 | 10.0 | 45.1 | 4.00 | 469 |
| D | 102 | Square | work floor | | 0.000 | 9.500 | 3.500 | 34.00 | 0.00 | 0.00 | 34.000 | 0.000 | 34.0 | 26.7 | 2.50 | 931 |
| D | 103 | Square | work floor | | 0.000 | 10.20 | 9.500 | 50.00 | 0.00 | 0.00 | 50.000 | 0.000 | 50.0 | 77.9 | 5.50 | 4,109 |
| D | 105 T | Irregular | work floor 9.7x6.5 less | | 25.600 | 0.000 | 0.000 | 7.000 | 0.00 | 0.00 | 7.000 | 0.000 | 7.0 | 25.6 | 2.50 | 183 |
| D | 105 B | Square | work floor - top 7' | | 0.000 | 9.700 | 6.500 | 28.00 | 0.00 | 0.00 | 28.000 | 0.000 | 28.0 | 50.7 | 4.50 | 1,484 |
| D | 106 | Square | work floor | | 0.000 | 10.20 | 9.700 | 50.00 | 0.00 | 0.00 | 50.000 | 0.000 | 50.0 | 79.5 | 5.50 | 4,194 |
| D | 107 | Square | work floor | | 0.000 | 10.20 | 9.500 | 50.00 | 0.00 | 0.00 | 50.000 | 0.000 | 50.0 | 77.9 | 5.50 | 4,109 |

Exam Date:09/13/2010

North Central Grain Cooperative

Page: 8

Examiner: 1

PO Box 8
Bisbee , ND
County:

| Status | Section | Bin Number | Bin Type | Base Point | Diameter or Bu/Ft (Irreg). | | Side wall | Add for Hopper | Ded. for Obst. | Effective Depth | Add for Peak | Depth for Capac. | Bushels per Foot | Base Pack% | Bushel Capacity with Pack |
|--------|---------|------------|----------|------------|-------------------------------|-------|--------------|----------------------|----------------------|--------------------|--------------------|------------------------|------------------------|---------------|------------------------------|
| | | | | | Length | Width | | | | | | | | | |

Facility: Rock Lake

Section: D

| | | | | | | | | | | | | | | | | |
|---|-------|--------|-------------------------|--|--------|-------|-------|-------|------|------|--------|-------|------|-------|------|--------|
| D | 109 | Square | work floor | | 0.000 | 9.500 | 6.500 | 35.00 | 0.00 | 0.00 | 35.000 | 0.000 | 35.0 | 49.6 | 4.20 | 1,809 |
| D | 110 | Square | work floor | | 0.000 | 9.500 | 6.200 | 35.00 | 0.00 | 0.00 | 35.000 | 0.000 | 35.0 | 47.3 | 4.00 | 1,722 |
| D | 111 | Square | work floor | | 0.000 | 10.20 | 9.500 | 50.00 | 0.00 | 0.00 | 50.000 | 0.000 | 50.0 | 77.9 | 5.50 | 4,109 |
| D | 112 | Square | work floor | | 0.000 | 9.700 | 6.200 | 35.00 | 0.00 | 0.00 | 35.000 | 0.000 | 35.0 | 48.3 | 4.20 | 1,762 |
| D | 114 | Square | work floor | | 0.000 | 10.20 | 9.700 | 48.00 | 0.00 | 0.00 | 48.000 | 0.000 | 48.0 | 79.5 | 5.50 | 4,026 |
| D | 116 T | Square | work floor | | 0.000 | 10.20 | 4.000 | 10.00 | 0.00 | 0.00 | 10.000 | 0.000 | 10.0 | 32.8 | 2.50 | 336 |
| D | 116 B | Square | work floor -top 10' | | 0.000 | 10.20 | 9.500 | 40.00 | 0.00 | 0.00 | 40.000 | 0.000 | 40.0 | 77.9 | 5.50 | 3,287 |
| D | 118 | Square | work floor | | 0.000 | 4.500 | 3.500 | 34.00 | 0.00 | 0.00 | 34.000 | 0.000 | 34.0 | 12.7 | 2.00 | 441 |
| D | 201 | Round | roof hatch -round or | | 15.500 | 0.000 | 0.000 | 64.00 | 0.00 | 0.00 | 64.000 | 0.000 | 64.0 | 151.7 | 5.50 | 10,243 |
| D | 202 | Round | roof hatch -round or | | 15.500 | 0.000 | 0.000 | 64.00 | 0.00 | 0.00 | 64.000 | 0.000 | 64.0 | 151.7 | 5.50 | 10,243 |
| D | 203 | Round | roof hatch -round or | | 18.500 | 0.000 | 0.000 | 64.00 | 0.00 | 0.00 | 64.000 | 0.000 | 64.0 | 216.1 | 6.20 | 14,687 |
| D | 204 | Round | roof hatch -round or | | 18.500 | 0.000 | 0.000 | 64.00 | 0.00 | 0.00 | 64.000 | 0.000 | 64.0 | 216.1 | 6.20 | 14,687 |
| D | 205 | Round | roof hatch -round or | | 18.500 | 0.000 | 0.000 | 64.00 | 0.00 | 0.00 | 64.000 | 0.000 | 64.0 | 216.1 | 6.20 | 14,687 |
| D | 206 | Round | roof hatch -round or | | 18.500 | 0.000 | 0.000 | 64.00 | 0.00 | 0.00 | 64.000 | 0.000 | 64.0 | 216.1 | 6.20 | 14,687 |
| D | 207 | Round | roof hatch -round or | | 18.500 | 0.000 | 0.000 | 64.00 | 0.00 | 0.00 | 64.000 | 0.000 | 64.0 | 216.1 | 6.20 | 14,687 |
| D | 208 | Round | roof hatch -round or | | 18.500 | 0.000 | 0.000 | 64.00 | 0.00 | 0.00 | 64.000 | 0.000 | 64.0 | 216.1 | 6.20 | 14,687 |
| D | 209 | Peaked | top of sidewall | | 35.900 | 0.000 | 0.000 | 64.80 | 0.00 | 0.00 | 64.800 | 2.200 | 67.0 | 813.7 | 10.0 | 59,970 |
| D | 301 | Peaked | top of sidewall-door 6' | | 15.500 | 0.000 | 0.000 | 15.00 | 2.00 | 0.00 | 17.000 | 0.900 | 17.9 | 151.7 | 5.50 | 2,864 |
| D | 302 | Peaked | top of sidewall-door 6' | | 15.500 | 0.000 | 0.000 | 15.00 | 2.00 | 0.00 | 17.000 | 0.900 | 17.9 | 151.7 | 5.50 | 2,864 |

NDPSC Bin Capacity Chart

Exam Date:09/13/2010

North Central Grain Cooperative
PO Box 8
Bisbee , ND
County:

Examiner: 1

| Status | Section | Bin Number | Bin Type | Base Point | Diameter or Bu/Ft (Irreg). Length | Width | Side wall | Add for Hopper | Ded. for Obst. | Effective Depth | Add for Peak | Depth for Capac. | Bushels per Foot | Base Pack% | Bushel Capacity with Pack |
|--------|---------|------------|----------|------------|---|-------|--------------|----------------------|----------------------|--------------------|--------------------|------------------------|------------------------|---------------|------------------------------|
|--------|---------|------------|----------|------------|---|-------|--------------|----------------------|----------------------|--------------------|--------------------|------------------------|------------------------|---------------|------------------------------|

Bin count: 40

Facility: Rock Lake Section: D Total: 259,835

To Even: 260,000

Section: E

| | | | | | | | | | | | | | | | |
|---|-------|--------|----------------------|-------|-------|-------|-------|------|------|--------|-------|------|-------|------|-------|
| E | 001 T | Square | work floor | 0.000 | 4.500 | 4.000 | 23.00 | 0.00 | 0.00 | 23.000 | 0.000 | 23.0 | 14.5 | 2.00 | 341 |
| E | 001 B | Square | work floor - top 23' | 0.000 | 10.20 | 4.000 | 22.00 | 0.00 | 0.00 | 22.000 | 0.000 | 22.0 | 32.8 | 2.50 | 740 |
| E | 002 | Square | work floor | 0.000 | 5.500 | 4.000 | 23.00 | 0.00 | 0.00 | 23.000 | 0.000 | 23.0 | 17.7 | 2.00 | 415 |
| E | 003 | Square | work floor | 0.000 | 6.500 | 6.300 | 45.00 | 0.00 | 0.00 | 45.000 | 0.000 | 45.0 | 32.9 | 2.50 | 1,518 |
| E | 004 | Square | work floor | 0.000 | 12.70 | 10.20 | 63.00 | 0.00 | 0.00 | 63.000 | 0.000 | 63.0 | 104.1 | 6.00 | 6,951 |
| E | 005 T | Square | work floor | 0.000 | 12.30 | 6.100 | 45.00 | 0.00 | 0.00 | 45.000 | 0.000 | 45.0 | 60.3 | 4.80 | 2,844 |
| E | 005 B | Square | work floor - top 45' | 0.000 | 12.70 | 12.30 | 18.00 | 0.00 | 0.00 | 18.000 | 0.000 | 18.0 | 125.6 | 6.50 | 2,408 |
| E | 006 | Square | work floor | 0.000 | 12.30 | 6.100 | 45.00 | 0.00 | 0.00 | 45.000 | 0.000 | 45.0 | 60.3 | 4.80 | 2,844 |
| E | 008 T | Square | work floor | 0.000 | 11.80 | 6.100 | 45.00 | 0.00 | 0.00 | 45.000 | 0.000 | 45.0 | 57.9 | 4.80 | 2,731 |
| E | 008 B | Square | work floor - top 45' | 0.000 | 12.70 | 11.80 | 18.00 | 0.00 | 0.00 | 18.000 | 0.000 | 18.0 | 120.5 | 6.50 | 2,310 |
| E | 009 | Square | work floor | 0.000 | 11.80 | 6.100 | 45.00 | 0.00 | 0.00 | 45.000 | 0.000 | 45.0 | 57.9 | 4.80 | 2,731 |
| E | 010 | Square | work floor | 0.000 | 11.80 | 6.500 | 45.00 | 0.00 | 0.00 | 45.000 | 0.000 | 45.0 | 61.7 | 4.80 | 2,910 |
| E | 011 | Square | work floor | 0.000 | 6.500 | 6.300 | 45.00 | 0.00 | 0.00 | 45.000 | 0.000 | 45.0 | 32.9 | 2.50 | 1,518 |
| E | 013 | Square | work floor | 0.000 | 11.80 | 6.500 | 45.00 | 0.00 | 0.00 | 45.000 | 0.000 | 45.0 | 61.7 | 4.80 | 2,910 |
| E | 014 | Square | work floor | 0.000 | 6.500 | 6.000 | 45.00 | 0.00 | 0.00 | 45.000 | 0.000 | 45.0 | 31.4 | 2.50 | 1,448 |
| E | 015 | Square | work floor | 0.000 | 11.80 | 6.100 | 45.00 | 0.00 | 0.00 | 45.000 | 0.000 | 45.0 | 57.9 | 4.80 | 2,731 |
| E | 016 T | Square | work floor | 0.000 | 11.80 | 6.100 | 45.00 | 0.00 | 0.00 | 45.000 | 0.000 | 45.0 | 57.9 | 4.80 | 2,731 |
| E | 016 B | Square | work floor - top 45' | 0.000 | 12.70 | 11.80 | 18.00 | 0.00 | 0.00 | 18.000 | 0.000 | 18.0 | 120.5 | 6.50 | 2,310 |
| E | 017 | Square | work floor | 0.000 | 12.30 | 6.100 | 45.00 | 0.00 | 0.00 | 45.000 | 0.000 | 45.0 | 60.3 | 4.80 | 2,844 |
| E | 019 T | Square | work floor | 0.000 | 12.30 | 6.100 | 45.00 | 0.00 | 0.00 | 45.000 | 0.000 | 45.0 | 60.3 | 4.80 | 2,844 |
| E | 019 B | Square | work floor - top 45' | 0.000 | 12.70 | 12.30 | 18.00 | 0.00 | 0.00 | 18.000 | 0.000 | 18.0 | 125.6 | 6.50 | 2,408 |

NDPSC Bin Capacity Chart

Exam Date:09/13/2010

North Central Grain Cooperative
PO Box 8
Bisbee , ND
County:

Examiner: 1

| Status | Section | Bin Number | Bin Type | Base Point | Diameter or Bu/Ft (Irreg.) | | Side wall | Add for Hopper | Ded. for Obst. | Effective Depth | Add for Peak | Depth for Capac. | Bushels per Foot | Base Pack% | Bushel Capacity with Pack |
|--------|---------|------------|----------|------------|----------------------------|-------|-----------|----------------|----------------|-----------------|--------------|------------------|------------------|------------|---------------------------|
| | | | | | Length | Width | | | | | | | | | |

Facility: Rock Lake

Section: E

| | | | | | | | | | | | | | | | | |
|---|-----|--------|---------------------------|--|--------|-------|-------|-------|------|------|--------|-------|------|-------|------|--------|
| E | 020 | Square | work floor | | 0.000 | 6.500 | 6.000 | 45.00 | 0.00 | 0.00 | 45.000 | 0.000 | 45.0 | 31.4 | 2.50 | 1,448 |
| E | 021 | Square | work floor | | 0.000 | 12.70 | 10.20 | 62.00 | 0.00 | 0.00 | 62.000 | 0.000 | 62.0 | 104.1 | 6.00 | 6,841 |
| E | 022 | Square | work floor | | 0.000 | 10.20 | 4.000 | 45.00 | 0.00 | 0.00 | 45.000 | 0.000 | 45.0 | 32.8 | 2.50 | 1,513 |
| E | 101 | Peaked | top of sidewall- peaked?? | | 27.000 | 0.000 | 0.000 | 40.00 | 0.00 | 0.00 | 40.000 | 1.600 | 41.6 | 460.3 | 8.50 | 20,776 |
| E | 102 | Peaked | top of sidewall- peaked?? | | 27.000 | 0.000 | 0.000 | 40.00 | 0.00 | 0.00 | 40.000 | 1.600 | 41.6 | 460.3 | 8.50 | 20,776 |
| E | 103 | Peaked | top of sidewall- peaked?? | | 27.000 | 0.000 | 0.000 | 40.00 | 0.00 | 0.00 | 40.000 | 1.600 | 41.6 | 460.3 | 8.50 | 20,776 |
| E | 104 | Peaked | top of sidewall- peaked?? | | 27.000 | 0.000 | 0.000 | 40.00 | 0.00 | 0.00 | 40.000 | 1.600 | 41.6 | 460.3 | 8.50 | 20,776 |
| E | 105 | Peaked | top of sidewall peaked?? | | 27.000 | 0.000 | 0.000 | 40.00 | 0.00 | 0.00 | 40.000 | 1.600 | 41.6 | 460.3 | 8.50 | 20,776 |

Bin count: 29

Facility: Rock Lake Section: E Total: 164,169

To Even: 165,000

Section: G

| | | | | | | | | | | | | | | | | |
|---|-----|---------|----------------------------|--|-------|-------|-------|-------|------|------|--------|-------|------|--------|------|--------|
| G | 001 | Quonset | get dimensions 16' roof to | | 0.000 | 90.00 | 32.00 | 15.90 | 0.00 | 0.00 | 15.900 | 0.000 | 15.9 | 1828.6 | 10.0 | 31,983 |
|---|-----|---------|----------------------------|--|-------|-------|-------|-------|------|------|--------|-------|------|--------|------|--------|

Bin count: 1

Facility: Rock Lake Section: G Total: 31,983

To Even: 32,000

Section: H

| | | | | | | | | | | | | | | | | |
|---|-----|---------|----------------------------|--|-------|-------|-------|-------|------|------|--------|-------|------|--------|------|--------|
| H | 001 | Quonset | get dimensions 16' roof to | | 0.000 | 90.00 | 32.00 | 15.90 | 0.00 | 0.00 | 15.900 | 0.000 | 15.9 | 1828.6 | 10.0 | 31,983 |
|---|-----|---------|----------------------------|--|-------|-------|-------|-------|------|------|--------|-------|------|--------|------|--------|

NDPSC Bin Capacity Chart

Exam Date:09/13/2010

North Central Grain Cooperative
PO Box 8
Bisbee , ND
County:

Examiner: 1

| Status | Section | Bin Number | Bin Type | Base Point | Diameter or Bu/Ft (Irreg.) Length | Width | Side wall | Add for Hopper | Ded. for Obst. | Effective Depth | Add for Peak | Depth for Capac. | Bushels per Foot | Base Pack% | Bushel Capacity with Pack | |
|-------------------|---------|------------|----------|------------|---|-------|--------------|----------------------|----------------------|--------------------|--------------------|------------------------|------------------------|---------------|--|---------------|
| Bin count: | | 1 | | | | | | | | | | | | | Facility: Rock Lake Section: H Total: | 31,983 |
| | | | | | | | | | | | | | | To Even: | 32,000 | |

Section: I

| | | | | | | | | | | | | | | | | |
|-------------------|-----|----------|----------------------------|-------|-------|-------|-------|------|------|-------|-------|-----|--------|----------|--|---------------|
| I | 001 | Quonset | get dimensions 16' roof to | 0.000 | 120.0 | 40.00 | 7.900 | 0.00 | 0.00 | 7.900 | 0.000 | 7.9 | 3755.6 | 10.0 | 32,637 | |
| Bin count: | | 1 | | | | | | | | | | | | | Facility: Rock Lake Section: I Total: | 32,637 |
| | | | | | | | | | | | | | | To Even: | 33,000 | |

Section: K

| | | | | | | | | | | | | | | | | |
|-------------------|-----|----------|--------------------------|--------|-------|-------|-------|------|------|--------|-------|------|-------|----------|--|---------------|
| K | 001 | Peaked | top of sidewall - leased | 35.900 | 0.000 | 0.000 | 22.00 | 0.00 | 0.00 | 22.000 | 2.200 | 24.2 | 813.7 | 10.0 | 21,661 | |
| K | 002 | Peaked | top of sidewall - leased | 35.900 | 0.000 | 0.000 | 22.00 | 0.00 | 0.00 | 22.000 | 2.200 | 24.2 | 813.7 | 10.0 | 21,661 | |
| Bin count: | | 2 | | | | | | | | | | | | | Facility: Rock Lake Section: K Total: | 43,322 |
| | | | | | | | | | | | | | | To Even: | 44,000 | |

Section: X-1

| | | | | | | | | | | | | | | | | |
|-------------------|-----|----------|--------------------------|-------|-------|-------|-------|------|------|-------|-------|-----|---------|----------|--|---------------|
| Added | X-1 | ground | Temporary ground storage | 0.000 | 200.0 | 75.00 | 7.500 | 0.00 | 0.00 | 7.500 | 0.000 | 7.5 | 12057.9 | 10.0 | 99,477 | |
| Bin count: | | 1 | | | | | | | | | | | | | Facility: Rock Lake Section: X-1 Total: | 99,477 |
| | | | | | | | | | | | | | | To Even: | 100,000 | |

Exam Date:09/13/2010

North Central Grain Cooperative

Page: 12

Examiner: 1

PO Box 8
Bisbee , ND
County:

| Status | Section | Bin Number | Bin Type | Base Point | Diameter or Bu/Ft (Irreg.) | Length | Width | Side wall | Add for Hopper | Ded. for Obst. | Effective Depth | Add for Peak | Depth for Capac. | Bushels per Foot | Base Pack% | Bushel Capacity with Pack |
|--------|---------|------------|----------|------------|-------------------------------|--------|-------|--------------|----------------------|----------------------|--------------------|--------------------|------------------------|------------------------|---------------|------------------------------|
|--------|---------|------------|----------|------------|-------------------------------|--------|-------|--------------|----------------------|----------------------|--------------------|--------------------|------------------------|------------------------|---------------|------------------------------|

Facility: Rolette

Section: M

| | | | | | | | | | | | | | | | | |
|---|-------|--|--------|----------------------|-------|-------|-------|-------|------|------|--------|-------|------|-------|------|-------|
| M | 002 | | Square | work floor | 0.000 | 8.200 | 4.000 | 51.00 | 0.00 | 0.00 | 51.000 | 0.000 | 51.0 | 26.4 | 2.50 | 1,380 |
| M | 003 T | | Square | work floor | 0.000 | 6.000 | 5.000 | 10.00 | 0.00 | 0.00 | 10.000 | 0.000 | 10.0 | 24.1 | 2.50 | 247 |
| M | 003 B | | Square | work floor - top 10' | 0.000 | 12.00 | 6.000 | 42.50 | 0.00 | 0.00 | 42.500 | 0.000 | 42.5 | 57.9 | 4.80 | 2,579 |
| M | 004 | | Square | work floor | 0.000 | 5.800 | 4.000 | 52.00 | 0.00 | 0.00 | 52.000 | 0.000 | 52.0 | 18.6 | 2.00 | 986 |
| M | 005 | | Square | work floor | 0.000 | 8.800 | 5.500 | 20.00 | 0.00 | 0.00 | 20.000 | 0.000 | 20.0 | 38.9 | 3.00 | 801 |
| M | 006 | | Square | work floor | 0.000 | 8.800 | 5.500 | 20.00 | 0.00 | 0.00 | 20.000 | 0.000 | 20.0 | 38.9 | 3.00 | 801 |
| M | 007 T | | Square | work floor | 0.000 | 10.70 | 2.100 | 20.00 | 0.00 | 0.00 | 20.000 | 0.000 | 20.0 | 18.1 | 2.00 | 369 |
| M | 007 B | | Square | work floor - top 20' | 0.000 | 10.90 | 10.70 | 50.00 | 0.00 | 0.00 | 50.000 | 0.000 | 50.0 | 93.8 | 5.80 | 4,962 |
| M | 008 | | Square | work floor | 0.000 | 10.70 | 5.800 | 50.00 | 0.00 | 0.00 | 50.000 | 0.000 | 50.0 | 49.9 | 4.20 | 2,600 |
| M | 009 | | Square | work floor | 0.000 | 5.800 | 4.000 | 52.00 | 0.00 | 0.00 | 52.000 | 0.000 | 52.0 | 18.6 | 2.00 | 986 |
| M | 010 | | Square | work floor | 0.000 | 13.20 | 10.90 | 68.00 | 0.00 | 0.00 | 68.000 | 0.000 | 68.0 | 115.7 | 6.20 | 8,356 |
| M | 011 | | Square | work floor | 0.000 | 13.20 | 12.00 | 51.00 | 0.00 | 0.00 | 51.000 | 0.000 | 51.0 | 127.3 | 6.50 | 6,914 |
| M | 012 | | Square | work floor | 0.000 | 10.70 | 5.800 | 50.00 | 0.00 | 0.00 | 50.000 | 0.000 | 50.0 | 49.9 | 4.20 | 2,600 |
| M | 013 T | | Square | work floor | 0.000 | 13.20 | 2.800 | 50.00 | 0.00 | 0.00 | 50.000 | 0.000 | 50.0 | 29.7 | 2.50 | 1,522 |
| M | 013 B | | Square | work floor - top 50' | 0.000 | 13.20 | 10.90 | 18.00 | 0.00 | 0.00 | 18.000 | 0.000 | 18.0 | 115.7 | 6.20 | 2,212 |
| M | 014 | | Square | work floor | 0.000 | 13.20 | 8.000 | 50.00 | 0.00 | 0.00 | 50.000 | 0.000 | 50.0 | 84.9 | 5.80 | 4,491 |
| M | 015 | | Square | work floor | 0.000 | 10.90 | 10.70 | 70.00 | 0.00 | 0.00 | 70.000 | 0.000 | 70.0 | 93.8 | 5.80 | 6,947 |
| M | 016 | | Square | work floor | 0.000 | 10.90 | 4.000 | 51.00 | 0.00 | 0.00 | 51.000 | 0.000 | 51.0 | 35.0 | 3.00 | 1,839 |
| M | 018 | | Square | work floor | 0.000 | 10.90 | 4.000 | 51.00 | 0.00 | 0.00 | 51.000 | 0.000 | 51.0 | 35.0 | 3.00 | 1,839 |
| M | 019 | | Square | work floor | 0.000 | 10.90 | 10.70 | 70.00 | 0.00 | 0.00 | 70.000 | 0.000 | 70.0 | 93.8 | 5.80 | 6,947 |
| M | 020 | | Square | work floor | 0.000 | 13.00 | 8.000 | 49.00 | 0.00 | 0.00 | 49.000 | 0.000 | 49.0 | 83.6 | 5.80 | 4,334 |

Exam Date:09/13/2010

North Central Grain Cooperative
PO Box 8
Bisbee , ND
County:

Page: 13

Examiner: 1

| Status | Section | Bin Number | Bin Type | Base Point | Diameter or Bu/Ft (Irreg). | | Side wall | Add for Hopper | Ded. for Obst. | Effective Depth | Add for Peak | Depth for Capac. | Bushels per Foot | Base Pack% | Bushel Capacity with Pack |
|--------|---------|------------|----------|------------|-------------------------------|-------|--------------|----------------------|----------------------|--------------------|--------------------|------------------------|------------------------|---------------|------------------------------|
| | | | | | Length | Width | | | | | | | | | |

Facility: Rolette

Section: M

| | | | | | | | | | | | | | | | | |
|-------|-------|--------|----------------------|-----------------|--------|-------|-------|-------|------|------|--------|-------|------|-------|------|--------|
| M | 021 | Square | work floor | | 0.000 | 5.800 | 4.000 | 52.00 | 0.00 | 0.00 | 52.000 | 0.000 | 52.0 | 18.6 | 2.00 | 986 |
| M | 022 T | Square | work floor | | 0.000 | 13.00 | 2.800 | 49.00 | 0.00 | 0.00 | 49.000 | 0.000 | 49.0 | 29.3 | 2.50 | 1,472 |
| M | 022 B | Square | work floor - top 49' | | 0.000 | 13.00 | 10.90 | 18.00 | 0.00 | 0.00 | 18.000 | 0.000 | 18.0 | 113.9 | 6.20 | 2,177 |
| M | 023 | Square | work floor | | 0.000 | 10.70 | 5.800 | 50.00 | 0.00 | 0.00 | 50.000 | 0.000 | 50.0 | 49.9 | 4.20 | 2,600 |
| M | 024 | Square | work floor | | 0.000 | 13.00 | 12.00 | 51.00 | 0.00 | 0.00 | 51.000 | 0.000 | 51.0 | 125.4 | 6.50 | 6,811 |
| M | 025 | Square | work floor | | 0.000 | 10.70 | 5.800 | 50.00 | 0.00 | 0.00 | 50.000 | 0.000 | 50.0 | 49.9 | 4.20 | 2,600 |
| M | 026 | Square | work floor | | 0.000 | 13.00 | 10.90 | 68.00 | 0.00 | 0.00 | 68.000 | 0.000 | 68.0 | 113.9 | 6.20 | 8,225 |
| M | 027 | Square | work floor | | 0.000 | 5.800 | 4.000 | 52.00 | 0.00 | 0.00 | 52.000 | 0.000 | 52.0 | 18.6 | 2.00 | 986 |
| M | 028 | Square | work floor | | 0.000 | 10.90 | 10.70 | 70.00 | 0.00 | 0.00 | 70.000 | 0.000 | 70.0 | 93.8 | 5.80 | 6,947 |
| M | 031 | Square | work floor | | 0.000 | 7.000 | 4.000 | 51.00 | 0.00 | 0.00 | 51.000 | 0.000 | 51.0 | 22.5 | 2.00 | 1,171 |
| M | 101 | Peaked | top of sidewall | | 29.900 | 0.000 | 0.000 | 32.00 | 0.00 | 0.00 | 32.000 | 1.800 | 33.8 | 564.4 | 9.00 | 20,794 |
| M | 102 | Peaked | top of sidewall | | 29.900 | 0.000 | 0.000 | 32.00 | 0.00 | 0.00 | 32.000 | 1.800 | 33.8 | 564.4 | 9.00 | 20,794 |
| Added | M | 201 | Peaked | top of sidewall | 32.800 | 0.000 | 0.000 | 66.10 | 0.00 | 0.00 | 66.100 | 2.000 | 68.1 | 679.2 | 9.50 | 50,648 |
| Added | M | 202 | Peaked | top of sidewall | 32.800 | 0.000 | 0.000 | 66.10 | 0.00 | 0.00 | 66.100 | 2.000 | 68.1 | 679.2 | 9.50 | 50,648 |

Bin count: 35

Facility: Rolette Section: M Total: 240,571

To Even: 241,000

Overall Licensed Bin Capacity for:

North Central Grain Cooperative

Bin count: 199

Licensed Capacity:

(includes pack)

3,854,232 Bu.

Licensed Capacity (to even):

(includes pack and section totals are
rounded up to next highest 1000)

3,860,000 Bu.

NORTH CENTRAL GRAIN COOPERATIVE
BISBEE ND
SECTION Y & Z



BNSF RAIL

SECTION Y

main house


SECTION Y

SECTION Y
east annex

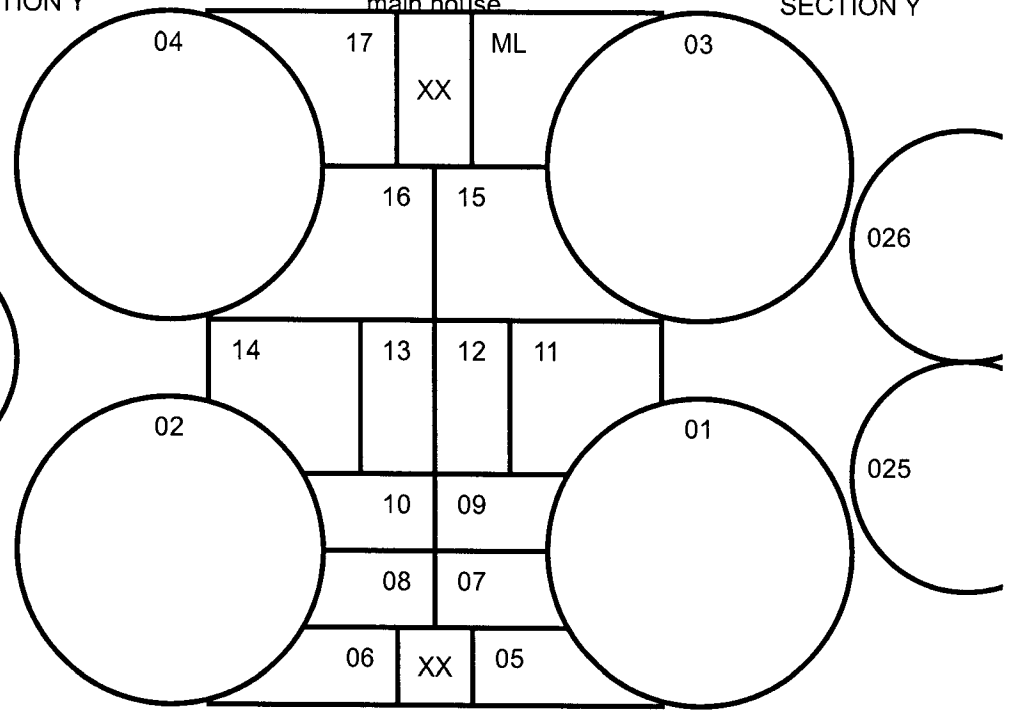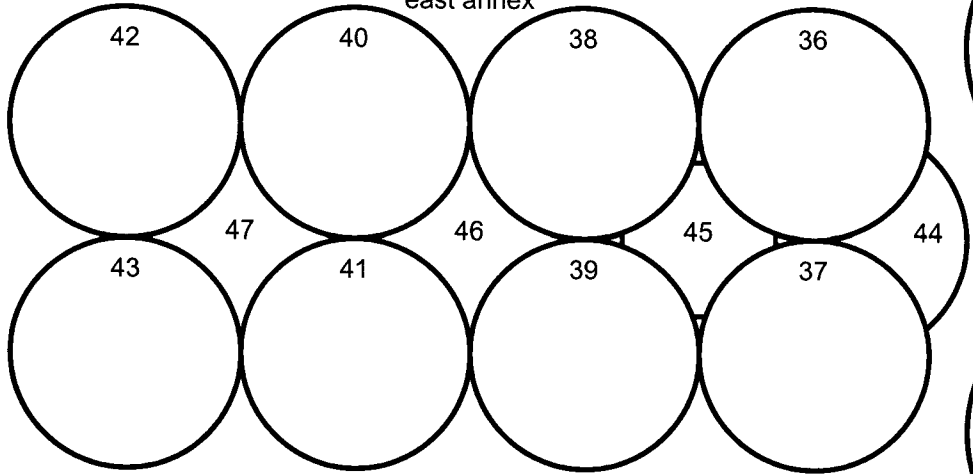

SECTION Z
hopper tanks


located 250' north of concrete complex

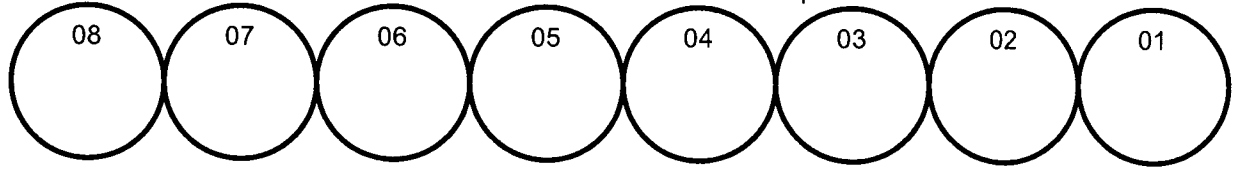


NORTH CENTRAL GRAIN COOPERATIVE

BISBEE ND

Rock Lake location Section D

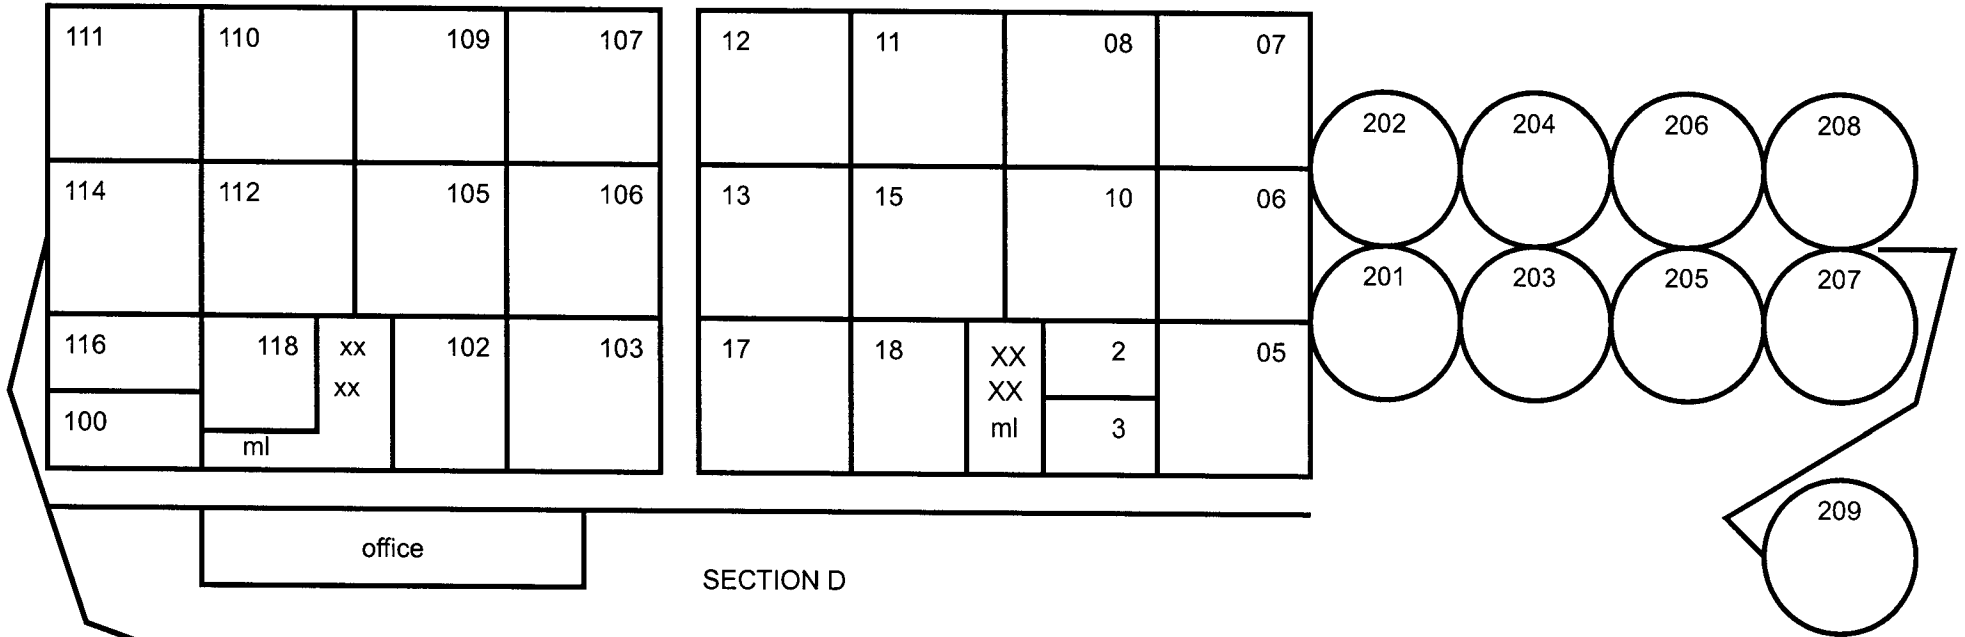


SECTION D

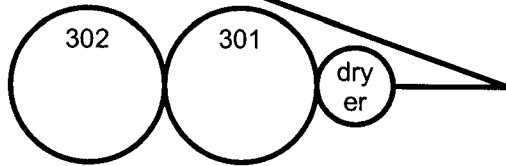

SECTION X-1 - ground 100,000 bu.

SECTION -G-H-I
consists of quonsets 90'L
16.0' to low point of roof
Sec.I- 120' L x 40'W

SECTION K
leased tanks

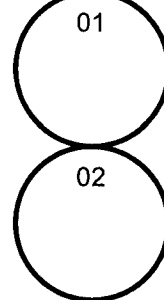


NORTH CENTRAL GRAIN COOPERATIVE
 BISBEE ND
 Rock Lake location
 Section E


| | | | | | |
|----|----|----|----|----|----|
| 16 | 15 | 13 | 10 | 09 | 08 |
| 19 | 17 | 14 | 11 | 06 | 05 |
| | | 20 | 03 | | |
| 21 | | 22 | XX | 01 | 04 |
| | | | XX | 02 | |
| | | ML | | | |

office

SECTION E


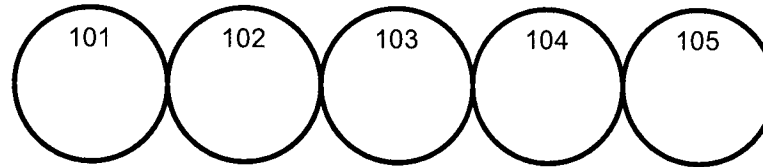


SECTION E

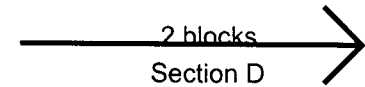

NORTH CENTRAL GRAIN COOPERATIVE
 BISBEE ND
 ROLETTE location
 Section M


NP RAIL

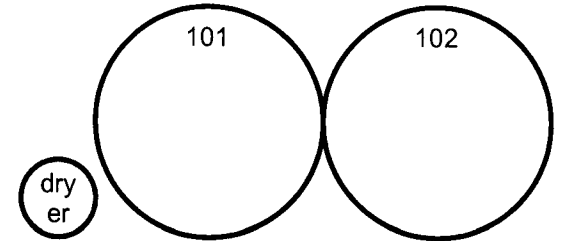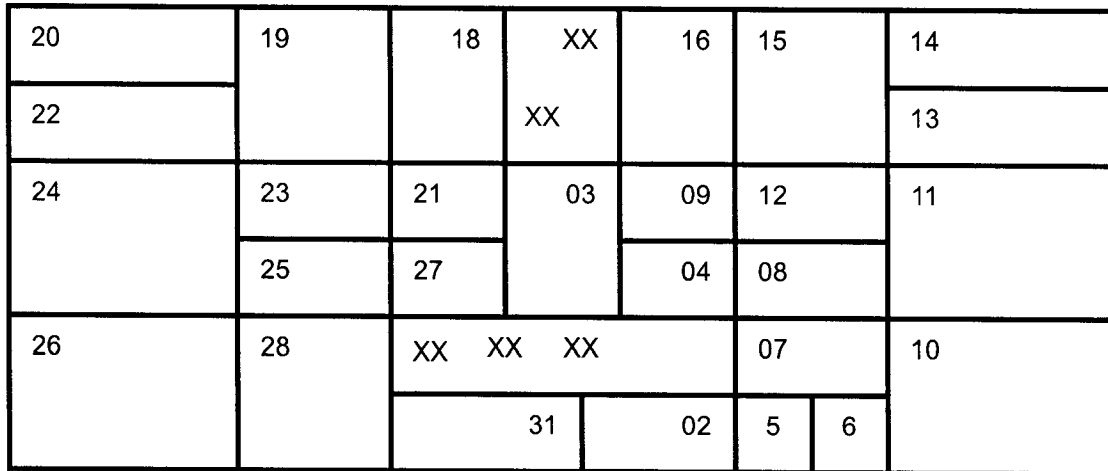


SECTION M



SECTION M

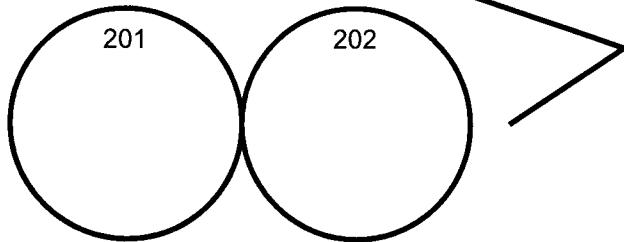

new construction
 32.8' dia x 66.1' sidewall

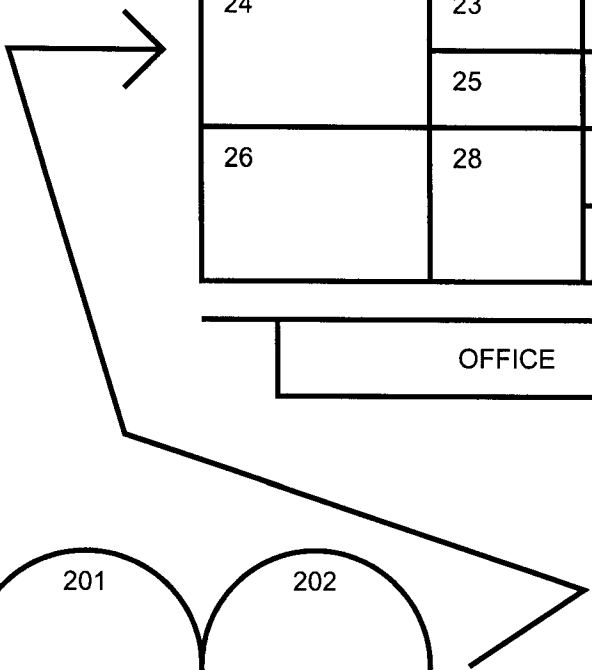

NORTH CENTRAL GRAIN COOPERATIVE
BISBEE ND
Perth location Section Q&S

BNSF RAIL




| | | | | | |
|----|----|------|-------|----|----|
| 03 | 19 | 21 | 15 | 13 | 09 |
| 07 | 23 | 24 | SCALE | 17 | 05 |
| | 20 | | | | |
| 12 | 16 | XXXX | ML | 18 | 10 |
| 04 | | 08 | 14 | | |

OFFICE


SECTION Q

NORTH CENTRAL GRAIN COOPERATIVE


BISBEE ND
Section W at Bisbee

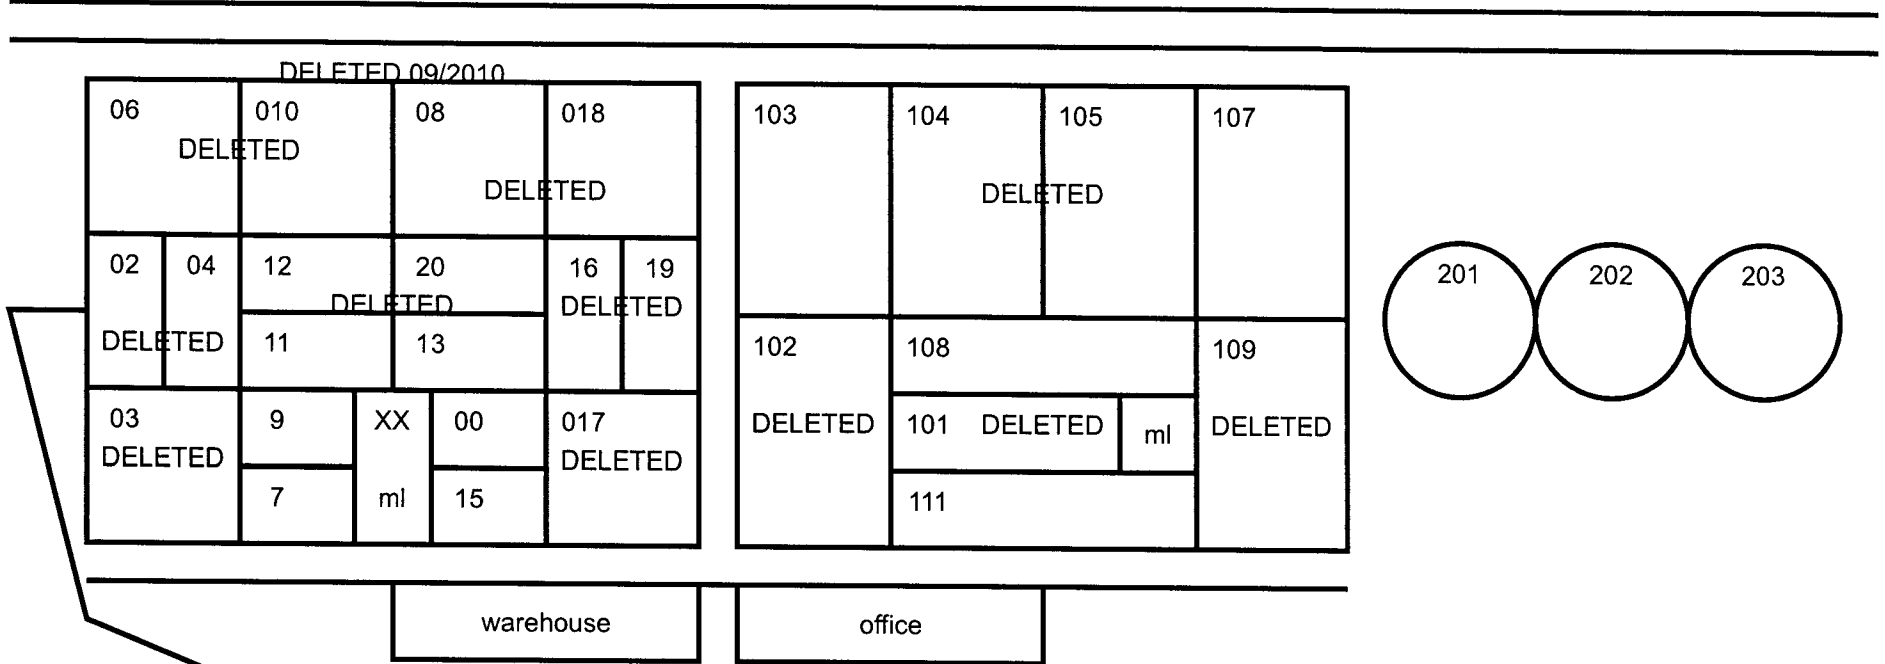

SECTION W

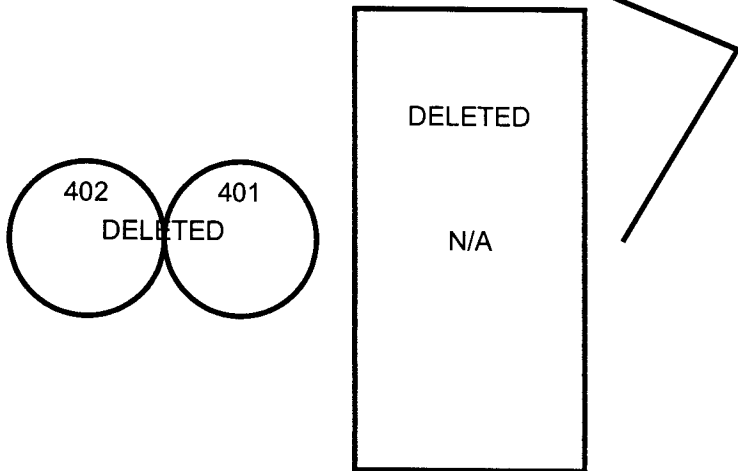




NORTH CENTRAL GRAIN COOPERATIVE
BISBEE ND
Section Y
steel construction east of office

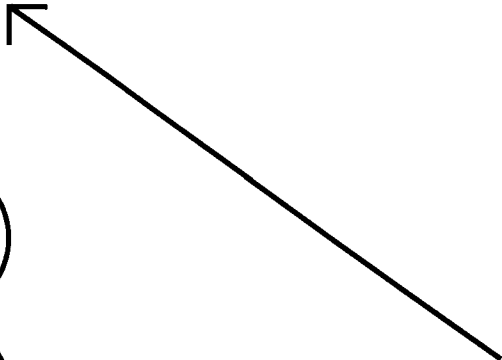

concrete complex 2 blcks SE


tanks 101 thru 106
47.8' diameter
31.6' sidewall
(33.1' sidewall minus 1.5' aeration floor)
(unusual 18" aeration floor ht.).

hopper tanks 7 & 8
16' diameter
25' sidewall
6' hopper

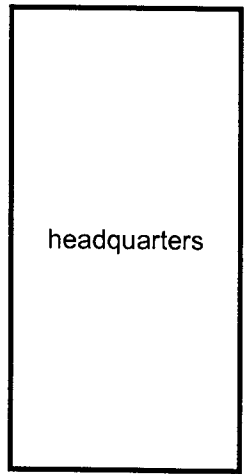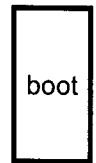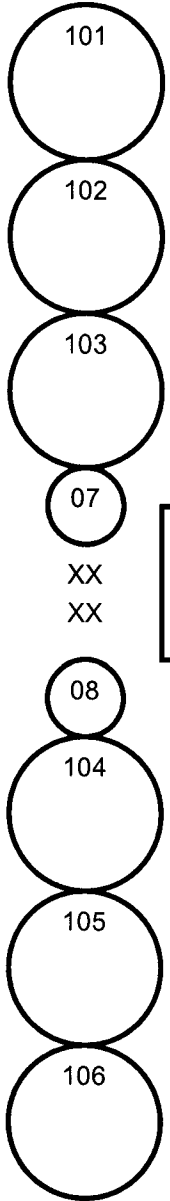


NORTH CENTRAL GRAIN COOPERATIVE
BISBEE ND
SECTION Y


SECTION Y
main concrete house

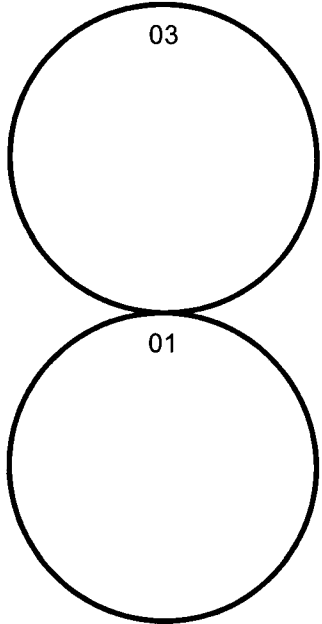

SECTION Y
west annex #1

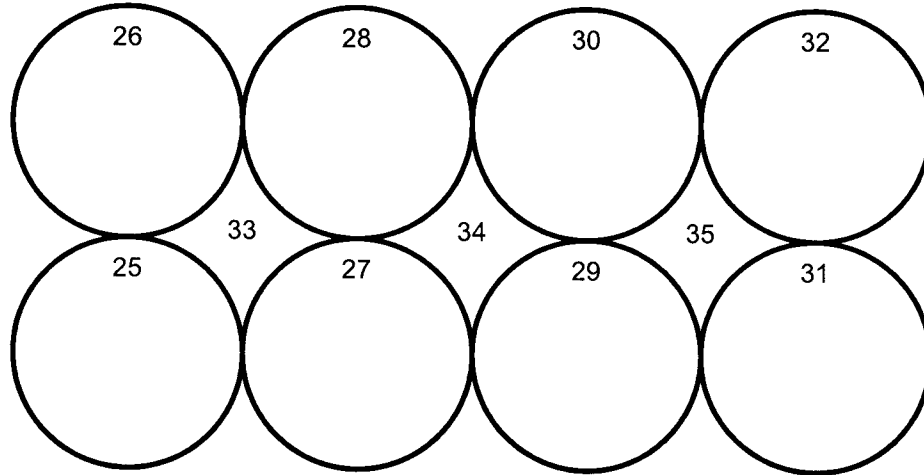

SECTION Y
west annex #2
constructed 09/2010

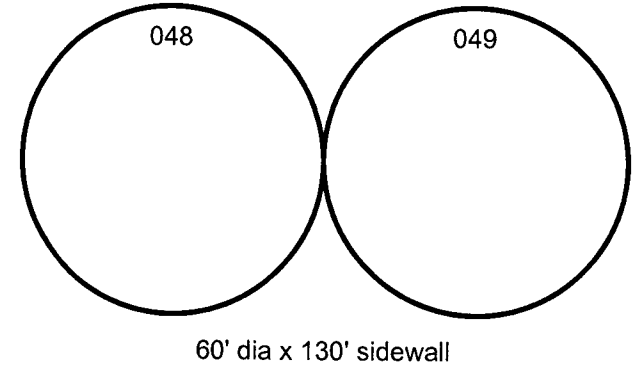

steel tank site 2 blocks north

