

Exam Date:07/16/2009

Crete Grain Co., Inc.  
220 Denver Drive  
Crete, ND  
County:

Page: 1

Examiner: 2

Status	Section	Bin Number	Bin Type	Base Point	Diameter or Bu/Ft (Irreg).		Side wall	Add for Hopper	Ded. for Obst.	Effective Depth	Add for Peak	Depth for Capac.	Bushels per Foot	Base Pack%	Bushel Capacity with Pack
					Length	Width									

## Facility: Crete

### Section: A

A	001	Square	work floor		0.000	11.70	7.400	58.00	0.00	0.00	58.000	0.000	58.0	69.6	5.20	4,247
A	002	Square	work floor		0.000	11.70	7.400	58.00	0.00	0.00	58.000	0.000	58.0	69.6	5.20	4,247
A	003	Square	work floor		0.000	11.70	7.500	58.00	0.00	0.00	58.000	0.000	58.0	70.5	5.20	4,302
A	004	Square	work floor		0.000	11.70	7.500	58.00	0.00	0.00	58.000	0.000	58.0	70.5	5.20	4,302
A	005E	Square	work floor		0.000	7.500	5.500	47.00	0.00	0.00	47.000	0.000	47.0	33.2	2.50	1,599
A	005W	Square	work floor		0.000	7.500	5.500	47.00	0.00	0.00	47.000	0.000	47.0	33.2	2.50	1,599
A	006	Square	work floor		0.000	11.70	7.500	58.00	0.00	0.00	58.000	0.000	58.0	70.5	5.20	4,302
A	007	Square	work floor		0.000	11.70	7.700	58.00	0.00	0.00	58.000	0.000	58.0	72.4	5.20	4,417
A	008	Square	work floor		0.000	11.70	7.400	58.00	0.00	0.00	58.000	0.000	58.0	69.6	5.20	4,247
A	009	Square	work floor		0.000	11.70	7.400	58.00	0.00	0.00	58.000	0.000	58.0	69.6	5.20	4,247
A	010E	Square	work floor		0.000	7.700	5.500	48.00	0.00	0.00	48.000	0.000	48.0	34.0	2.50	1,673
A	010W	Square	work floor		0.000	7.700	5.500	48.00	0.00	0.00	48.000	0.000	48.0	34.0	2.50	1,673
A	011E	Square	work floor		0.000	5.500	5.100	48.00	0.00	0.00	48.000	0.000	48.0	22.5	2.00	1,102
A	011W	Square	work floor		0.000	5.500	5.100	48.00	0.00	0.00	48.000	0.000	48.0	22.5	2.00	1,102
A	012	Square	work floor		0.000	6.000	5.500	48.00	0.00	0.00	48.000	0.000	48.0	26.5	2.50	1,304
A	013	Square	work floor		0.000	11.10	4.000	48.00	0.00	0.00	48.000	0.000	48.0	35.7	3.00	1,765
A	114 T	Square	work floor		0.000	15.20	15.20	49.00	0.00	0.00	49.000	0.000	49.0	185.7	7.00	9,736
A	114 B	Square	work floor- top 49'		0.000	15.20	13.20	6.000	0.00	0.00	6.000	0.000	6.0	161.3	7.00	1,036
A	115 T	Square	work floor		0.000	15.20	15.20	49.00	0.00	0.00	49.000	0.000	49.0	185.7	7.00	9,736
A	115 B	Square	work floor -top 49'		0.000	15.20	13.20	6.000	0.00	0.00	6.000	0.000	6.0	161.3	7.00	1,036
A	116 T	Square	work floor		0.000	15.40	15.20	49.00	0.00	0.00	49.000	0.000	49.0	188.2	7.00	9,868

Exam Date:07/16/2009

Crete Grain Co., Inc.  
220 Denver Drive  
Crete, ND  
County:

Page: 2

Examiner: 2

Status	Section	Bin Number	Bin Type	Base Point	Diameter or Bu/Ft (Irreg.) Length	Width	Side wall	Add for Hopper	Ded. for Obst.	Effective Depth	Add for Peak	Depth for Capac.	Bushels per Foot	Base Pack%	Bushel Capacity with Pack
--------	---------	------------	----------	------------	---	-------	--------------	----------------------	----------------------	--------------------	--------------------	------------------------	------------------------	---------------	------------------------------

## Facility: Crete

### Section: A

A	116 B	Square	work floor -top 49'	0.000	15.40	13.20	6.000	0.00	0.00	6.000	0.000	6.0	163.4	7.00	1,049
A	117 T	Square	work floor	0.000	15.40	15.20	49.00	0.00	0.00	49.000	0.000	49.0	188.2	7.00	9,868
A	117 B	Square	work floor -top 49'	0.000	15.40	13.20	6.000	0.00	0.00	6.000	0.000	6.0	163.4	7.00	1,049
A	118 T	Square	work floor	0.000	15.20	15.00	49.00	0.00	0.00	49.000	0.000	49.0	183.3	7.00	9,611
A	118 B	Square	work floor -top 49'	0.000	15.00	13.20	6.000	0.00	0.00	6.000	0.000	6.0	159.2	7.00	1,022
A	119 T	Square	work floor	0.000	15.20	15.00	49.00	0.00	0.00	49.000	0.000	49.0	183.3	7.00	9,611
A	119 B	Square	work floor -top 49'	0.000	15.00	13.20	6.000	0.00	0.00	6.000	0.000	6.0	159.2	7.00	1,022
A	223	Square	work floor	0.000	11.00	9.500	55.00	0.00	0.00	55.000	0.000	55.0	84.0	5.80	4,888
A	224	Square	work floor	0.000	10.00	5.500	40.00	0.00	0.00	40.000	0.000	40.0	44.2	3.50	1,830
A	225	Square	work floor	0.000	11.00	10.00	41.00	0.00	0.00	41.000	0.000	41.0	88.4	5.80	3,834
A	226	Square	work floor	0.000	9.500	3.500	40.00	0.00	0.00	40.000	0.000	40.0	26.7	2.50	1,095
A	227	Square	work floor	0.000	11.00	9.500	55.00	0.00	0.00	55.000	0.000	55.0	84.0	5.80	4,888
A	228	Square	work floor	0.000	11.00	9.500	55.00	0.00	0.00	55.000	0.000	55.0	84.0	5.80	4,888
A	229	Square	work floor	0.000	11.00	10.00	41.00	0.00	0.00	41.000	0.000	41.0	88.4	5.80	3,834
A	230	Square	work floor	0.000	10.00	6.000	40.00	0.00	0.00	40.000	0.000	40.0	48.2	4.20	2,009
A	231	Square	work floor	0.000	11.00	9.500	55.00	0.00	0.00	55.000	0.000	55.0	84.0	5.80	4,888
A	232	Square	work floor	0.000	9.500	6.000	40.00	0.00	0.00	40.000	0.000	40.0	45.8	4.00	1,905
A	233	Square	work floor	0.000	9.500	5.500	40.00	0.00	0.00	40.000	0.000	40.0	42.0	3.50	1,739
A	234	Square	work floor	0.000	9.500	3.500	40.00	0.00	0.00	40.000	0.000	40.0	26.7	2.50	1,095
A	301	Peaked	top of sidewall	30.000	0.000	0.000	72.00	0.00	0.00	72.000	1.800	73.8	568.2	9.00	45,707
A	302	Peaked	top of sidewall	30.000	0.000	0.000	72.00	0.00	0.00	72.000	1.800	73.8	568.2	9.00	45,707

Exam Date:07/16/2009

Crete Grain Co., Inc.  
220 Denver Drive  
Crete, ND  
County:

Page: 3

Examiner: 2

Status	Section	Bin Number	Bin Type	Base Point	Diameter or Bu/Ft (Irreg). Length	Width	Side wall	Add for Hopper	Ded. for Obst.	Effective Depth	Add for Peak	Depth for Capac.	Bushels per Foot	Base Pack%	Bushel Capacity with Pack
--------	---------	------------	----------	------------	---	-------	--------------	----------------------	----------------------	--------------------	--------------------	------------------------	------------------------	---------------	------------------------------

## Facility: Crete

### Section: A

A	303	Peaked	top of sidewall		30.000	0.000	0.000	72.00	0.00	0.00	72.000	1.800	73.8	568.2	9.00	45,707
A	304	Peaked	top of sidewall		30.000	0.000	0.000	72.00	0.00	0.00	72.000	1.800	73.8	568.2	9.00	45,707
A	401	Peaked	top of sidewall		33.000	0.000	0.000	58.00	0.00	0.00	58.000	2.000	60.0	687.5	9.50	45,169
A	402	Peaked	top of sidewall		33.000	0.000	0.000	58.00	0.00	0.00	58.000	2.000	60.0	687.5	9.50	45,169
A	403	Peaked	top of sidewall		33.000	0.000	0.000	58.00	0.00	0.00	58.000	2.000	60.0	687.5	9.50	45,169

Bin count: 47

Facility: Crete Section: A Total: **466,000**To Even: **466,000**

### Section: B

B	001	Peaked	top of sidewall -top of peak		41.800	0.000	0.000	33.00	0.00	0.00	33.000	2.500	35.5	1103.1	10.0	43,076
B	002	Peaked	top of sidewall -top of peak		41.800	0.000	0.000	33.00	0.00	0.00	33.000	2.500	35.5	1103.1	10.0	43,076
B	004	Peaked	top of sidewall -top of peak		41.800	0.000	0.000	33.00	0.00	0.00	33.000	2.500	35.5	1103.1	10.0	43,076
B	005	Peaked	top of sidewall -top of peak		41.800	0.000	0.000	33.00	0.00	0.00	33.000	2.500	35.5	1103.1	10.0	43,076
B	006	Peaked	top of sidewall -top of peak		41.800	0.000	0.000	33.00	0.00	0.00	33.000	2.500	35.5	1103.1	10.0	43,076
B	007	Peaked	top of sidewall -top of peak		41.800	0.000	0.000	33.00	0.00	0.00	33.000	2.500	35.5	1103.1	10.0	43,076
B	008	Peaked	top of sidewall -top of peak		41.800	0.000	0.000	33.00	0.00	0.00	33.000	2.500	35.5	1103.1	10.0	43,076
B	009	Peaked	top of sidewall -top of peak		41.800	0.000	0.000	33.00	0.00	0.00	33.000	2.500	35.5	1103.1	10.0	43,076
B	010	Peaked	top of sidewall -top of peak		41.800	0.000	0.000	33.00	0.00	0.00	33.000	2.500	35.5	1103.1	10.0	43,076
B	011	Peaked	top of sidewall -top of peak		41.800	0.000	0.000	33.00	0.00	0.00	33.000	2.500	35.5	1103.1	10.0	43,076
Added	B	012	Peaked	top of sidewall - #3 moved	41.800	0.000	0.000	33.00	0.00	0.00	33.000	2.500	35.5	1103.1	10.0	43,076

Exam Date:07/16/2009

Examiner: 2

Crete Grain Co., Inc.  
220 Denver Drive  
Crete, ND  
County:

Page: 4

Status	Section	Bin Number	Bin Type	Base Point	Diameter or Bu/Ft (Irreg).		Side wall	Add for Hopper	Ded. for Obst.	Effective Depth	Add for Peak	Depth for Capac.	Bushels per Foot	Base Pack%	Bushel Capacity with Pack
					Length	Width									

## Facility: Crete

### Section: B

B	013	Peaked	top of sidewall -top of peak	41.800	0.000	0.000	33.00	0.00	0.00	33.000	2.500	35.5	1103.1	10.0	43,076
B	014	Peaked	top of sidewall -top of peak	41.800	0.000	0.000	40.40	0.00	0.00	40.400	2.500	42.9	1103.1	10.0	52,055
B	015	Peaked	top of sidewall -top of peak	41.800	0.000	0.000	40.40	0.00	0.00	40.400	2.500	42.9	1103.1	10.0	52,055
B	016	Peaked	top of sidewall -top of peak	41.800	0.000	0.000	40.40	0.00	0.00	40.400	2.500	42.9	1103.1	10.0	52,055
B	017	Peaked	top of sidewall -top of peak	41.800	0.000	0.000	40.40	0.00	0.00	40.400	2.500	42.9	1103.1	10.0	52,055

Bin count: 16

Facility: Crete Section: B Total: 725,132To Even: 726,000

### Section: C

C	001	Peaked	top of sidewall -top of peak	35.800	0.000	0.000	24.50	0.00	0.00	24.500	2.100	26.6	809.2	10.0	23,678
C	002	Peaked	top of sidewall -top of peak	35.800	0.000	0.000	24.50	0.00	0.00	24.500	2.100	26.6	809.2	10.0	23,678
C	003	Peaked	top of sidewall -top of peak	35.800	0.000	0.000	24.50	0.00	0.00	24.500	2.100	26.6	809.2	10.0	23,678
C	004	Peaked	top of sidewall -top of peak	35.800	0.000	0.000	24.50	0.00	0.00	24.500	2.100	26.6	809.2	10.0	23,678
C	005	Peaked	top of sidewall -top of peak	35.800	0.000	0.000	24.50	0.00	0.00	24.500	2.100	26.6	809.2	10.0	23,678
C	006	Peaked	top of sidewall -top of peak	35.800	0.000	0.000	24.50	0.00	0.00	24.500	2.100	26.6	809.2	10.0	23,678


Bin count: 6

Facility: Crete Section: C Total: 142,068To Even: 143,000

CRETE GRAIN INC.


Crete ND

RRV&W rail

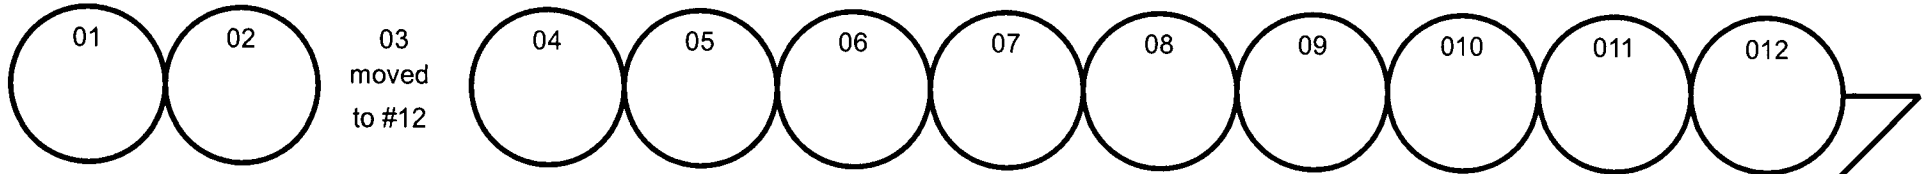


Section B

Section B

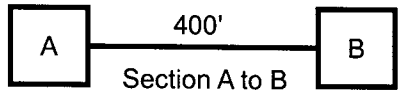

670' S. by SW

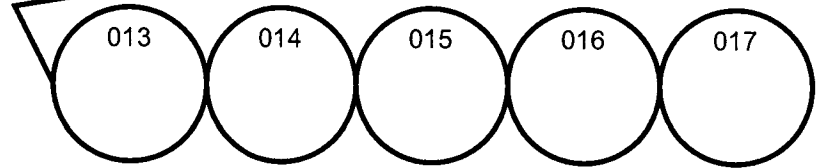

Section B

Section B tanks

all are 41.8' dia

#1 thru #13- 33' sidewall

#14 thru #17- 40.4' sidewall

zero - top of sidewall

Section C tanks

35.8' dia

24.5' sidewall

zero- top of sidewall

Section C

Section C

north

