


# Figure 4.A.3a - Route Map

(Revised April 17, 2012)

6-Inch Natural Gas Liquids Pipeline  
 McKenzie County  
 Township 151N Range 103 W  
 Township 152N Range 103 W

### Legend

- Sensitive Reptiles
- Sensitive Birds
- Sensitive Plants
- Sensitive Species
- Residence within 500ft
- 6 Inch LPG Line
- 8 Inch Natural Gas Line
- Requested Re-route
- 2010 Field Study Corridor 1 Mile
- 2011 Field Study Corridor 1 Mile
- Cultural Inventory Sites
- Cultural Inventory Lead Sites
- USFWS Wetland Inventory
- Approved Route 200' Corridor
- Requested Reroute 200' Corridor

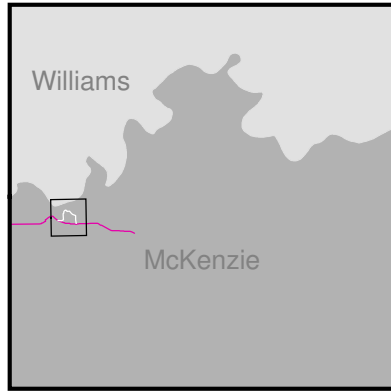

Hiland Operating, LLC  
 205 West Maple, Suite 1100  
 Enid, Oklahoma 73701  
 580-616-2080

2011 Aerial Photography