


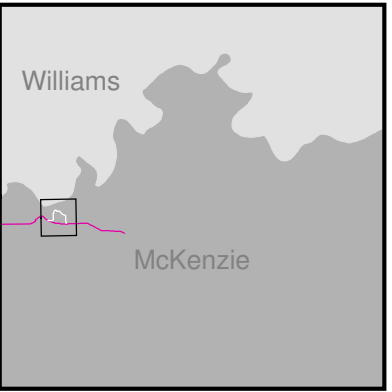


# Figure 4.A.3b - Route Map (Revised April 17, 2012)

6-Inch Natural Gas Liquids Pipeline  
 McKenzie County  
 Township 151N Range 103 W  
 Township 152N Range 103 W

### Legend

-  6 Inch LPG Line (As Approved)
-  8 Inch Natural Gas Line
-  Requested Re-route
-  2010 Field Study Corridor 1 Mile
-  2011 Field Study Corridor 1 Mile
-  Cultural Inventory Sites
-  Cultural Inventory Lead Sites
-  USFWS Wetland Inventory
-  Approved Route 200' Corridor
-  Requested Reroute 200' Corridor



Hiland Operating, LLC  
 205 West Maple, Suite 1100  
 Enid, Oklahoma 73701  
 580-616-2080

