


Z:\16143 PLAINS ALL AMER - Bakken North CL Staking ND\Base Map From Client\basemap-04-27-12.dwg, G3 REROUTE FOR HDD REV1, 7/19/2012 3:54:48 PM

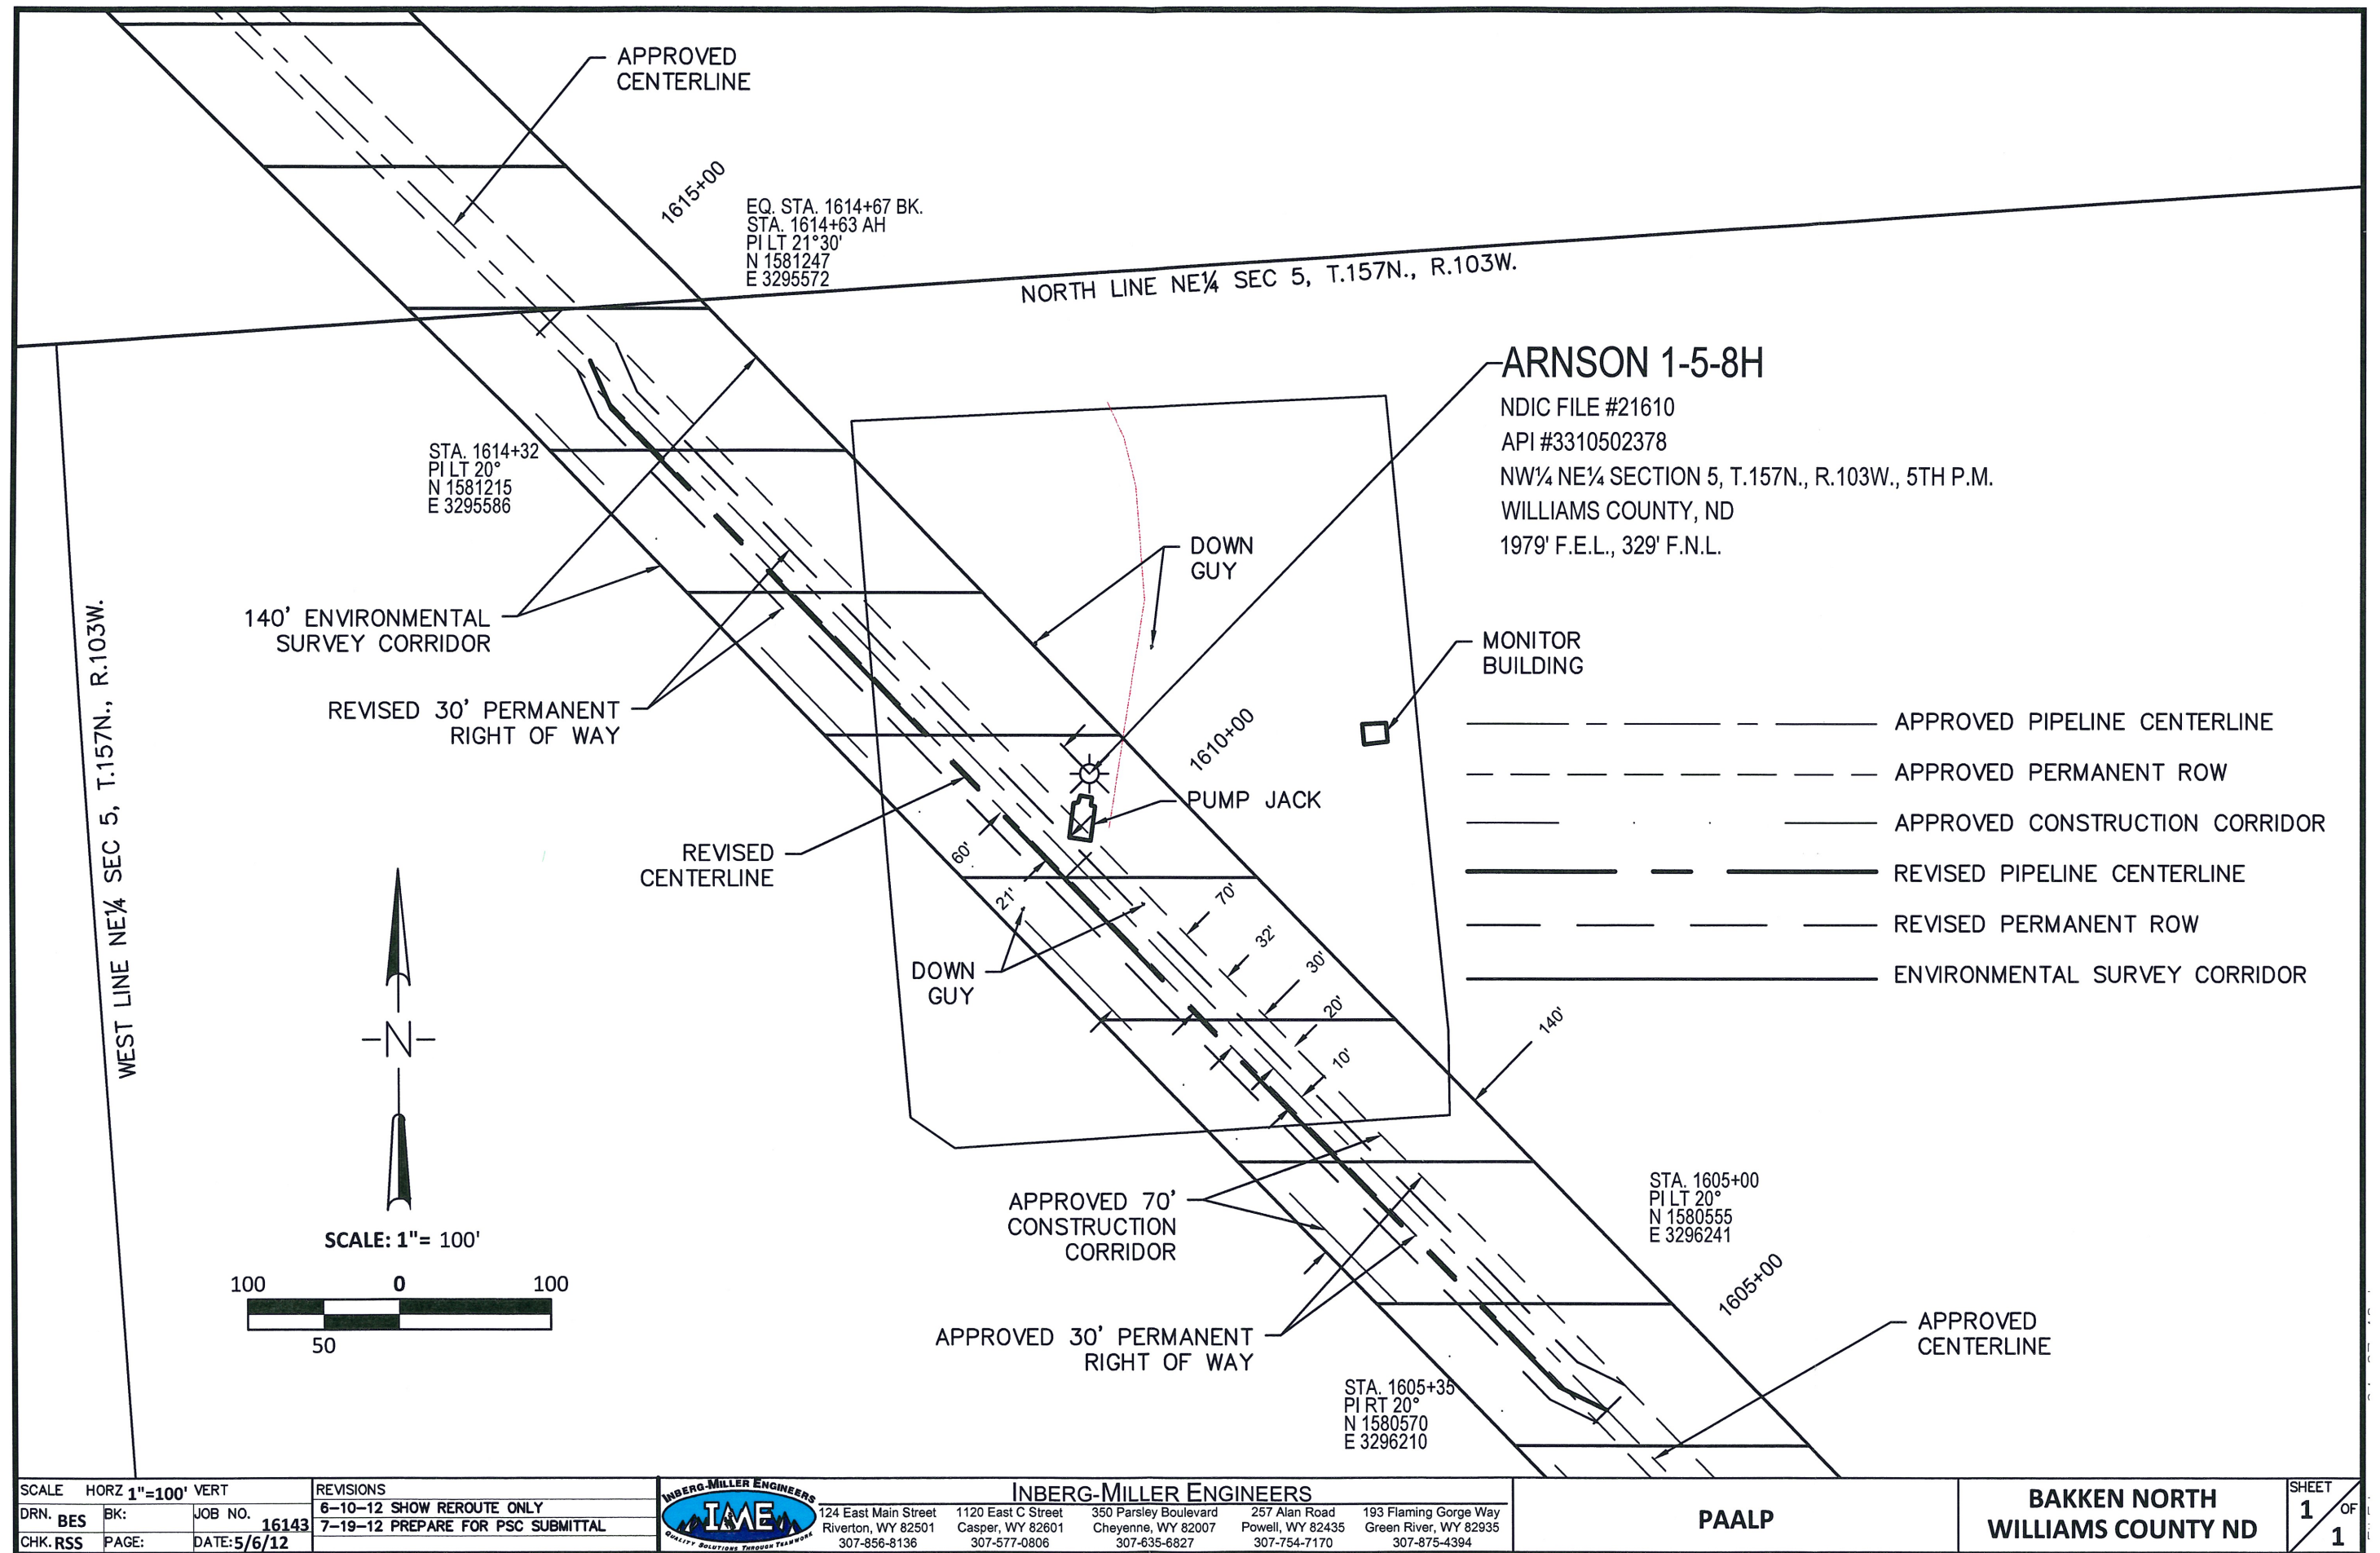

Any use, reuse, or CADD adaptation of this drawing other than for the specific purpose intended, by anyone, without written authorization from the engineer, will be at the Client's risk and full legal responsibility.