


Path: P:\SWCA\BakkenNorth\Post_Const_Filing\MXDs\FSC_PostConst_Filing_CertificatedCorridor.mxd

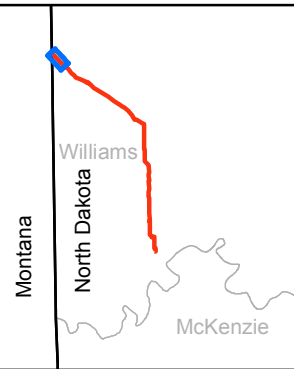


Source: Esri, i-cubed, USDA, USGS, AEX, GeoEye, Getmapping, Aerogrid, IGN, IGP, and the GIS User Community

Author: TTD
Date: 4/5/2013



 Certificated Corridor

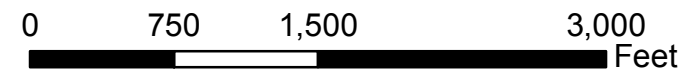

1:12,000



Bakken North
PCS Post Construction Filing
Certificated Corridor

Docket No. PU-10-630
Certificate of Corridor Compatibility No 127



Map 1 of 14
Williamsl County, ND

Path: P:\SWCA\BakkenNorth\Post_Const_Filing\MXDs\FSC_PostConst_Filing_CertificatedCorridor.mxd



Source: Esri, i-cubed, USDA, USGS, AEX, GeoEye, Getmapping, Aerogrid, IGN, IGP, and the GIS User Community


Author: TTD
Date: 4/5/2013

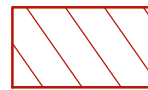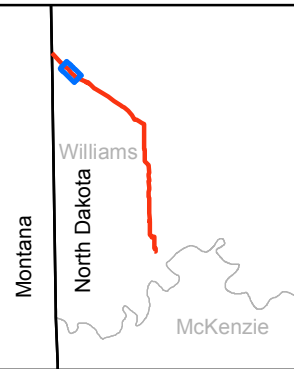


Certificated Corridor



Enhancing Execution
with Experience

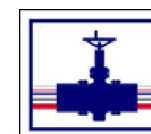

PLAINS
ALL AMERICAN
PIPELINE, L.P.

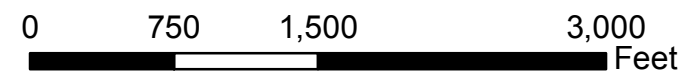

1:12,000

Bakken North
PCS Post Construction Filing
Certificated Corridor

Docket No. PU-10-630
Certificate of Corridor Compatibility No 127


Map 2 of 14
Williams County, ND

Path: P:\SWCA\BakkenNorth\Post_Const_Filing\MXDs\FSC_PostConst_Filing_CertificatedCorridor.mxd




Source: Esri, i-cubed, USDA, USGS, AEX, GeoEye, Getmapping, Aerogrid, IGN, IGP, and the GIS User Community

Author: TTD Date: 4/5/2013

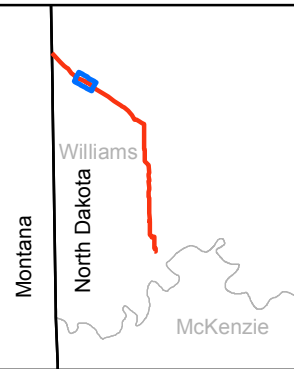

 Certified Corridor

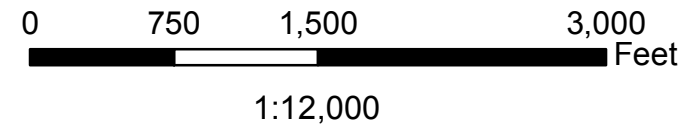


Bakken North
 PCS Post Construction Filing
 Certificated Corridor

 Docket No. PU-10-630
 Certificate of Corridor Compatibility No 127


 Map 3 of 14
 Williamsl County, ND

Path: P:\SWCA\BakkenNorth\Post_Const_Filing\MXDs\FSC_PostConst_Filing_CertificatedCorridor.mxd

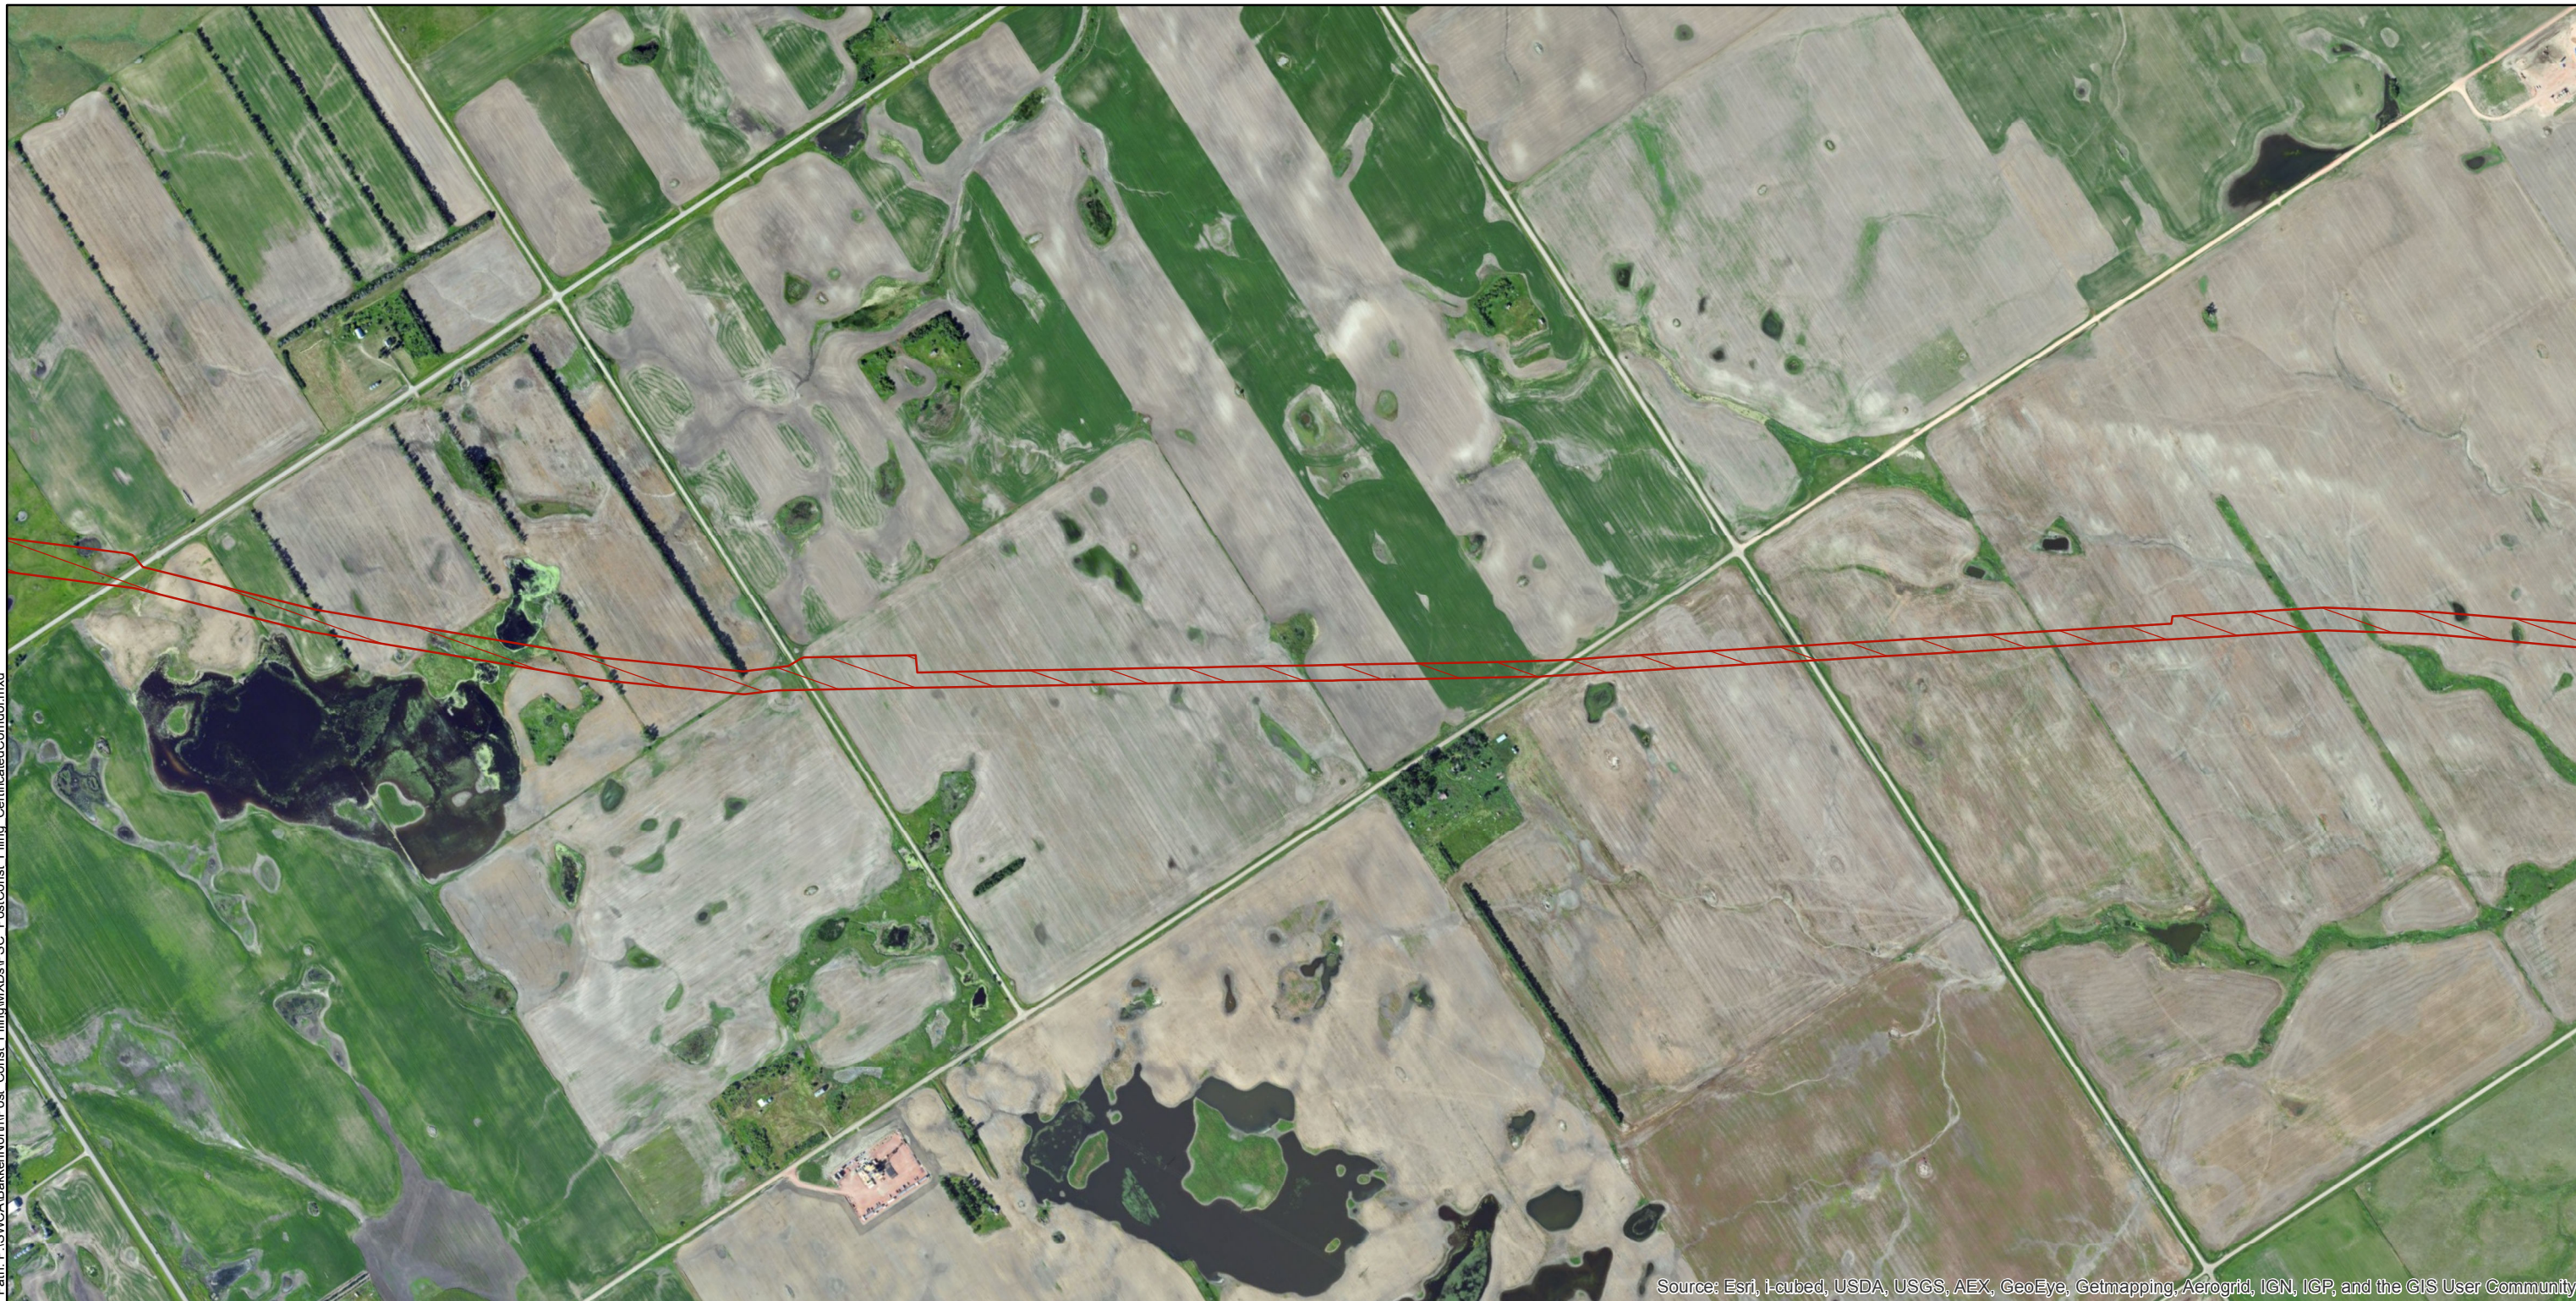


Source: Esri, i-cubed, USDA, USGS, AEX, GeoEye, Getmapping, Aerogrid, IGN, IGP, and the GIS User Community

Author: TTD
Date: 4/5/2013

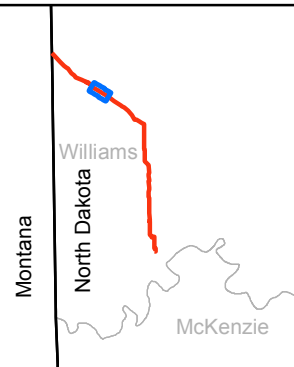

 Certificated Corridor

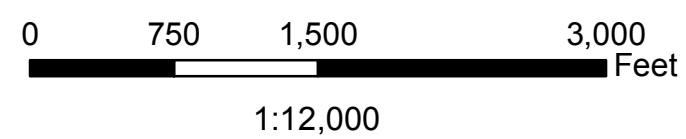


Bakken North
 PCS Post Construction Filing
 Certificated Corridor

Docket No. PU-10-630
 Certificate of Corridor Compatibility No 127


Map 4 of 14
 Williams County, ND

Path: P:\SWCA\BakkenNorth\Post_Const_Filing\MXDs\FSC_PostConst_Filing_CertificatedCorridor.mxd

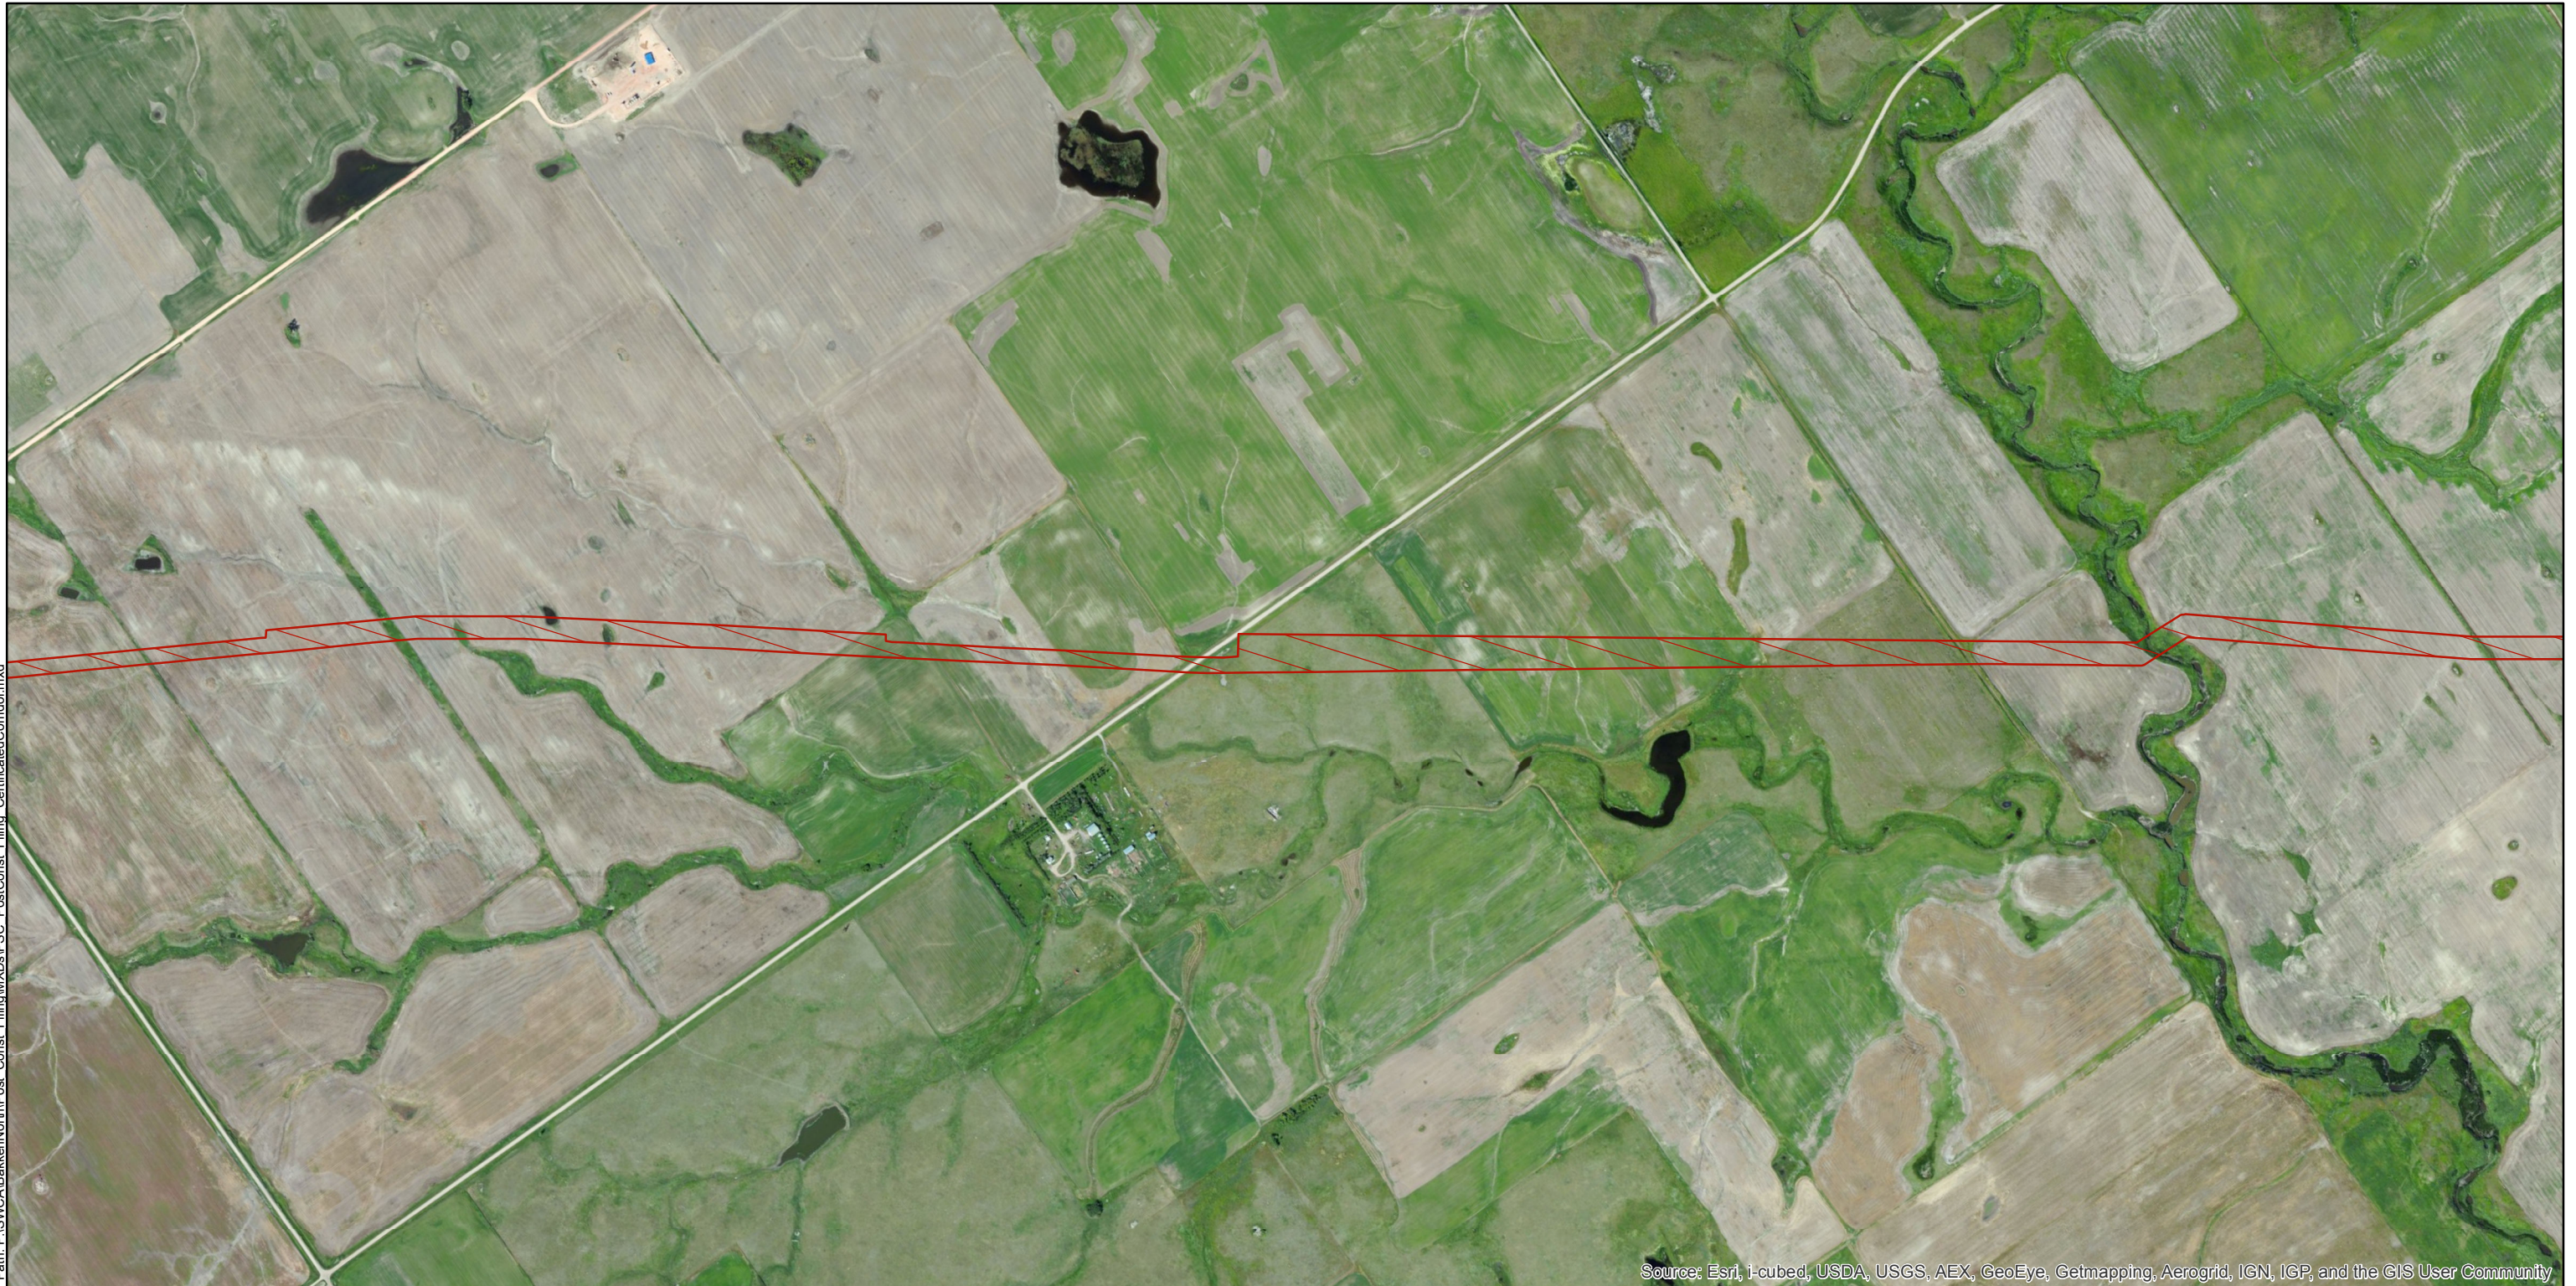


Source: Esri, i-cubed, USDA, USGS, AEX, GeoEye, Getmapping, Aerogrid, IGN, IGP, and the GIS User Community

Author: TTD Date: 4/5/2013

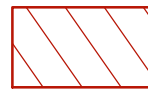

Certificated Corridor

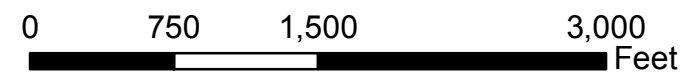

1:12,000

Bakken North
 PCS Post Construction Filing
 Certificated Corridor

Docket No. PU-10-630
 Certificate of Corridor Compatibility No 127


Map 5 of 14
 Williamsl County, ND

Path: P:\SWCA\BakkenNorth\Post_Const_Filing\MXDs\FSC_PostConst_Filing_CertificatedCorridor.mxd




Source: Esri, i-cubed, USDA, USGS, AEX, GeoEye, Getmapping, Aerogrid, IGN, IGP, and the GIS User Community

Author: TTD
Date: 4/5/2013

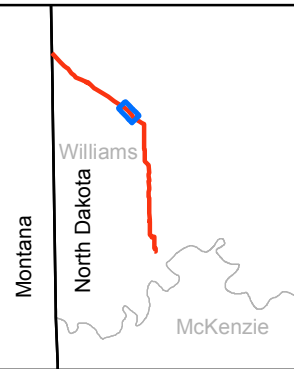

 Certified Corridor

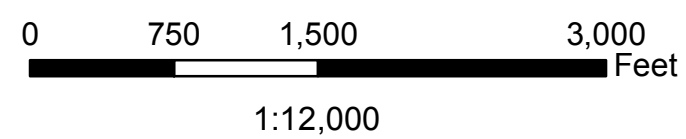

Bakken North
 PCS Post Construction Filing
 Certificated Corridor

Docket No. PU-10-630
 Certificate of Corridor Compatibility No 127


Map 6 of 14
 Williamsl County, ND

Path: P:\SWCA\BakkenNorth\Post Const. Filing\MXDs\FSC_PostConst_Filing_CertificatedCorridor.mxd




Source: Esri, i-cubed, USDA, USGS, AEX, GeoEye, Getmapping, Aerogrid, IGN, IGP, and the GIS User Community

Author: TTD
Date: 4/5/2013

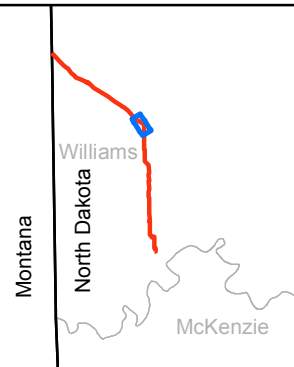

 Certified Corridor

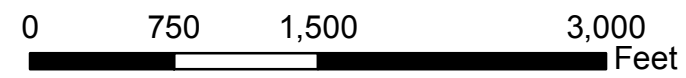

1:12,000



Bakken North
 PCS Post Construction Filing
 Certificated Corridor

Docket No. PU-10-630
 Certificate of Corridor Compatibility No 127



Map 7 of 14
 Williams County, ND

Path: P:\SWCA\BakkenNorth\Post_Const_Filing\MXD\PCS_PostConst_Filing_CertificatedCorridor.mxd





Source: Esri, i-cubed, USDA, USGS, AEX, GeoEye, Getmapping, Aerogrid, IGN, IGP, and the GIS User Community

Author: TTD
Date: 4/5/2013

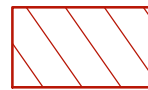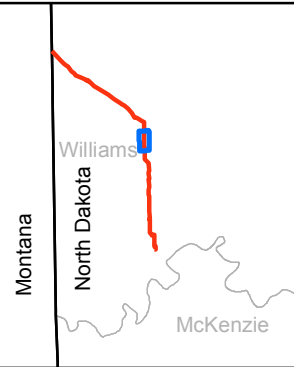

Certificated Corridor

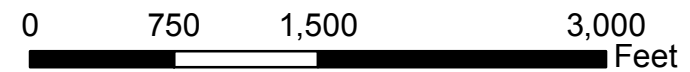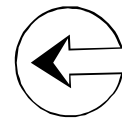

1:12,000



Bakken North
PCS Post Construction Filing
Certificated Corridor

Docket No. PU-10-630
Certificate of Corridor Compatibility No 127



Map 8 of 14
Williams County, ND

Path: P:\SWCA\BakkenNorth\Post Const. Filing\MXDs\FSC_PostConst_Filing_CertificatedCorridor.mxd





Source: Esri, i-cubed, USDA, USGS, AEX, GeoEye, Getmapping, Aerogrid, IGN, IGP, and the GIS User Community

Author: TTD Date: 4/5/2013

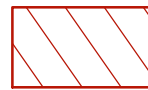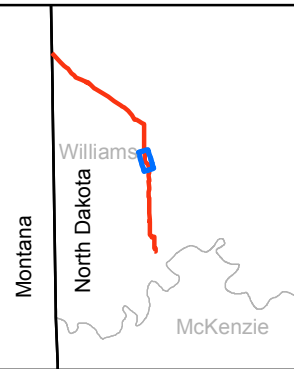

Certificated Corridor

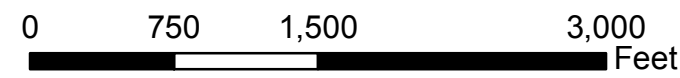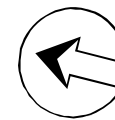

1:12,000

Bakken North
 PCS Post Construction Filing
 Certificated Corridor

Docket No. PU-10-630
 Certificate of Corridor Compatibility No 127



Map 9 of 14
 Williams County, ND

Path: P:\SWCA\BakkenNorth\Post_Const_Filing\MXDs\FSC_PostConst_Filing_CertificatedCorridor.mxd





Source: Esri, i-cubed, USDA, USGS, AEX, GeoEye, Getmapping, Aerogrid, IGN, IGP, and the GIS User Community

Author: TTD Date: 4/5/2013

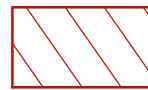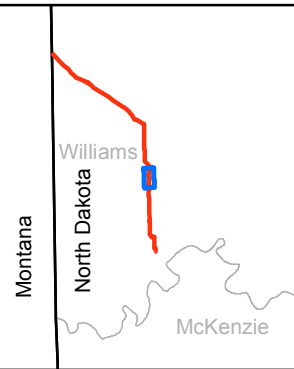


Certificated Corridor

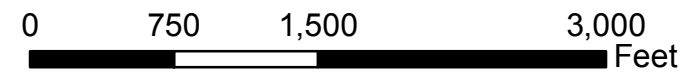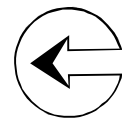

1:12,000



Enhancing Execution with Experience

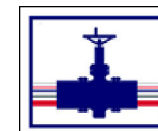


PLAINS ALL AMERICAN PIPELINE, L.P.

Bakken North
 PCS Post Construction Filing
 Certificated Corridor

Docket No. PU-10-630
 Certificate of Corridor Compatibility No 127



Map 10 of 14
 Williams County, ND

Path: P:\SWCA\BakkenNorth\Post Const Filing\MXDs\FSC_PostConst_Filing_CertificatedCorridor.mxd


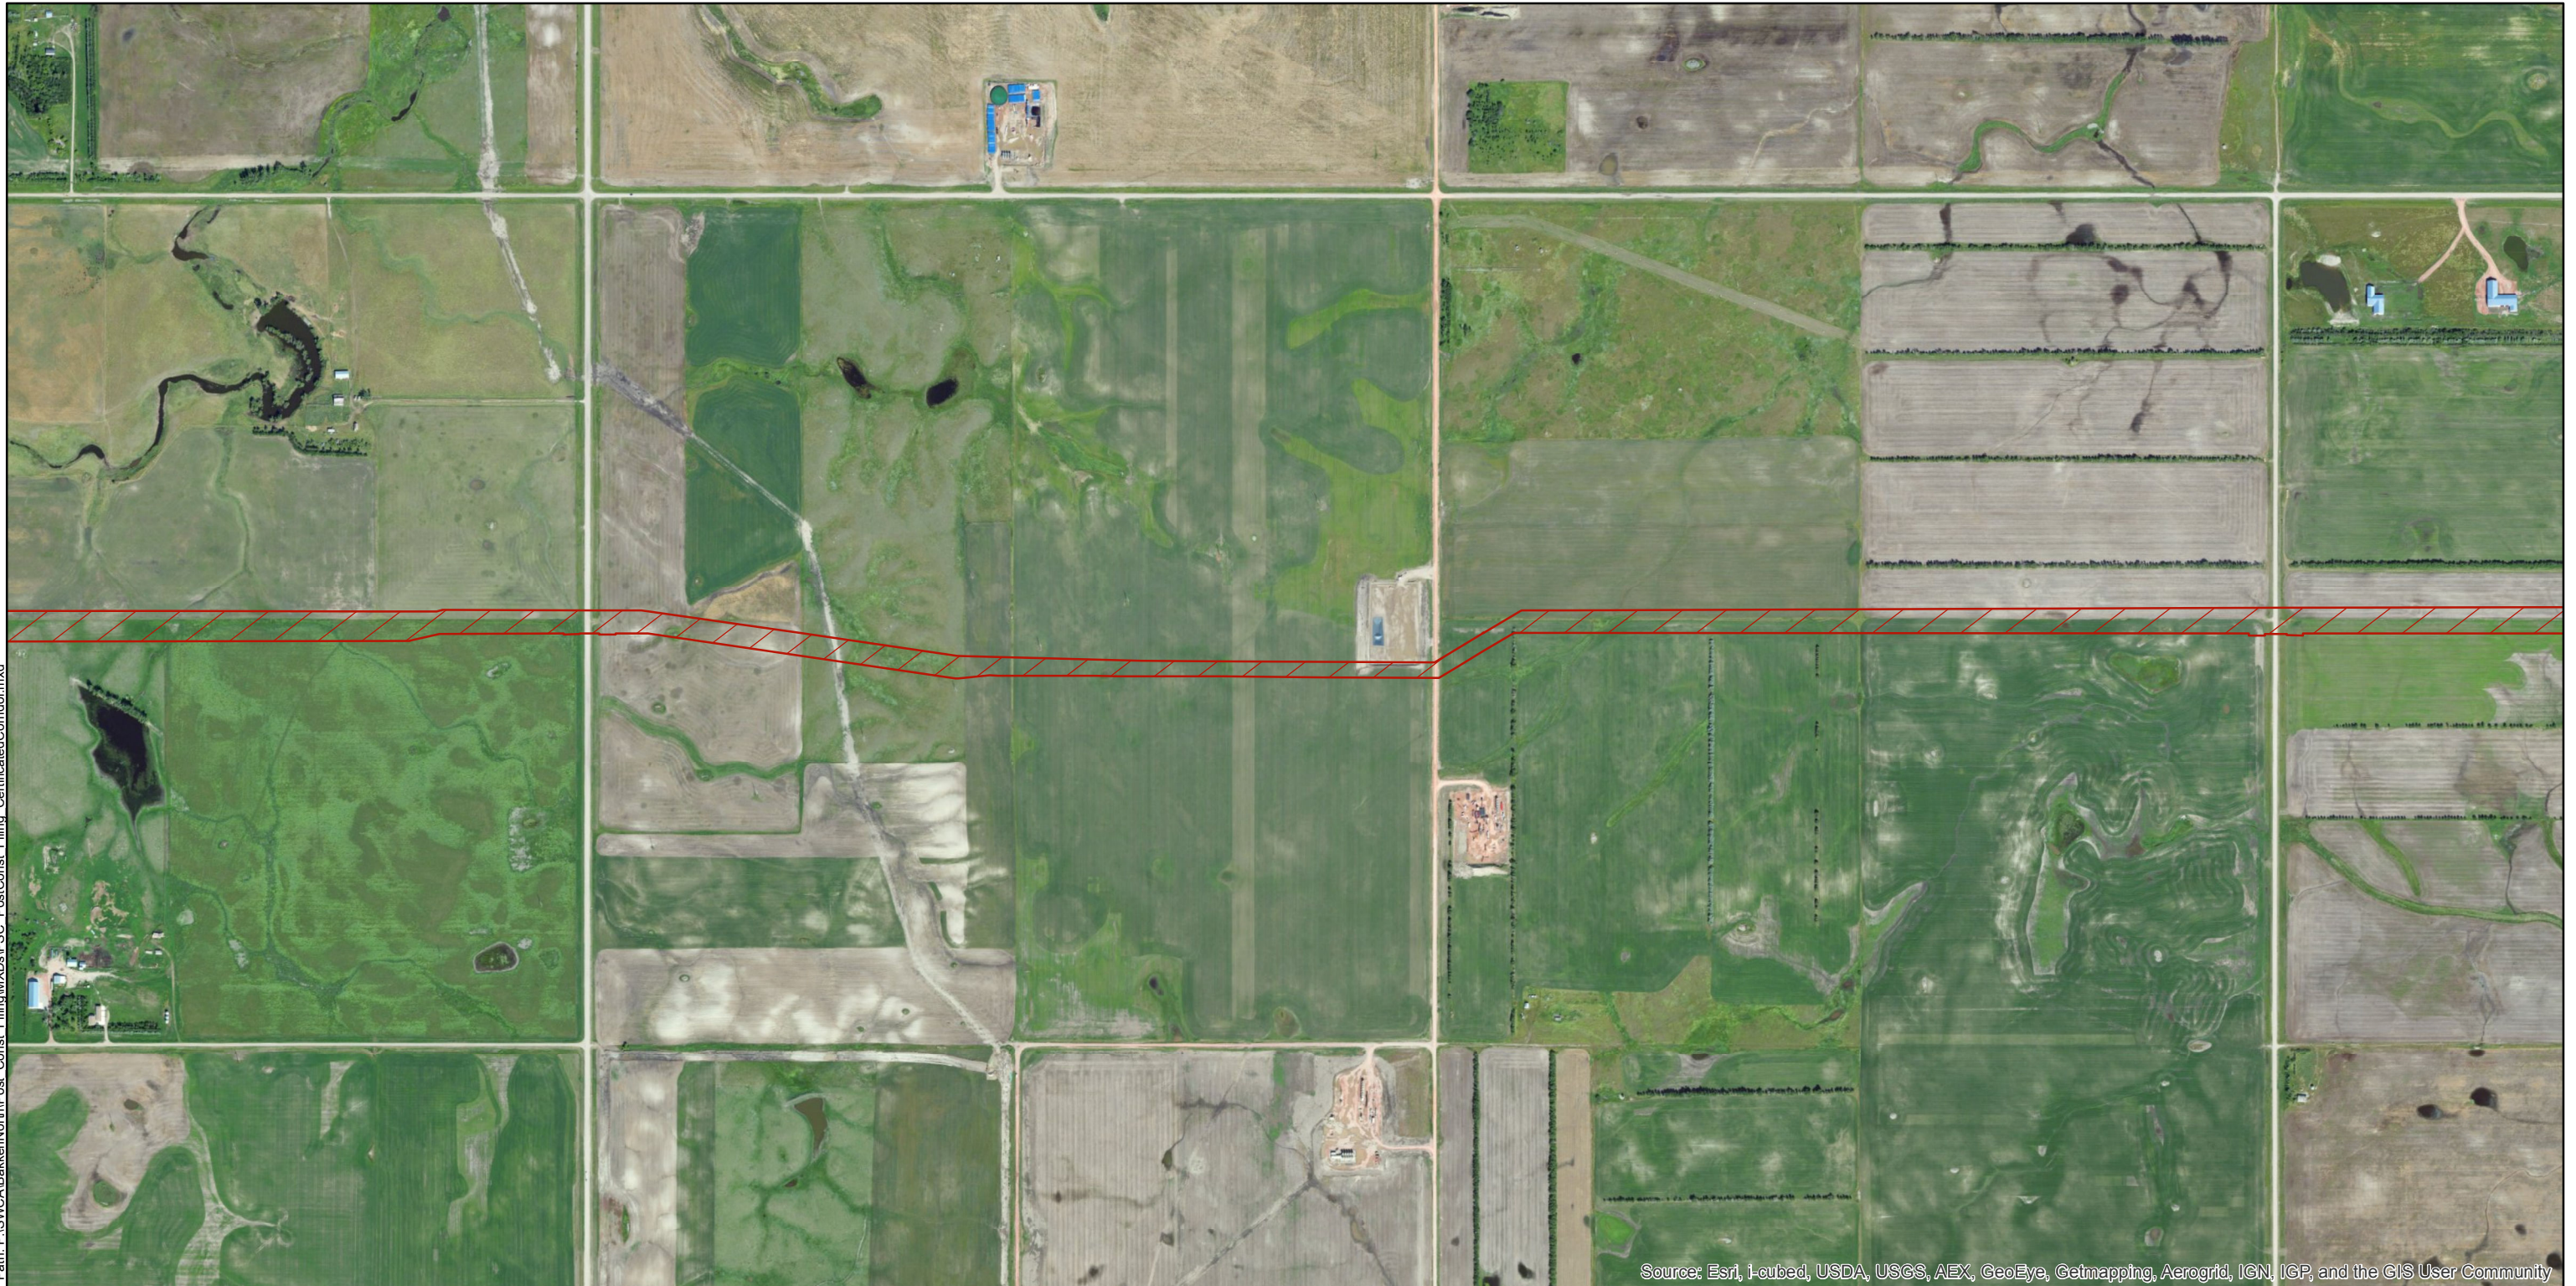


Source: Esri, i-cubed, USDA, USGS, AEX, GeoEye, Getmapping, Aerogrid, IGN, IGP, and the GIS User Community

Author: TTD Date: 4/5/2013

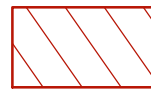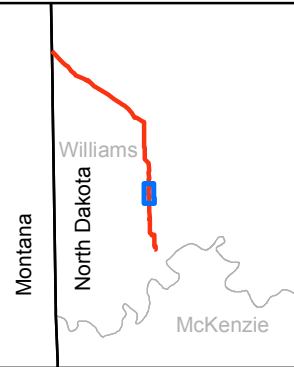

Certificated Corridor

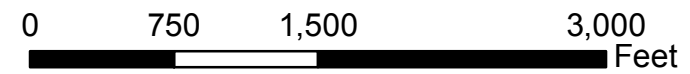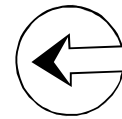

1:12,000




Bakken North
 PCS Post Construction Filing
 Certificated Corridor

Docket No. PU-10-630
 Certificate of Corridor Compatibility No 127



Map 11 of 14
 Williamsl County, ND

Path: P:\SWCA\BakkenNorth\Post Const. Filing\MXDs\FSC_PostConst_Filing_CertificatedCorridor.mxd

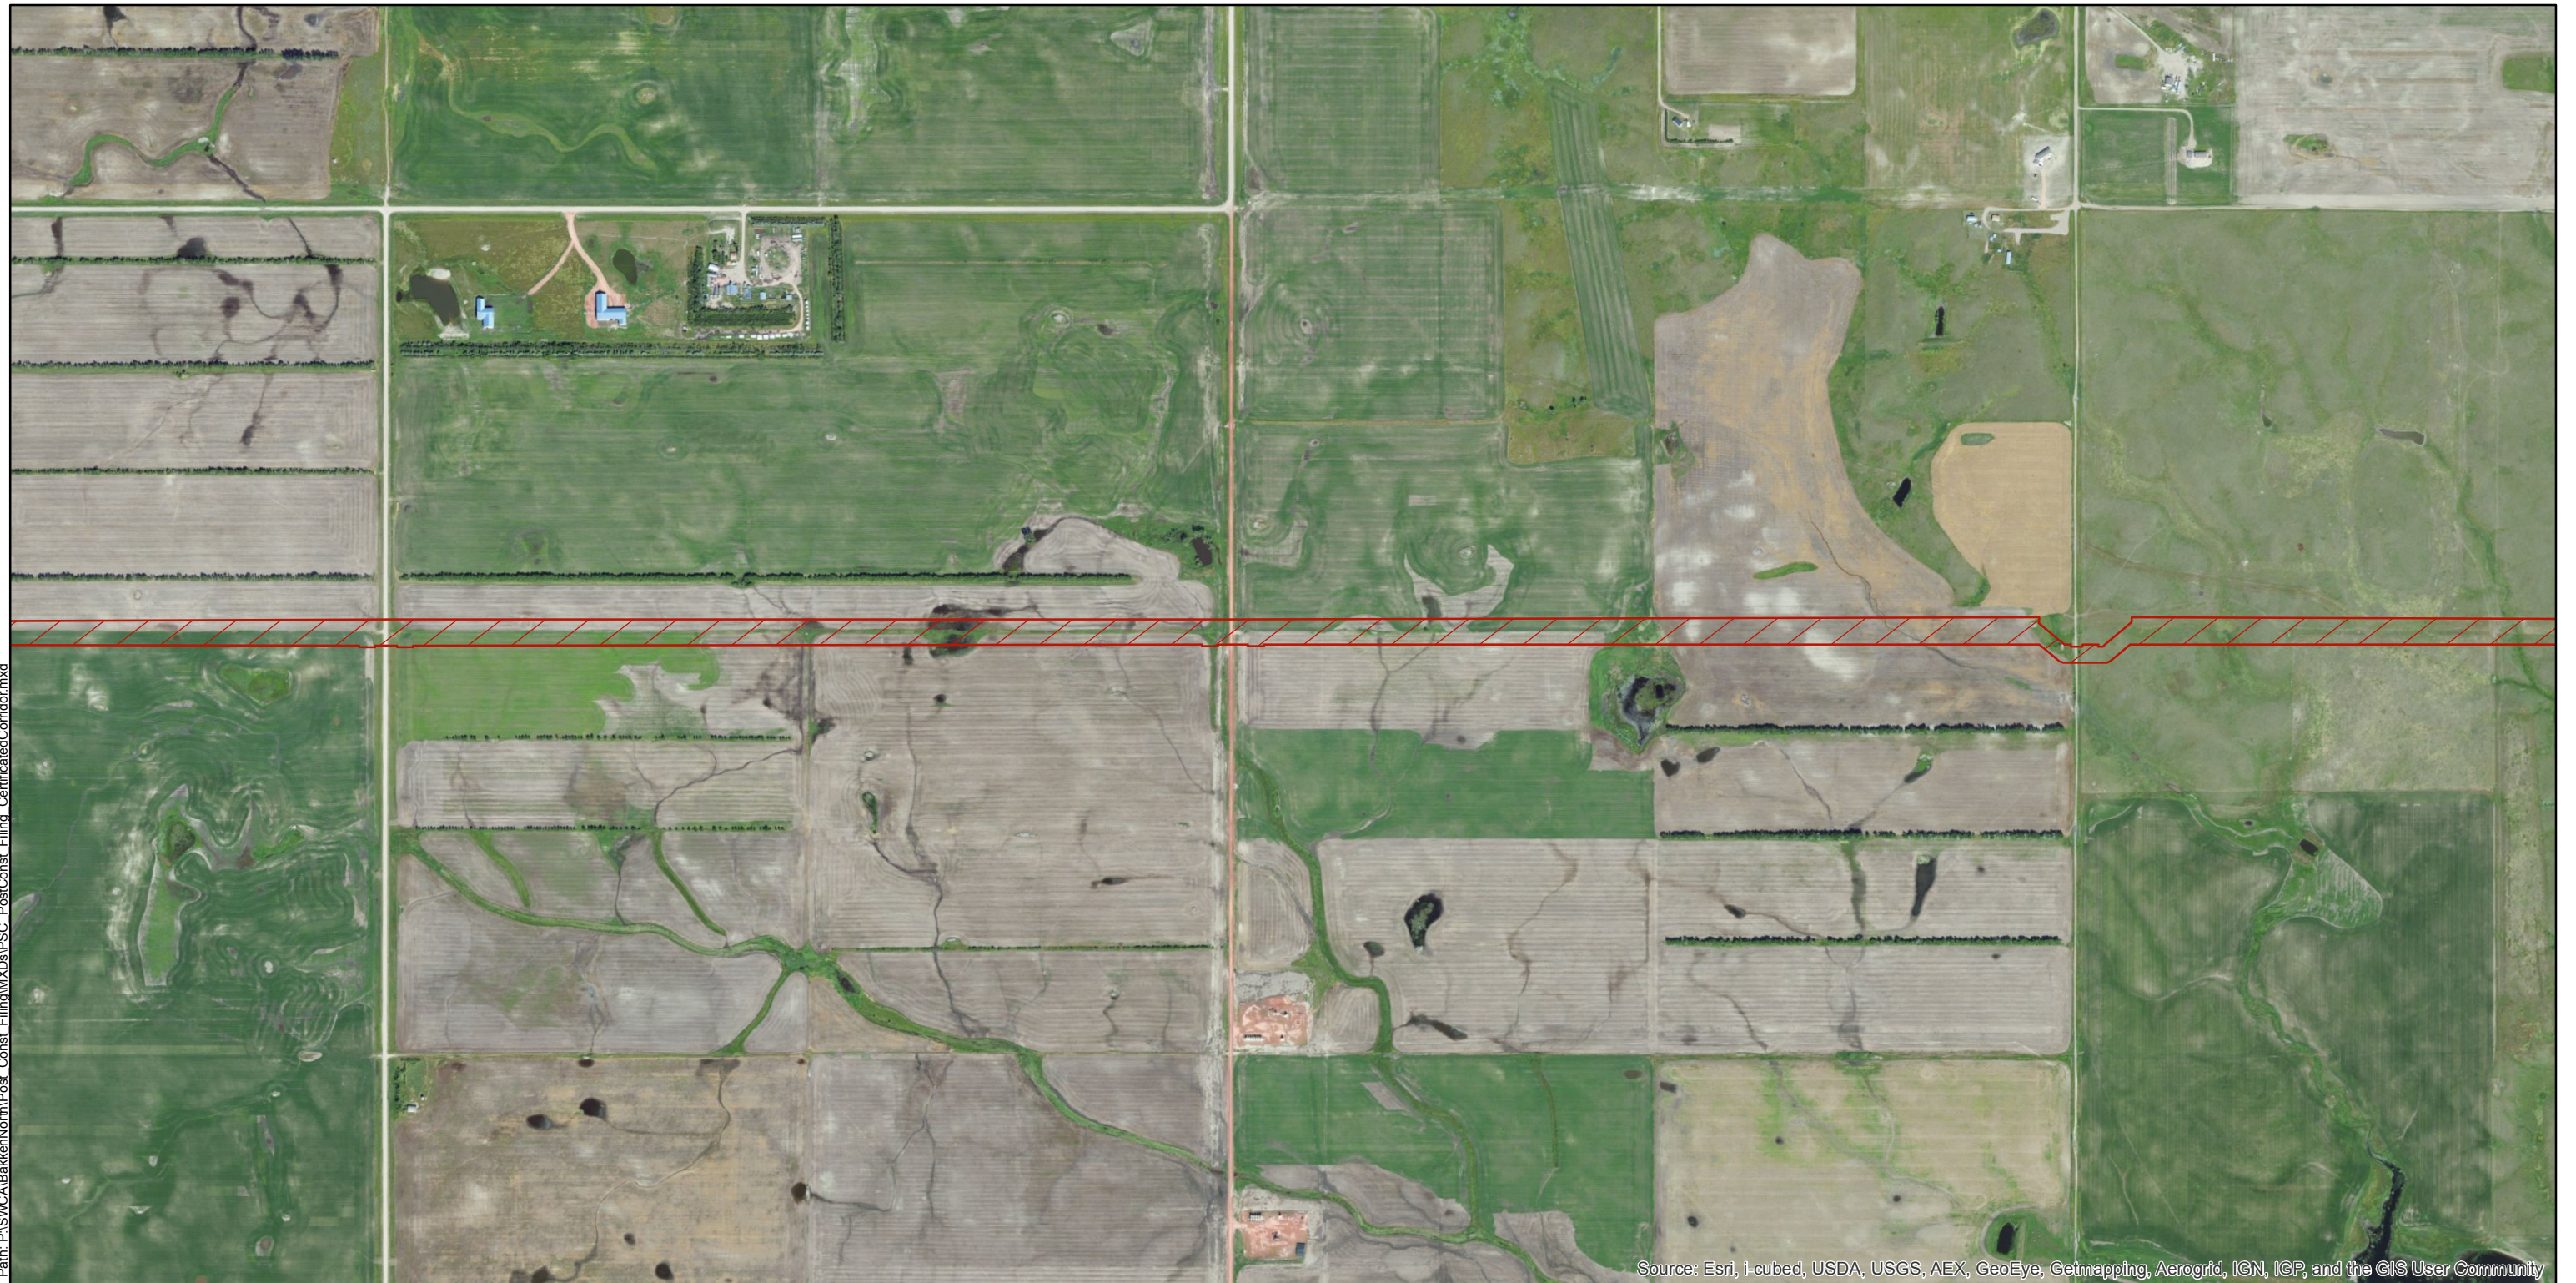


Source: Esri, i-cubed, USDA, USGS, AEX, GeoEye, Getmapping, Aerogrid, IGN, IGP, and the GIS User Community


Author: TTD Date: 4/5/2013

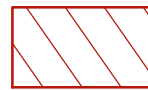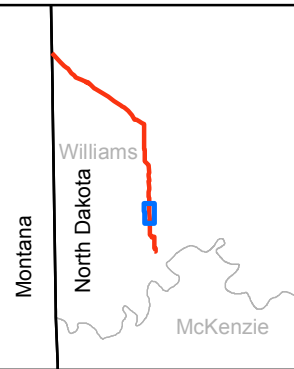


Certificated Corridor

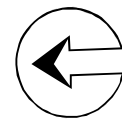

Enhancing Execution with Experience

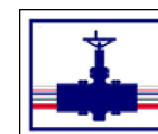

PLAINS ALL AMERICAN PIPELINE, L.P.

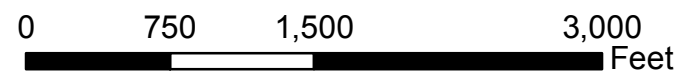

1:12,000

Bakken North
PCS Post Construction Filing
Certificated Corridor

Docket No. PU-10-630
Certificate of Corridor Compatibility No 127


Map 12 of 14
Williamsl County, ND

Path: P:\SWCA\BakkenNorth\Post_Const_Filing\MXDs\FSC_PostConst_Filing_CertificatedCorridor.mxd




Source: Esri, i-cubed, USDA, USGS, AEX, GeoEye, Getmapping, Aerogrid, IGN, IGP, and the GIS User Community

Author: TTD Date: 4/5/2013

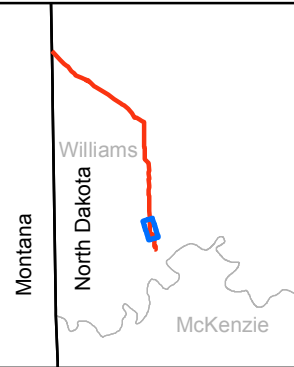

 Certified Corridor

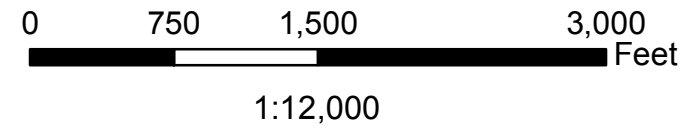

Bakken North
 PCS Post Construction Filing
 Certificated Corridor

Docket No. PU-10-630
 Certificate of Corridor Compatibility No 127


Map 13 of 14
 Williams County, ND

Path: P:\SWCA\BakkenNorth\Post_Const_Filing\MXD\PCS_PostConst_Filing_CertificatedCorridor.mxd





Source: Esri, i-cubed, USDA, USGS, AEX, GeoEye, Getmapping, Aerogrid, IGN, IGP, and the GIS User Community

Author: TTD Date: 4/5/2013

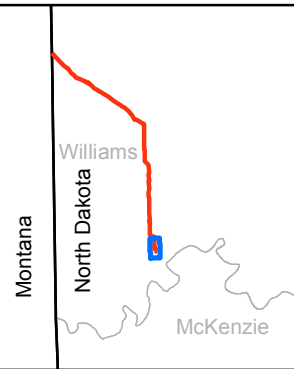

 Certified Corridor

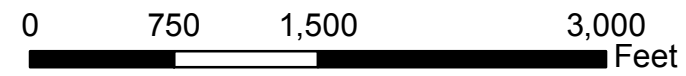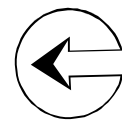

1:12,000



Bakken North
 PCS Post Construction Filing
 Certificated Corridor

Docket No. PU-10-630
 Certificate of Corridor Compatibility No 127

Map 14 of 14
 Williamsl County, ND