

Barr Footer: ArcGIS 10.0, 2011-08-23 10:52:15.922000 File: I:\Projects\34521002\GIS\Maps\Reports\Aug_2011\1Route Modification 2a - August 2011.mxd User: kac2




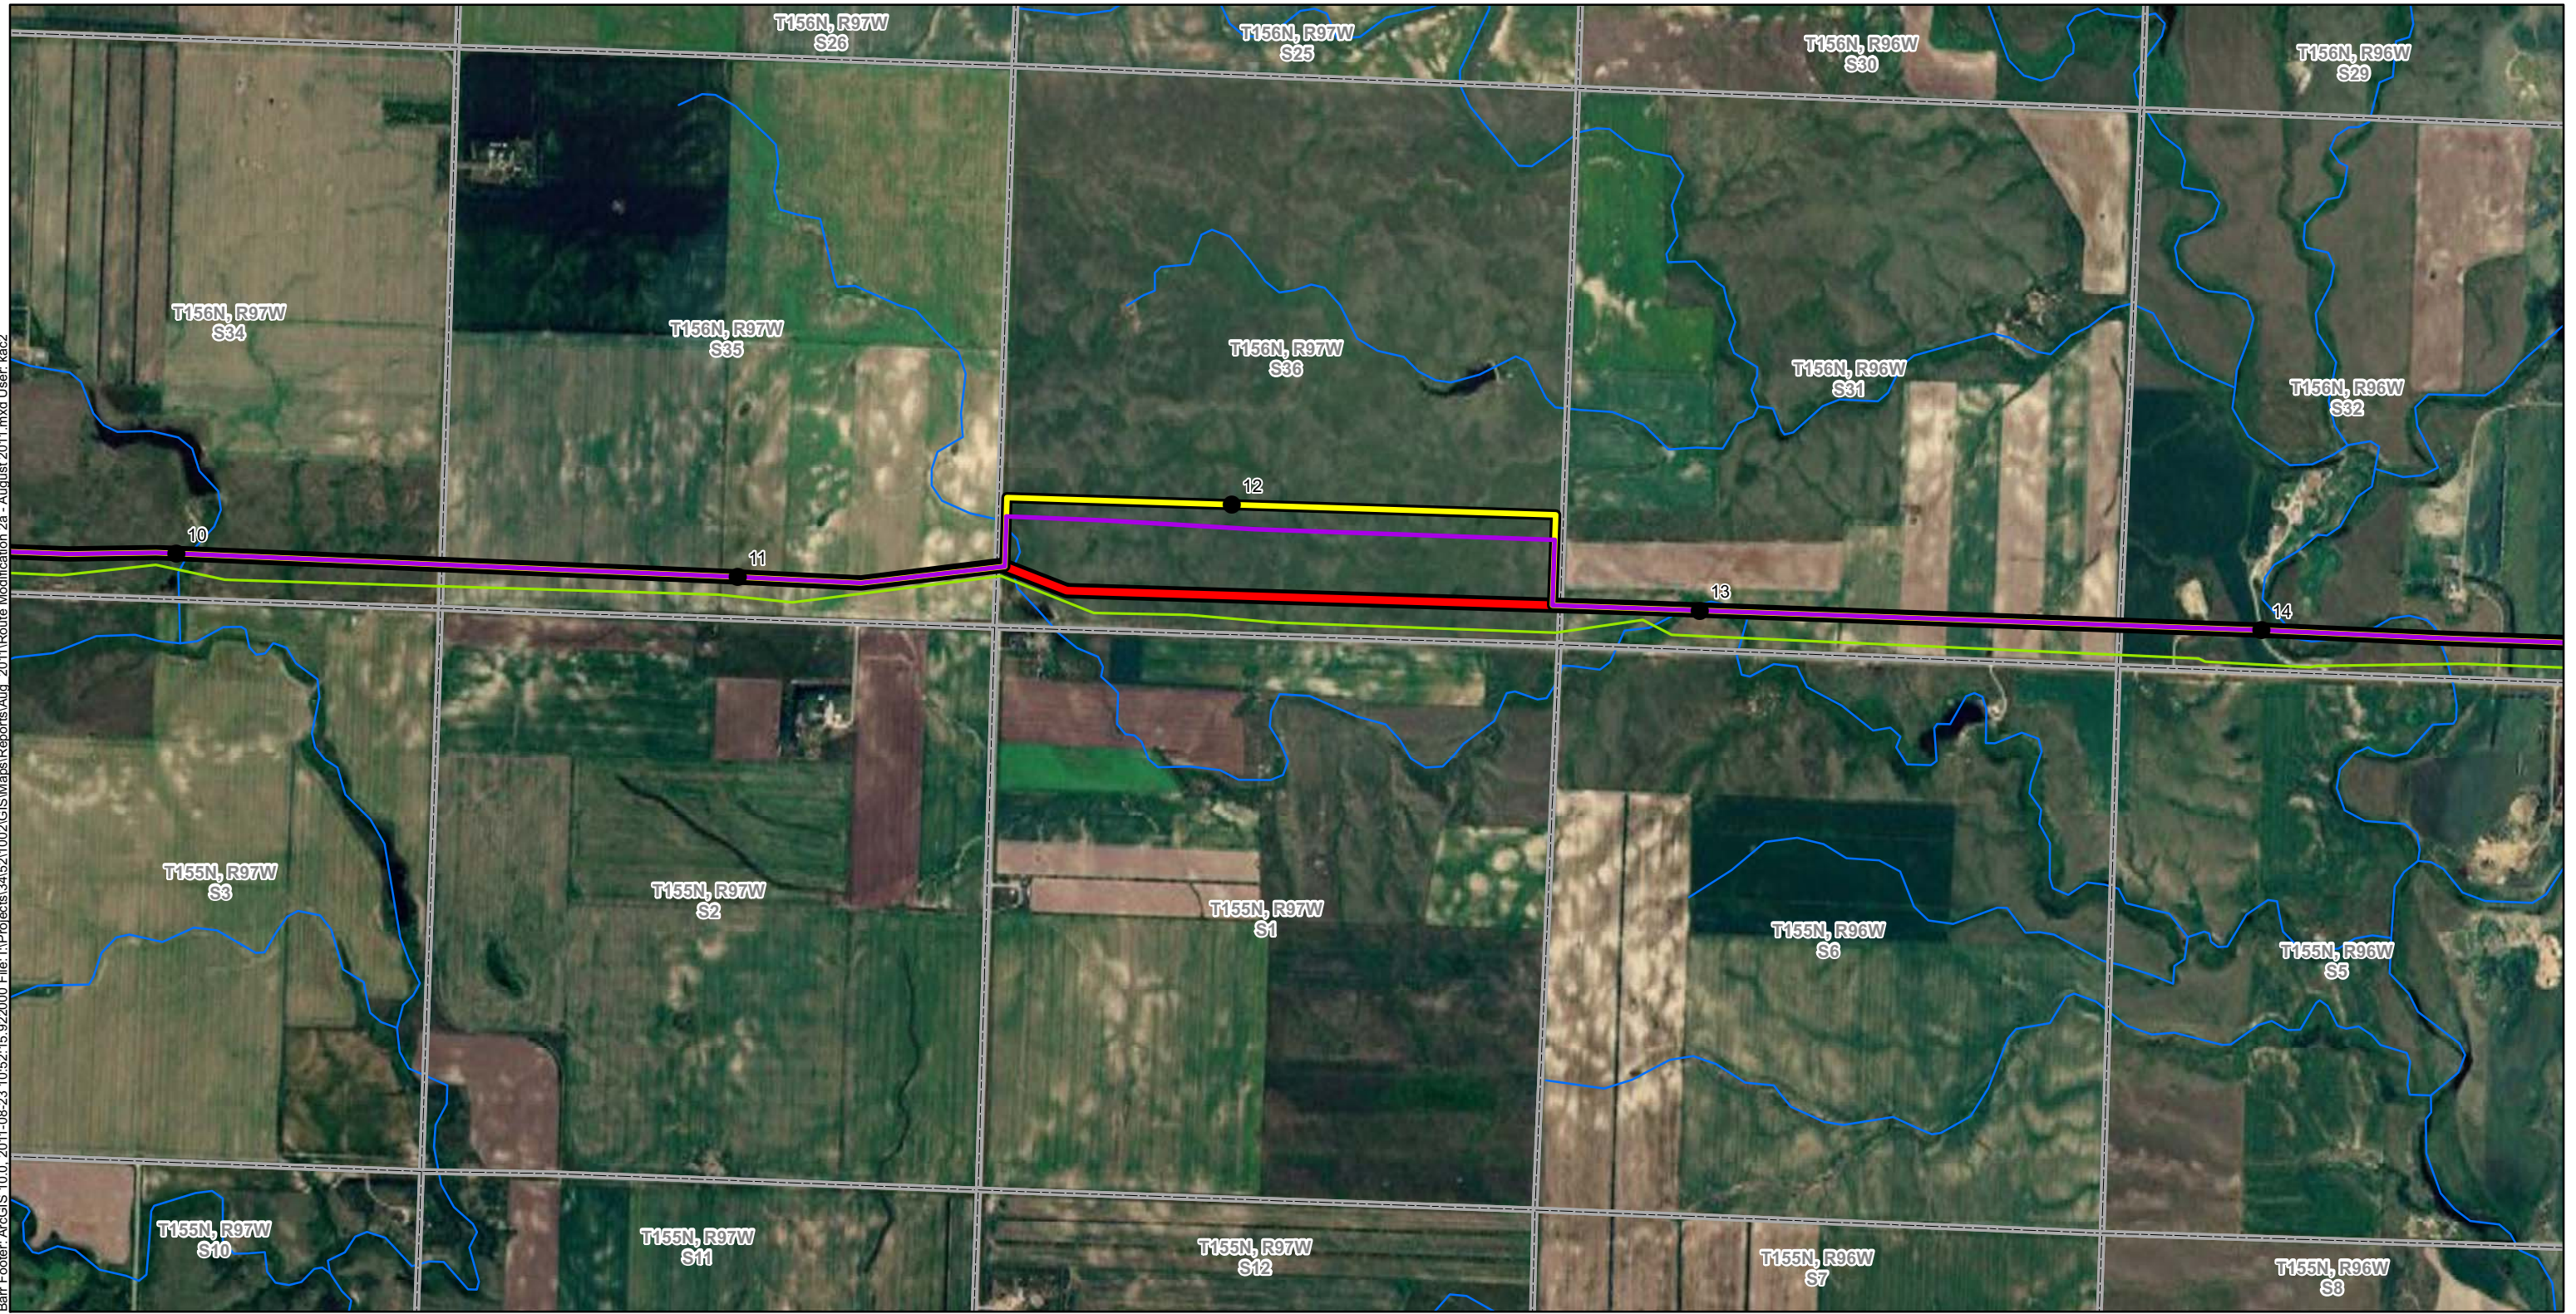




Image: ESRI Image Server, 2009, 1.0 Meter Resolution

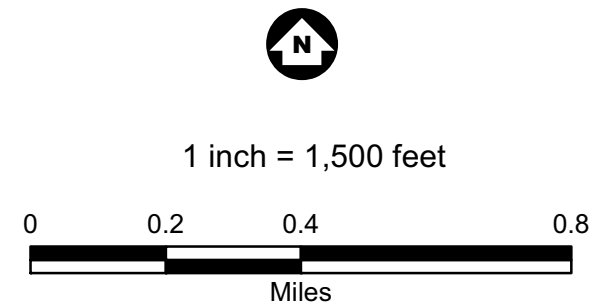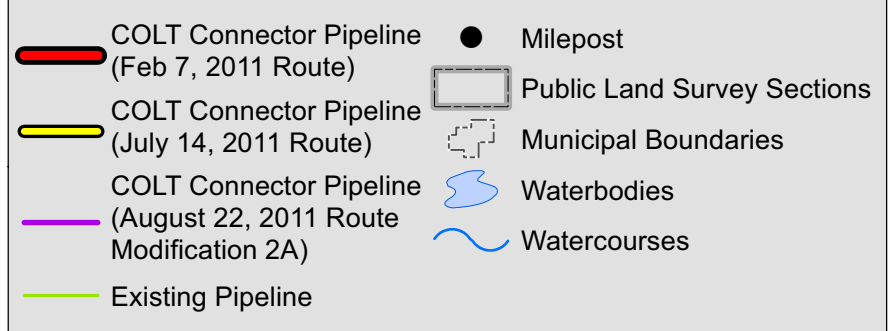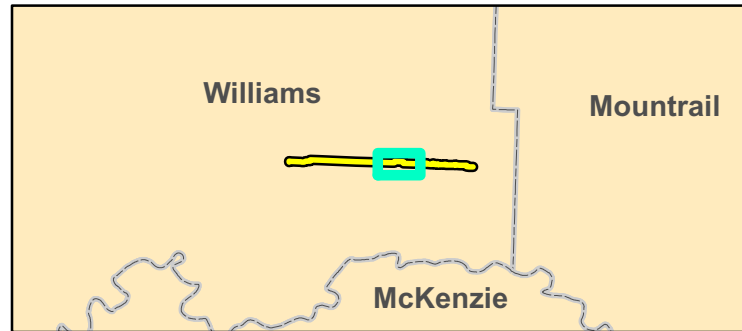

ROUTE MODIFICATION 2A
AUGUST 2011
COLT Connector Pipeline
Williams County, North Dakota