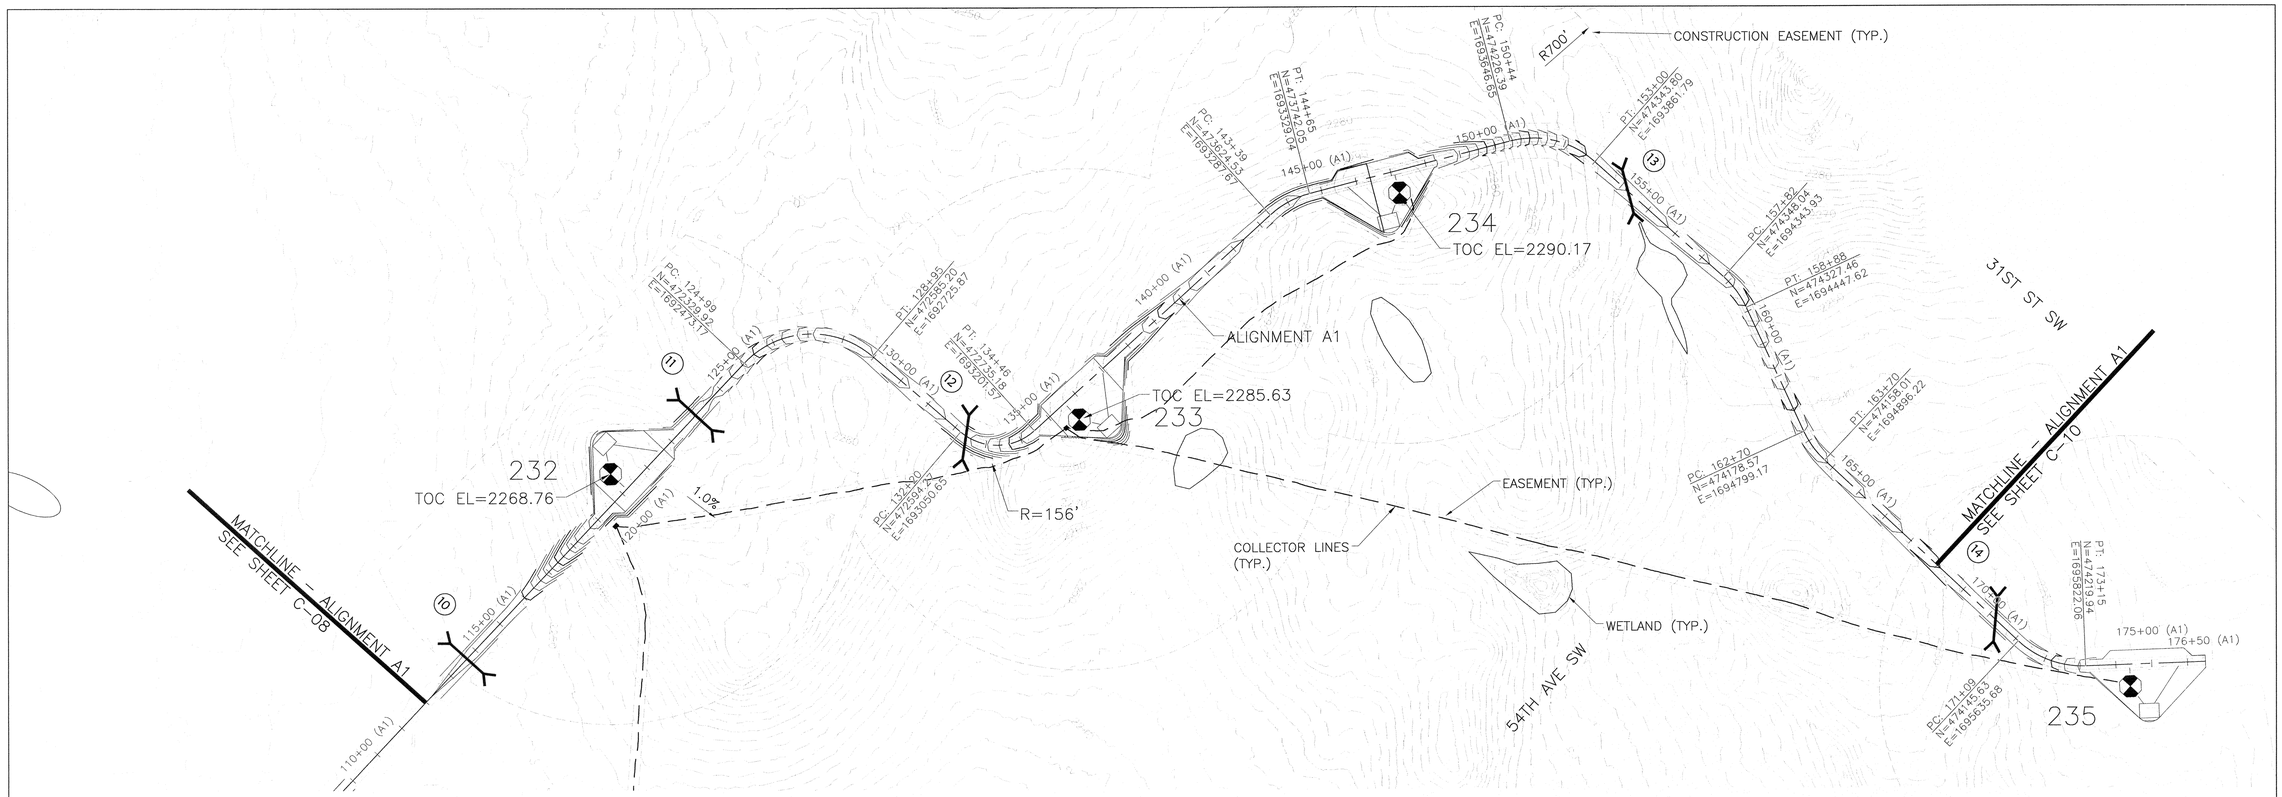

1 PLAN: ALIGNMENT A1

0 200 400
SCALE IN FEET

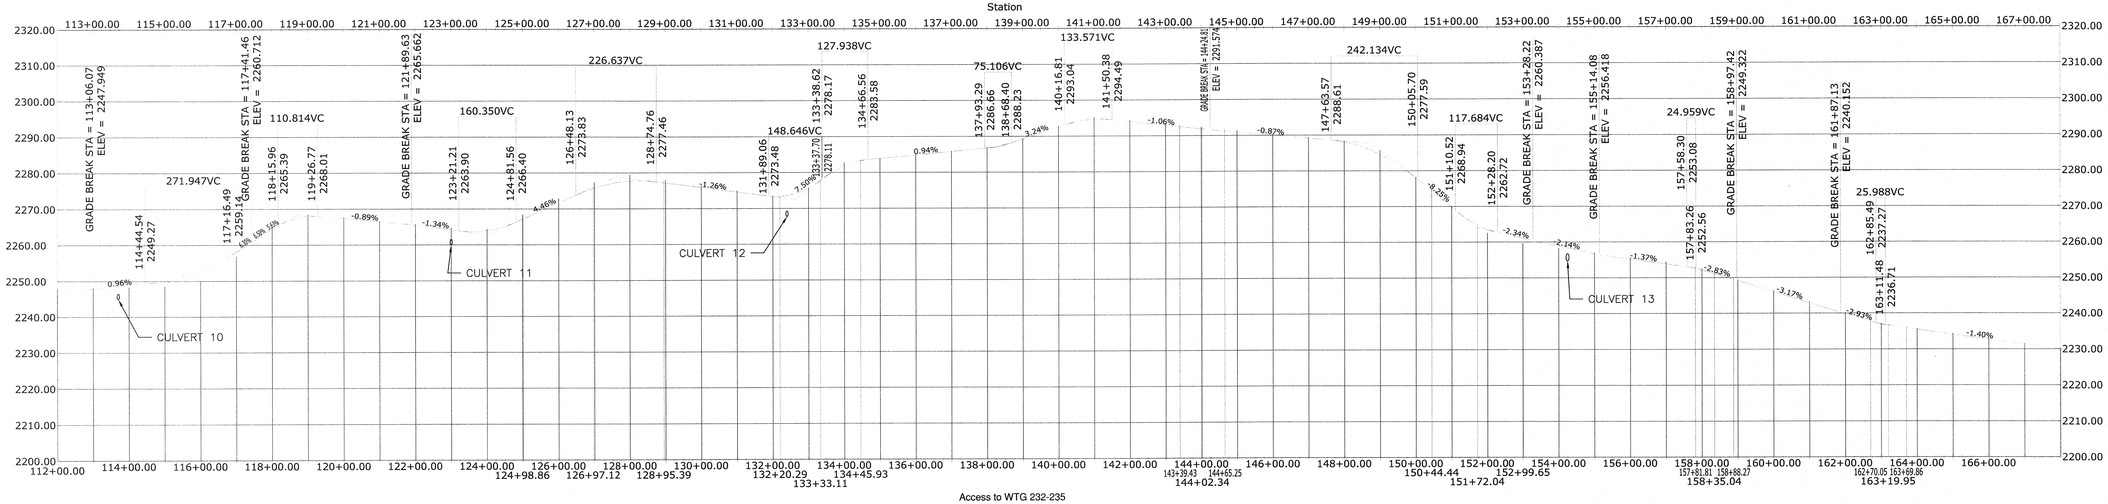

2 PROFILE: ALIGNMENT A1

0 200 400 0 20 40
HORIZONTAL SCALE IN FEET VERTICAL SCALE IN FEET

EXTERNAL REFERENCE:
34331007-BASE-C3D-DESIGN-ROADS-AS-BUILT.DWG

NO.	BY	CHK.	APP.	DATE	REVISION DESCRIPTION
A	DMD	CAD	JXB	05/27/11	60 PERCENT SUBMITTAL
B	CAD	CAD	JXB	07/01/11	90 PERCENT SUBMITTAL
0	DMD	CAD	JXB	08/12/11	ISSUED FOR CONSTRUCTION
1	NJG	.	.	2/27/13	CONSTRUCTION REVISIONS

REV.1

RELEASED TO/FOR	A	B	C	0	1	2	3
CLIENT	05/27/11	07/01/11					
BID							
CONSTRUCTION				08/12/11			
PERMITTING							
RECORD							
DATE RELEASED							

[redacted]

BARR

Corporate Headquarters:
Minneapolis, Minnesota
Ph: 1-800-632-2277

Project Office:
BARR ENGINEERING CO.
4700 WEST 77TH STREET
MINNEAPOLIS, MN.
55435-4803
Ph: 1-800-632-2277
Fax: (952) 832-2601
www.barr.com

Scale	AS SHOWN
Date	05/20/11
Drawn	DMD
Checked	JXB
Designed	CAD
Approved	JXB

minnesota power
AN ALLETE COMPANY

Bison

A WIND ENERGY INITIATIVE OF MINNESOTA POWER IN NORTH DAKOTA

BISON 2 WIND PROJECT
MORTON & OLIVER COUNTIES, NORTH DAKOTA

PLAN AND PROFILE
ALIGNMENT A1 – STA. 112+00 TO 168+00

BARR PROJECT No. 34/33-1007
CLIENT PROJECT No.
DWG. No. C-09
REV. No. 1