

[XXXX]  
**CABLE TAG DETAIL**

**SPLICE ENCLOSURE DETAIL**  
**ABOVE GRADE 3-WAY**  
 N.T.S.


**NOTES:**

1. A MINIMUM OF 50 FEET OF EACH CABLE MUST BE LEFT AT THE SPLICE ENCLOSURE.
2. REFER TO DRAWINGS E-SD-03 AND E-SD-04 FOR CABINET LAYOUT DETAILS.
3. ALL TRACER WIRES TO TERMINATE TO ELECTRICALLY ISOLATED BUS BAR. LABEL BUS BAR "TRACER WIRES ONLY - DO NOT GROUND".
4. ALL FIBERS AND TRACER WIRES MUST BE LABELED WITHIN 12" OF TERMINATION WITH CABLE/WIRE DESTINATION.

BILL OF MATERIALS - FIBER OPTIC SPLICE, 3-WAY, ABOVE GRADE					
ITEM	QUANTITY	UNIT	DESCRIPTION	MANUFACTURER	CATALOG
63	3	FT	2" HDPE CONDUIT 90 DEGREE ELBOW, 24" RADIUS		
112	1	EA	SPLICE CLOSURE, FIBER OPTIC, 8" I.D. x 25"	TYCO	FOSC-450-B64-24-0-BOV
140	1	EA	BURIED PADMOUNT SPLICE CABINET, 2 STAKES (MS1342), 2 RECESSED	EMERSON	OPF0BD7
141	1	EA	PADMOUNT BRACKETS, (BA12)	EMERSON	PADMT200300
142	1	EA	SURFACE MOUNTING KIT W/ 2 BRACKETS	NORDIC	GS-30-18-30-MG-21X10
143	1	EA	SINGLE PHASE GROUND SLEEVE	HARGER	GBIS1416CGB



NO.	BY	CHK.	APP.	DATE	REVISION DESCRIPTION
A	RJG	CSF	CSF	7/1/11	90% DELIVERABLE
B	RJG	CSF	CSF	7/8/11	REVISED PER CLIENT COMMENTS
C	BNK	RJG	CSF	7/19/11	REVISED FOR QA CHECKS
D	BNK	RJG	CSF	7/21/11	REVISED PER CLIENTS COMMENTS
E	BNK	RJG	CSF	8/4/11	ISSUED FOR CONSTRUCTION
1	NJG	.	.	11/1/12	CONSTRUCTION REVISIONS, NO CHANGES

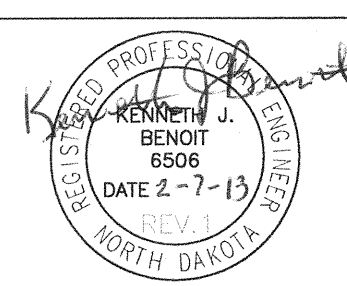


CLIENT	7/8/11/19/11/21/18/4/11
BID	
CONSTRUCTION	
PERMITTING	
RELEASED TO/FOR	B C D O 1 2 3
DATE RELEASED	



Project Office:  
 BARR ENGINEERING CO.  
 4700 WEST 77TH STREET  
 MINNEAPOLIS, MN,  
 55435-4803  
 Corporate Headquarters:  
 Minneapolis, Minnesota  
 Ph: 1-800-632-2277  
 Fax: (952) 832-2601  
 www.barr.com

Scale	N.T.S.
Date	07/01/11
Drawn	RJG
Checked	CSF
Designed	RJG
Approved	JLM

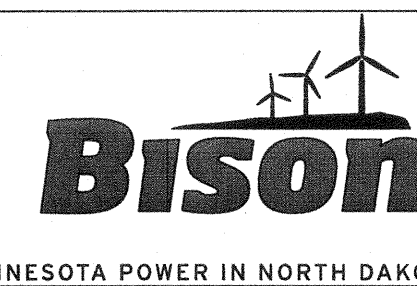

BISON 2 WIND PROJECT  
 MORTON & OLIVER COUNTIES, NORTH DAKOTA  
 COLLECTOR SYSTEM  
 ABOVE GRADE FIBER OPTIC SPLICE (3-WAY)

BARR PROJECT No.	34/33-1007
CLIENT PROJECT No.	
DWG. No.	E-FS-01
REV. No.	1