


LEGEND

- xxx TURBINE
- ⊕ METEOROLOGICAL TOWER
- SWITCH CABINET
- GROUNDING XFRMR
- FIBER HANDHOLE
- BUILDING SETBACK
- WETLAND BOUNDARY
- COLLECTOR LINE
- FIBER LINE

EXTERNAL REFERENCE:
 • 2010_NAIP.JPG

Images_in_Drawing - 2010_NAIP.JPG

A	CLD	SGP	CSF	6/3/11	60% DELIVERABLE
B	CLD	CEG	CSF	7/1/11	90% DELIVERABLE
C	RJG	CEG	CSF	7/21/11	MET TOWER, HANDHOLES, & LABELING REVISIONS
O	BNK	RJG	CSF	8/4/11	ISSUED FOR CONSTRUCTION
1	NUG	RJG	CSF	11/2/12	CONSTRUCTION REVISIONS
NO.	BY	CHK	APP.	DATE	REVISION DESCRIPTION

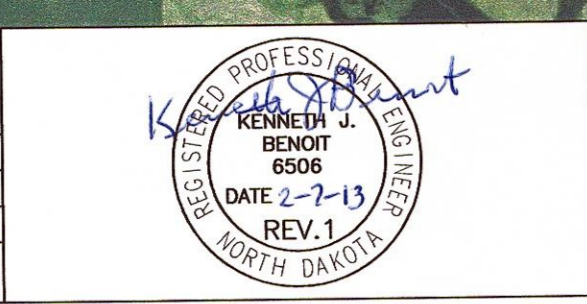

CLIENT						
BID						
CONSTRUCTION						
PERMITTING						
RELEASED TO/FOR	A	B	C	0	1	2
						3
	DATE RELEASED					

BARR
 Project Office:
 BARR ENGINEERING CO.
 4700 WEST 77TH STREET
 MINNEAPOLIS, MN.
 55435-4803
 Ph: 1-800-632-2277
 Fax: (952) 832-2601
 www.barr.com

Scale	1"=500'-0"
Date	06/03/11
Drawn	CLD
Checked	CEG
Designed	CLD
Approved	JLM



BISON 2 WIND PROJECT
 MORTON & OLIVER COUNTIES, NORTH DAKOTA
 34.5KV COLLECTOR SYSTEM
 GENERAL ARRANGEMENT

BARR PROJECT No. 34/33-1007	
CLIENT PROJECT No.	
DWG. No. E-GA10	REV. No. 1