




- LEGEND**
- xxx TURBINE
  - ⊕ METEOROLOGICAL TOWER
  - SWITCH CABINET
  - GROUNDING XFRMR
  - FIBER HANDHOLE
  - BUILDING SETBACK
  - WETLAND BOUNDARY
  - COLLECTOR LINE
  - FIBER LINE

**PIKE**  
ENERGY SOLUTIONS  
PIKE ENERGY SOLUTIONS, LLC.  
10101 Claude Freeman Drive, Suite 100W  
Charlotte, NC 28262  
ND License No. 954PE

EXTERNAL REFERENCE:  
• 2010\_NAIP.JPG

Images in Drawing - 2010\_NAIP.JPG

NO.	BY	CHK.	APP.	DATE	REVISION DESCRIPTION
A	CLD	SGP	CSF	6/3/11	60% DELIVERABLE
B	CLD	CEG	CSF	7/1/11	90% DELIVERABLE
C	RJG	CEG	CSF	7/21/11	MET TOWER, HANDHOLES, & LABELING REVISIONS
O	BNK	RJG	CSF	8/4/11	ISSUED FOR CONSTRUCTION
1	NJG	CSF		11/3/12	CONSTRUCTION REVISIONS

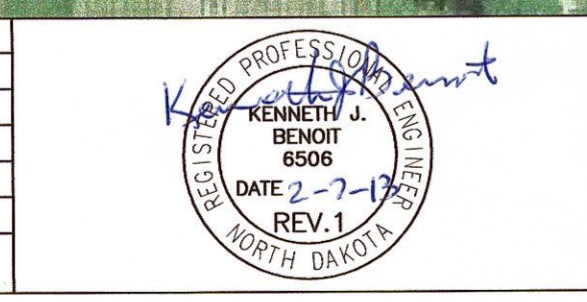

CLIENT	6/3/11/1/11/21/18/4/11
BID	
CONSTRUCTION	
PERMITTING	
RELEASED TO/FOR	A B C O 1 2 3
DATE RELEASED	

**BARR**  
Project Office:  
BARR ENGINEERING CO.  
4700 WEST 77TH STREET  
MINNEAPOLIS, MN.  
55435-4803  
Corporate Headquarters:  
Minneapolis, Minnesota  
Ph: 1-800-632-2277  
Ph: (952) 832-2601  
www.barr.com

Scale	1"=500'-0"
Date	06/03/11
Drawn	CLD
Checked	SGP
Designed	CLD
Approved	JLM

**minnesota power**  
AN ALLETE COMPANY  
**BISON**  
A WIND ENERGY INITIATIVE OF MINNESOTA POWER IN NORTH DAKOTA

BISON 2 WIND PROJECT  
MORTON & OLIVER COUNTIES, NORTH DAKOTA  
34.5KV COLLECTOR SYSTEM  
GENERAL ARRANGEMENT

BARR PROJECT No. 34/33-1007	CLIENT PROJECT No.
DWG. No. E-GA13	REV. No. 1