


EXHIBIT A

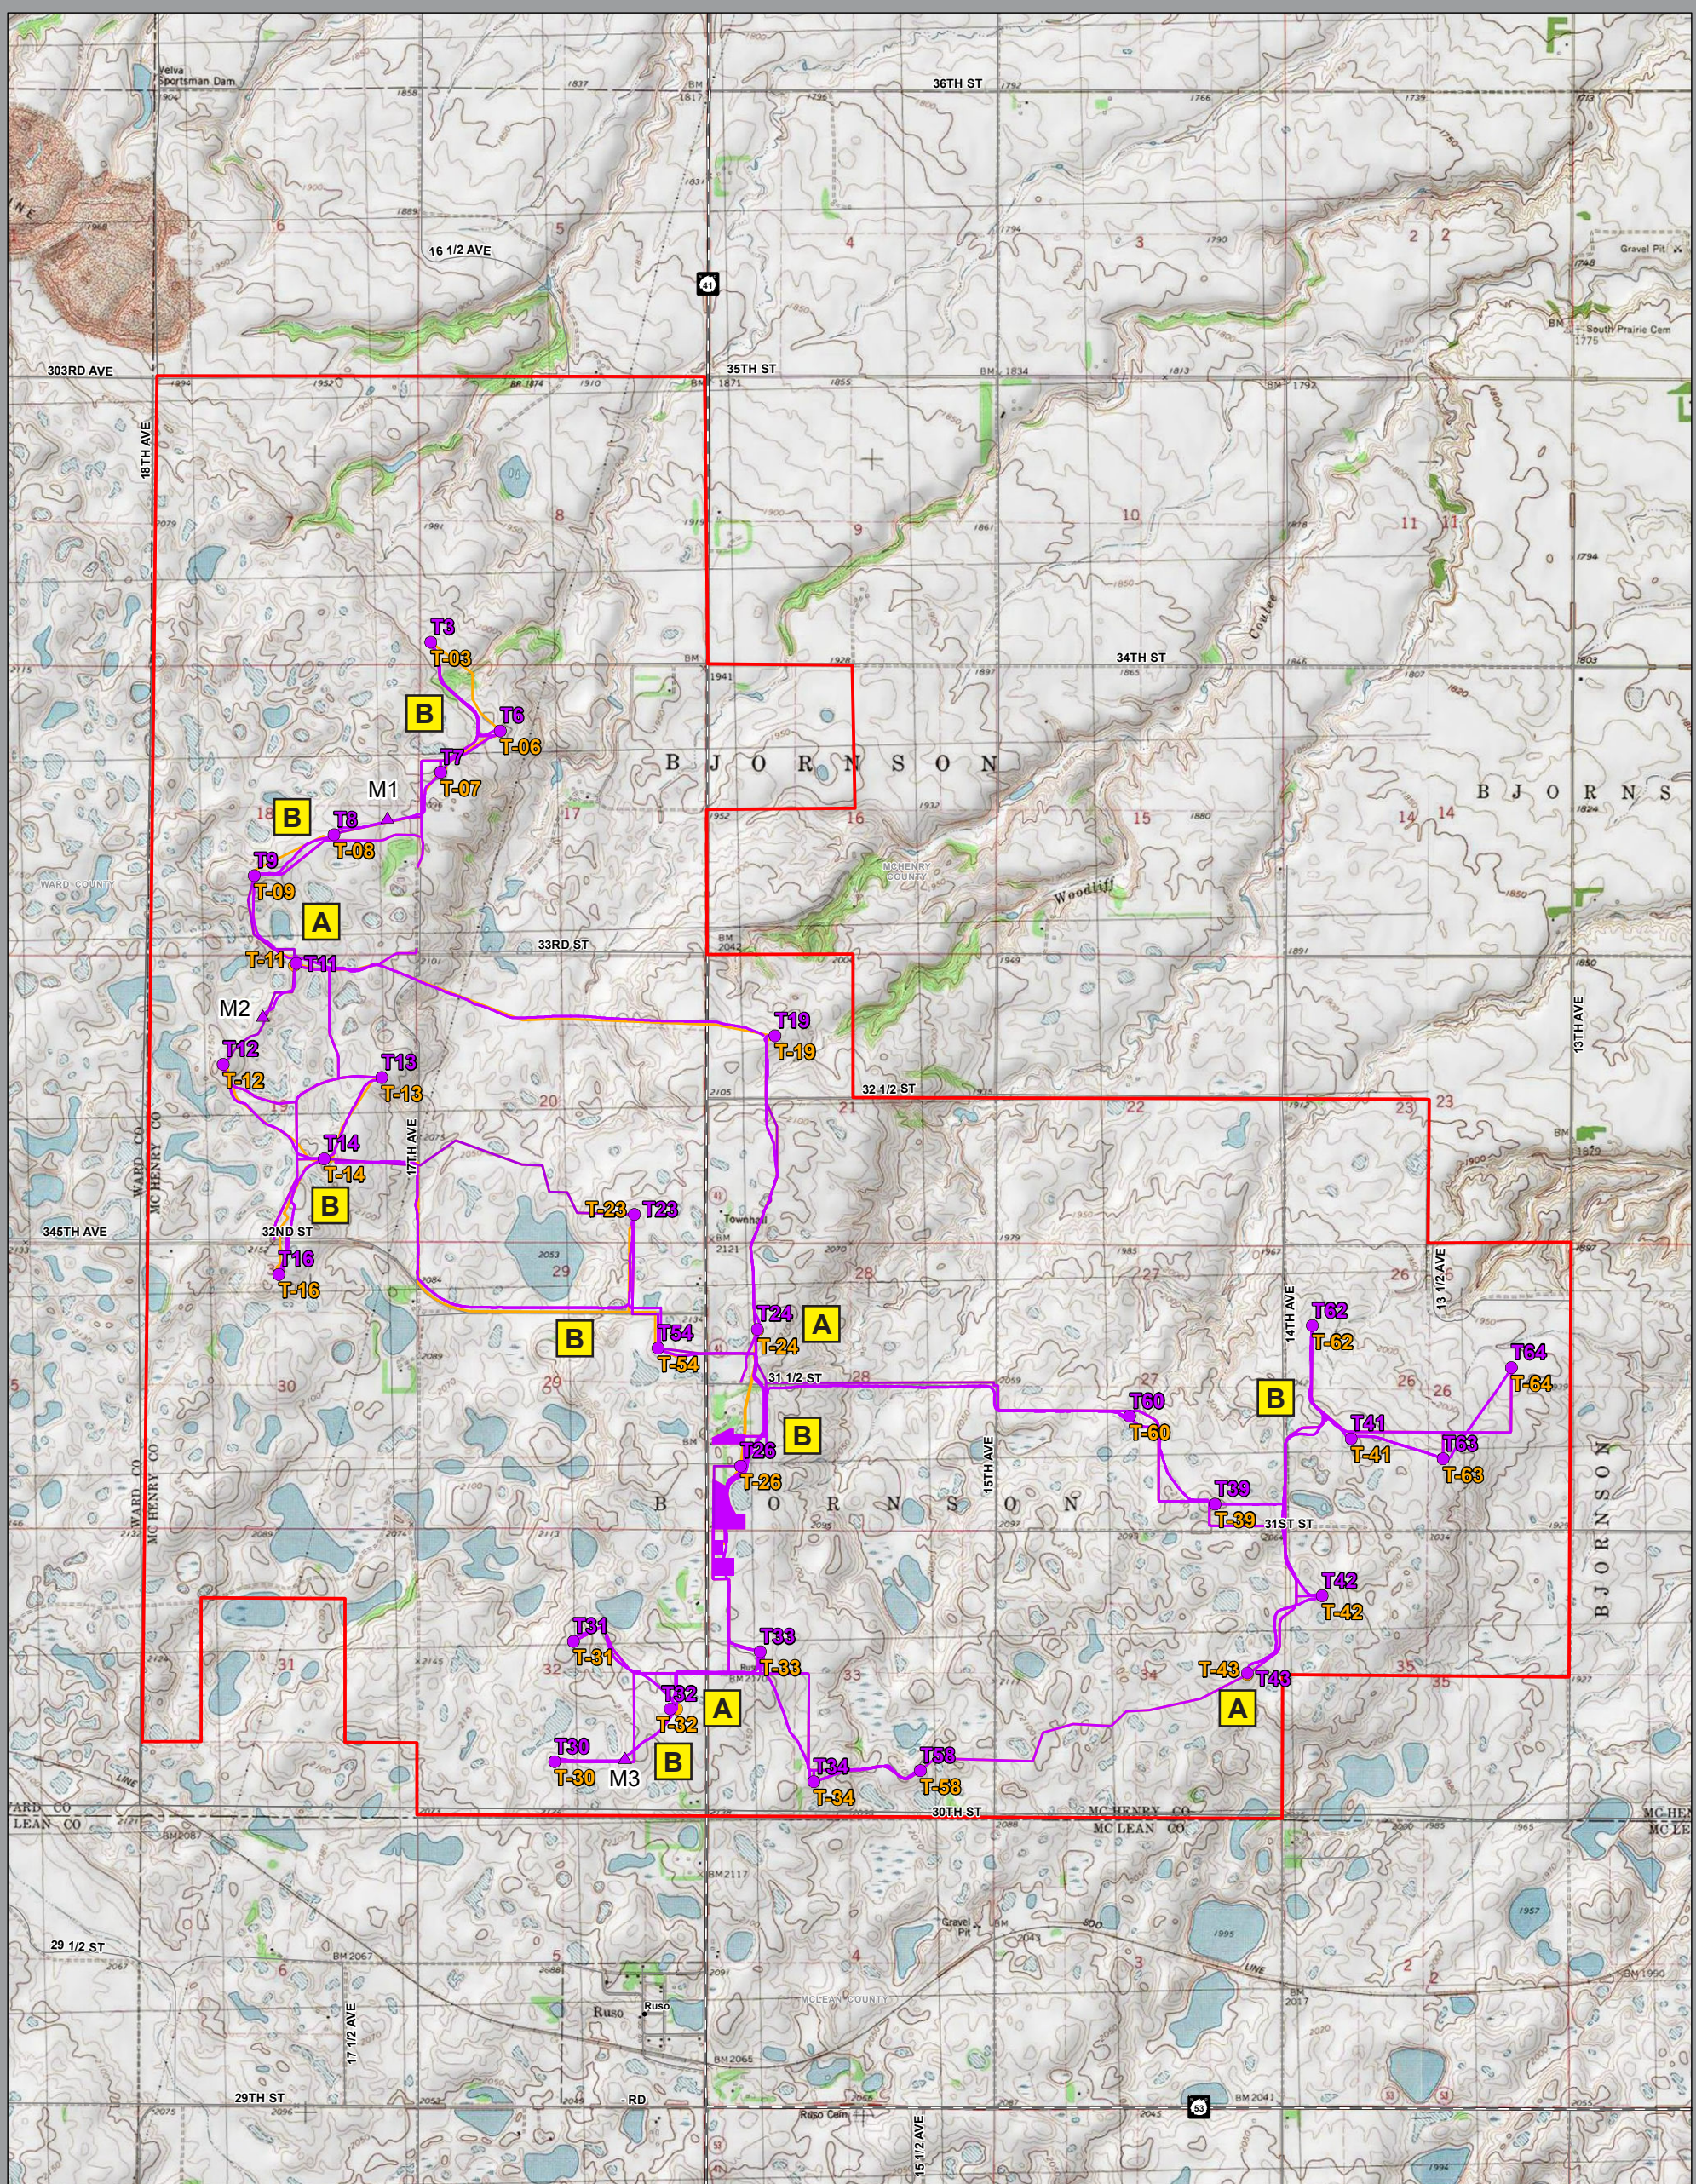


NEW FRONTIER WIND ENERGY PROJECT

29-Turbine Layout (August 2018) and Updated 29-Turbine Layout (October 2018)

- Project Area
- 29-Turbine Layout (August 2018)**
- Turbine
- ▲ Met Tower
- Access Road
- Collector Line
- Crane Walk/Path
- O & M Building
- Substation
- Laydown/Batch Plant
- 29-Turbine Layout (October 2018)**
- Turbine
- ▲ Met Tower
- Access Road
- Collector Line
- Crane Walk/Path
- O & M Building
- Substation
- Laydown/Batch Plant

Layout Modifications
 A – Minor turbine shifts
 B – Minor collection line shifts

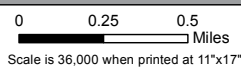

Vicinity Map

