


LEGEND

- 30 EA TURBINE
- ALTERNATES
- METS
- INTERSECTION RADIUS
- TURBINE APPROACH RADIUS
- PUBLIC ASPHALT ROAD
- PUBLIC CHIP SEAL ROAD
- PUBLIC DIRT ROAD
- PUBLIC GRAVEL ROAD
- TURBINE ACCESS ROAD
- PROPOSED COLLECTION
- OH E PROPOSED TRANSMISSION LINE
- OH E EXISTING TRANSMISSION LINE

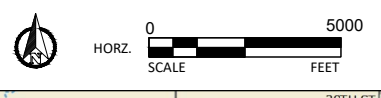

PROJECT BOUNDARY

SWITCHYARD SUBSTATION

THIS DRAWING IS THE PROPERTY OF BLATTNER ENERGY, INC. AND IS TRANSMITTED IN CONFIDENCE. THE REPRODUCTION, USE, OR DISCLOSURE IN WHOLE OR IN PART, OF THE DESIGN CONTAINED HEREIN IS PROHIBITED WITHOUT WRITTEN CONSENT OF BLATTNER ENERGY, INC.

CONFIDENTIAL
PRELIMINARY PRINT
FOR BIDDING ONLY - NOT FOR CONSTRUCTION

DATE: 12-06-2018		ESTIMATOR:
ENGINEER: ---		DRAFTED BY: KW
REV #	REVISION DESCRIPTION:	DATE:
0	20181010 NEW FRONTIER AS BUILT	12/05/2018
1	---	---
2	---	---



PROJECT:
**CAPITAL POWER
NEW FRONTIER WIND**
MCHENRY COUNTY, NORTH DAKOTA

SHEET TITLE:
SITE LAYOUT

SHEET NUMBER:
1

12/6/2018 10:55 AM

© 2018 Blattner Energy, Inc.