



RECEIVED

APR 27 2012

PUBLIC SERVICE COMMISSION

April 26, 2012

North Dakota Public Service Commission
600 East Boulevard Avenue
Dept. 408
Bismarck, ND 58505-0480
FedEx # 7983 3282 5442

Subject: Case No. PU-11-102 Pipeline As-Built Facility Design Specifications Map

Mr. Patrick Fahn,

Whiting Oil and Gas Corporation (Whiting) is submitting this Belfield Oil Pipeline as-built facility design specifications map per number 33 of the Certificate Relating to Order Provisions dated October 10, 2011 and signed by Rick Ross. This same map is being sent via email along with the electronic file referenced to the North Dakota coordinate system of 1983, UTM Zone 13.

Please contact me at (303) 390-1596 or at katie.walbek@whiting.com if you have any questions.

Sincerely,
Whiting Oil and Gas Corporation

Katie Walbek

Katie Walbek
Pipeline Compliance Technician


Enclosure

57 PU-11-102 Filed: 4/27/2012 Pages: 2
As-built facility design specifications map

Whiting Oil and Gas Corporation


Katie Walbek

*Whiting Petroleum Corporation
and its wholly owned subsidiary
Whiting Oil and Gas Corporation*

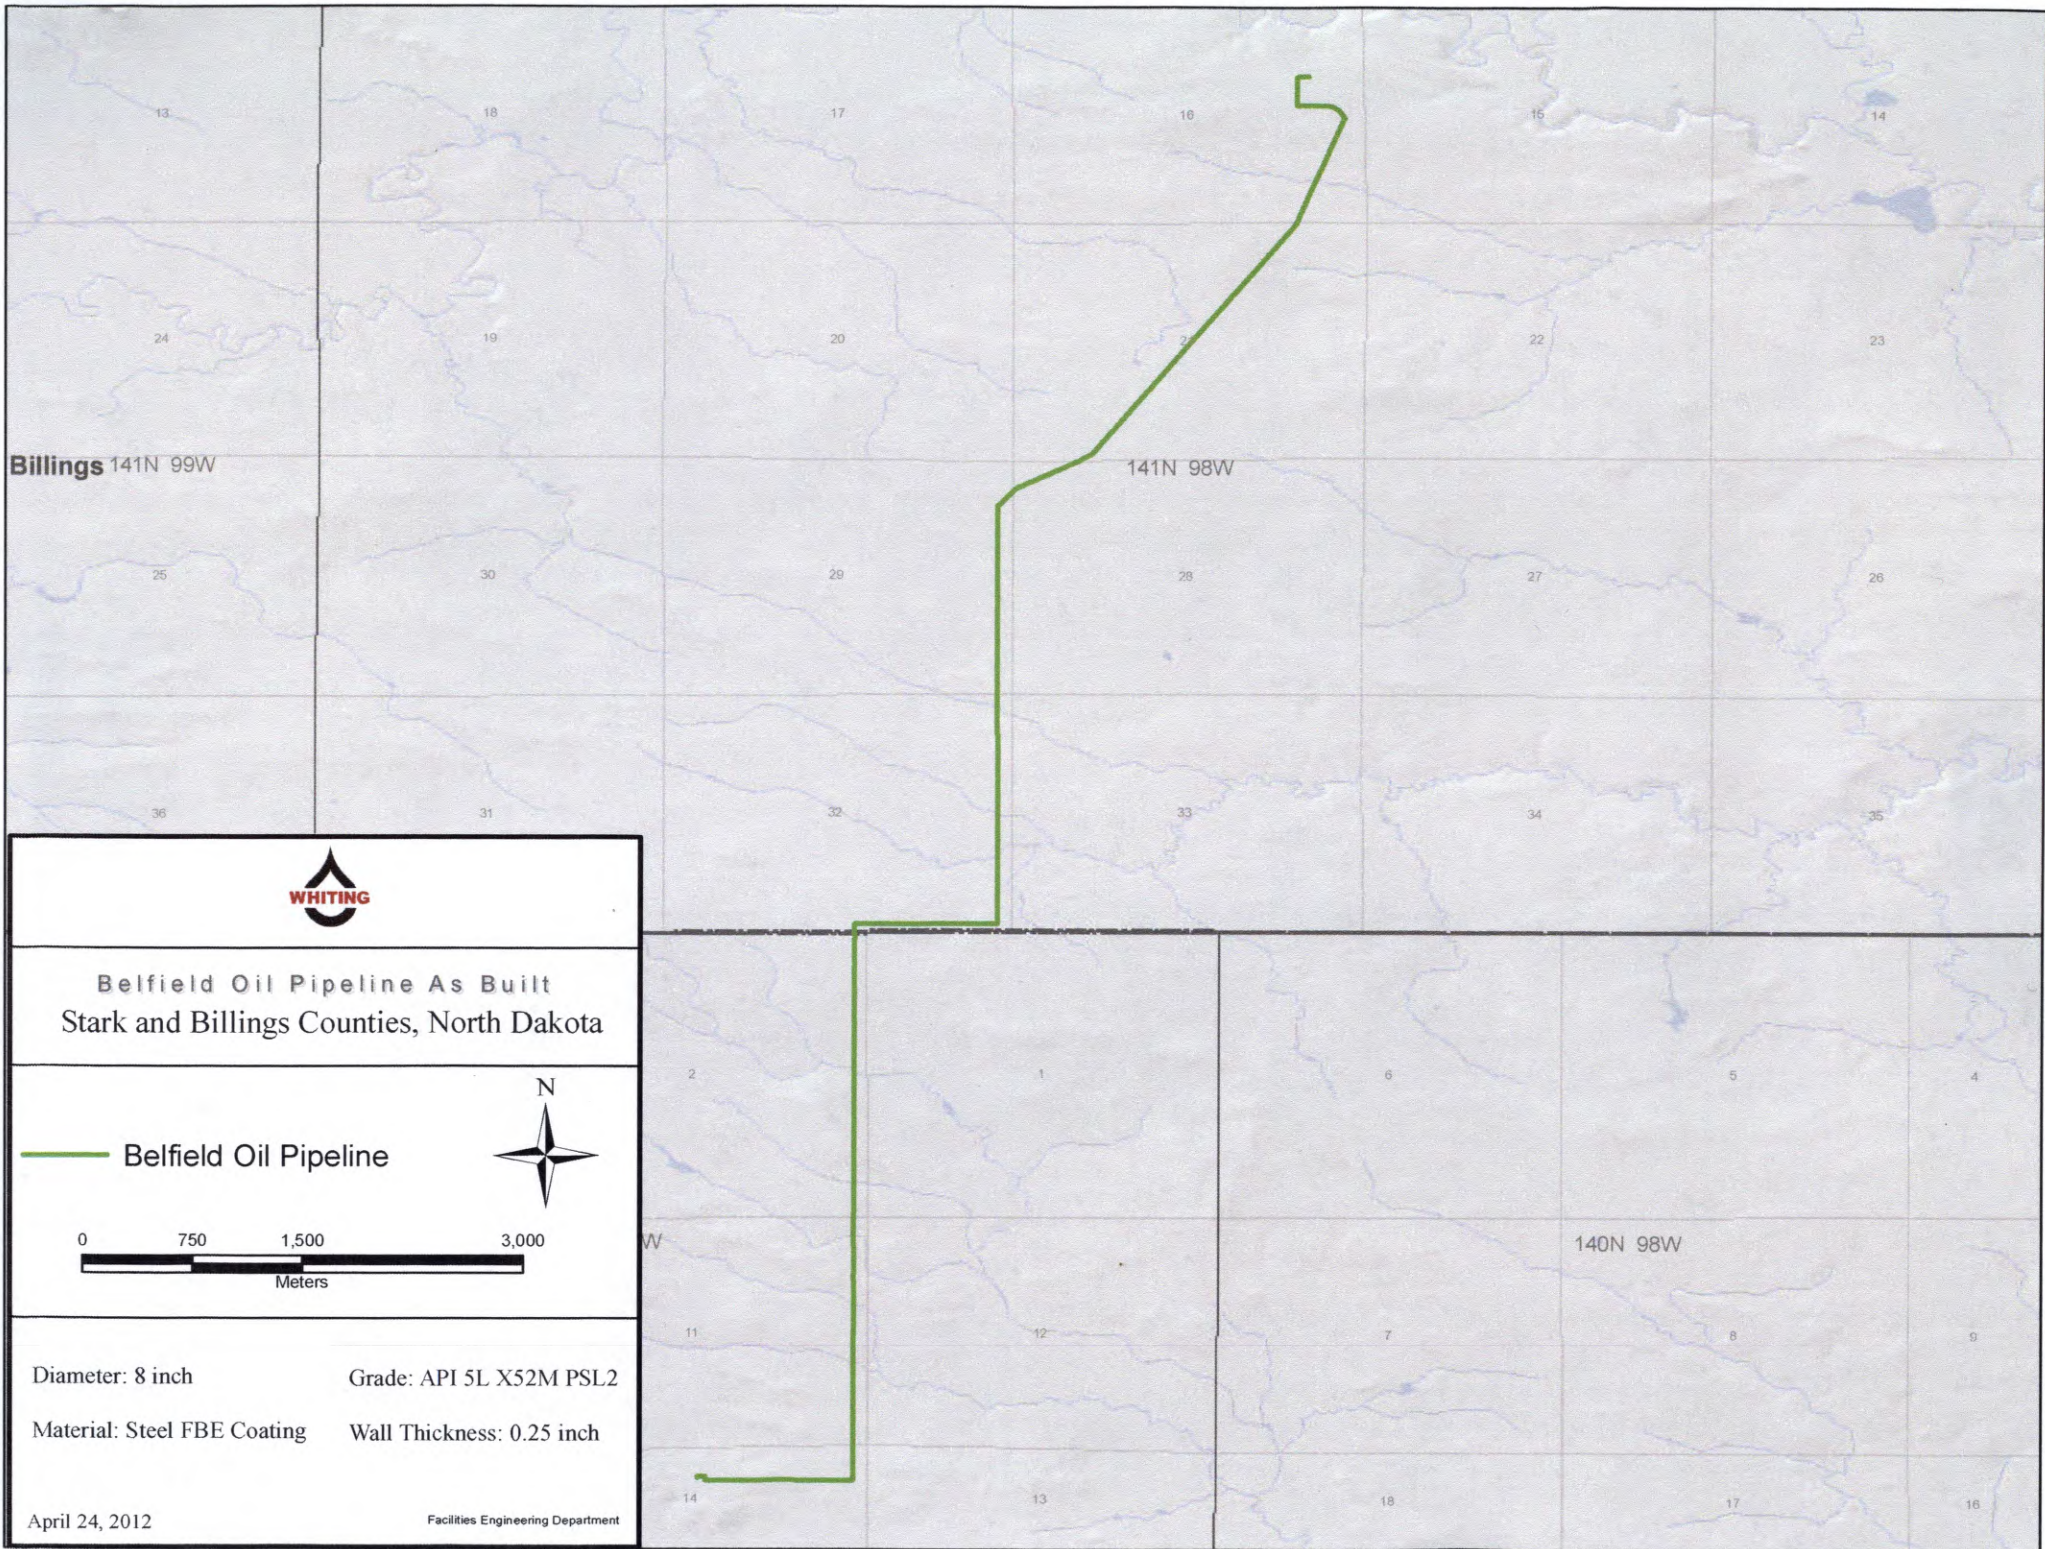

Belfield Oil Pipeline As Built
Stark and Billings Counties, North Dakota

— Belfield Oil Pipeline

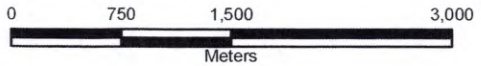

Diameter: 8 inch	Grade: API 5L X52M PSL2
Material: Steel FBE Coating	Wall Thickness: 0.25 inch