




1 PLAN: OVERALL LAYOUT
0 2000 4000
SCALE IN FEET



A	KKB	CAD	JXB	07/15/11	60 PERCENT SUBMITTAL
B	CAD	JXB	09/02/11	90 PERCENT SUBMITTAL	
C	CAD	JXB	09/30/11	ISSUED FOR CONSTRUCTION	
D	NJG		1/2/13	CONSTRUCTION REVISIONS	
NO.	BY	CHK.	APP.	DATE	REVISION DESCRIPTION

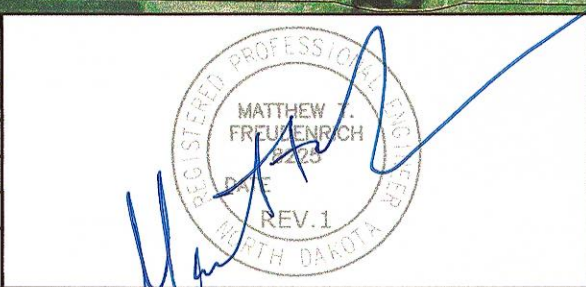

CLIENT	07/15/11	09/02/11							
BID									
CONSTRUCTION									
PERMITTING									
RECORD									
RELEASED TO/FOR	A	B	C	O	1	2	3		
	DATE RELEASED								

BARR
Corporate Headquarters:
Minneapolis, Minnesota
Ph: 1-800-632-2277

Project Office:
BARR ENGINEERING CO.
4700 WEST 77TH STREET
MINNEAPOLIS, MN.
55435-4803
Ph: 1-800-632-2277
Fax: (952) 832-2601
www.barr.com

Scale	AS SHOWN
Date	07/05/11
Drawn	KKB
Checked	JXB
Designed	CAD
Approved	JXB

minnesota power
AN ELLETE COMPANY

Bison
A WIND ENERGY INITIATIVE OF MINNESOTA POWER IN NORTH DAKOTA

BISON 3 WIND PROJECT
MORTON & OLIVER COUNTIES, NORTH DAKOTA

OVERALL SITE PLAN

BARR PROJECT No.	34/30-1006
CLIENT PROJECT No.	
DWG. No.	C-02
REV. No.	1