


- LEGEND**
- xxx TURBINE
 - ⊕ METEOROLOGICAL TOWER
 - SWITCH CABINET
 - GROUNDING XFRM
 - FIBER HANDHOLE
 - BUILDING SETBACK
 - WETLAND BOUNDARY
 - PHASE 1 & 2 COLLECTOR
 - PHASE 3 COLLECTOR
 - FIBER LINE

EXTERNAL REFERENCE:
 • 2010_NAIP.JPG

PIKE
 ENERGY SOLUTIONS
 PIKE ENERGY SOLUTIONS, LLC.
 10101 Claude Freeman Drive, Suite 100W
 Charlotte, NC 28262
 ND License No. 954PE

NO.	BY	CHK.	APP.	DATE	REVISION DESCRIPTION
A	CLD	CEG	CSF	7/8/11	60% DELIVERABLE
B	RJC	CEG	CSF	8/16/11	85% REVIEW DRAWINGS, NAME CHANGED TO E-GA30
C	CLD	CEG	CSF	9/20/11	90% REVIEW DRAWINGS, NEW ROAD LAYOUT
D	CLD	CEG	CSF	9/21/11	REVISED PER CLIENT COMMENTS
0	BNK	CSF	JLM	10/4/11	ISSUED FOR CONSTRUCTION
1	NJG	CSF	JLM	12/3/12	CONSTRUCTION REVISIONS

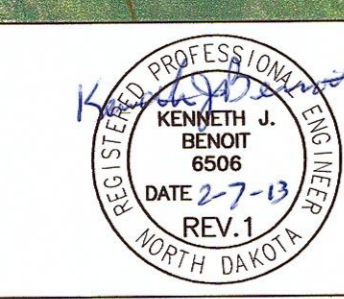

CLIENT	8/16/19/20/19/21/110/4/11						
BID							
CONSTRUCTION PERMITTING							
RELEASED TO/FOR	B	C	D	0	1	2	3
DATE RELEASED							

BARR
 Project Office:
 BARR ENGINEERING CO.
 4700 WEST 77TH STREET
 MINNEAPOLIS, MN.
 55435-4803
 Ph: 1-800-632-2277
 Fax: (952) 832-2601
 www.barr.com

Scale	1"=2000'-0"
Date	07/08/11
Drawn	CLD
Checked	CEG
Designed	CLD
Approved	JLM



BARR PROJECT No. 34/33-1006	
CLIENT PROJECT No.	
COLLECTOR SYSTEM GENERAL ARRANGEMENT	
DWG. No. E-GA30	REV. No. 1