




- LEGEND
- xxx TURBINE
 - METEOROLOGICAL TOWER
 - SWITCH CABINET
 - GROUNDING XFRMR
 - FIBER HANDHOLE
 - BUILDING SETBACK
 - WETLAND BOUNDARY
 - PHASE 1 & 2 COLLECTOR
 - PHASE 3 COLLECTOR
 - FIBER LINE

EXTERNAL REFERENCE:
• 2010_NAIP.JPG

PIKE
ENERGY SOLUTIONS
PIKE ENERGY SOLUTIONS, LLC.
10101 Claude Freeman Drive, Suite 100W
Charlotte, NC 28262
ND License No. 954PE

NO.	BY	CHK	APP	DATE	REVISION DESCRIPTION
A	CLD	CEG	CSF	7/8/11	60% DELIVERABLE
B	RJG	CEG	CSF	8/16/11	85% REVIEW DRAWINGS, NAME CHANGED TO E-GA36
C	CLD	CEG	CSF	9/20/11	90% REVIEW DRAWINGS, NEW ROAD LAYOUT
D	CLD	CEG	CSF	9/21/11	REVISED PER CLIENT COMMENT
E	BNK	CSF	JLM	10/4/11	ISSUED FOR CONSTRUCTION
1	NJG	CEG	CSF	12/11/12	CONSTRUCTION REVISIONS

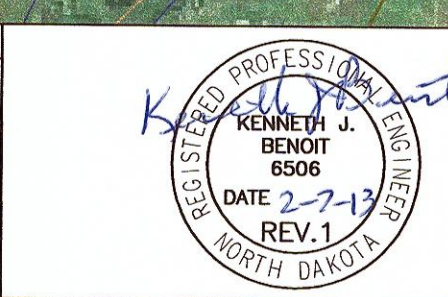

CLIENT	BARR ENGINEERING CO.
BID	8/16/11
CONSTRUCTION	9/20/11
PERMITTING	10/4/11
RELEASED TO/FOR	B C D O 1 2 3
DATE RELEASED	8/16/11 9/20/11 10/4/11

BARR
Project Office:
BARR ENGINEERING CO.
4700 WEST 77TH STREET
MINNEAPOLIS, MN.
55435-4803
Ph: 1-800-632-2277
Fax: (952) 832-2601
www.barr.com

Scale	1"=500'-0"
Date	07/08/11
Drawn	CLD
Checked	CEG
Designed	CLD
Approved	JLM

minnesota power
AN ALLETE COMPANY
Bison
A WIND ENERGY INITIATIVE OF MINNESOTA POWER IN NORTH DAKOTA

BISON 3 WIND PROJECT
MORTON & OLIVER COUNTIES, NORTH DAKOTA
COLLECTOR SYSTEM
GENERAL ARRANGEMENT DETAIL 6 of 6

BARR PROJECT No.	34/33-1006
CLIENT PROJECT No.	
DWG. No.	E-GA36
REV. No.	1