

Exam Date:09/01/2011

Northwood Bean Co., Inc.
 301 S Potato Rd
 Northwood , ND
 County:
 Phone: 701-587-5206
 CCC Number:

Page: 1

Examiner: 2

Location/Container Numbers/Comments	Section	Capacity
-------------------------------------	---------	----------

PART A - ADDITIONAL SPACE TO BE INCLUDED UNDER LICENSE

205	B	32,832
206	B	32,832
002	A	2,323
		Total: 67,987

PART B - SPACE TO BE DELETED UNDER LICENSE

302	C	38,914
303	C	32,291
		Total: 71,205

PART C - ALL SPACE TO BE INCLUDED UNDER LICENSE

A	57,000	
B	139,000	
E	44,000	
F	30,000	
J	63,000	
Z	30,000	
		Total: 363,000

PART D - TOTAL CAPACITY BY FUNCTIONAL UNIT

Northwood 1136	A B E F J Z	363,000
		Total: 363,000

Exam Date:09/01/2011

Northwood Bean Co., Inc.
301 S Potato Rd
Northwood , ND
County:

Page: 1

Examiner: 2

Status	Section	Bin Number	Bin Type	Base Point	Diameter or Bu/Ft (Irreg).		Side wall	Add for Hopper	Ded. for Obst.	Effective Depth	Add for Peak	Depth for Capac.	Bushels per Foot	Base Pack%	Bushel Capacity with Pack
					Length	Width									

Facility: Northwood

Section: A

	A	001	Peaked	top of sidewall at eave	12.000	0.000	0.000	12.00	2.00	0.00	14.000	0.700	14.7	90.9	5.00	1,403
Added	A	002	Peaked	top of sidewall at eave	14.000	0.000	0.000	15.00	2.00	0.00	17.000	0.800	17.8	123.7	5.50	2,323
	A	003	Flat	bag storage	0.000	48.00	70.00	2.000	0.00	0.00	2.000	0.000	2.0	2701.0	10.0	5,942
	A	102	Peaked	top of sidewall at eave	36.000	0.000	0.000	22.00	0.00	0.00	22.000	2.200	24.2	818.2	10.0	21,780
	A	103	Peaked	top of sidewall at eave	36.000	0.000	0.000	25.70	0.00	0.00	25.700	2.200	27.9	818.2	10.0	25,111
Bin count: 5					Facility: Northwood Section: A Total:											56,559
															To Even:	57,000

Section: B

	B	201 chstr	Flat	bag storage only	0.000	65.00	60.00	4.000	0.00	0.00	4.000	0.000	4.0	3135.0	10.0	13,794
	B	204	Quonset	8' on side - 22.5' ceiling	0.000	124.0	61.00	9.000	0.00	0.00	9.000	0.000	9.0	5990.9	10.0	59,310
Added	B	205	Peaked	top of sidewall	42.000	0.000	0.000	24.30	0.00	0.00	24.300	2.500	26.8	1113.7	10.0	32,832
Added	B	206	Peaked	top of sidewall	42.000	0.000	0.000	24.30	0.00	0.00	24.300	2.500	26.8	1113.7	10.0	32,832
Bin count: 4					Facility: Northwood Section: B Total:											138,768
															To Even:	139,000

Section: E

	E	001	Flat	Sherva North flat	0.000	53.50	97.50	9.500	0.00	0.00	9.500	0.000	9.5	4193.1	10.0	43,817
--	---	-----	------	-------------------	-------	-------	-------	-------	------	------	-------	-------	-----	--------	------	--------

NDPSC Bin Capacity Chart

Exam Date:09/01/2011

Northwood Bean Co., Inc.
301 S Potato Rd
Northwood , ND
County:

Examiner: 2

Status	Section	Bin Number	Bin Type	Base Point	Diameter or Bu/Ft (Irreg.) Length	Width	Side wall	Add for Hopper	Ded. for Obst.	Effective Depth	Add for Peak	Depth for Capac.	Bushels per Foot	Base Pack%	Bushel Capacity with Pack	
Bin count:		1													Facility: Northwood Section: E Total:	43,817
														To Even:	44,000	

Section: F

F	001	Flat	korsmo potato flat	0.000	69.50	19.00	8.500	0.00	0.00	8.500	0.000	8.5	1061.5	10.0	9,925	
F	002	Flat	korsmo potato flat	0.000	69.50	19.00	8.500	0.00	0.00	8.500	0.000	8.5	1061.5	10.0	9,925	
F	003	Flat	korsmo potato flat	0.000	69.50	19.00	8.500	0.00	0.00	8.500	0.000	8.5	1061.5	10.0	9,925	
Bin count:		3													Facility: Northwood Section: F Total:	29,775
														To Even:	30,000	

Section: J

J	001	Flat	Johnson potato wrhse	0.000	56.00	15.00	8.500	0.00	0.00	8.500	0.000	8.5	675.2	9.50	6,284	
J	002	Flat	Johnson potato wrhse	0.000	56.00	15.00	8.500	0.00	0.00	8.500	0.000	8.5	675.2	9.50	6,284	
J	003	Flat	Johnson potato wrhse	0.000	56.00	15.00	8.500	0.00	0.00	8.500	0.000	8.5	675.2	9.50	6,284	
J	004	Flat	Johnson potato wrhse	0.000	56.00	15.00	8.500	0.00	0.00	8.500	0.000	8.5	675.2	9.50	6,284	
J	005	Flat	Johnson potato wrhse	0.000	56.00	15.00	8.500	0.00	0.00	8.500	0.000	8.5	675.2	9.50	6,284	
J	006	Flat	Johnson potato wrhse	0.000	56.00	15.00	8.500	0.00	0.00	8.500	0.000	8.5	675.2	9.50	6,284	
J	007	Flat	Johnson potato wrhse	0.000	56.00	15.00	8.500	0.00	0.00	8.500	0.000	8.5	675.2	9.50	6,284	
J	008	Flat	Johnson potato wrhse	0.000	56.00	15.00	8.500	0.00	0.00	8.500	0.000	8.5	675.2	9.50	6,284	
J	009	Flat	Johnson potato wrhse	0.000	56.00	15.00	8.500	0.00	0.00	8.500	0.000	8.5	675.2	9.50	6,284	
J	010	Flat	Johnson potato wrhse	0.000	56.00	15.00	8.500	0.00	0.00	8.500	0.000	8.5	675.2	9.50	6,284	
Bin count:		10													Facility: Northwood Section: J Total:	62,840
														To Even:	63,000	

Client ID: 2993	NDPSC Bin Capacity Chart	09/01/2011 09:55:48 AM
Exam Date:09/01/2011 Examiner: 2	Northwood Bean Co., Inc. 301 S Potato Rd Northwood , ND County:	Page: 3

Status	Section	Bin Number	Bin Type	Base Point	Diameter or Bu/Ft (Irreg.)	Length	Width	Side wall	Add for Hopper	Ded. for Obst.	Effective Depth	Add for Peak	Depth for Capac.	Bushels per Foot	Base Pack%	Bushel Capacity with Pack
--------	---------	------------	----------	------------	-------------------------------	--------	-------	--------------	----------------------	----------------------	--------------------	--------------------	------------------------	------------------------	---------------	------------------------------


Facility: Northwood

Section: Z

Z	temporary		Flat	Johnson potato house	0.000	69.50	56.75	8.500	0.00	0.00	8.500	0.000	8.5	3170.5	10.0	29,644
Bin count:		1													Facility: Northwood Section: Z Total:	29,644
															To Even:	30,000

<u>Overall Licensed Bin Capacity for:</u>	Licensed Capacity:	361,403 Bu.
Northwood Bean Co., Inc.	(includes pack)	
Bin count: 24	Licensed Capacity (to even):	363,000 Bu.
	(includes pack and section totals are rounded up to next highest 1000)	

NORTHWOOD BEAN
Northwood N.D.
PLANT LAY-OUT

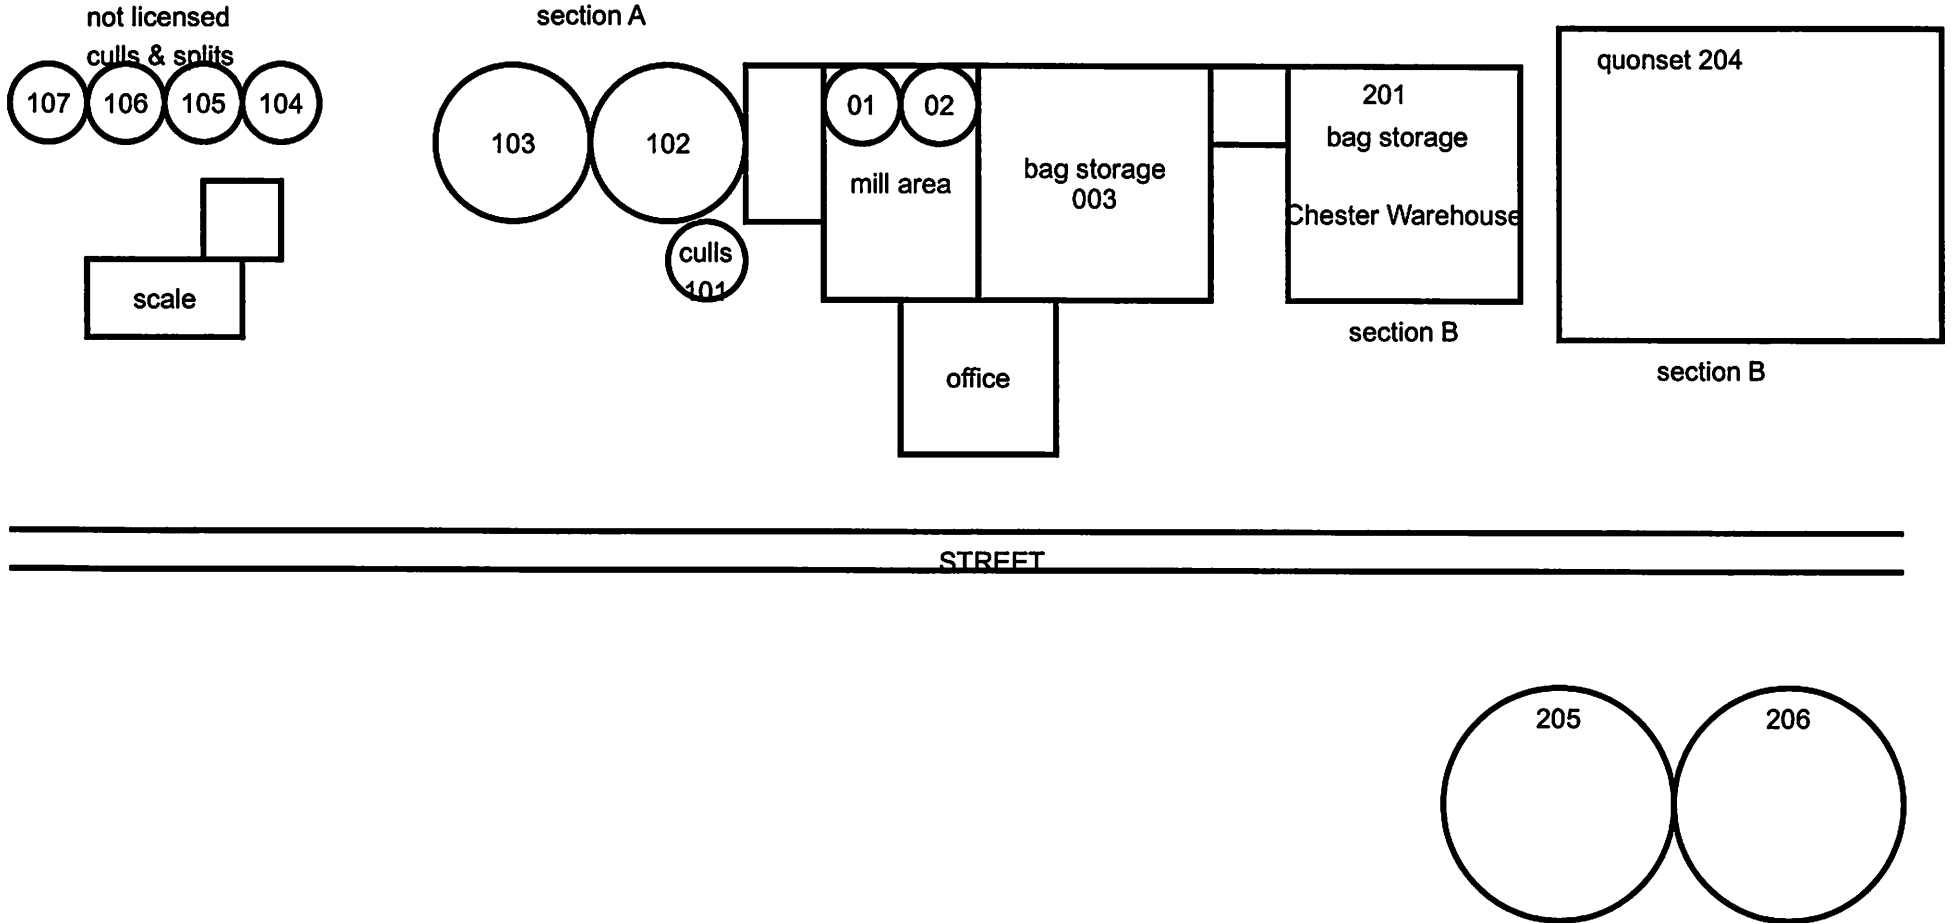


Section C NE quonsets- DELETED 09/2011

Section E Sherva North flat #001

Section J potato house 10 bins

NORTHWOOD BEAN
Northwood N.D.
PLANT LAY-OUT

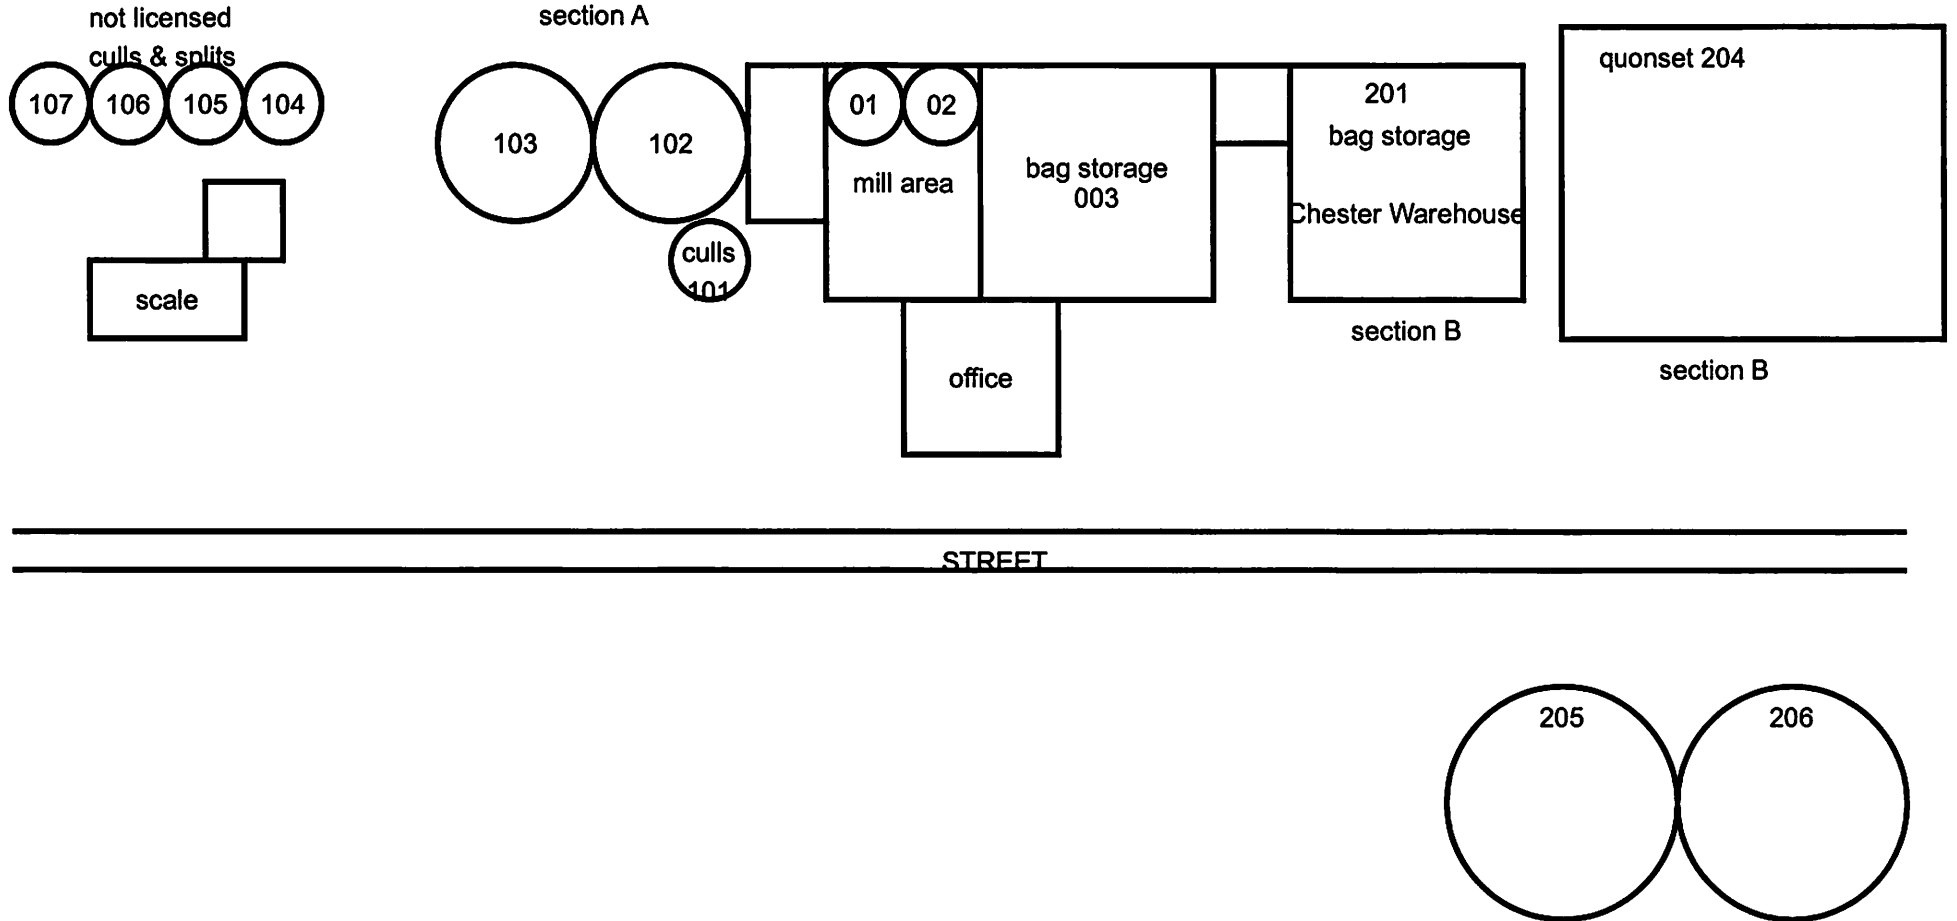

Section C NE quonsets- DELETED 09/2011
Section E Sherva North flat #001
SEction F Korsmo potato house 3 bins
Section J potato house 10 bins