

507 South Main  
Dickinson, ND 58601  
701-483-4000  
Fax 701-483-0001  
1-888-225-5282  
www.ctctel.com



**RECEIVED**

JUN 17 2011

**PUBLIC SERVICE COMMISSION**

June 15, 2011

North Dakota Public Service Commission  
Attn: Executive Secretary  
Capitol Building – 12<sup>th</sup> Floor  
600 East Boulevard, Dept. 408  
Bismarck, ND 58505-0480

*Consolidated  
Telcom*

Re: Request for Authority to Provide Service  
and Change in Exchange Boundary

*Consolidated  
Enterprises, Inc.*

Consolidated Telcom is hereby requesting Authority to Provide Service and for a change in Exchange Boundaries as set forth in the attached maps. Chad and Shelly Hoherz have requested service from Consolidated Telcom at the location identified in the maps and West Reiver Telecom has agreed to release this area to Consolidated. Attached is a letter from West River Telecom agreeing to the boundary change to make this possible.

*Consolidated  
Communications  
Corporation*

At this time Consolidated is ready to proceed with constructing facilities and providing service to the Hoherz's. Please advise when the PSC authorizes the changes requested. In the event that you require additional documentation or information please contact the undersigned. Thank you for your assistance in this regard.

*Consolidated  
Cable Vision, Inc.*

Sincerely,

Bryan W. Personne  
Chief Operating Officer  
Consolidated Telcom

*Consolidated  
Communications  
Networks, Inc.*

Writers Direct No.s  
Telephone 701-483-7328  
Facsimile 701-483-7346

81ST AVE SW

21 Hwy

80TH AVE SW

73RD ST SW

74TH ST SW

81ST AVE SW

AVE SW

33

34

35

Mott

3

2

1

9

10

16

15

T 134 R 091

New Subscriber

Existing Border


This would be the new Consolidated Telcom Boundary for the Mott Exchange to include the North half of 133-91-1

Exchange Boundary

Consolidated Telcom

West River Telephone



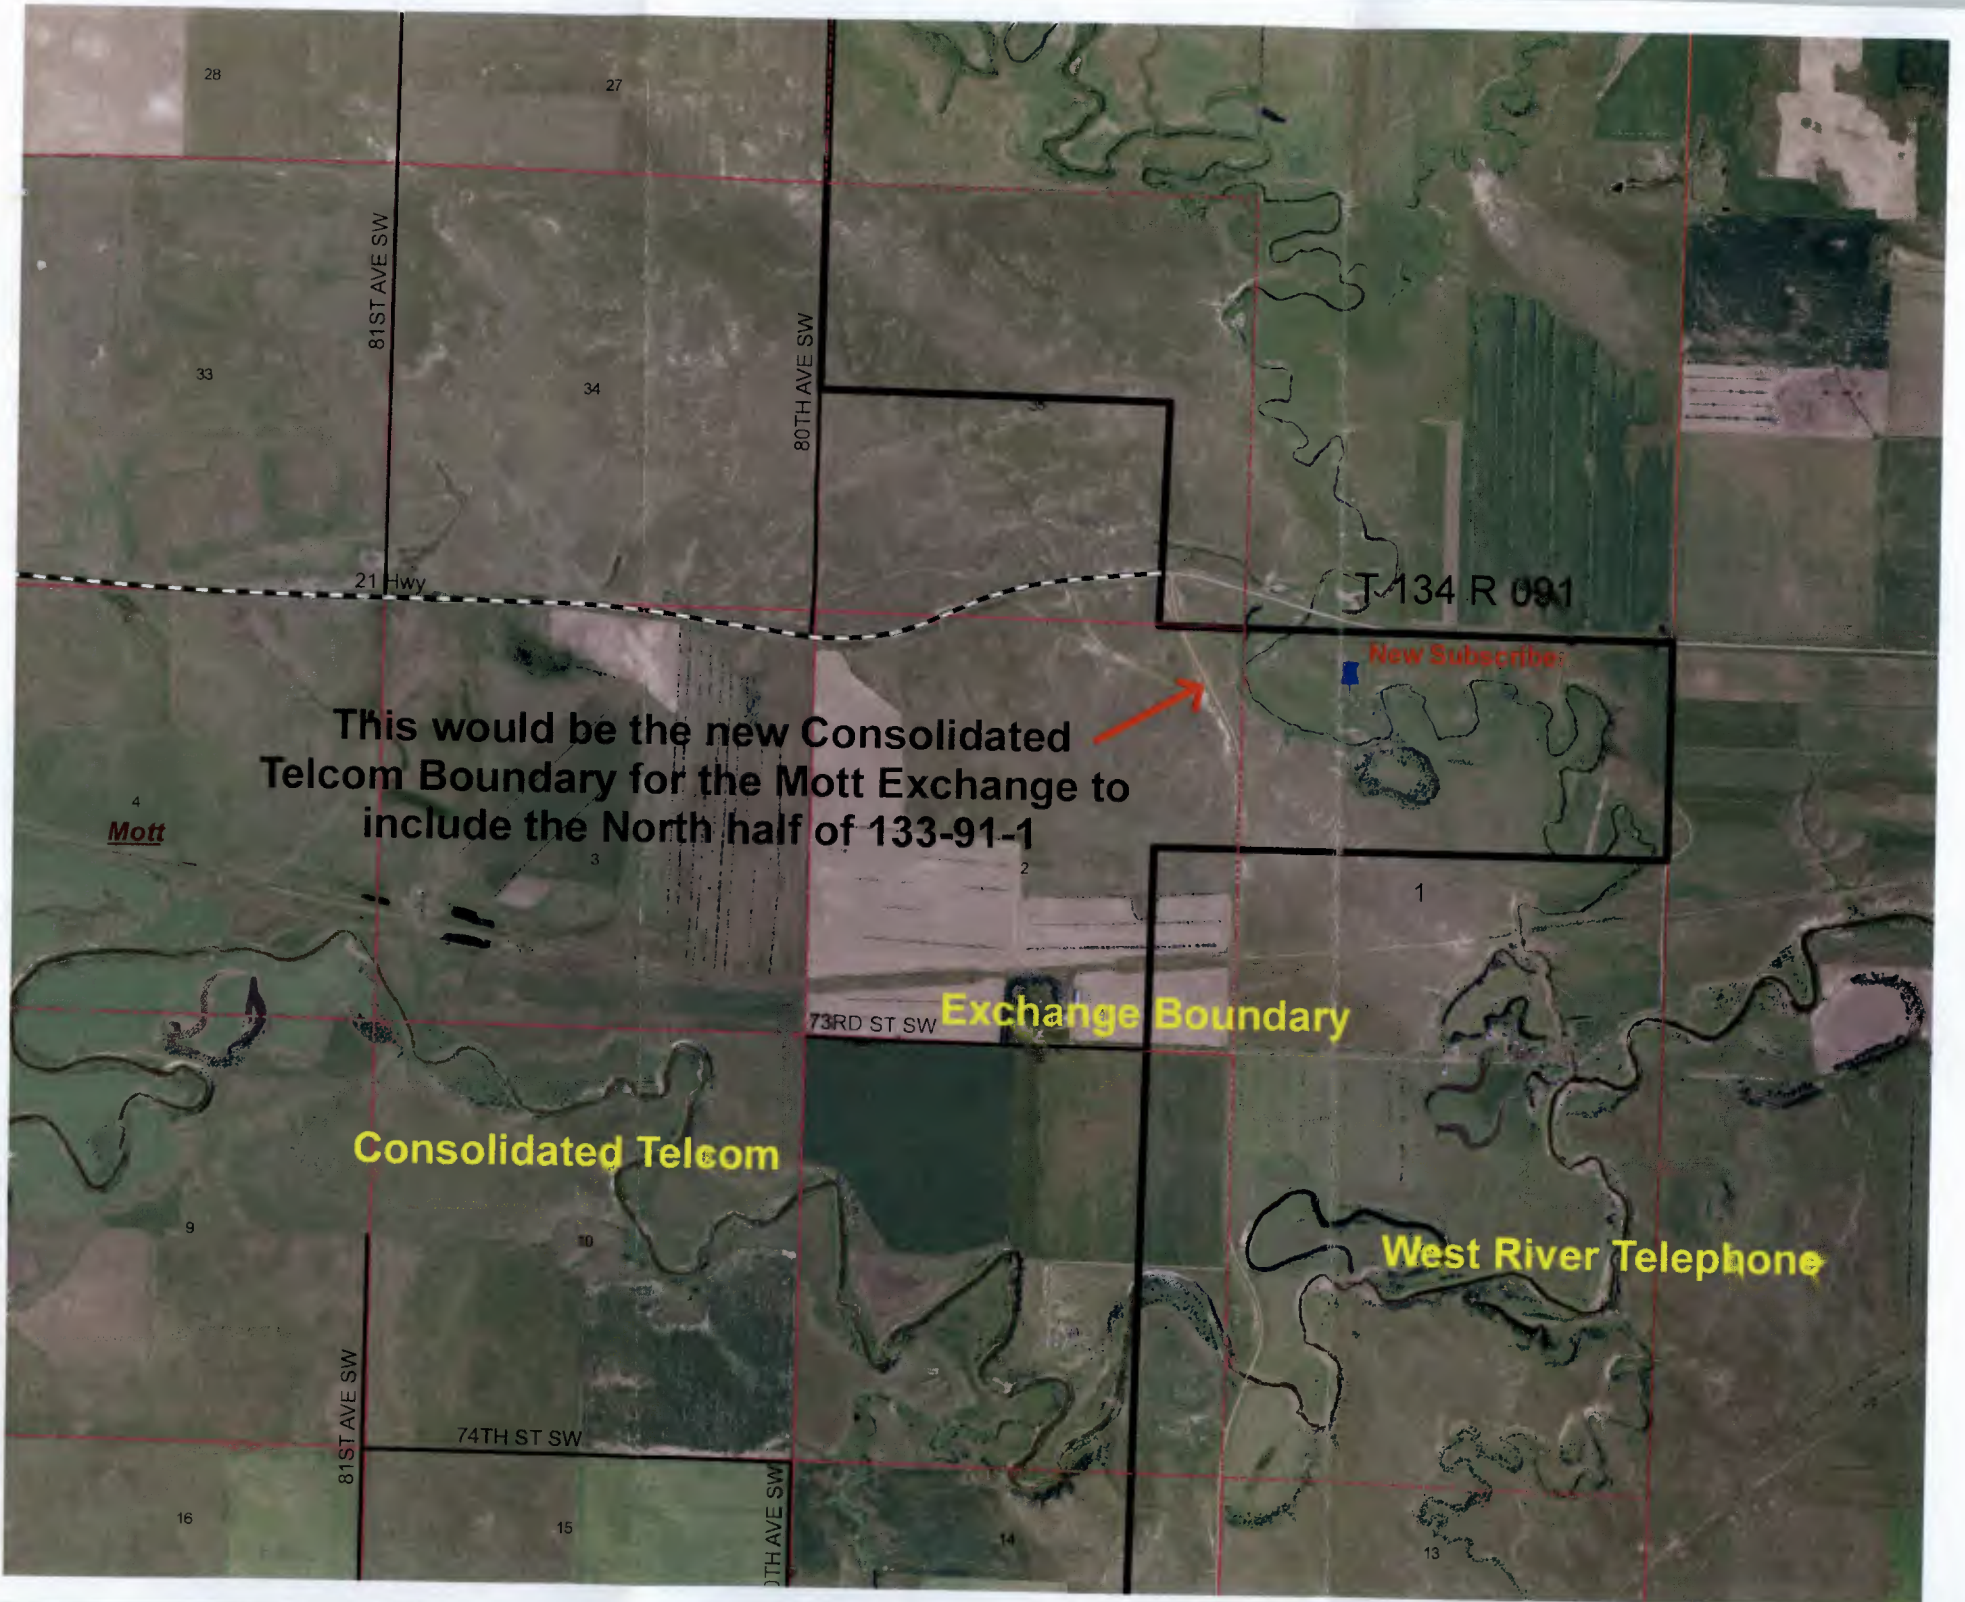

This would be the new Consolidated Telcom Boundary for the Mott Exchange to include the North half of 133-91-1

Mott

New Subscriber

T 134 R 091

Exchange Boundary

Consolidated Telcom

West River Telephone

81ST AVE SW

80TH AVE SW

73RD ST SW

74TH ST SW

81ST AVE SW

80TH AVE SW

28

27

33

34

21 Hwy

4

3

2

1

9

10

16

15

14

13



**West River Telecom**

---

April 13, 2011

Chad and Shelly Hoherz  
PO Box 267  
Bentley, ND 58562

Dear Chad and Shelly:

The Board of Directors considered your request to release the part of the WRT service area on which you plan to live to CTC of Dickinson. The Board agreed to this release with the stipulation that all costs associated with the redefining of the respective service area boundaries be the responsibilities of either you or CTC.

If you wish to continue with your proposed plans please contact CTC and they can contact WRT to get the details worked out.

Sincerely,

A handwritten signature in black ink, appearing to read 'Albert Grosz', written in a cursive style.

Albert "Mick" Grosz, CEO

lmb