


Figure 2  
 Project Area  
 (Aerial)  
 Optimized Layout  
 Thunder Spirit Wind Energy Project  
 Thunder Spirit Wind, LLC  
 Adams County, North Dakota  
 June 2014

- Met Tower Location
- Approximate POI
- Optimized Turbine Location (5/27/2014)
- Proposed Collector Substation (5/27/2014)
- Overhead Line (5/27/2014)
- Collection Line (5/27/2014)
- Access Road (5/27/2014)
- Construction Laydown Area (10 Acres)
- Collection Substation, O&M Facility, and Additional Laydown Area
- Project Area (4/26)
- Township Boundary

N

0    0.5    1    1.5    2

Miles

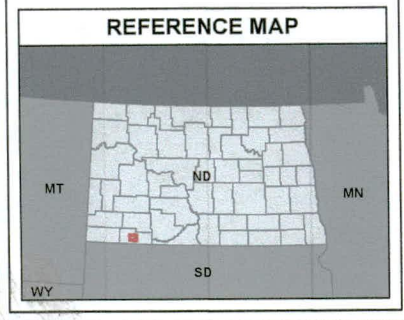

Path: P:\Global Winds Harvest\Thunder Spirit - ND\GIS\Spatial\MXD\20140630\_PSC\_Figures\20140630\_PSCMap\_Fig2\_ProjectArea\_Aerial.mxd

\* Location of our home & property  
 Lot 1 Sec 19 T130 R95 (~38 acres)  
 (80 acres) E 1/2 of NW 1/4 of Sec 19 T130 R95