Divide
Burke
Sheridan (Montana)
NORTH DAKOTA
Williams
LITTLE MUDDY STATION
EAST FORK STATION
Roosevelt (Montana)
Mountrail
Williston
McKenzie

0 2.5 5 10 15
Miles

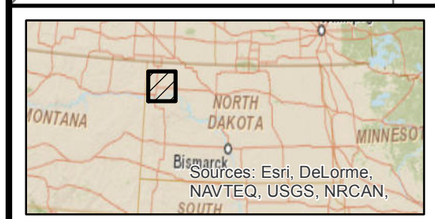

Existing Pipelines
Little Muddy Pipeline - Asbuilt

DRAWN	CHECKED	APPROVED	DATE	REV NO.	DESCRIPTION
MW	MJ	MJ	11/30/12	0	ISSUED FOR ASBUILT

PREPARED BY:
ROONEY ENGINEERING, INC.
CENTENNIAL, COLORADO
303-792-5911

ENBRIDGE PIPELINES (NORTH DAKOTA) LLC

LITTLE MUDDY STATION AND PIPELINE PROJECT
WILLIAMS COUNTY OVERVIEW
SEC 17,20,21,22,26,27,35,36 T156N, R100W

DRAWN: MWW	CHECKED: MJ
DATE: 11/30/12	SCALE: AS SHOWN

D-88-5.92-5008-0-24