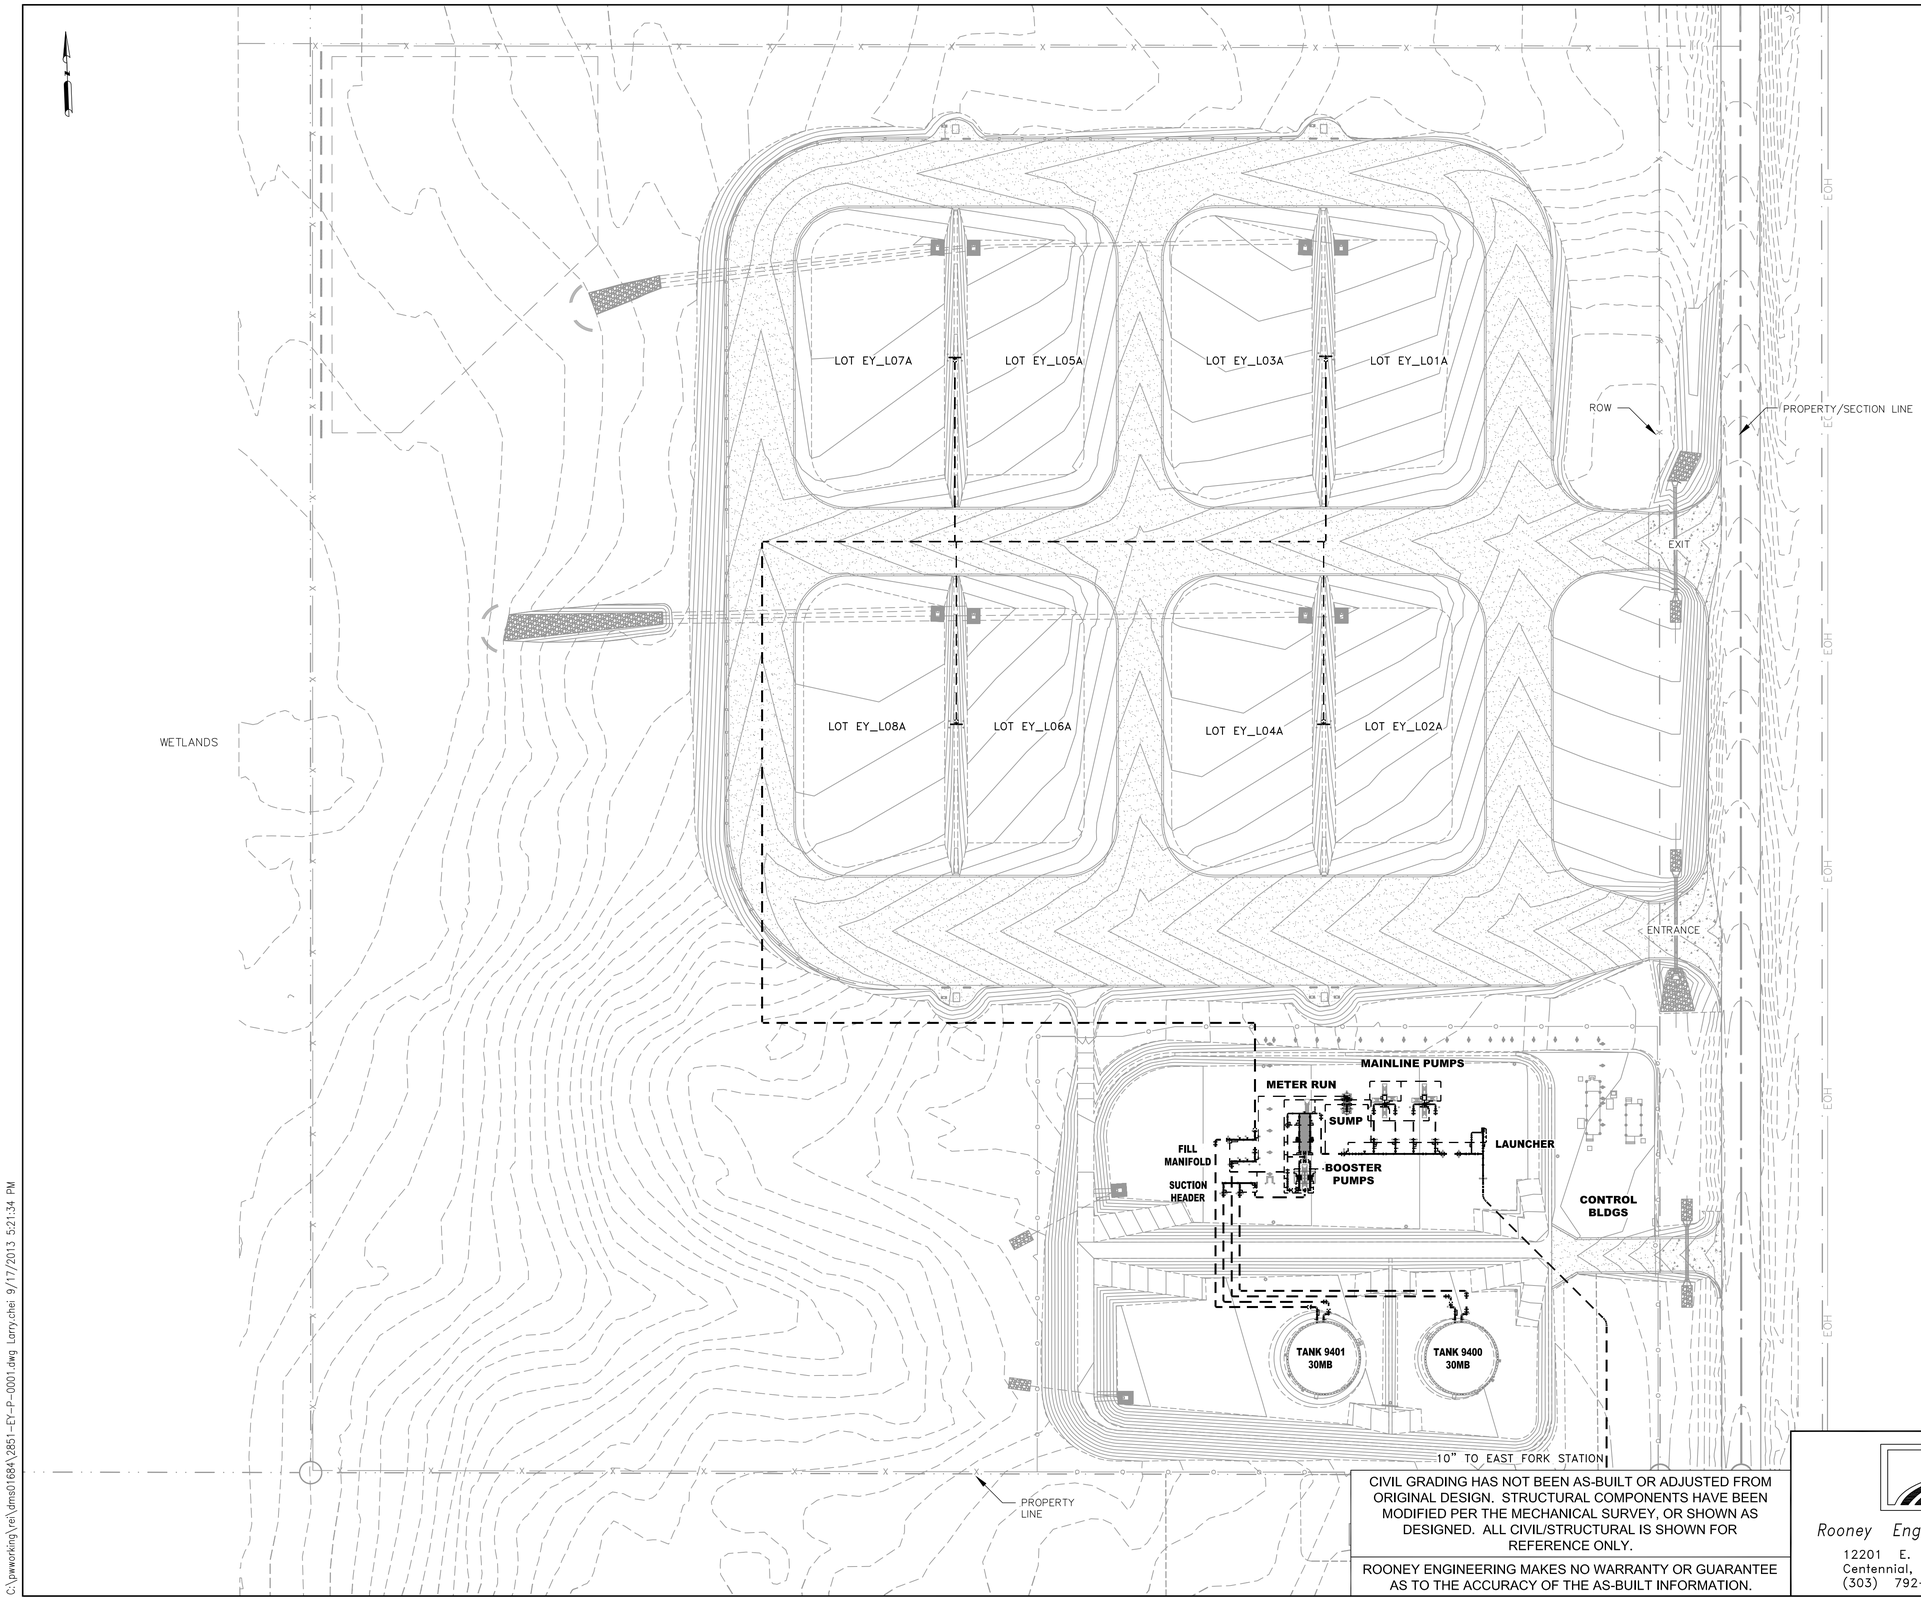

70' 0' 70' 140'

SCALE 1" = 70'
(SEE NOTE 1)

NOTES:
1. LISTED SCALE IS FOR 22"x34" ("D" SIZE) DRAWINGS.

NO	REVISION	DATE	APPR	BY
7	AS-BUILT	09/18/13	JL	LC
6	REVISED LOT NUMBERS	09/21/12	JL	LC
5	REVISED DRAINLINES	08/31/12	GR	LC
4	REVISED MAINLINE PUMPS	07/27/12	JH	LC

ENBRIDGE® PIPELINES (NORTH DAKOTA) LLC

LITTLE MUDDY (ND) STATION

LITTLE MUDDY PROJECT
OVERALL PLOT PLAN

CIVIL GRADING HAS NOT BEEN AS-BUILT OR ADJUSTED FROM ORIGINAL DESIGN. STRUCTURAL COMPONENTS HAVE BEEN MODIFIED PER THE MECHANICAL SURVEY, OR SHOWN AS DESIGNED. ALL CIVIL/STRUCTURAL IS SHOWN FOR REFERENCE ONLY.

ROONEY ENGINEERING MAKES NO WARRANTY OR GUARANTEE AS TO THE ACCURACY OF THE AS-BUILT INFORMATION.

Rooney Engineering, Inc.
12201 E. Arapahoe Rd.
Centennial, CO 80112
(303) 792-5911

PROJECT: 02851 – LITTLE MUDDY PROJECT EXECUTION

SCALE: AS NOTED	DATE: 01/13/12	DRAWN: LC
CHECK: JH	APPR: GR	DATE: 09/18/13

DWG. NO. 2851-EY-P-0001 REV 7

C:\pwworking\rei\dms01684\2851-EY-P-0001.dwg Larry.chei 9/17/2013 5:21:34 PM