

Andrea Sampson

From: Haupt, Michael L. [mhaupt@nd.gov]
Sent: Friday, October 14, 2011 4:37 PM
To: Andrea Sampson
Cc: William McCarthy
Subject: RE: ONEOK Rockies Midstream - Stateline NGL Pipeline Project Review Request
Attachments: 154-104-36WIL.pdf

Andrea,

Good afternoon! It appears that the ND School trust has one tract lying within the proposed Oneok pipeline corridor, that would be in 36-154-104 Williams County. As shown on the attached aerial photo, existing and potential oil well sites are located along the south end of section 36. Based on topography and soils it appears we could consider a pipeline corridor along the north section line. This is only a preliminary review. Let me know if you have questions. Thanks.


Michael L. Haupt

Land Management Professional, CPRM
North Dakota Department of Trust lands
PO Box 5523, Bismarck ND 58506-5523
701-328-1916
mhaupt@nd.gov

Note: You can track the real time status of your right-of-way application 24/7 at <http://www.land.nd.gov/surface/row/> using either the ROW number or by entering at least the first three letters of the company name. By checking this site you can find the name, telephone number and email address of the person working on the application as well as its current status in real time.

36-T154-R104

Williams County
Township: Round Prairie

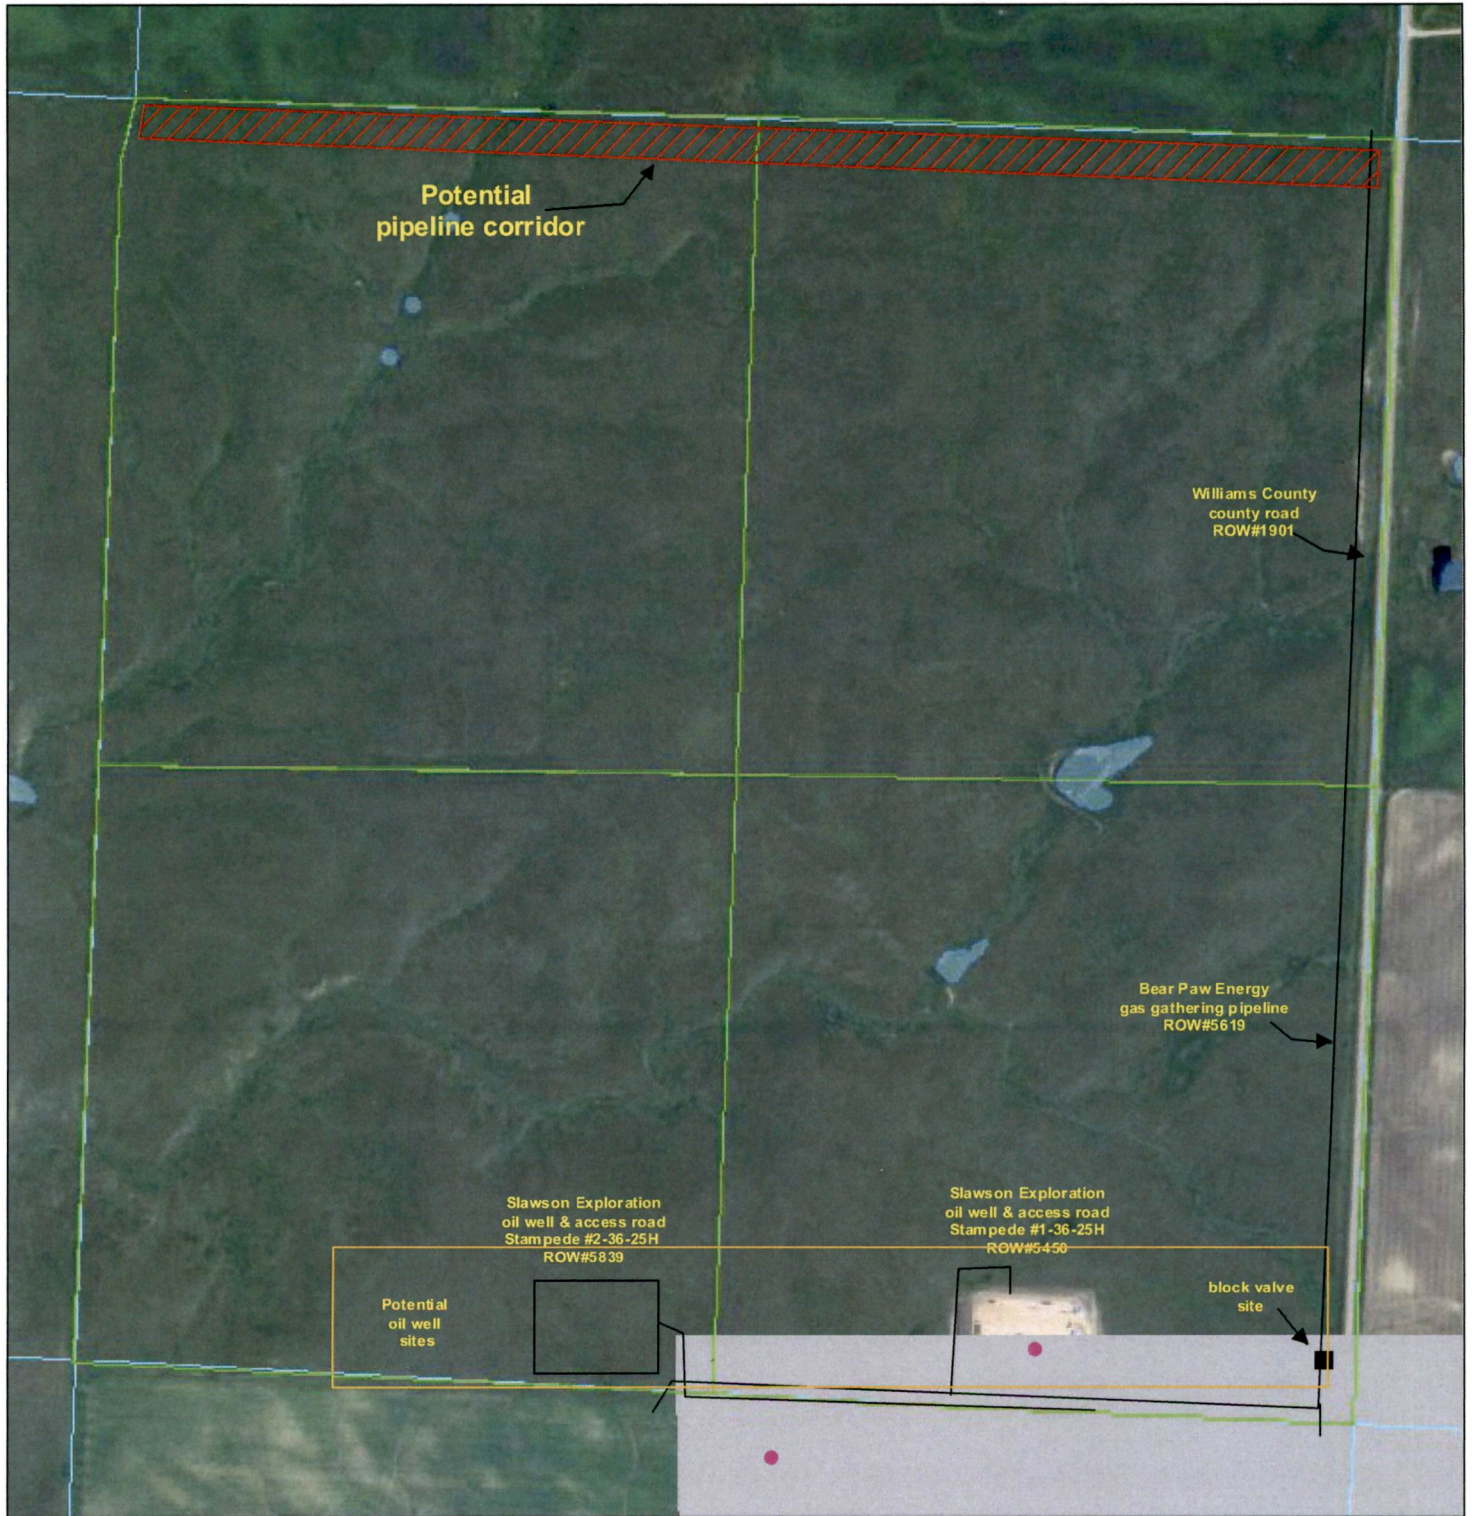

Map Datum is WGS 84 (same as NAD 83)

