




**LEGEND:**  
 STRUCTURE  
 EASEMENT CENTERLINE  
 150' WIDE EASEMENT

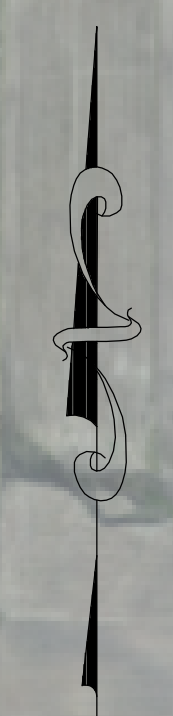

Basis of Bearing is NAD83 ND State Plane North Zone - International Feet. All distances are Ground Distance. Combined scale factor = 0.999893141

SEC. 9,10,11,12 - T145N - R89W  
 MERCER COUNTY, NORTH DAKOTA

NOTE:  
 STRUCTURE PLACEMENT AS OF 8-8-2013

PSC SUBMITTAL FOR LINE 294  
 CHARLIE CREEK TO AVS  
 345kV TRANSMISSION LINE

**BASIN ELECTRIC POWER COOPERATIVE**  
 A Touchstone Energy Cooperative