

EXHIBIT
9

Date: 8/13/2013
1 inch = 700 feet

Map Features

- Present Route
- July 2013 Route
- Surface Ownership
- Sections
- Townships



15
oy Dietrich/
inda Carrie
Dietrich

Irma
Bitner

14

T145N
-R88W

22

The Coteau
Properties

Irma
Bitner 23

The Coteau
Properties

39 PU-11-696 Filed: 10/14/2013 Pages: 4
Exhibit 9 of September 4, 5, and 12, 2013 formal
hearing

Basin Electric Power Cooperative

Date: 8/13/2013
1 inch = 1,200 feet

Map Features

- Present Route
- July 2013 Route
- Surface Ownership
- Sections
- Townships



Date: 8/13/2013

1 inch = 800 feet

Map Features

-  Present Route
-  July 2013 Route
-  Surface Ownership
-  Cultural Sites
-  Sections
-  Townships

26

HOLMES,
JANET R

DENNERT,
DANA &
NANCY

WADE A &
MELISSA C

**T156N -
R101W**

35


36

MCCAULEY
PARTNERSHIP
LLLP

MCCAULEY
PARTNERSHIP
LLLP

T155N - R101W

2

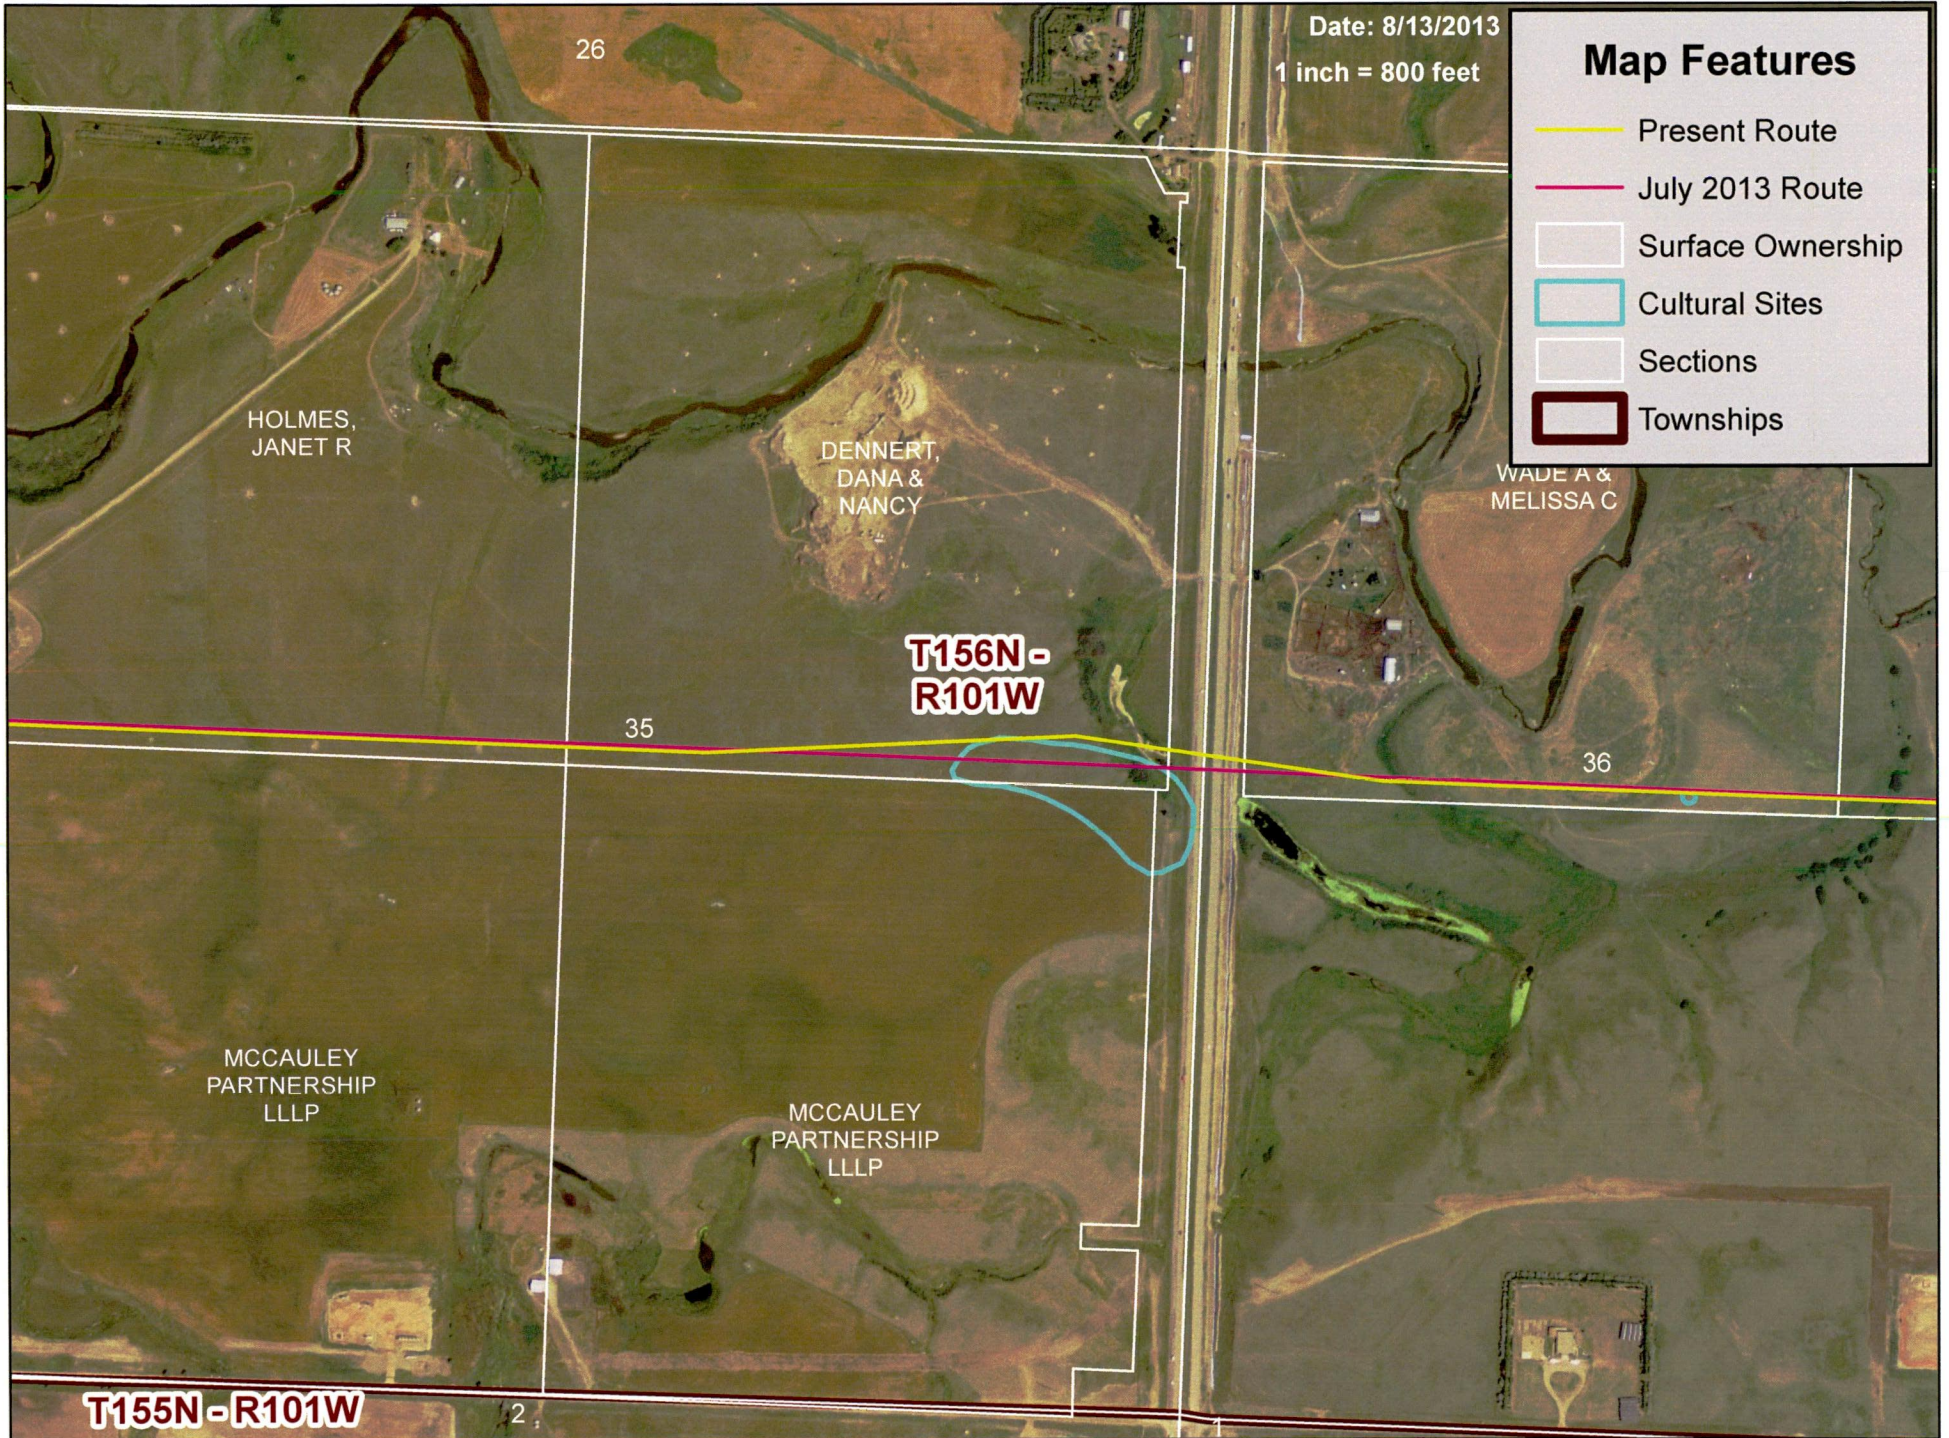

Date: 8/29/2013
1 inch = 1,200 feet

Map Features

- Present Route
- July 2013 Route
- Surface Ownership
- Townships
- Sections

