


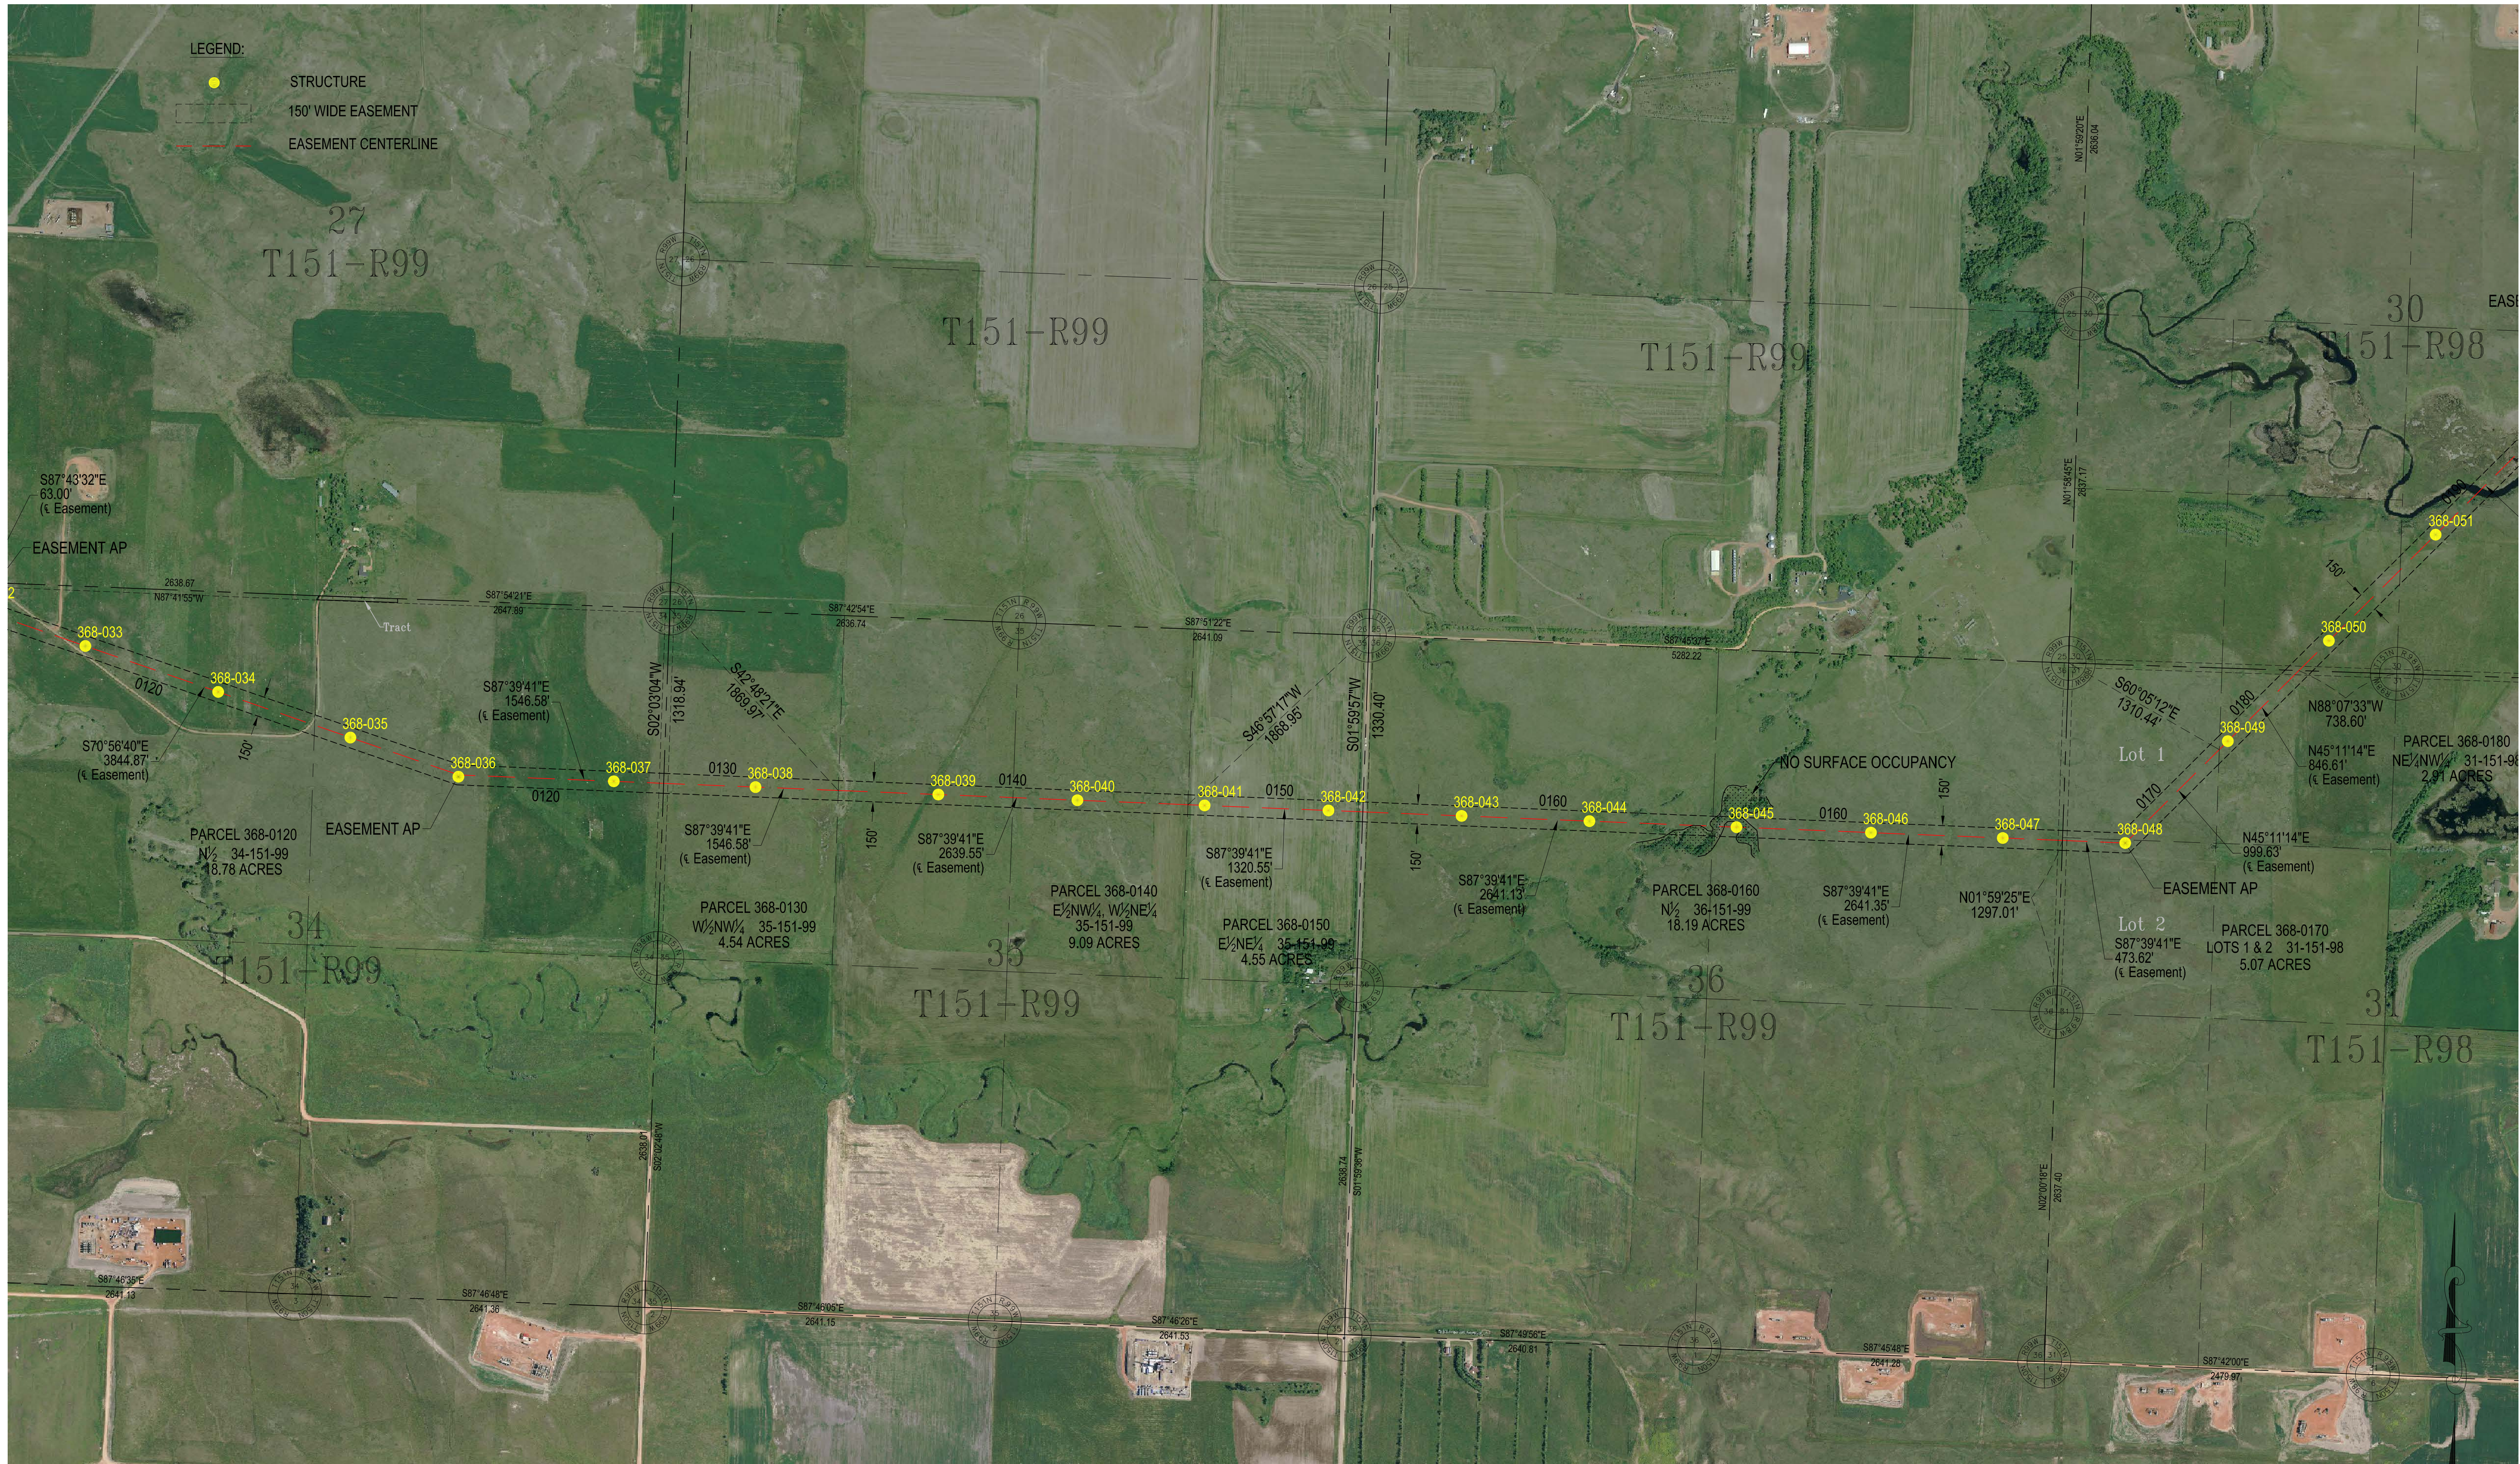


Basis of Bearing is NAD83 ND State Plane North Zone - International Feet. All distances are Ground Distance. Combined scale factor = 0.99985172

SEC. 35 & 36 – T151N-R99W
SEC. 29, 30 & 31 – T151N-R98W
MCKENZIE COUNTY, NORTH DAKOTA

NOTE:
STRUCTURE PLACEMENT AS OF 3-3-2015

PSC SUBMITTAL FOR LINE 368
PATENT GATE TO KUMMER RIDGE
345kV TRANSMISSION LINE

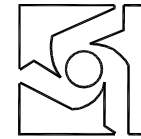**BASIN ELECTRIC
POWER COOPERATIVE**
A Touchstone Energy Cooperative