



2302 Great Northern Drive
PO Box 2757
Fargo, ND 58108-2747
(701) 241-8632
dave.sederquist@xcelenergy.com

May 21, 2014

- VIA E-MAIL & U.S. MAIL -

Darrell Nitschke, Executive Director
North Dakota Public Service Commission
State Capitol Building, Dept 408
600 East Boulevard
Bismarck, ND 59505-0480

**RE: REVISED MAP OF PEACE GARDEN SUBSTATION (FIGURE 1)
CERTIFICATE OF PUBLIC CONVENIENCE AND NECESSITY NUMBER 5465
CASE NO. PU-12-039**

Dear Mr. Nitschke:


Northern States Power Company, doing business as Xcel Energy, submits the enclosed revised map of the Peace Garden Substation (Figure 1).

Please contact me at 701-241-8632 if you have any questions concerning this filing.

SINCERELY,

A handwritten signature in blue ink that reads 'David H. Sederquist'.

DAVID H. SEDERQUIST
SENIOR REGULATORY AND FINANCIAL CONSULTANT

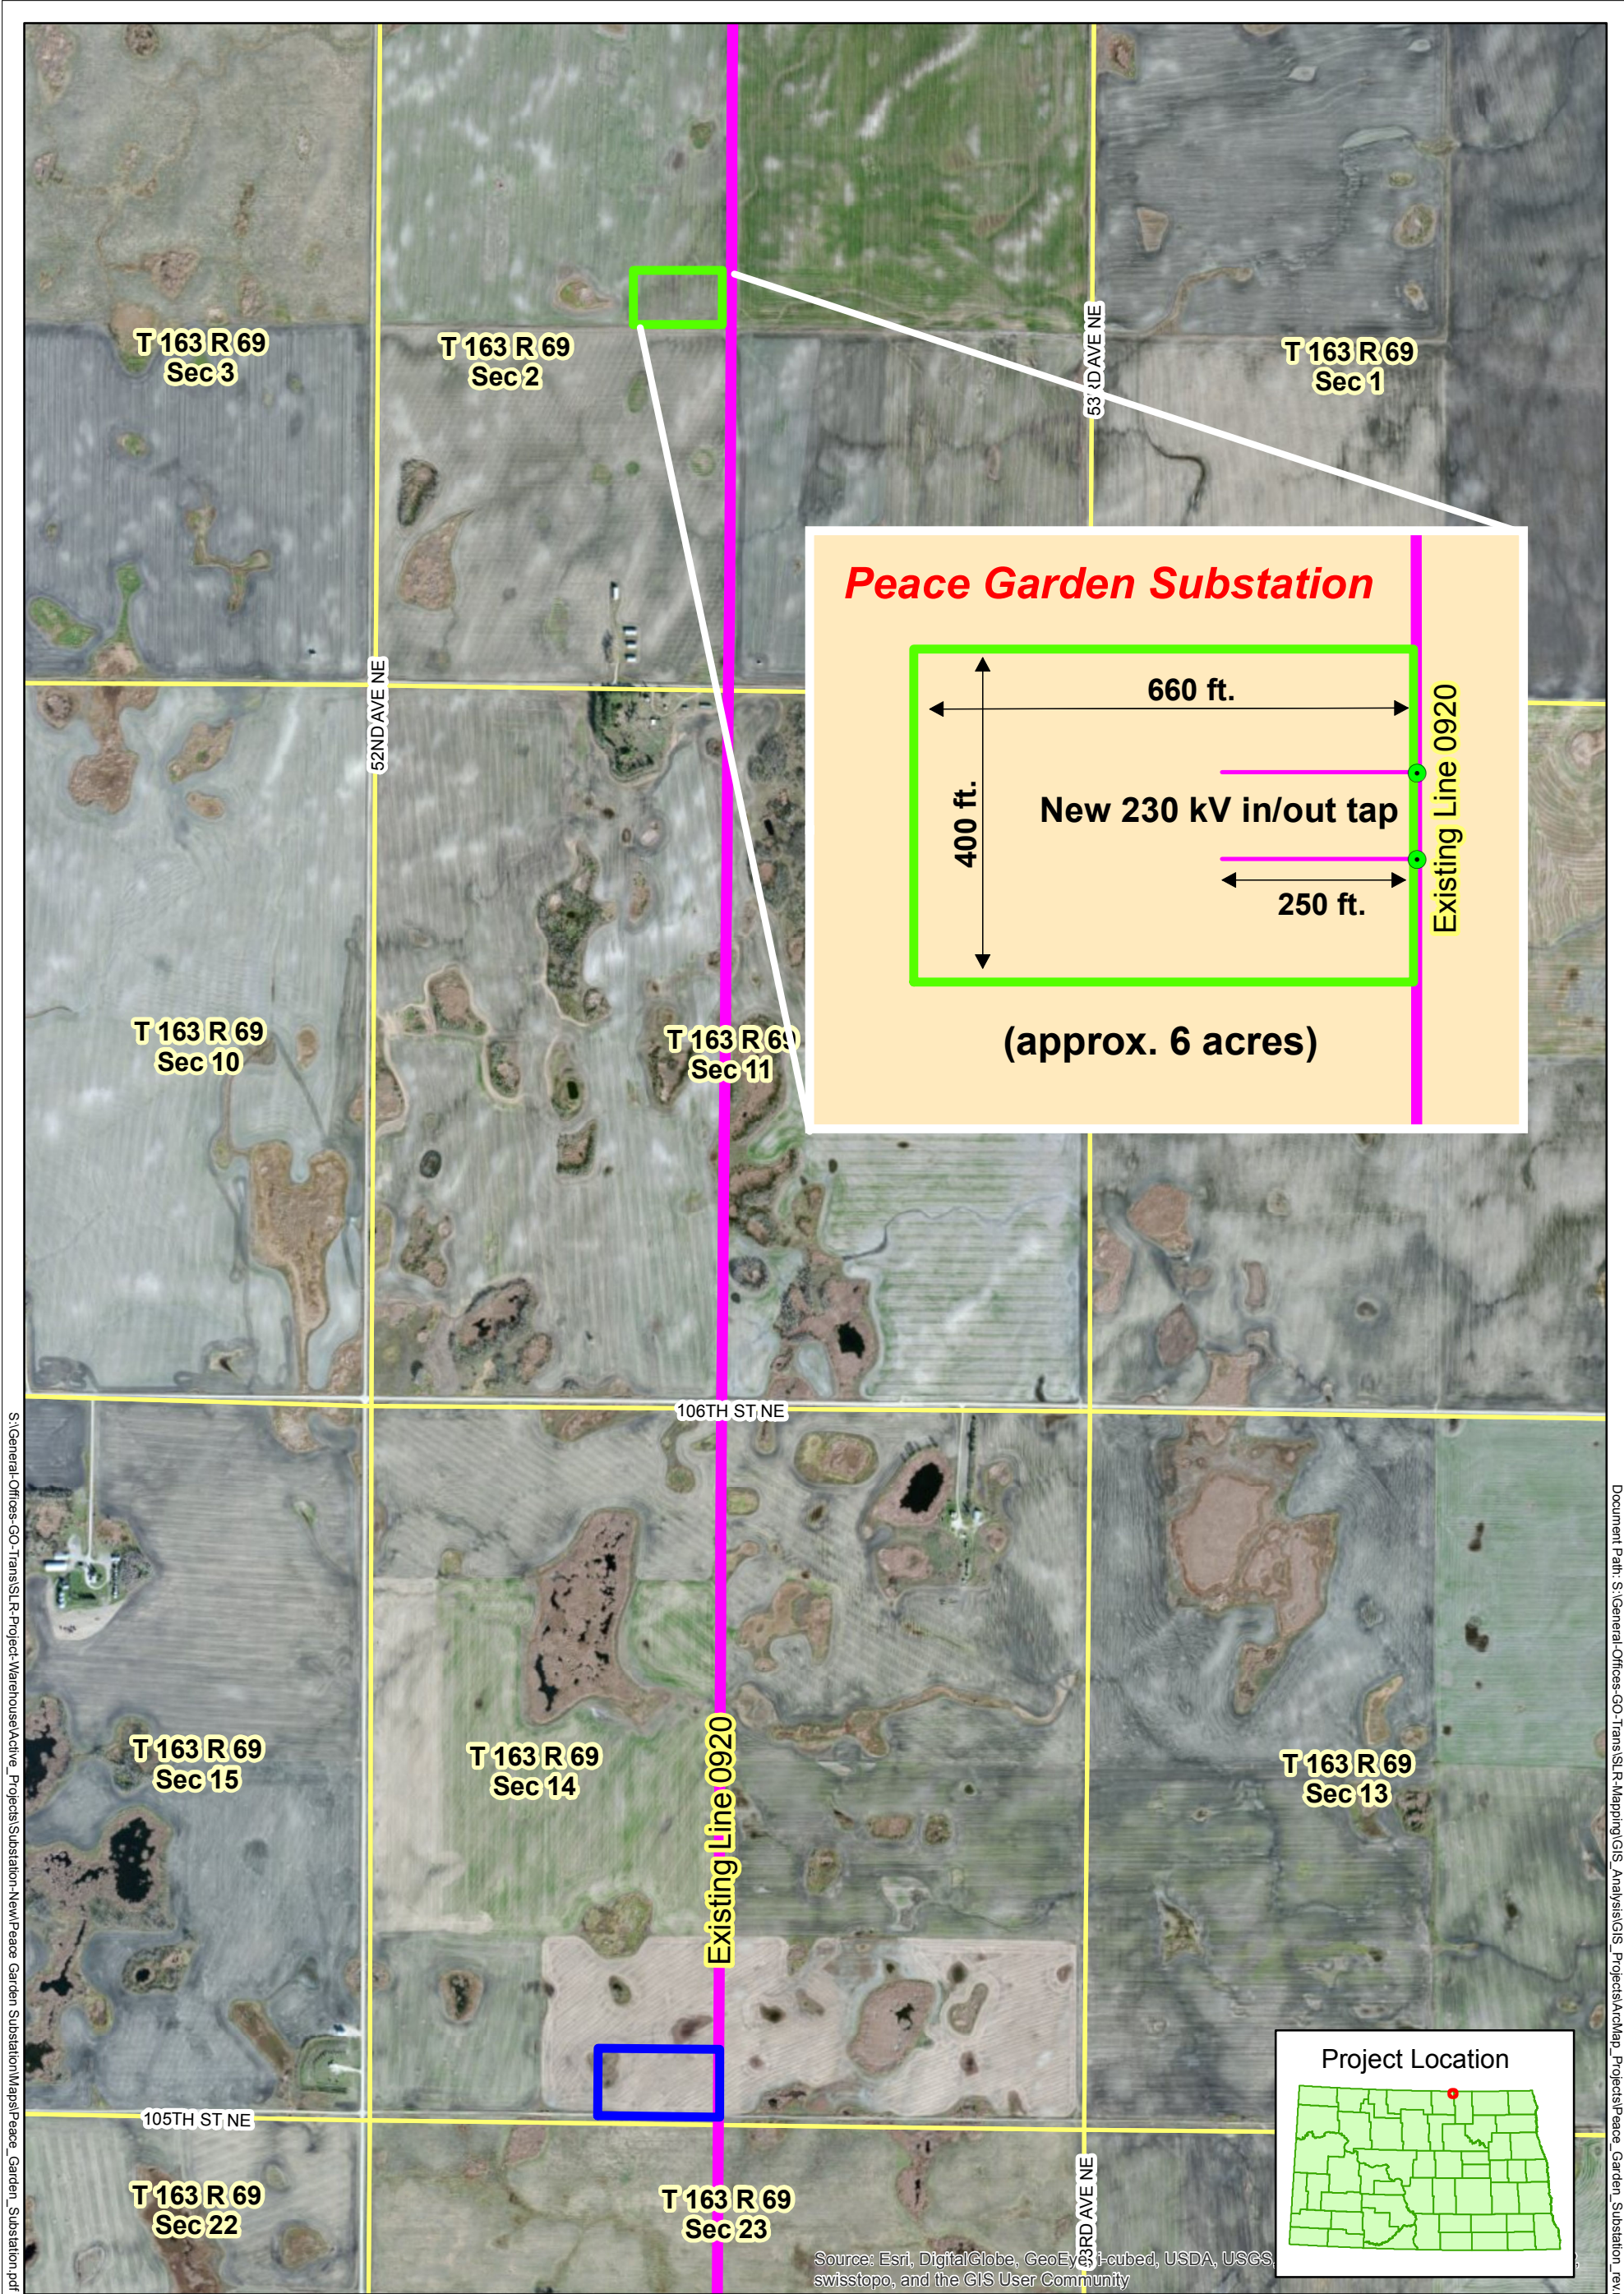

S:\General-Offices-GO-Trans\SLR-Project-Warehouse\Active-Projects\Substation-New\Peace Garden Substation\Map\Peace_Garden_Substation.pdf

Document Path: S:\General-Offices-GO-Trans\SLR-Project-Warehouse\Active-Projects\Substation-New\Peace Garden Substation\Map\Peace_Garden_Substation.pdf

Source: Esri, DigitalGlobe, GeoEye, Earthstar, USDA, USGS, swisstopo, and the GIS User Community

Proposed Peace Garden Substation

Rolette County, ND


Figure 1



- Proposed Substation Boundary
- Previously Permitted Substation Boundary
- Existing Xcel Energy 230 kV Transmission Line
- Section Line



DISCLAIMER: This information is believed to be correct but is subject to change and is not warranted.

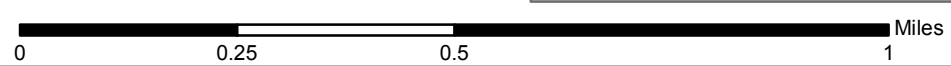

Date: May, 2014