



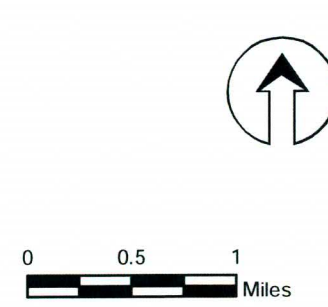
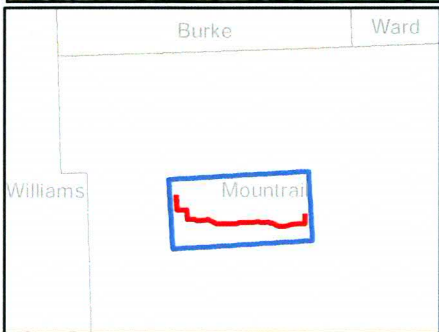
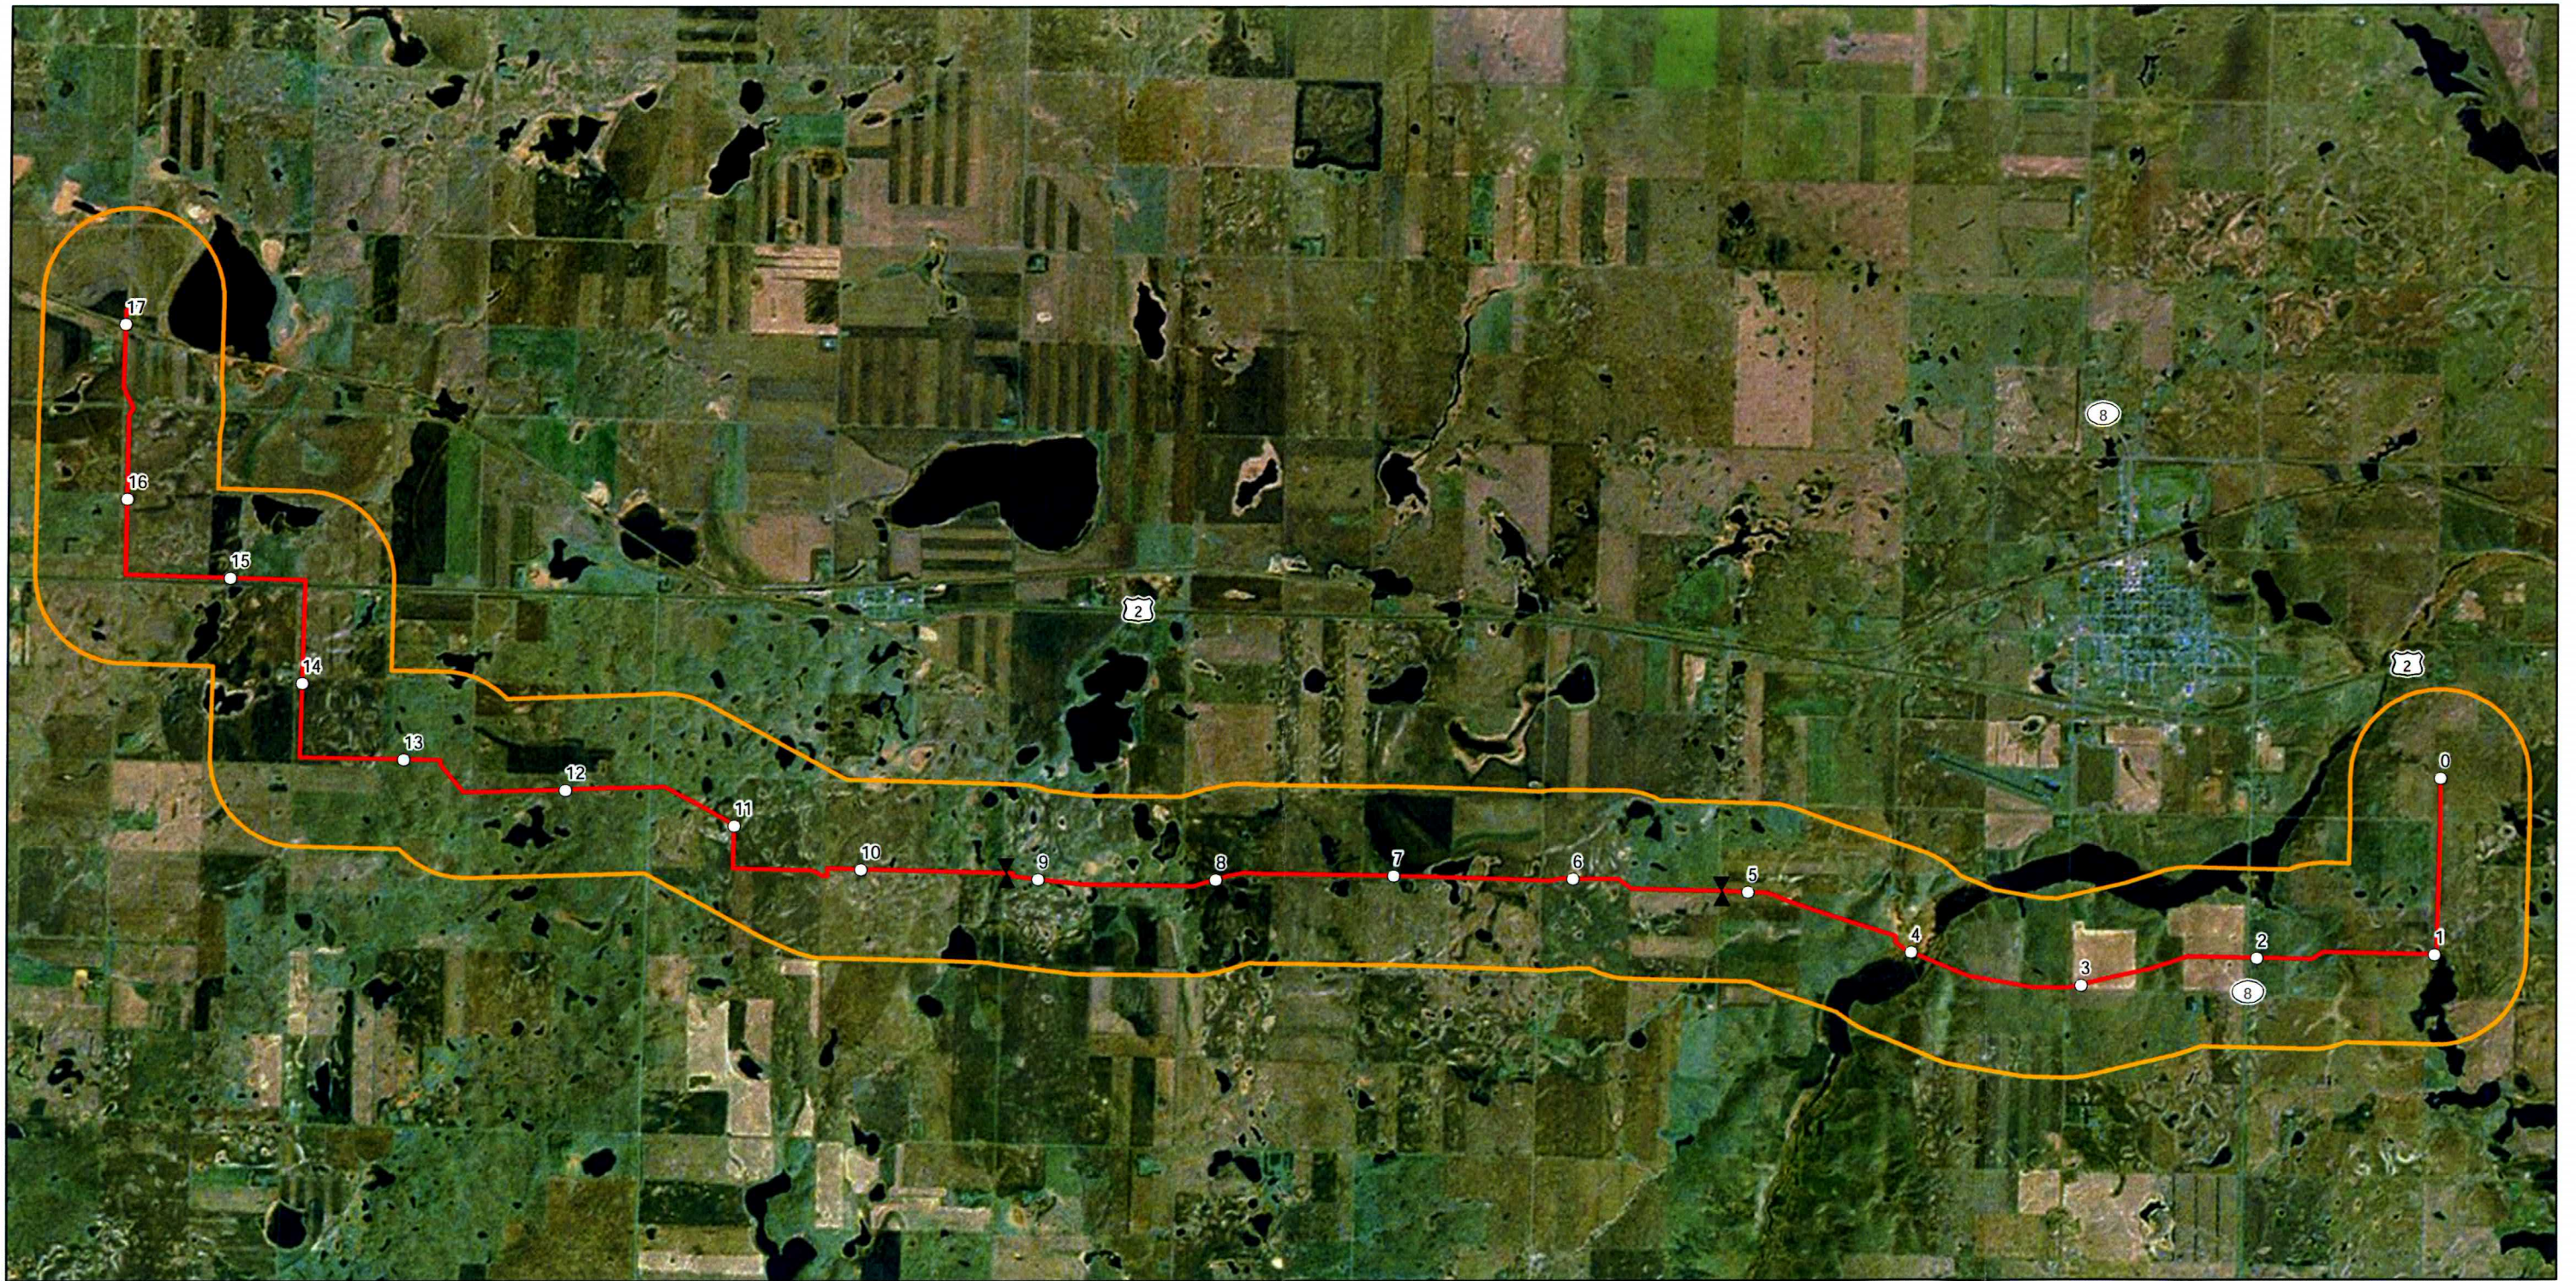





-  Valve
-  Nelson-Ross Mainline (2/6/2012)
-  Final Proposed Pipeline Centerline
-  Corridor (1-mile)

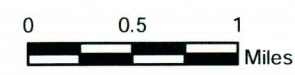


Hearing Figure 2

Nelson to Ross
Original Route with
Requested Re-Routes



-  Valve
-  Final Proposed Pipeline Centerline
-  Corridor (1-mile)




**Enhancing Execution
with Experience**


**PLAINS
ALL AMERICAN
PIPELINE, L.P.**

Hearing Figure 3

 Nelson to Ross
 Final Proposed
 Pipeline Centerline