


Bernard Wright and Rodney Barstad Reroute
5,303 ft.

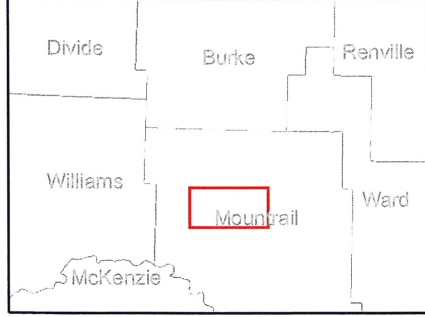

<ul style="list-style-type: none"> Valve Bernard Wright and Rodney Barstad Reroute (5,303 ft.) Final Proposed Pipeline Centerline Nelson-Ross Mainline (2/6/2012) 	<ul style="list-style-type: none"> Corridor (1-mile) Federal Land State Land 	 	
---	--	------	------

Figure M1
Nelson to Ross
Amendment to Application
for Route Permit
Overview Map