


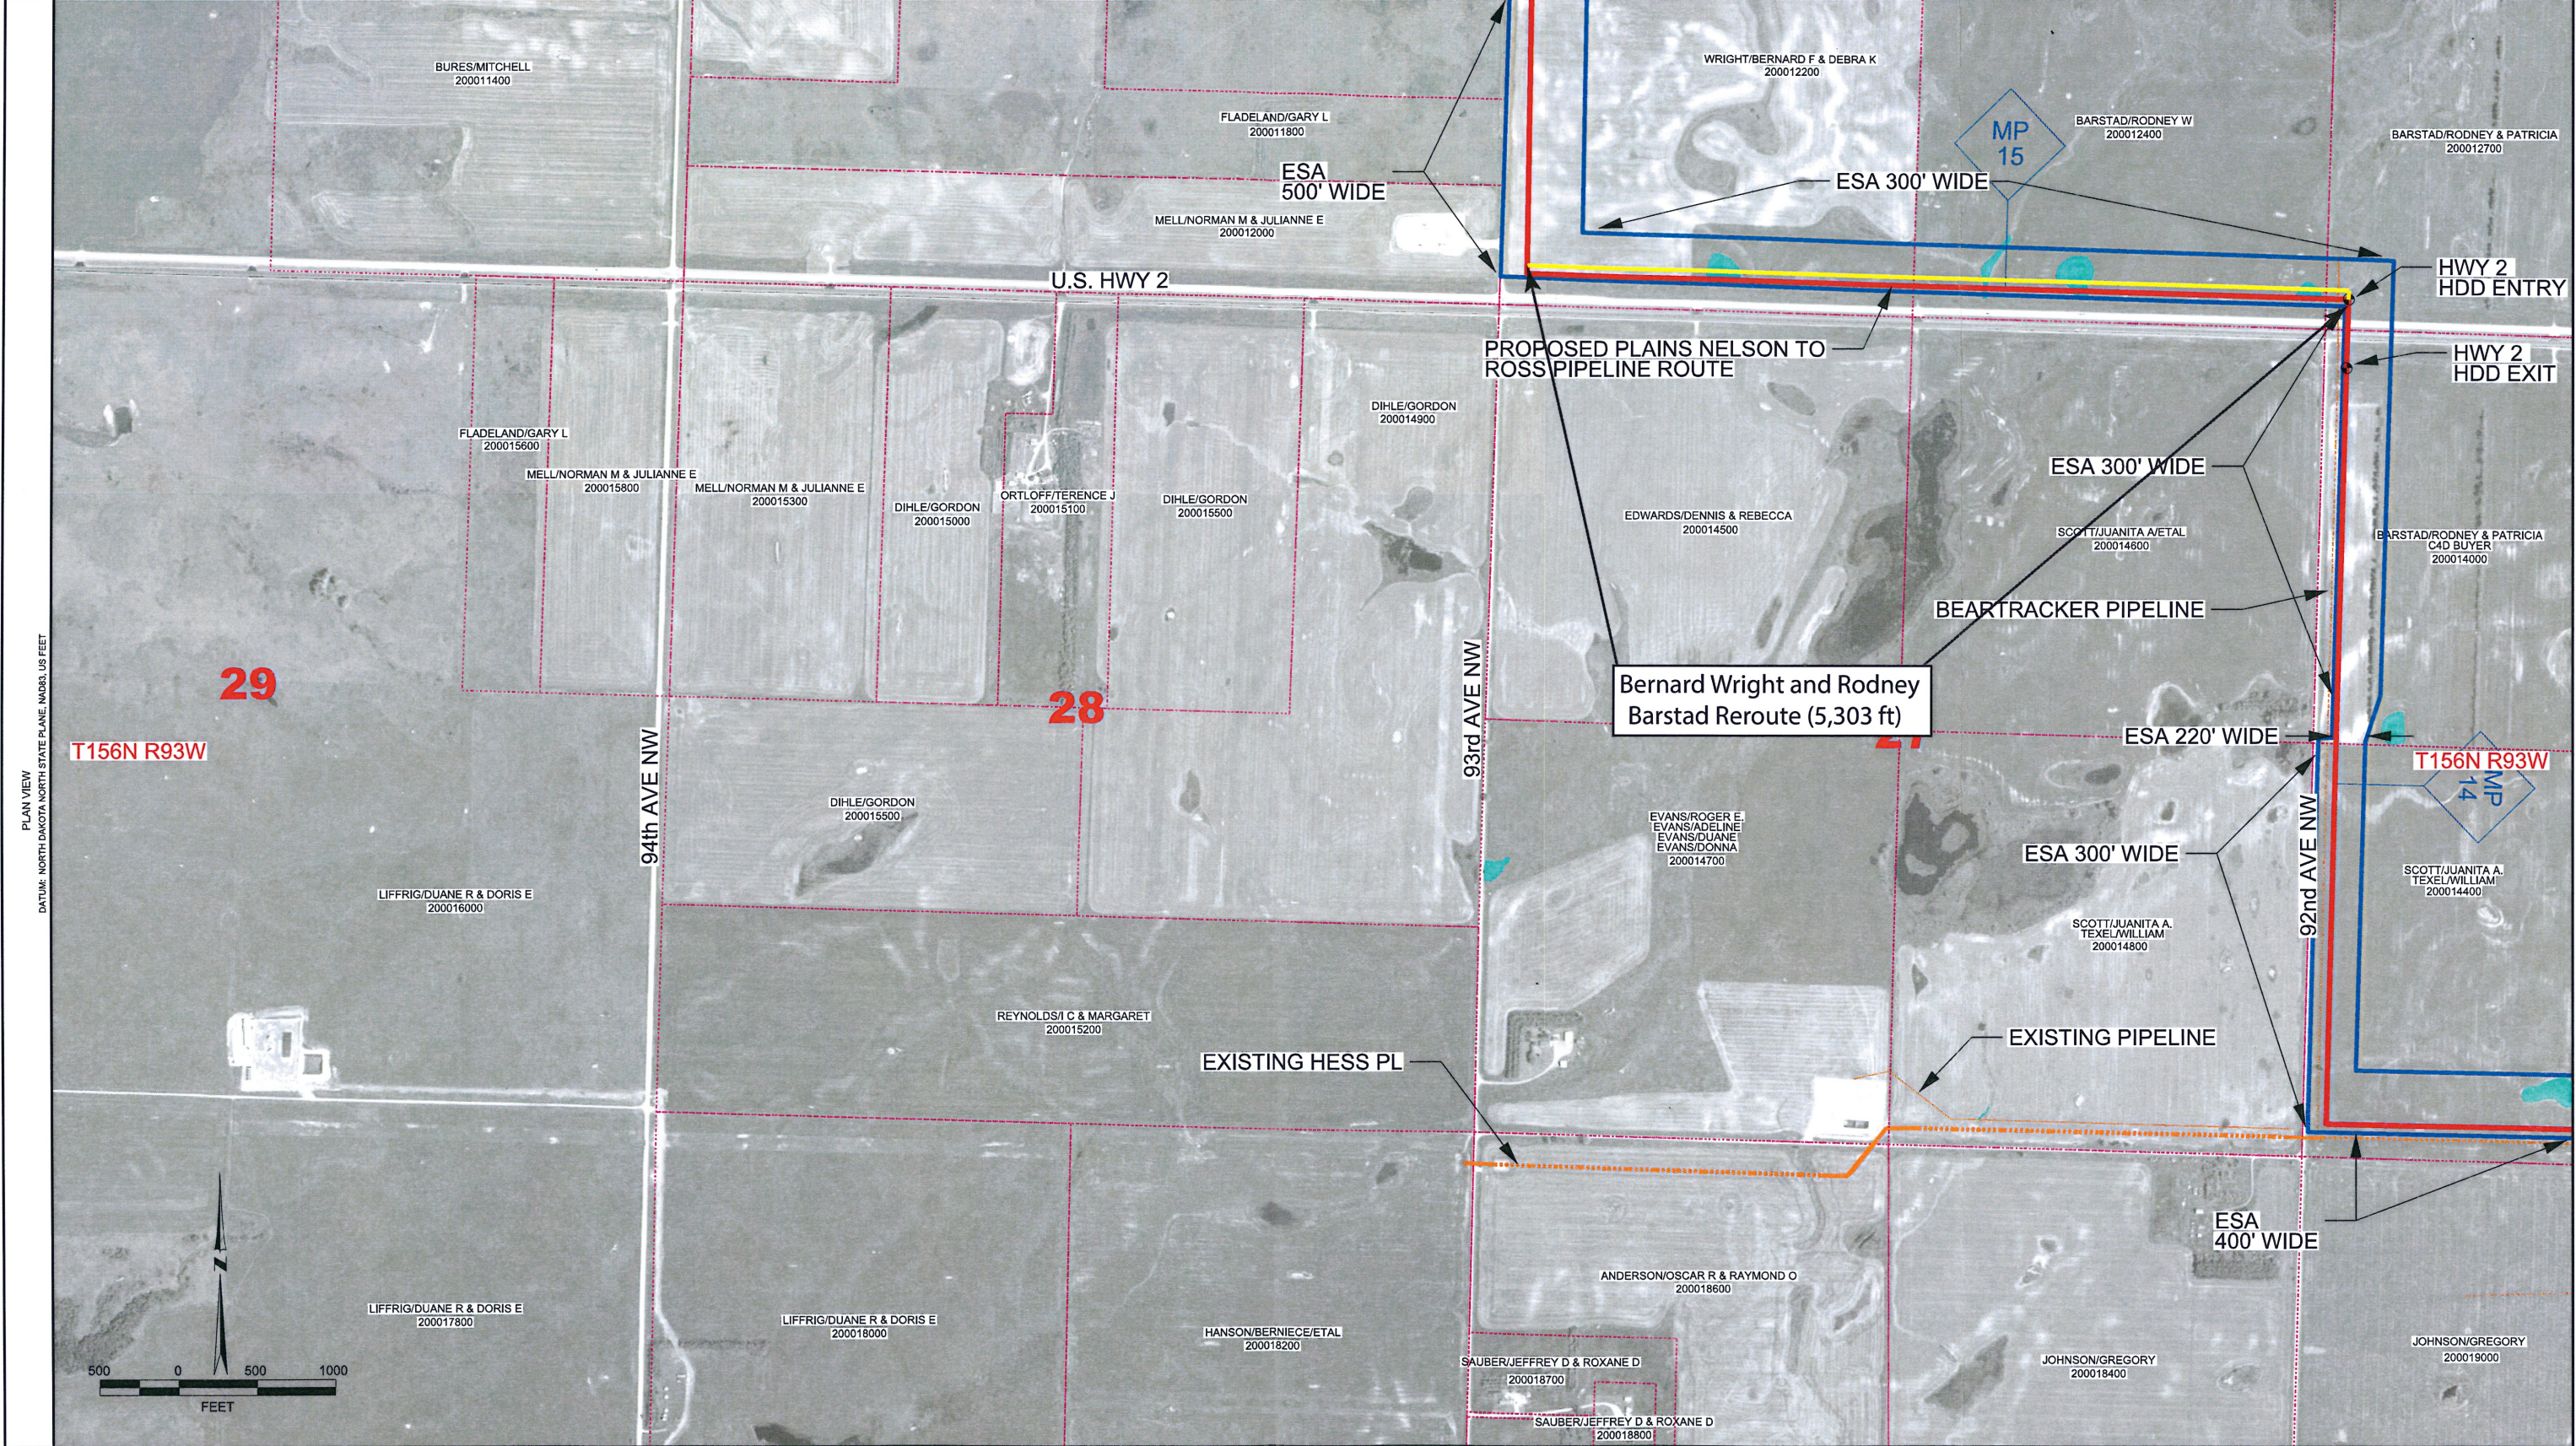

NOTES

1) ESA-ENVIRONMENTAL SURVEY AREA
2) DIMENSIONS ARE APPROXIMATE AND FOR USE IN PSC APPLICATIONS ONLY

PIPE SUMMARY				PIPE SPECIFICATIONS			
FROM	TO	LIN. FT.	TYPE	FROM	TO	LIN. FT.	TYPE

SPECIFICATIONS		REVISIONS	
WELDS:	X-RAYS:	REV. NO.	DESCRIPTION
TEST PRESSURE:		A	ISSUED FOR REVIEW
M.O.P.:		B	UPDATED PL ROUTE AND LAND OWNERS
CONST. START DATE:		C	UPDATED PIPELINE ROUTE FROM SURVEY
CONST. END DATE:		D	UPDATED FOREIGN PIPELINES FROM SURVEY
FIELD BOOK	PAGES	E	ADDED SECTION NUMBERS
		F	UPDATED ROUTE
		G	ADDED WETLANDS
		H	ADDED ESA BOUNDARY

SCALE:	AS SHWN	DATE	PROJECT NO.	DRAWING NO.
DWN BY:	JW	8-9-11	02826	2826-M-0005
CHKD BY:	QB	8-9-11		
ENGR:				

PLAINS
ALL AMERICAN
PIPELINE, L.P.

**NELSON TO ROSS PIPELINE
PROPOSED ROUTE OVERVIEW #5
MOUNTAIN COUNTY, NORTH DAKOTA**

PREPARED BY: ROCKWELL ENGINEERING, INC. PLATTED: SPATES