



Reroute Segment 7

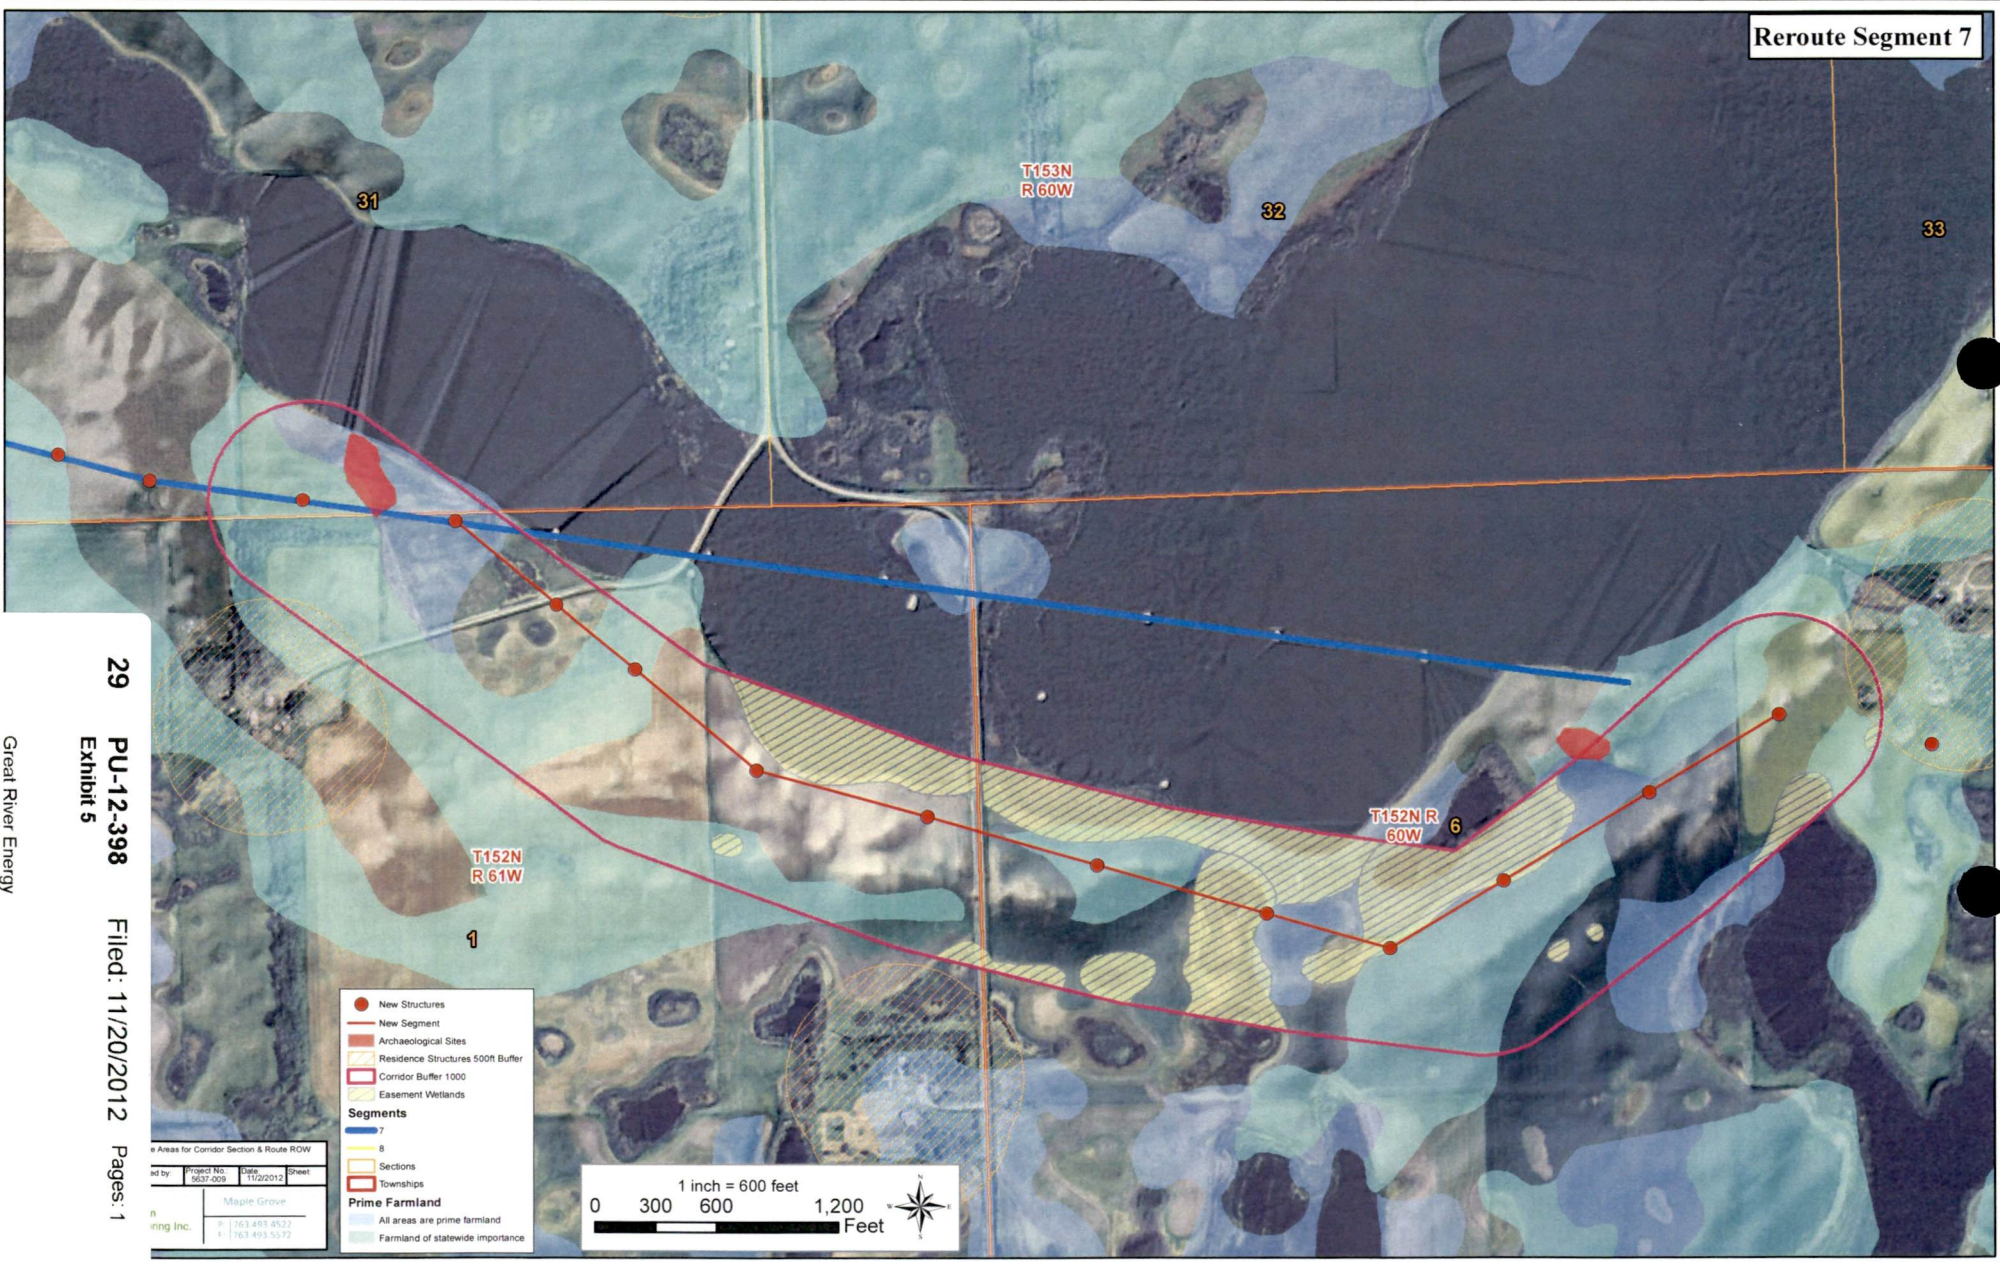

- New Structures
 - New Segment
 - Archaeological Sites
 - Residence Structures 500ft Buffer
 - Corridor Buffer 1000
 - Easement Wetlands
- Segments**
- 7
 - 8
- Sections**
- Townships**
- 152N
 - 153N
- Prime Farmland**
- All areas are prime farmland
 - Farmland of statewide importance

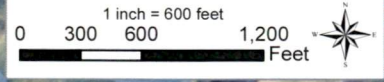

Areas for Corridor Section & Route ROW

Project No.	Date	Sheet
9637-009	11/20/2012	

Maple Grove

1763.481.4522
1763.493.5572