LIGNITE TO STAMPEDE
ALIGNMENT SHEETS
AS-BUILT

STATION TO STATION		WALL SIZE	GRADE	API 5L GR. X52 PIPE TOTALS	
-00+35	00+98	.219	X52	TOTAL .219 PIPE	TOTAL .365 PIPE
00+98	03+36	.365	X52		
03+36	18+68	.219	X52		
18+68	19+22	.365	X52		
19+22	65+62	.219	X52		
65+62	72+64	.365	X52		
72+64	104+56	.219	X52		
104+56	105+67	.365	X52		
105+67	120+00	.219	X52		
120+00	131+34	.219	X52		
131+34	134+91	.365	X52		
134+91	157+85	.219	X52		
157+85	158+28	.365	X52		
158+28	208+59	.219	X52	33,626'	2445'
208+59	209+30	.365	X52		
209+30	240+00	.219	X52		
240+00	246+08	.219	X52		
246+08	248+69	.365	X52		
248+69	261+46	.219	X52		
261+46	262+19	.365	X52		
262+19	314+19	.219	X52		
314+19	314+90	.365	X52		
314+90	347+85	.219	X52		
347+85	352+49	.365	X52		
352+49	360+36	.219	X52		

TESORO LOGISTICS

REFERENCE DRAWINGS	
DRAWING NO.	TITLE

REVISIONS							
NO.	DESCRIPTION	BY	DATE	CHK	DATE	APP	DATE
0	AS BUILT	KMC	8/9/13	RC	8/9/13	KE	8/9/13

	BY	DATE	REC JOB NUMBER:
DRAWN	AKA	7/9/13	CLIENT CONTRACT NUMBER:
CHECKED	MSB	7/9/13	CAD FILE:
APPROVED			

PREPARED BY:
EDK
TECHNICAL COMPANY, LLC

TESORO LOGISTICS OPERATIONS LLC.

TESORO HIGH PLAINS PIPELINES
PLOT PLAN AND PROFILE
10" LATERAL FROM
LIGNITE TO STAMPEDE

SCALE: NOTED | DWG: 1 OF 4 | REV: 0

PLSS		SECTION 34, T 163 N, R 92 W		SECTION 3, T 162 N, R 92 W			SECTION 4, T 162 N, R 92 W			SECTION 5, T 162 N, R 92 W
OWNER	00+00	BLAKE MARTIN & THE MARTIN BROS. PARTNERSHIP-N/P	02+20	MARLYCE MURPHY REV TRUST DOUGLASS & DEBRA NELSON CHAD JOHNSON	18+98	EUGENE DAVIDSON & DIANE BLY-N/P 2700 23RD STREET SW, MINOT, SD 85701 CARL& CAROL NEUBAUER-N/P P.O. BOX 944, OSBURN, ID 84839-0944	52+36	SHAWN BLY 10273 85TH AVE NW, LIGNITE, ND 58752	78+32	BLY FAMILY LIGNITE, ND	105+24	EUGENE DAVIDSON & DIANE BLY-N/P 2700 23RD STREET SW, MINOT, SD 85701

STATION

PIPELINE PLAN

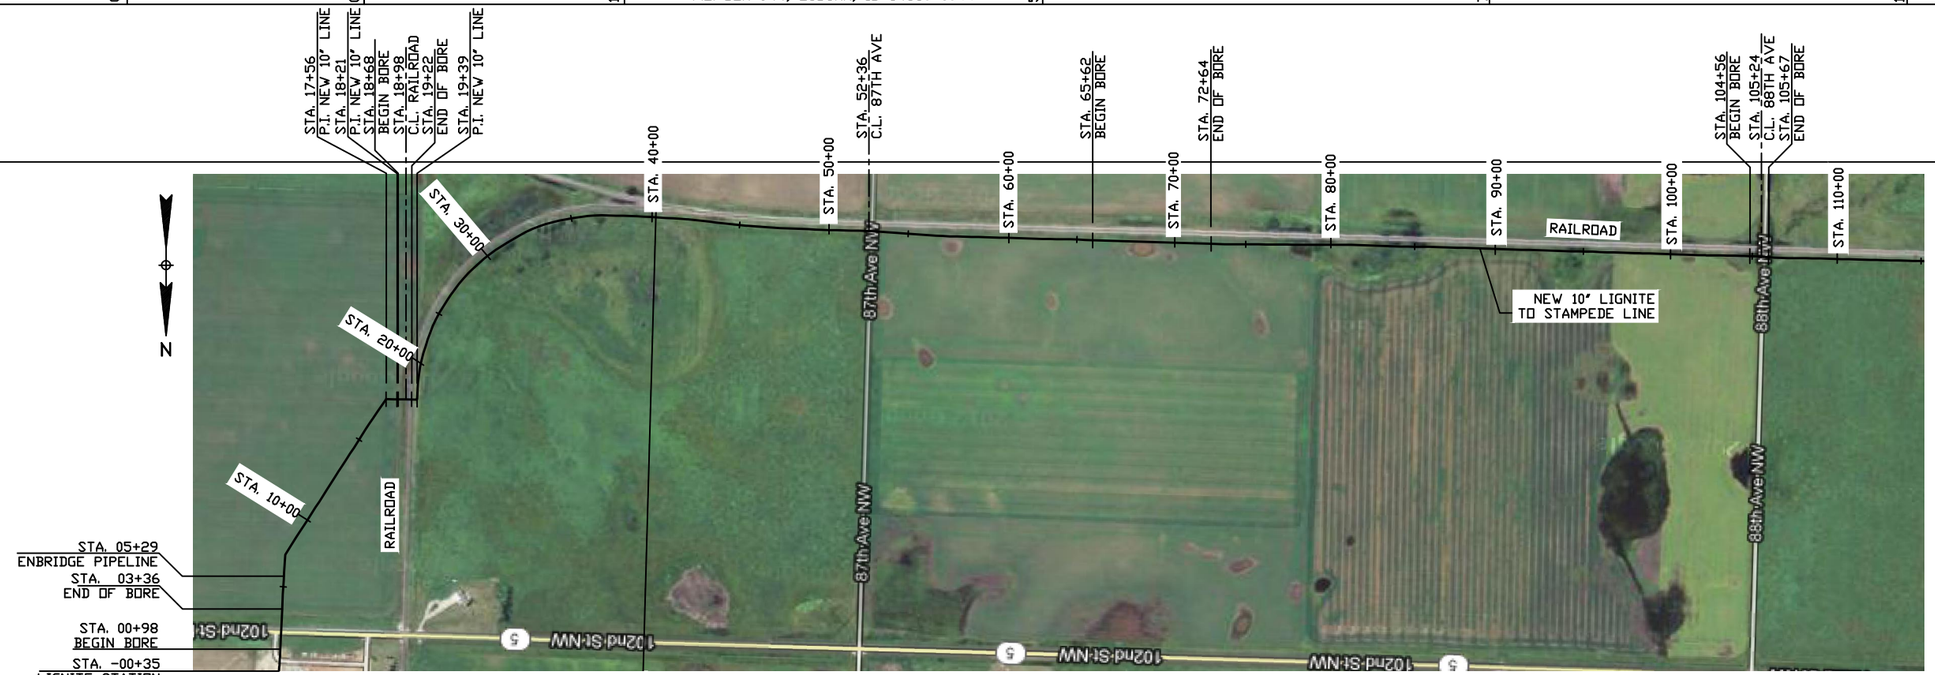

PLAN
SCALE 1"=1000'

GROUND PROFILE

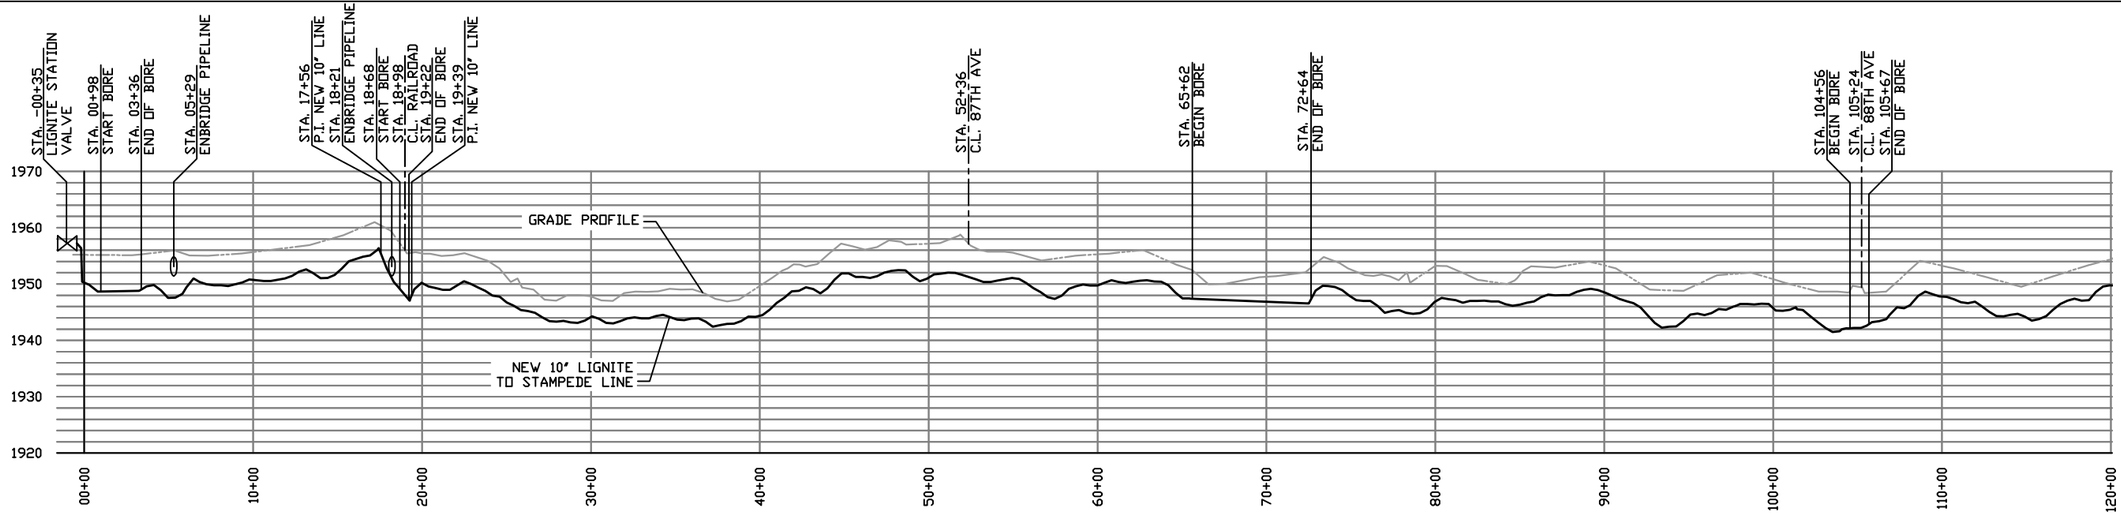

PROFILE LIGNITE TO STAMPEDE
HORIZONTAL SCALE 1"=1000'
VERTICAL SCALE 1"=30'

TESORO LOGISTICS

REFERENCE DRAWINGS		REVISIONS								
		0	AS BUILT	KMC	8/9/13	RC	8/9/13	KE	8/9/13
DRAWING NO.	TITLE	NO.	DESCRIPTION	BY	DATE	CHK	DATE	APP	DATE

	BY	DATE	REC JOB NUMBER:
DRAWN	AKA	7/9/13	CLIENT CONTRACT NUMBER:
CHECKED	MSB	7/9/13	CAD FILE:-
APPROVED			

PREPARED BY:
EDK
TECHNICAL COMPANY, LLC

TESORO LOGISTICS OPERATIONS LLC.

TESORO HIGH PLAINS PIPELINES
PLOT PLAN AND PROFILE
10" LATERAL FROM
LIGNITE TO STAMPEDE

SCALE: NOTED | DWG: 2 OF 4 | REV: 0

PLSS		SECTION 5, T 162 N, R 92 W			SECTION 6, T 162 N, R 92 W			SECTION 1, T 162 N, R 93 W	
OWNER		EUGENE DAVIDSON & DIANE BLY-N/P 2700 23RD STREET SW, MINOT, SD 85701	131+34	G&K MCEVERS FARMS, INC. P.O. BOX 577, LIGNITE, ND 58752	158+08	MICHAEL & WANDA ELY P.O. BOX 175, COLUMBUS, ND 58727	185+00	FIRST HERITAGE RE TRUST-N/P 59 OAKLAWN ST, NEW BEDFORD, MA 02744	208+95	MICHAEL & WANDA ELY P.O. BOX 175, COLUMBUS, ND 58727	240+00

STATION

STA. 131+34 BEGIN BORE
STA. 134+91 END OF BORE
STA. 157+85 BEGIN BORE
STA. 158+08 C.L. 89TH AVE
STA. 158+28 END OF BORE
STA. 208+59 BEGIN BORE
STA. 208+95 C.L. 90TH AVE
STA. 209+30 END OF BORE

PIPELINE PLAN

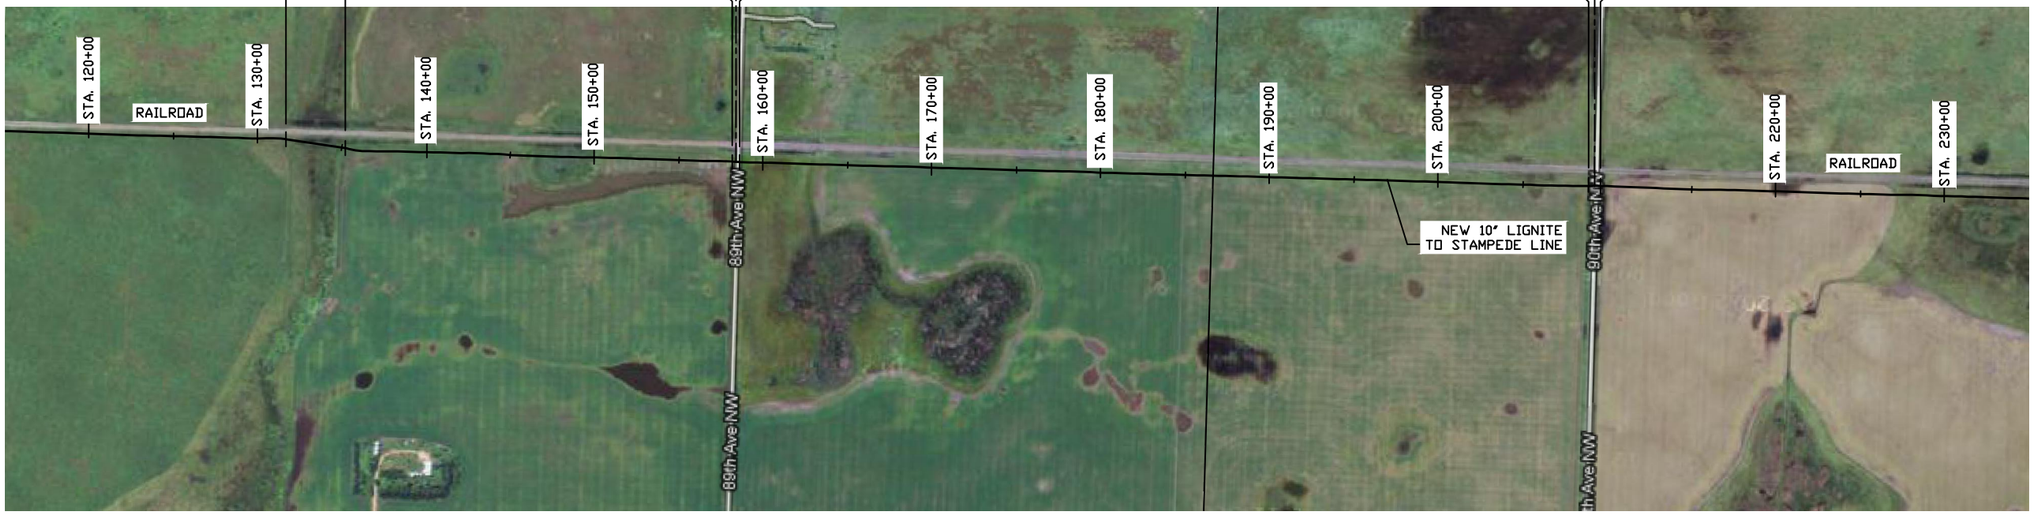

PLAN
SCALE 1"=1000'

GROUND PROFILE

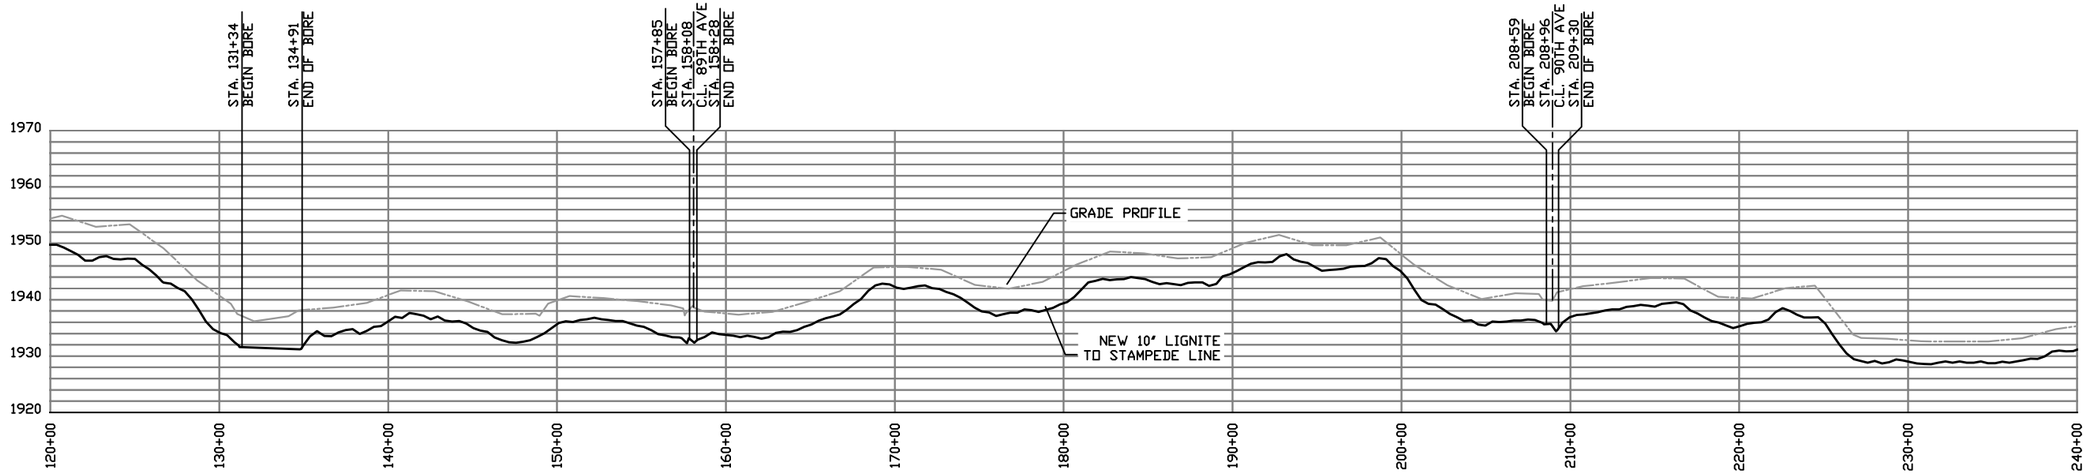

PROFILE LIGNITE TO STAMPEDE
HORIZONTAL SCALE 1"=1000'
VERTICAL SCALE 1"=30'

TESORO LOGISTICS

REFERENCE DRAWINGS		REVISIONS								
		0	AS BUILT	KMC	8/9/13	RC	8/9/13	KE	8/9/13	
DRAWING NO.	TITLE	NO.	DESCRIPTION	BY	DATE	CHK	DATE	APP	DATE	

	BY	DATE	REC JOB NUMBER:
DRAWN	AKA	7/9/13	CLIENT CONTRACT NUMBER:
CHECKED	MSB	7/9/13	CAD FILE:-
APPROVED			
PREPARED BY:	EDK TECHNICAL COMPANY, LLC		

TESORO LOGISTICS OPERATIONS LLC.

TESORO HIGH PLAINS PIPELINES
PLOT PLAN AND PROFILE
10" LATERAL FROM
LIGNITE TO STAMPEDE

SCALE: NOTED | DWG: 3 OF 4 | REV: 0

PLSS		SECTION 1. T 162 N R 93 W		SECTION 2 T 162 N R 93 W			SECTION 3. T 162 N R 93 W		
OWNER	240+00	STANLEY P. & MARGARET W. PARRIS 4462 WINSTON LANE S, SARASOTA, FL 34235-3209	261+78	JAMES M. & KERRI K. POWELL 9474 HWY 5, COLUMBUS, ND 58727	288+00	JEROME KOPPELSLOEN 5025 14TH ST SE, MINOT, SD 58701	314+61	TX3, LLLP 662 SUNSET CT., SHOREVIEW, MN 55126	343+00	BASIN TRANSLOAD P.O. BOX 80284, BILLINGS, MT 59102	360+36

STATION

STA. 246+08 BEGIN BORE EAST BRANCH SHORT CREEK
STA. 248+69 END OF BORE EAST BRANCH SHORT CREEK
STA. 261+46 BEGIN BORE
STA. 261+78 C.L. 91ST AVE
STA. 262+19 END OF BORE
STA. 292+49 PIPELINE B.G.
STA. 298+78 PIPELINE A.G.
STA. 314+19 BEGIN BORE
STA. 314+61 C.L. 92ND AVE.
STA. 314+90 END OF BORE
STA. 315+33 P.I. NEW 10" LINE
STA. 320+15 P.I. NEW 10" LINE
STA. 347+85 BEGIN BORE
STA. 352+49 END OF BORE
STA. 354+52 P.I. NEW 10" LINE
STA. 357+12 P.I. NEW 10" LINE
STA. 360+36 STAMPEDE STATION VALVE

PIPELINE PLAN

PLAN
SCALE 1"=1000'

GROUND PROFILE

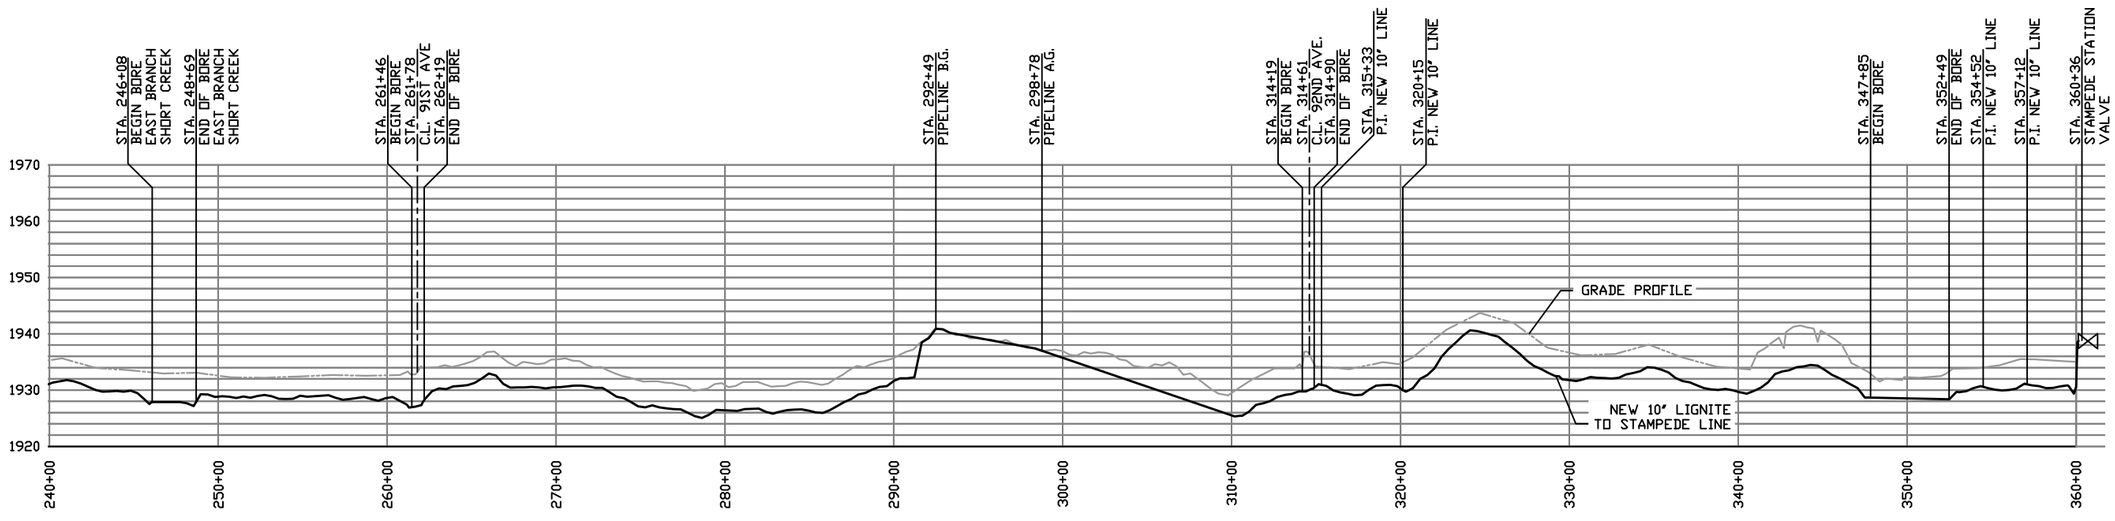

PROFILE LIGNITE TO STAMPEDE
HORIZONTAL SCALE 1"=1000'
VERTICAL SCALE 1"=30'

TESORO LOGISTICS

REFERENCE DRAWINGS		REVISIONS							
		0	AS BUILT	KMC	8/9/13	RC	8/9/13	KE	8/9/13
DRAWING NO.	TITLE	NO.	DESCRIPTION	BY	DATE	CHK	DATE	APP	DATE

	BY	DATE	REC JOB NUMBER:
DRAWN	AKA	7/9/13	CLIENT CONTRACT NUMBER:
CHECKED	MSB	7/9/13	CAD FILE:-
APPROVED			
PREPARED BY:	EDK TECHNICAL COMPANY, LLC		

TESORO LOGISTICS OPERATIONS LLC.

TESORO HIGH PLAINS PIPELINES
PLOT PLAN AND PROFILE
10" LATERAL FROM
LIGNITE TO STAMPEDE

SCALE: NOTED | DWG: 4 OF 4 | REV: 0