Courtenay Wind Farm - Meteorological Tower Change

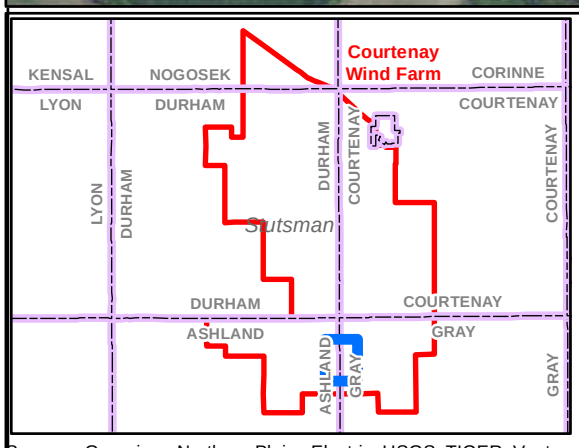

LEGEND

- Final Turbine Layout
- Turbine Removed From Layout
- New Permanent Met Tower
- Removed Permanent Met Tower
- Access Road
- Collection System

0 245 490 980
Feet

COURTENAY WIND FARM
Stutsman County, ND

Sources: Geronimo, Northern Plains Electric, USGS, TIGER, Ventyx

Document Path: G:\GISData\Projects\Courtenay Wind Farm\Projects\CY_NewMetTower_DetailMap_20141016.mxd

psmith Date: 11/7/2014