

# Pipe Depth Map


**Proposed Transmission Lines**

- 1
- 2
- 3
- 4
- 5
- 6

**Mainline/River Valves**

**Dig Info**

- Digs
- Dig Type with Depth in Inches**
  - Determined by Line Locator
  - Foreign Line Crossing by Construction
  - Verified by Excavation
- Dig Number
- Depth in Inches

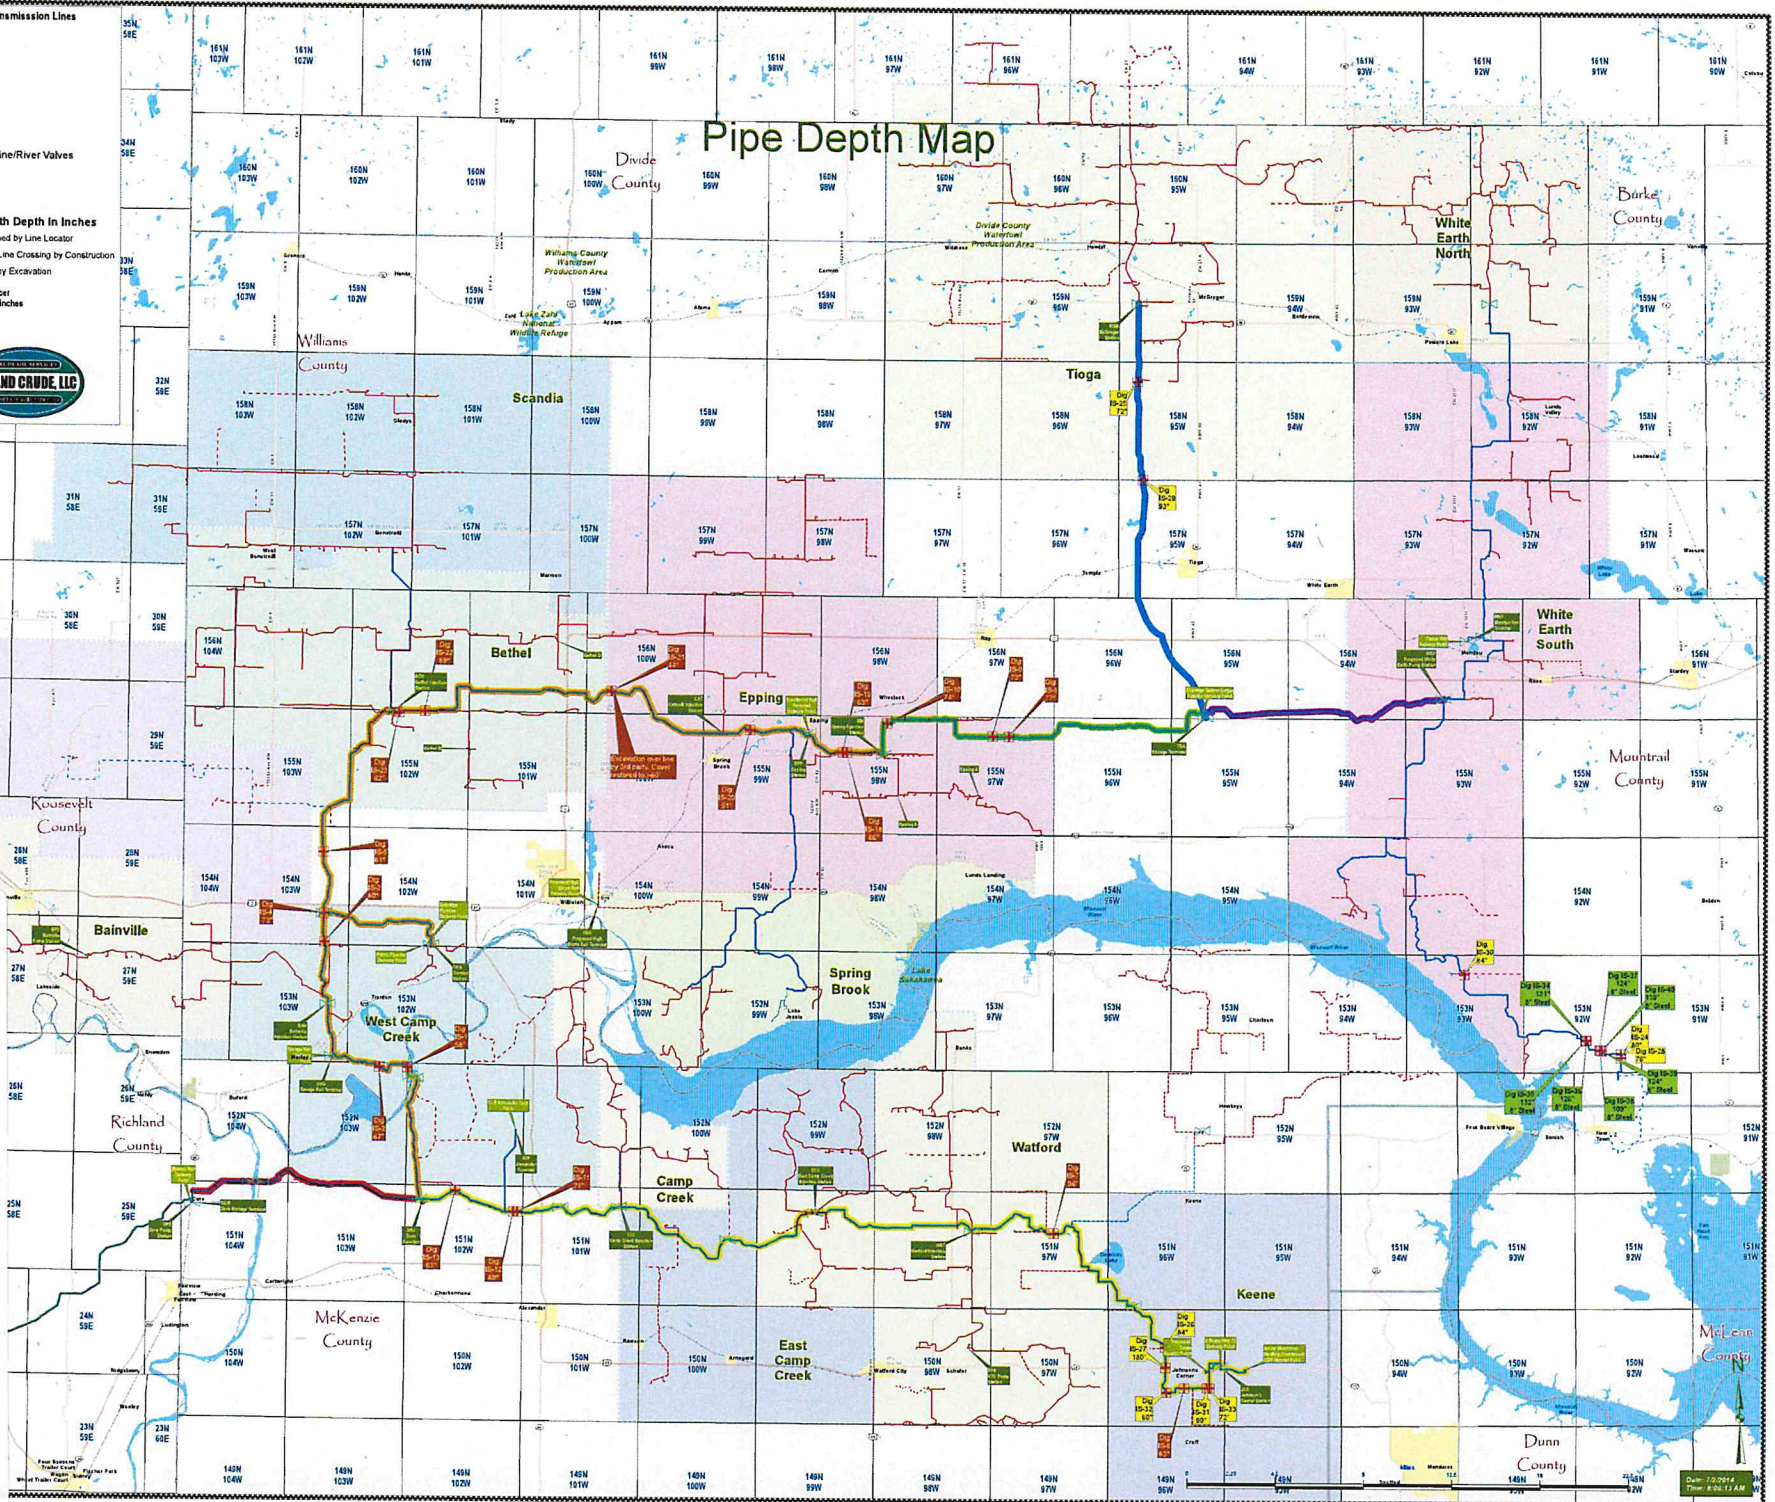

tabbles

**EXHIBIT**

**2**

28 PU-13-136 Filed: 7/15/2014 Pages: 1

Hiland Crude, LLC