


# Pipe Depth Map

- Proposed Transmission Lines**
- 1
  - 2
  - 3
  - 4
  - 5
  - 6
- Mainline/River Valves**
- ⊗
- Dig Info**
- ⊕ Digs
- Dig Type with Depth in Inches**
- Determined by Line Locator
  - Foreign Line Crossing by Construction
  - Verified by Excavation
- Dig Number**  
Depth in inches

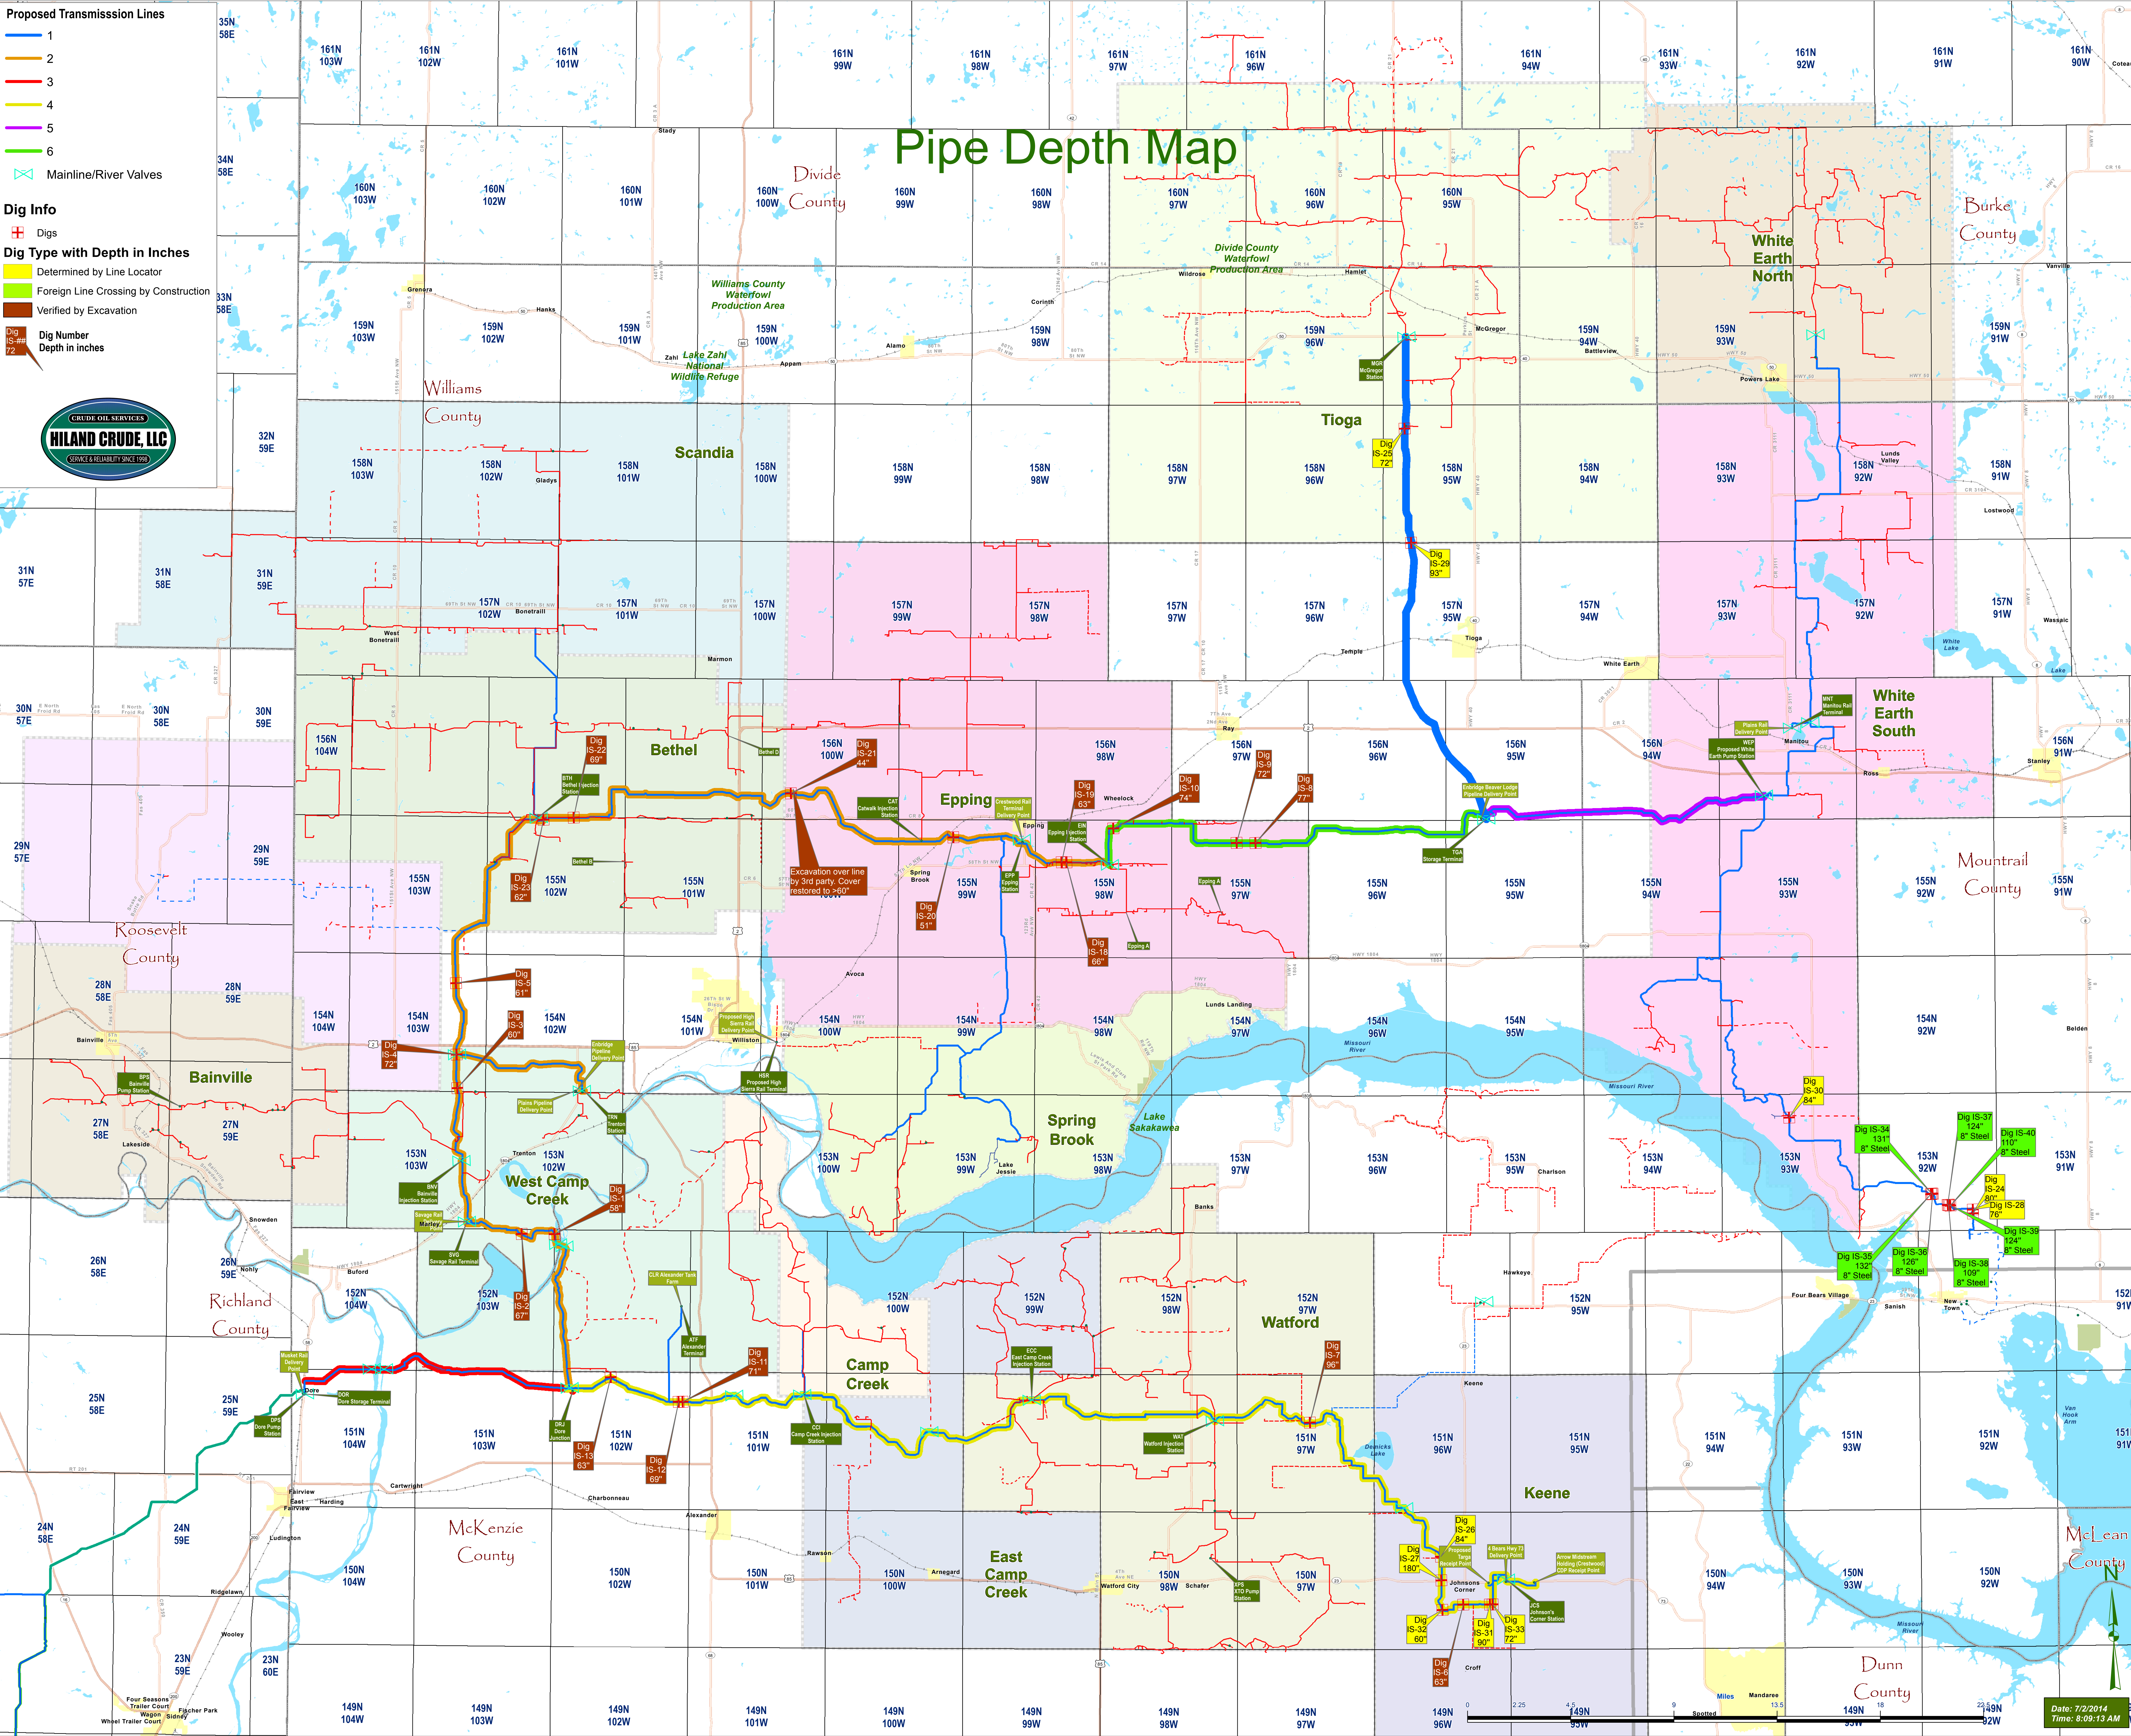

