



we are technology • broadband • voice • wireless • cameras • security • monitoring • more



April 16, 2018

North Dakota Public Service Commission
Attn: Executive Secretary
Capital Building-12th Floor
600 East Boulevard, Dept. 408
Bismarck ND 58505-0480

Re: Request for Potential Boundary Change to Serve Individuals Requesting Service from West River Telecommunications Cooperative

On March 14, 2018, West River Telecommunications Cooperative (WRT) filed a request for an exchange boundary modification with Century Link in three locations. One of those modifications was in the St. Anthony/Mandan boundary and two were in the Elgin/Morristown boundary.

WRT has removed five census blocks from the Elgin/Morristown boundary modification request and submits the attached maps to reflect that change from the original filing.

The St. Anthony/Mandan boundary modification request remains the same as the original map filed, therefore no map of this specific modification is attached to this letter.

This change to the map does not change the locations or customers impacted in the initial filing.

Sincerely,

Troy Schilling
CEO/GM
West River Telecommunications Cooperative

lal

Enclosures




6 PU-13-230 Filed: 4/19/2018 Pages: 4
Revised Exchange Boundary Maps


West River Telecommunications Cooperative


Elgin

Carson

WRT

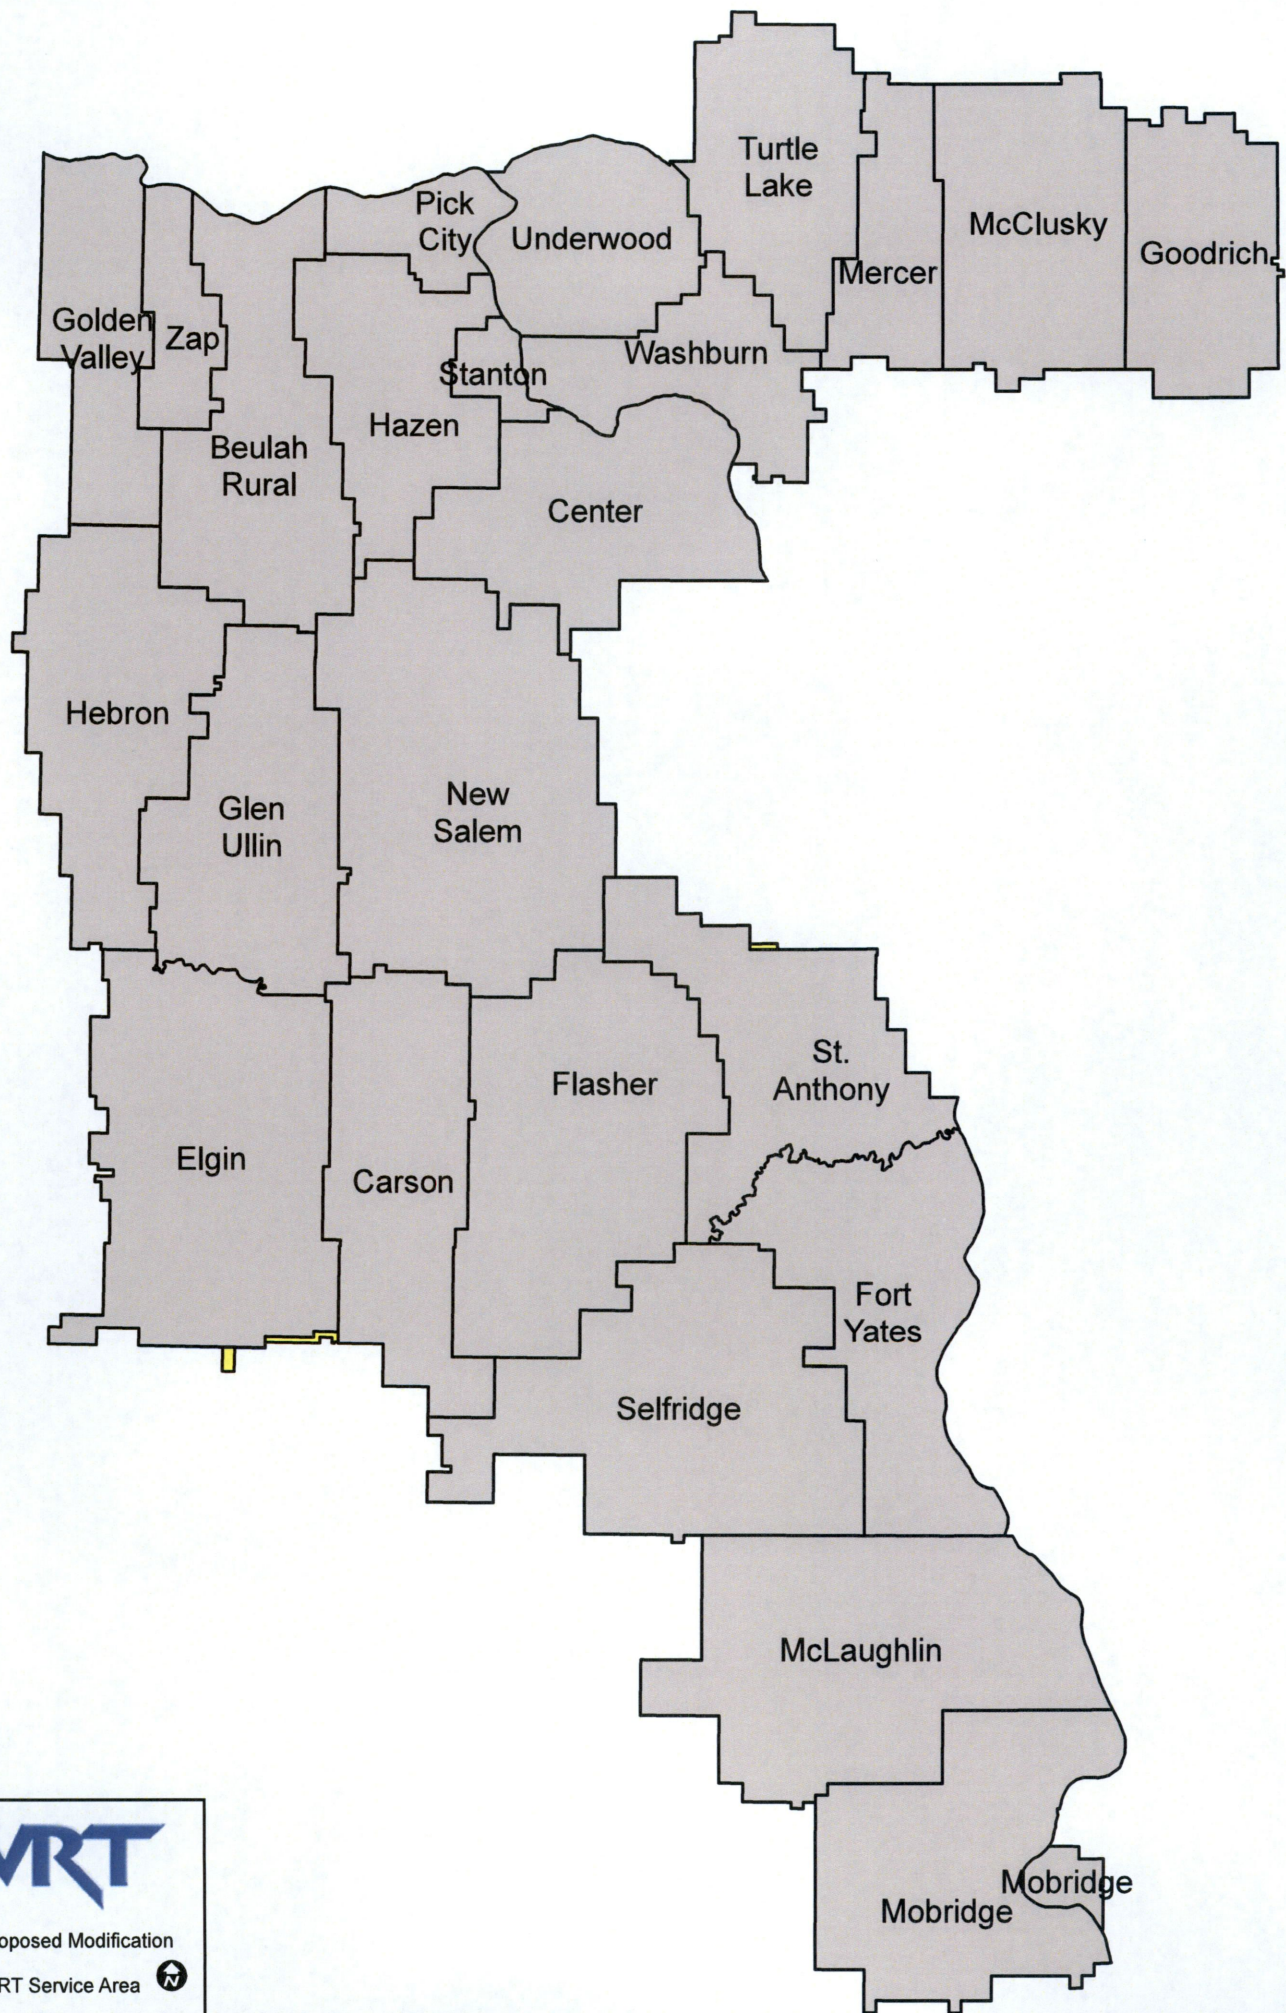

-  Proposed Modification
-  WRT Service Area 

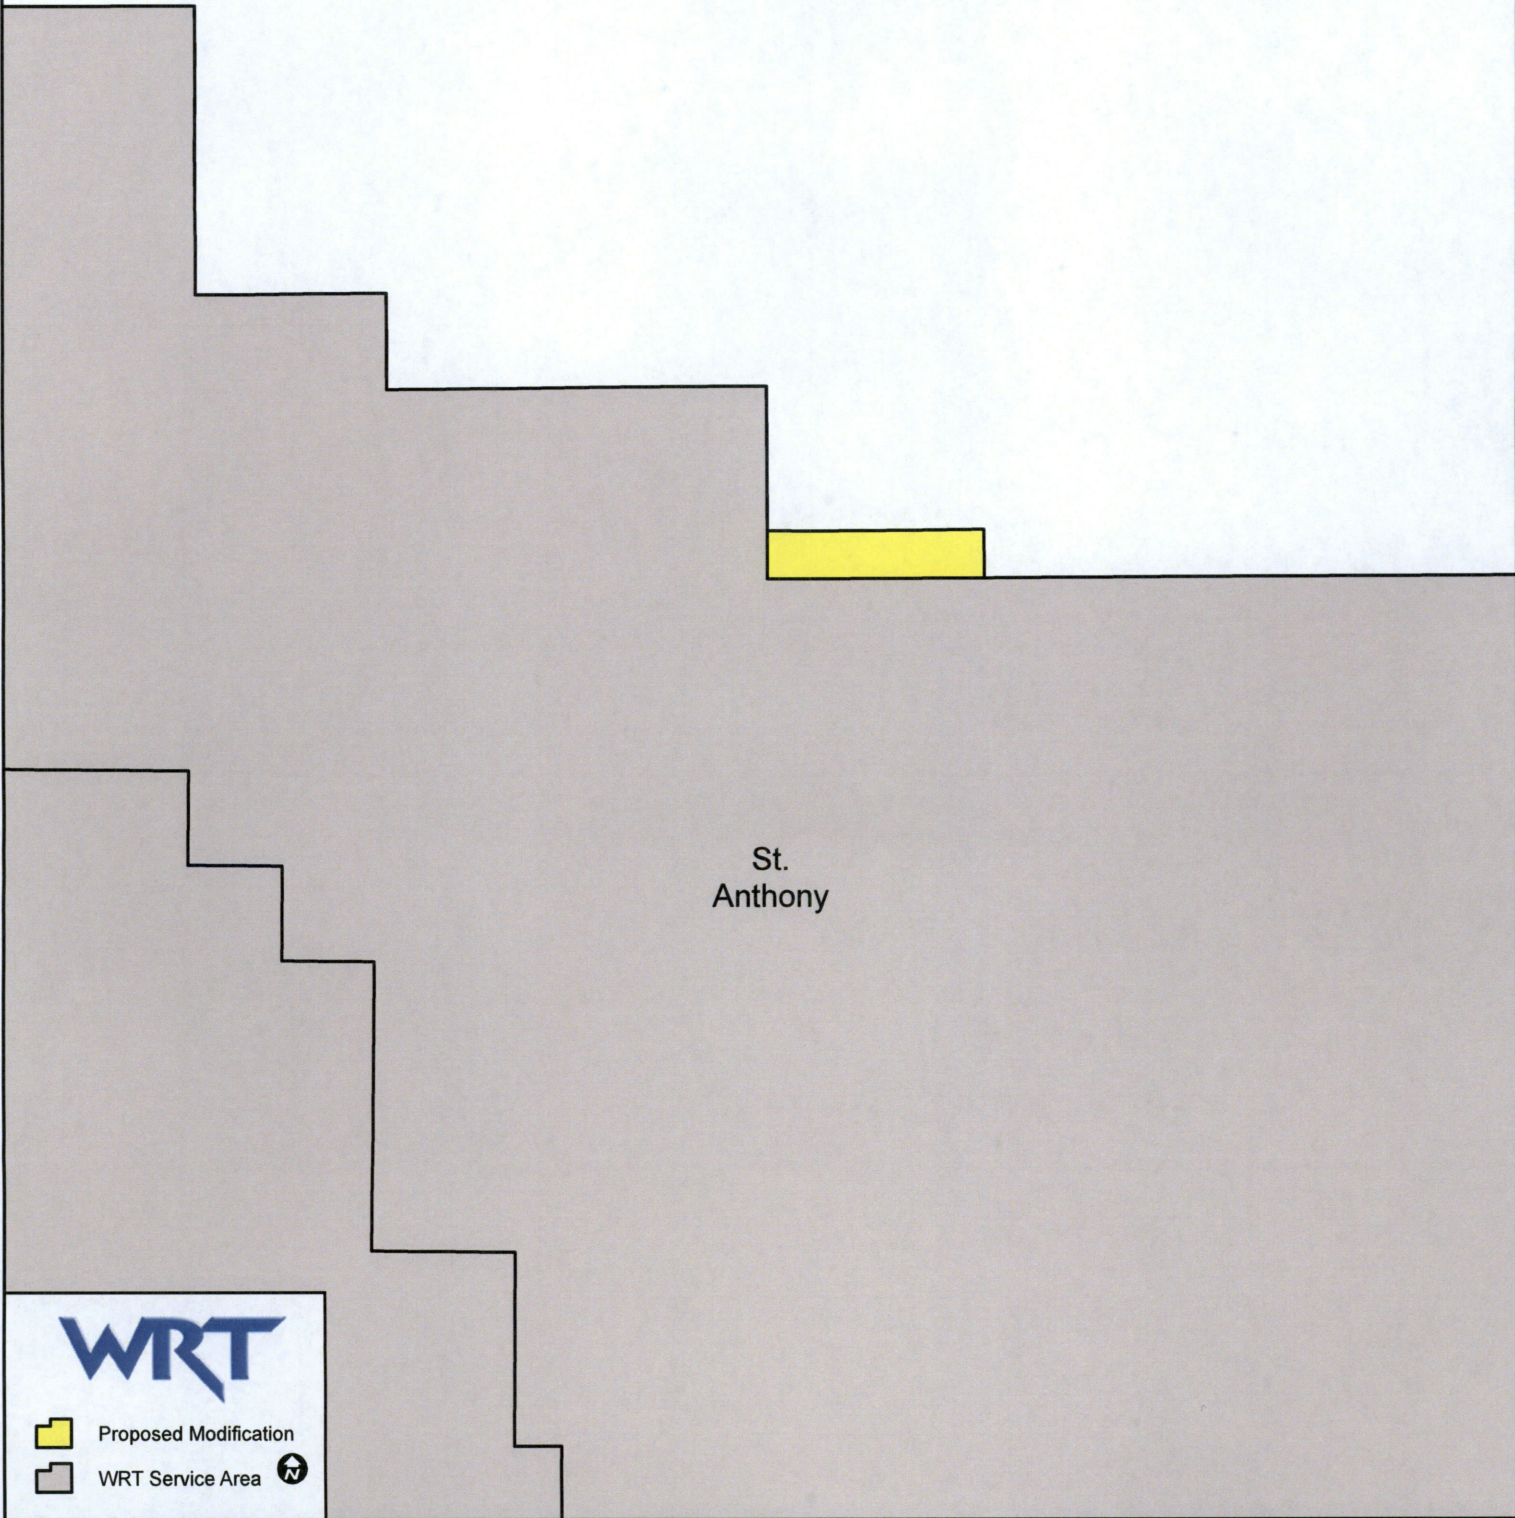



St.
Anthony

WRT

-  Proposed Modification
-  WRT Service Area 