

Exam Date:10/07/2013

Woodworth Farmers Grain Co.

Page: 1

Examiner: 1

PO Box 59

Woodworth , ND

County:

Phone: 701-752-4143

CCC Number:

Location/Container Numbers/Comments	Section	Capacity
<b>PART A - ADDITIONAL SPACE TO BE INCLUDED UNDER LICENSE</b>		
104	A	230,413
		<b>Total: 230,413</b>
<b>PART B - SPACE TO BE DELETED UNDER LICENSE</b>		
ground	A	249,808
		<b>Total: 249,808</b>
<b>PART C - ALL SPACE TO BE INCLUDED UNDER LICENSE</b>		
	A	847,000
	B	43,000
	E	34,000
		<b>Total: 924,000</b>
<b>PART D - TOTAL CAPACITY BY FUNCTIONAL UNIT</b>		
Woodworth 104	A B E	924,000
		<b>Total: 924,000</b>

### NDPSC Bin Capacity Chart

Exam Date:10/07/2013

Woodworth Farmers Grain Co.

Examiner: 1

PO Box 59  
Woodworth, ND  
County:

Status	Section	Bin Number	Bin Type	Base Point	Diameter or Bu/Ft (Irreg).	Length	Width	Side wall	Add for Hopper	Ded. for Obst.	Effective Depth	Add for Peak	Depth for Capac.	Bushels per Foot	Base Pack%	Bushel Capacity with Pack
--------	---------	------------	----------	------------	-------------------------------	--------	-------	--------------	----------------------	----------------------	--------------------	--------------------	------------------------	------------------------	---------------	------------------------------

## Facility: Woodworth

### Section: A

A	001	Square	bin floor		0.000	13.30	4.200	42.00	0.00	0.00	42.000	0.000	42.0	44.9	3.50	1,952
A	002	Square	bin floor		0.000	8.600	4.800	48.00	0.00	0.00	48.000	0.000	48.0	33.2	2.50	1,634
A	003	Square	bin floor		0.000	8.600	4.800	48.00	0.00	0.00	48.000	0.000	48.0	33.2	2.50	1,634
A	004 T	Square	bin floor		0.000	9.700	4.500	48.00	0.00	0.00	48.000	0.000	48.0	35.1	3.00	1,736
A	004 B	Square	bin floor - top 48'		0.000	13.30	9.700	21.00	0.00	0.00	21.000	0.000	21.0	103.7	6.00	2,309
A	005	Square	bin floor		0.000	13.30	9.700	69.00	0.00	0.00	69.000	0.000	69.0	103.7	6.00	7,584
A	006	Square	bin floor		0.000	13.80	9.700	47.50	0.00	0.00	47.500	0.000	47.5	107.6	6.20	5,428
A	007	Square	bin floor		0.000	13.80	9.700	47.50	0.00	0.00	47.500	0.000	47.5	107.6	6.20	5,428
A	008	Square	bin floor		0.000	13.30	13.30	69.50	0.00	0.00	69.500	0.000	69.5	142.2	6.80	10,555
A	009	Square	blind bin 43' below bin floor		0.000	13.30	9.700	26.80	0.00	0.00	26.800	0.000	26.8	103.7	6.00	2,946
A	010	Square	bin floor		0.000	13.30	9.700	43.00	0.00	0.00	43.000	0.000	43.0	103.7	6.00	4,727
A	011	Square	blind bin 43' below bin floor		0.000	13.30	9.700	26.80	0.00	0.00	26.800	0.000	26.8	103.7	6.00	2,946
A	012	Square	bin floor		0.000	13.30	9.700	43.00	0.00	0.00	43.000	0.000	43.0	103.7	6.00	4,727
A	013	Square	bin floor		0.000	13.80	6.600	49.50	0.00	0.00	49.500	0.000	49.5	73.2	5.50	3,822
A	014	Square	platform 19' below bin floor		0.000	13.30	6.600	29.00	0.00	0.00	29.000	0.000	29.0	70.6	5.20	2,153
A	016	Square	bin floor		0.000	13.80	13.30	47.50	0.00	0.00	47.500	0.000	47.5	147.5	6.80	7,482
A	017	Square	bin floor		0.000	13.30	9.300	43.00	0.00	0.00	43.000	0.000	43.0	99.4	6.00	4,530
A	018	Square	blind bin 43' below bin floor		0.000	13.30	9.300	26.80	0.00	0.00	26.800	0.000	26.8	99.4	6.00	2,824
A	019	Square	bin floor		0.000	13.30	9.900	43.00	0.00	0.00	43.000	0.000	43.0	105.8	6.20	4,831
A	020	Square	bin floor		0.000	13.80	9.200	49.50	0.00	0.00	49.500	0.000	49.5	102.1	6.00	5,357
A	021	Square	blind bin 43' below bin floor		0.000	13.30	9.900	26.80	0.00	0.00	26.800	0.000	26.8	105.8	6.20	3,011

### NDPSC Bin Capacity Chart

Exam Date:10/07/2013

Woodworth Farmers Grain Co.

Examiner: 1

PO Box 59  
Woodworth, ND  
County:

Status	Section	Bin Number	Bin Type	Base Point	Diameter or Bu/Ft (Irreg.) Length	Width	Side wall	Add for Hopper	Ded. for Obst.	Effective Depth	Add for Peak	Depth for Capac.	Bushels per Foot	Base Pack%	Bushel Capacity with Pack
--------	---------	------------	----------	------------	---	-------	--------------	----------------------	----------------------	--------------------	--------------------	------------------------	------------------------	---------------	------------------------------

## Facility: Woodworth

### Section: A

A	022	Square	bin floor		0.000	13.80	9.300	49.50	0.00	0.00	49.500	0.000	49.5	103.2	6.00	5,414
A	023	Square	bin floor		0.000	13.30	13.30	69.00	0.00	0.00	69.000	0.000	69.0	142.2	6.80	10,479
A	024	Square	bin floor		0.000	13.80	9.900	47.50	0.00	0.00	47.500	0.000	47.5	109.8	6.20	5,539
A	025	Square	bin floor		0.000	13.30	9.900	69.00	0.00	0.00	69.000	0.000	69.0	105.8	6.20	7,753
A	026 T	Square	bin floor		0.000	9.300	4.500	48.00	0.00	0.00	48.000	0.000	48.0	33.6	2.50	1,653
A	026 B	Square	bin floor - top 48'		0.000	13.30	9.300	22.00	0.00	0.00	22.000	0.000	22.0	99.4	6.00	2,318
A	027	Square	bin floor		0.000	8.600	4.500	48.00	0.00	0.00	48.000	0.000	48.0	31.1	2.50	1,530
A	028	Square	bin floor		0.000	8.600	4.500	48.00	0.00	0.00	48.000	0.000	48.0	31.1	2.50	1,530
A	029	Square	bin floor		0.000	13.30	4.500	42.00	0.00	0.00	42.000	0.000	42.0	48.1	4.20	2,105
A	101	Peaked	top of sidewall		36.300	0.000	0.000	61.40	0.00	0.00	61.400	2.200	63.6	831.9	10.0	58,200
A	102	Peaked	top of sidewall		42.700	0.000	0.000	58.20	0.00	0.00	58.200	2.600	60.8	1151.1	10.0	76,986
A	103	Peaked	top of sidewall		55.800	0.000	0.000	54.90	0.00	0.00	54.900	3.900	58.8	1965.8	10.0	127,148
Added	A	104	Peaked	top of sidewall	72.000	0.000	0.000	59.00	0.00	0.00	59.000	5.000	64.0	3272.9	10.0	230,413
A	204	Peaked	top of sidewall		42.000	0.000	0.000	59.50	0.00	0.00	59.500	2.500	62.0	1113.7	10.0	75,954
A	205	Peaked	top of sidewall		42.000	0.000	0.000	59.50	0.00	0.00	59.500	2.500	62.0	1113.7	10.0	75,954
A	206	Peaked	top of sidewall		42.000	0.000	0.000	59.50	0.00	0.00	59.500	2.500	62.0	1113.7	10.0	75,954

Bin count: 37

Facility: Woodworth Section: A Total: **846,546**

To Even: **847,000**

Client ID: 1848

## NDPSC Bin Capacity Chart

10/07/2013 10:37:38 AM

Exam Date:10/07/2013

Woodworth Farmers Grain Co.

Page: 3

Examiner: 1

PO Box 59  
Woodworth , ND  
County:

Status	Section	Bin Number	Bin Type	Base Point	Diameter or Bu/Ft (Irreg.)   Length	Width	Side wall	Add for Hopper	Ded. for Obst.	Effective Depth	Add for Peak	Depth for Capac.	Bushels per Foot	Base Pack%	Bushel Capacity with Pack
--------	---------	------------	----------	------------	--	-------	--------------	----------------------	----------------------	--------------------	--------------------	------------------------	------------------------	---------------	------------------------------

## Facility: Woodworth

### Section: B

B	100	Quonset	get dimensions		0.000	41.50	49.50	12.00	0.00	0.00	12.000	0.000	12.0	1584.1	10.0	20,911
B	200	Quonset	get dimensions		0.000	41.50	50.50	12.00	0.00	0.00	12.000	0.000	12.0	1618.9	10.0	21,370
<b>Bin count:</b>		<b>2</b>														
<b>Facility: Woodworth Section: B Total:</b>														<b>42,281</b>		
<b>To Even:</b>														<b>43,000</b>		

### Section: E

E	001	Peaked	Store King		13.500	0.000	0.000	10.00	2.00	0.00	12.000	0.800	12.8	115.1	5.20	1,550
E	002	Peaked	Lorrich		14.000	0.000	0.000	15.00	2.00	0.00	17.000	0.800	17.8	123.7	5.50	2,323
E	003	Peaked	Lorrich		14.000	0.000	0.000	15.00	2.00	0.00	17.000	0.800	17.8	123.7	5.50	2,323
E	004	Peaked	Store King		15.500	0.000	0.000	15.00	2.30	0.00	17.300	0.900	18.2	151.7	5.50	2,913
E	005	Peaked	Store King		15.500	0.000	0.000	15.00	2.30	0.00	17.300	0.900	18.2	151.7	5.50	2,913
E	006	Peaked	Lorrich		16.000	0.000	0.000	25.00	2.60	0.00	27.600	1.000	28.6	161.6	5.80	4,890
E	007	Peaked	Lorrich		16.000	0.000	0.000	25.00	2.60	0.00	27.600	1.000	28.6	161.6	5.80	4,890
E	008	Peaked	Meridian		16.000	0.000	0.000	30.00	2.60	0.00	32.600	1.000	33.6	161.6	5.80	5,745
E	009	Peaked	Meridian		16.000	0.000	0.000	30.00	2.60	0.00	32.600	1.000	33.6	161.6	5.80	5,745
<b>Bin count:</b>		<b>9</b>														
<b>Facility: Woodworth Section: E Total:</b>														<b>33,292</b>		
<b>To Even:</b>														<b>34,000</b>		

**Overall Licensed Bin Capacity for:**

Woodworth Farmers Grain Co.

Bin count: 48

**Licensed Capacity:**  
(includes pack)


**922,119 Bu.**

---

**Licensed Capacity (to even):**  
(includes pack and section totals are  
rounded up to next highest 1000)


**924,000 Bu.**

---

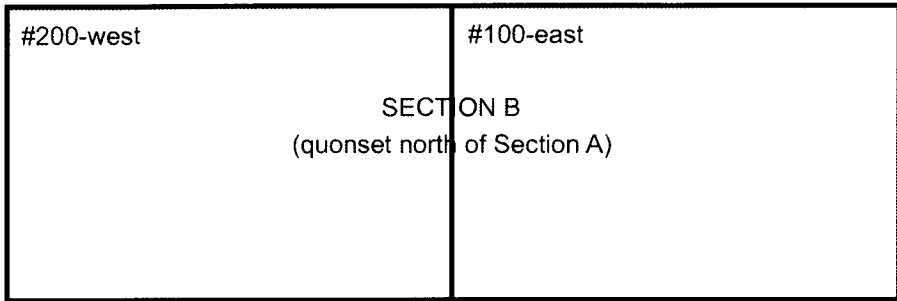


WOODWORTH FARMER GRAIN COMPANY

WOODWORTH N.D.

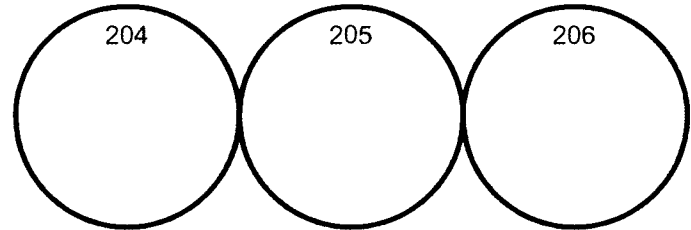

SECTION A

RRV& W RAIL

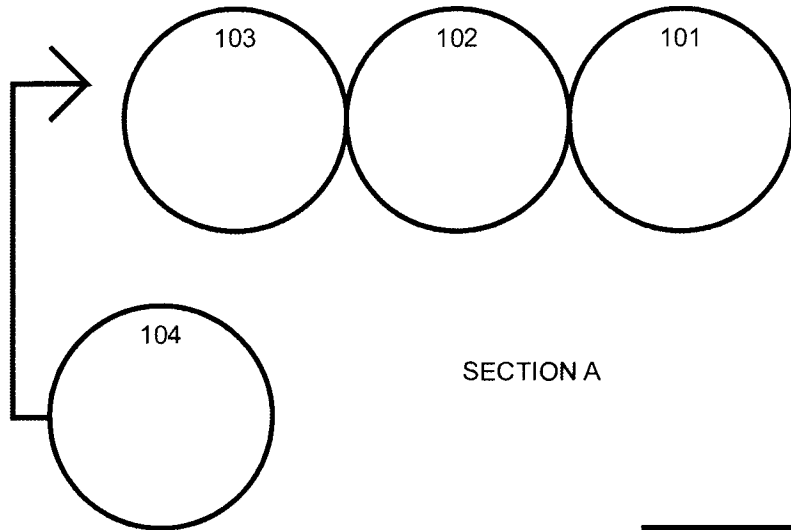


SECTION A

019	017	XX	014	012	010	008
021	018	XX		011	009	
024	022	020	013	006	007	016
025	026	029	X	001	004	005
	27	28	X		2	3

driveway



SECTION A

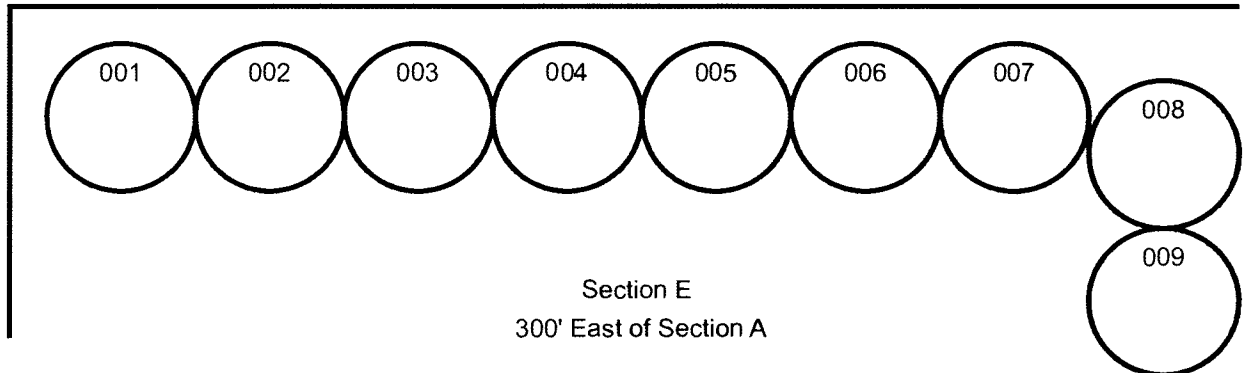

Section E  
300' East of Section A