

March 20, 2014

VIA HAND DELIVERY

Mr. Darrell Nitschke
Executive Secretary
North Dakota Public Service Commission
600 E. Boulevard, Dept. 408
Bismarck, ND 58505-0480



**RE: BAKKEN OIL EXPRESS PIPELINE
CRUDE OIL PIPELINE — DUNN AND
STARK COUNTIES
CASE NUMBER PU-13-825**

Dear Mr. Nitschke:

Enclosed for filing, please find an original and ten (10) copies of the following replacement documents of Bakken Oil Express Pipeline, LLC (“BOE”) pursuant to Section 49-22-16.3(3) and the Certification Related to Order Provisions in the above-referenced matter:

1. Certification of John Wadsworth regarding exclusion and avoidance areas;
2. Map depicting original route and requested reroute; and
3. Map depicting field studies conducted and incorporated into original Siting Application and reports.

This filing is intended to replace the March 19, 2014 filing. Also enclosed is a CD containing the above-referenced documents in PDF format.

As shown in the third attached item (“Map depicting field studies conducted and incorporated into original Siting Application and reports”), field studies were conducted in summer and fall 2013 on a variety of potential 200-foot-wide corridors, to prepare for potential route changes that seemed likely in this area. As noted in the attached documents, the results of these field studies are incorporated into the Siting Application filed with the Commission on October 4, 2013, as well as in the Cultural Report filed with the Commission on October 25, 2013. Finally, please note that the Certification of John Wadsworth is a copy. The original executed documents will be forwarded shortly.

73 PU-13-825 Filed 03/20/2014 Pages: 6
Amended certification and documentation for route adjustments under NDCC 49-22-16.3
Bakken Oil Express, LLC
Jillian Rupnow, Fredrikson&Byron, P.A.

45272844_1.DOCX

If you should have any questions, please advise.

Sincerely,


JILLIAN RUPNOW

Enclosures

BEFORE THE PUBLIC SERVICE COMMISSION
OF THE STATE OF NORTH DAKOTA

**Bakken Oil Express Pipeline, LLC
Crude Oil Pipeline — Dunn and Stark Counties
Siting Application**

CASE NO. PU-13-825

Certification of John Wadsworth

STATE OF KANSAS

COUNTY OF SEDGWICK

John C. Wadsworth states and alleges as follows:

1. That I am the Director of Engineering and Construction of Bakken Oil Express Pipeline, LLC (“BOE”) with the authority to bind BOE to the statements set forth in this Certification.
2. That I submit this Certification in support of BOE’s request for an amended Certificate of Corridor Compatibility and Route Permit, filed in the above-captioned matter.
3. That on October 4, 2013, BOE filed its Combined Certificate of Corridor Compatibility and Route Permit Application (“Siting Application”) with the North Dakota Public Service Commission (“Commission”).
4. That on December 9, 2013, a public hearing was held in this matter.
5. That on December 30, 2013, the Commission issued Certificate of Corridor Compatibility Number 150 and Route Permit Number 161.
6. That a landowner, L&W Land, LLLP, (Lester and Warren Schneider) 11050 17th Street SW, Manning, ND 58642, owning land found within the Section 36, T143N, R96W requested a change in the location of the pipeline to avoid an agricultural field as depicted in the maps enclosed herewith.

7. That a landowner, Lynn Bullinger, 11426 19th Street SW, Dickinson, North Dakota 58601, owning property in Sections 2 and 11, Township 142 North, Range 96 West, requested a minor change in the location of the pipeline to avoid a fence line.

8. That no landowners on which the adjustments are to be located oppose the adjustment.

9. That no governmental entity owns an interest within the adjustment areas or has opposed the adjustments.


10. That field studies encompassing the adjustment area were previously completed, and that the results of those studies were included in BOE's Siting Application in the above-captioned matter. A map enclosed herewith shows the various 200-foot-wide corridors that were surveyed and included in the Siting Application.

11. That the requested route and corridor changes will not affect any exclusion or avoidance areas that BOE has conducted field studies to confirm the same, and that the results of those studies have been previously filed with the Commission and provided to applicable state and federal agencies.

12. That the requested reroutes that are outside the previously approved corridor are less than one and one-half miles long, as shown in the map enclosed herewith.


13. That BOE will continue to comply with the Commission's order, laws, and rules designating the corridor and route.

BAKKEN OIL EXPRESS PIPELINE, LLC





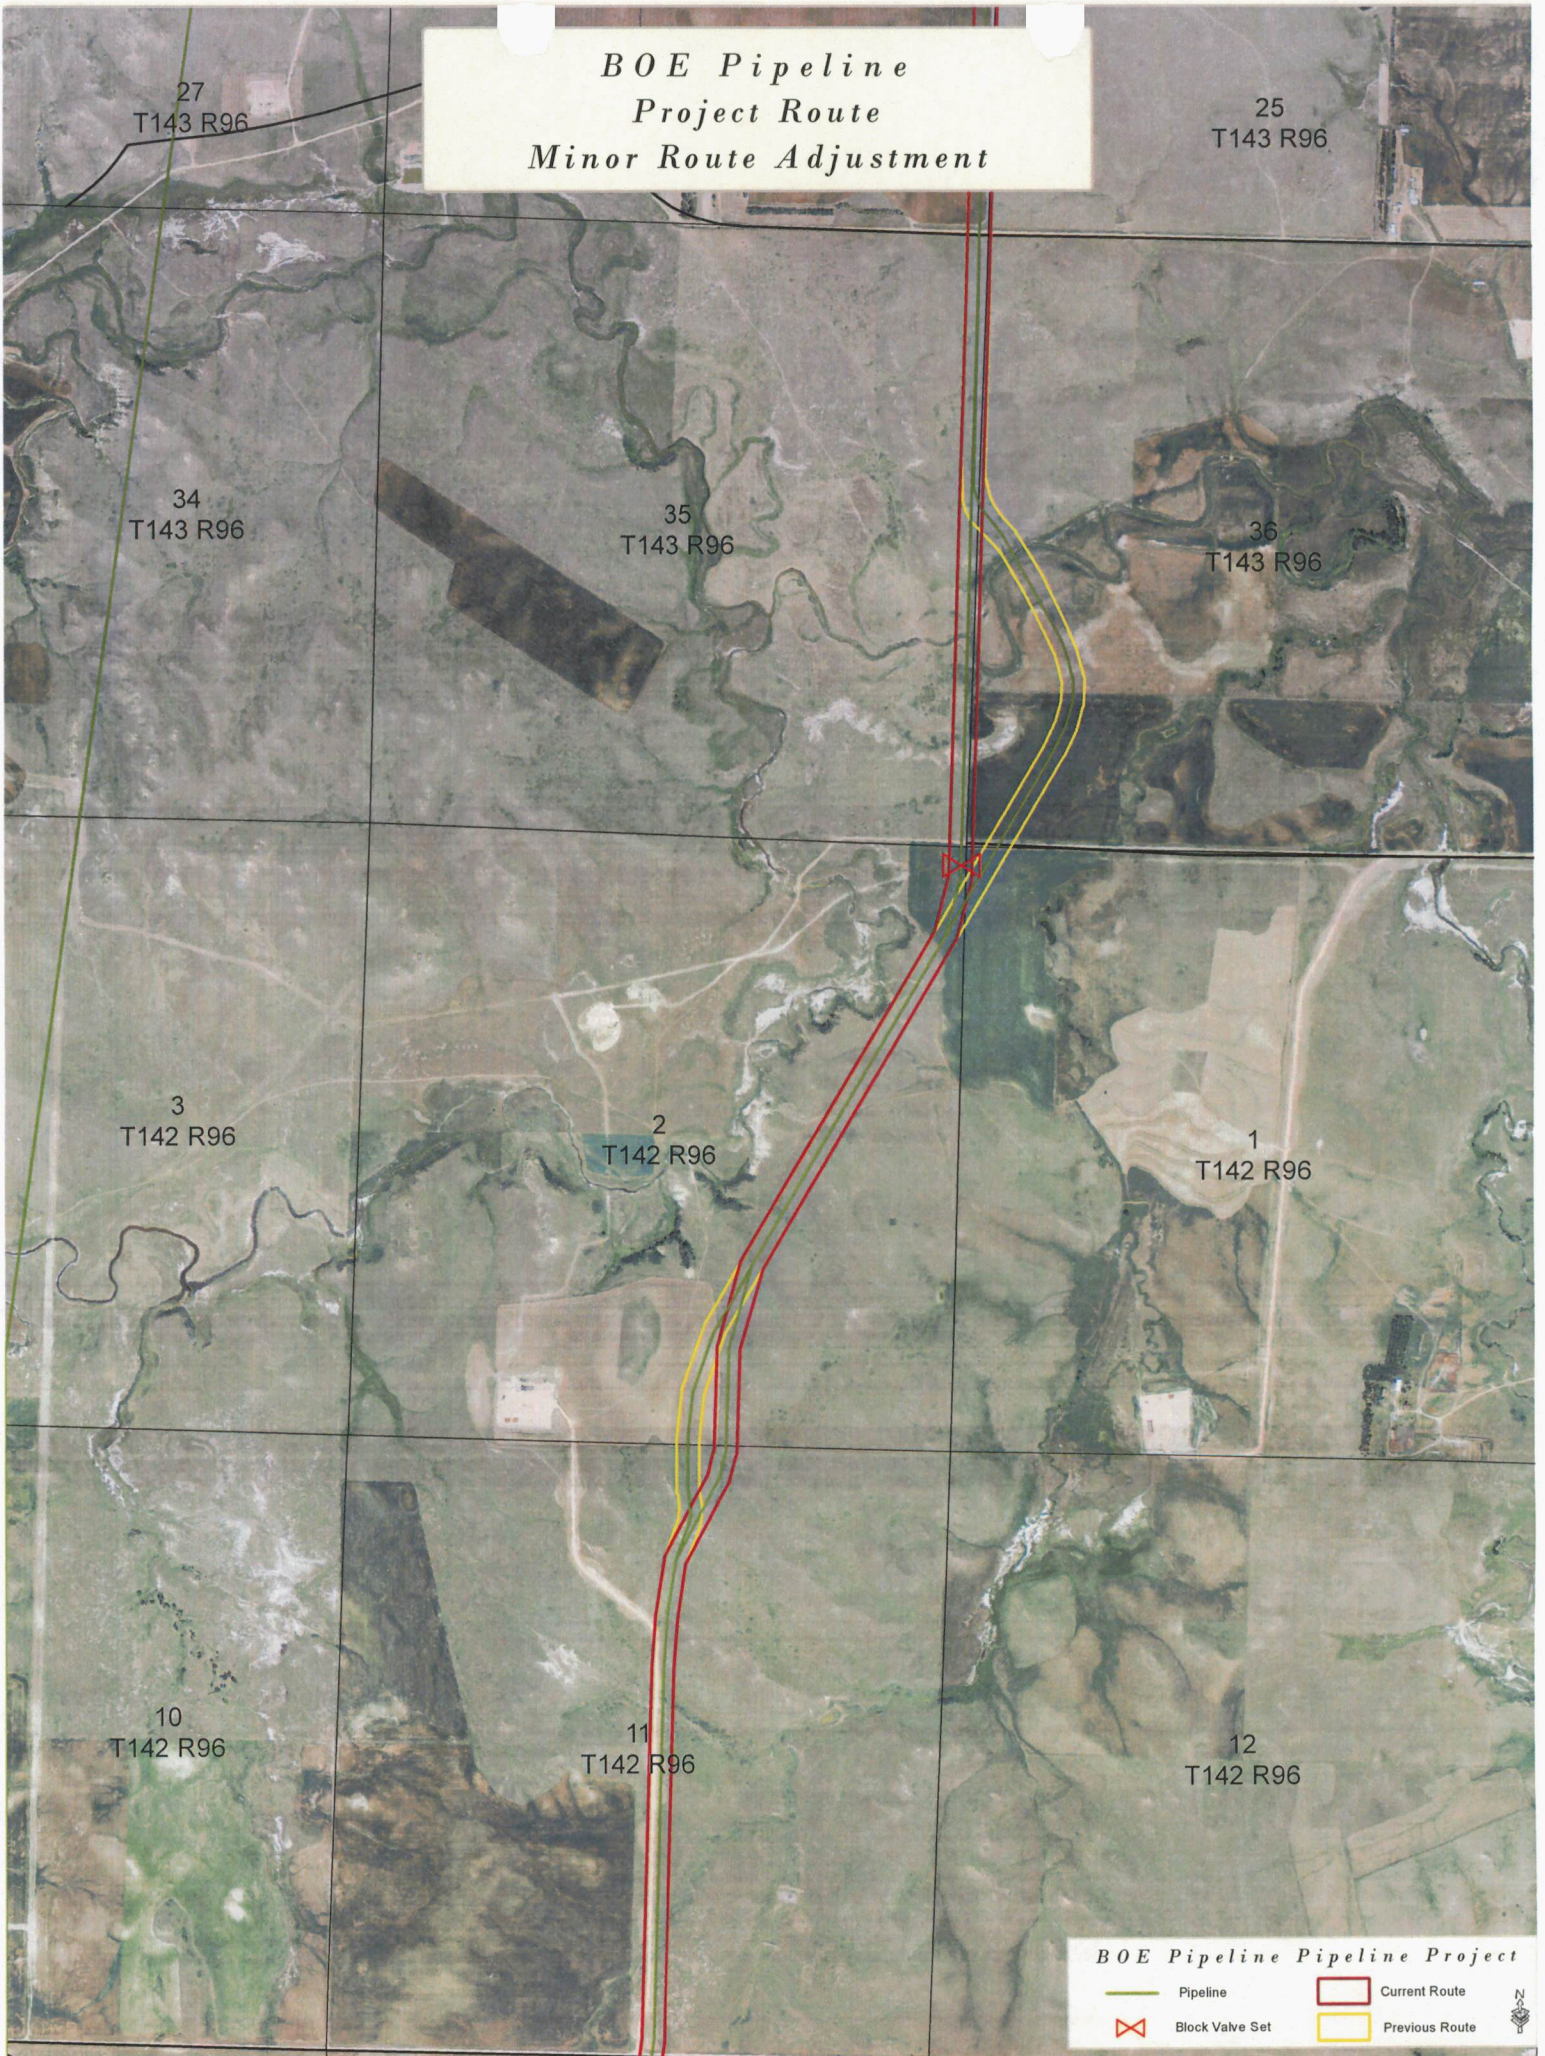

John C. Wadsworth

*BOE Pipeline
Project Route
Minor Route Adjustment*



BOE Pipeline Pipeline Project

-  Pipeline
-  Current Route
-  Block Valve Set
-  Previous Route



