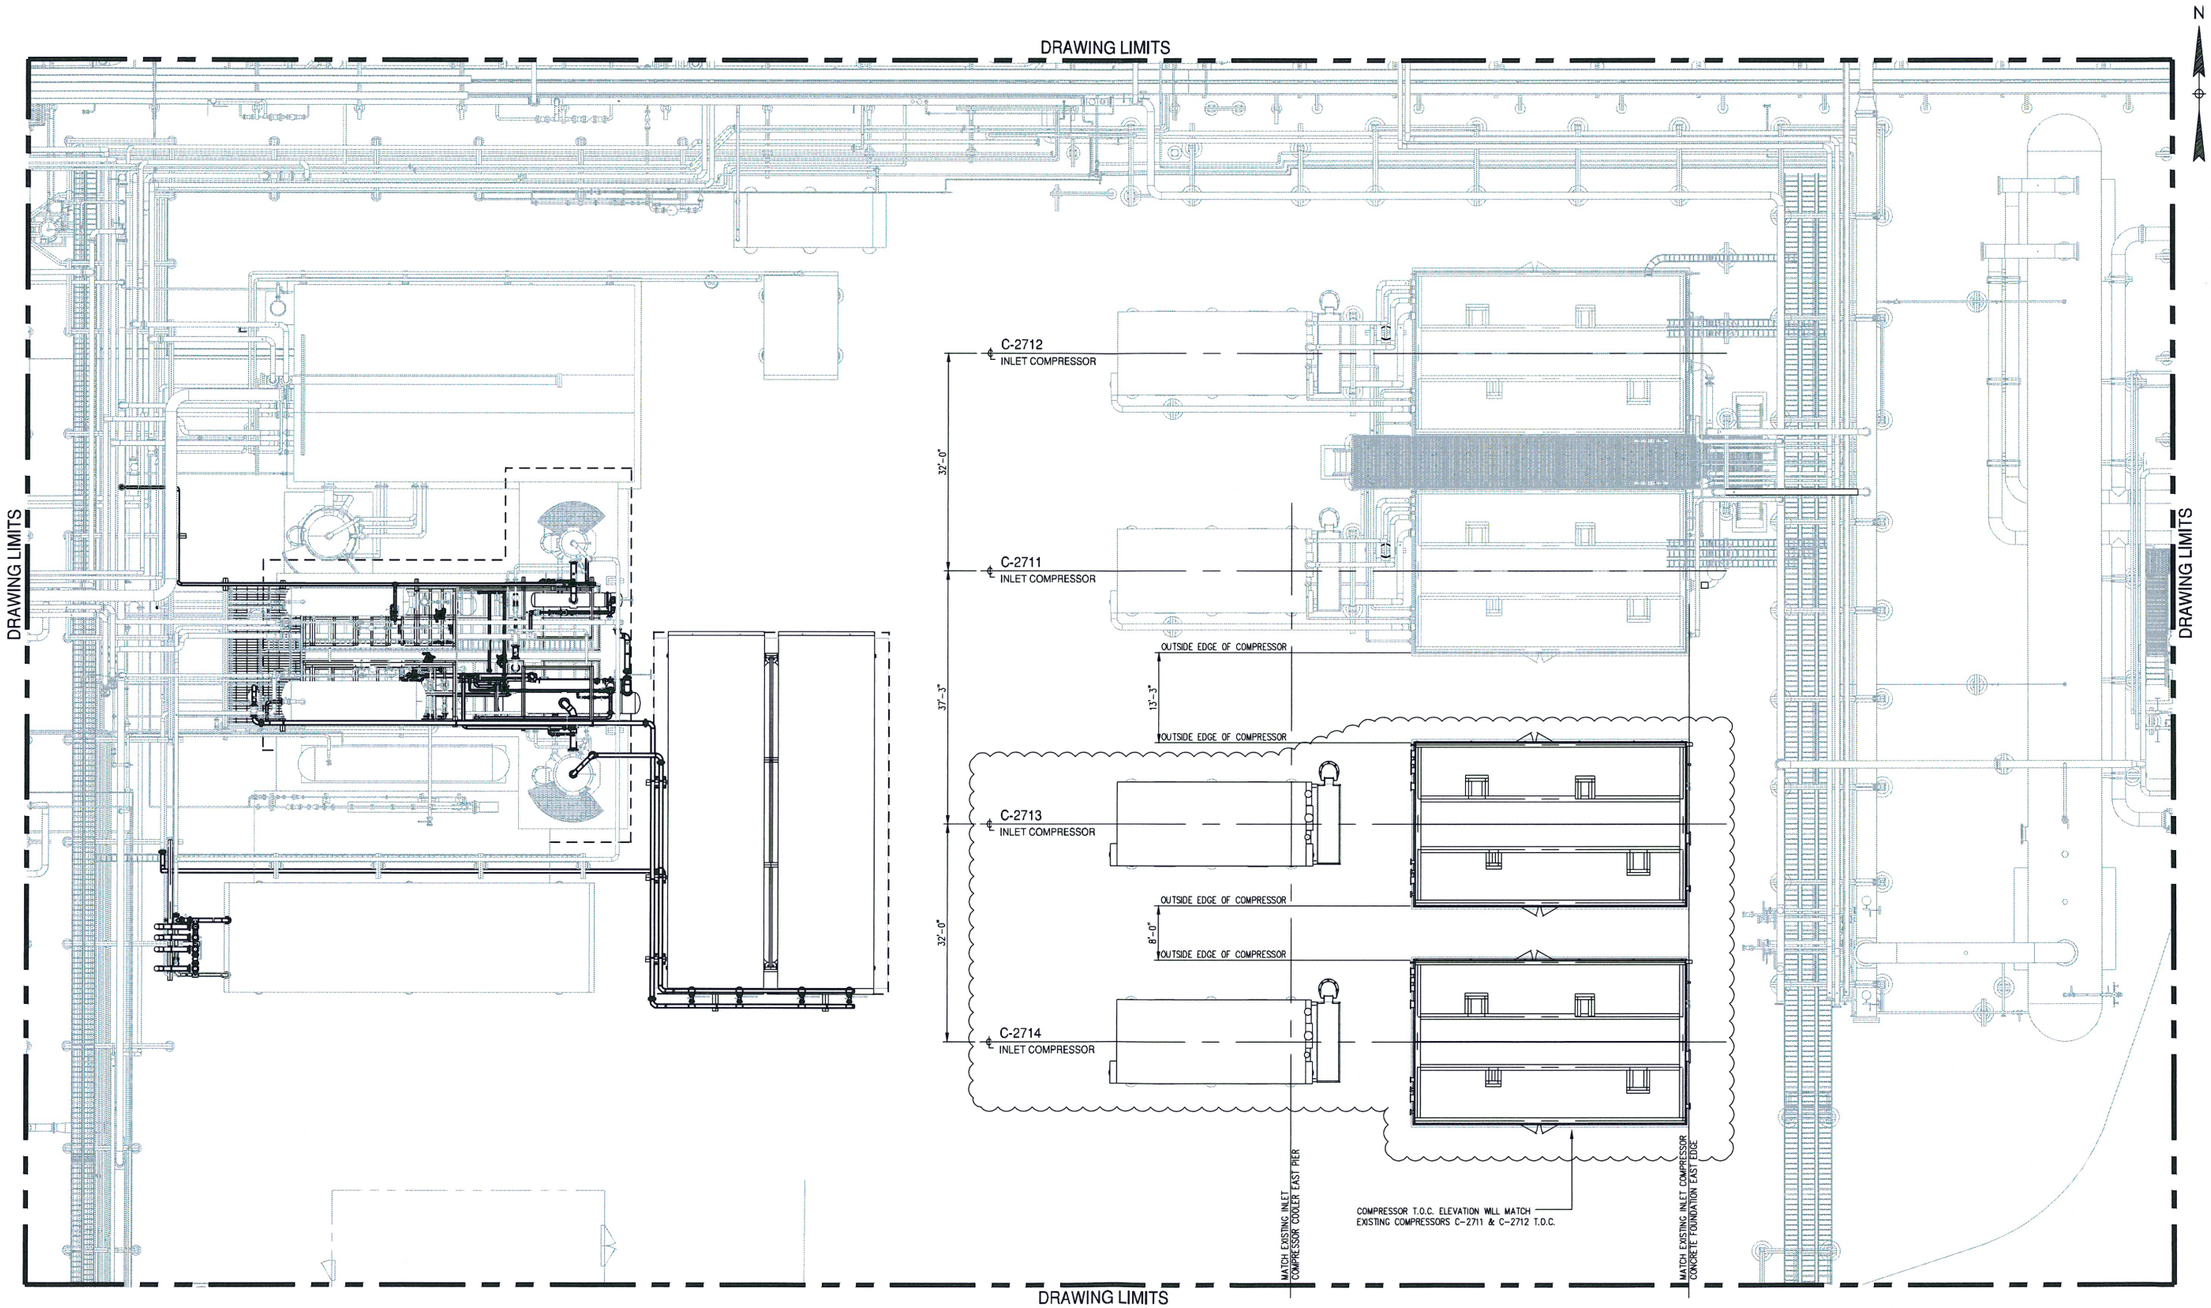

STV|GWD

621 17th St, Denver, CO | 303-951-9300

NOTES:
1. FIELD VERIFY ALL DIMENSIONS PRIOR TO CONSTRUCTION.

REFERENCE DRAWINGS	No	REVISIONS	BY	CHKD	PM	DATE
	A	ISSUED FOR REVIEW	CDH			7/30/14

Whiting Petroleum Corporation

Mountrail County, North Dakota

ROBINSON LAKE PLANT – 2014 INLET COMPRESSION EXPANSION
INLET COMPRESSION AREA
PLOT PLAN

FILE NUMBER	DRAWING NUMBER	SCALE	REVISION
RL14CMP-PP-3000	RL14CMP-PP-3001	1"=10'-0"	A