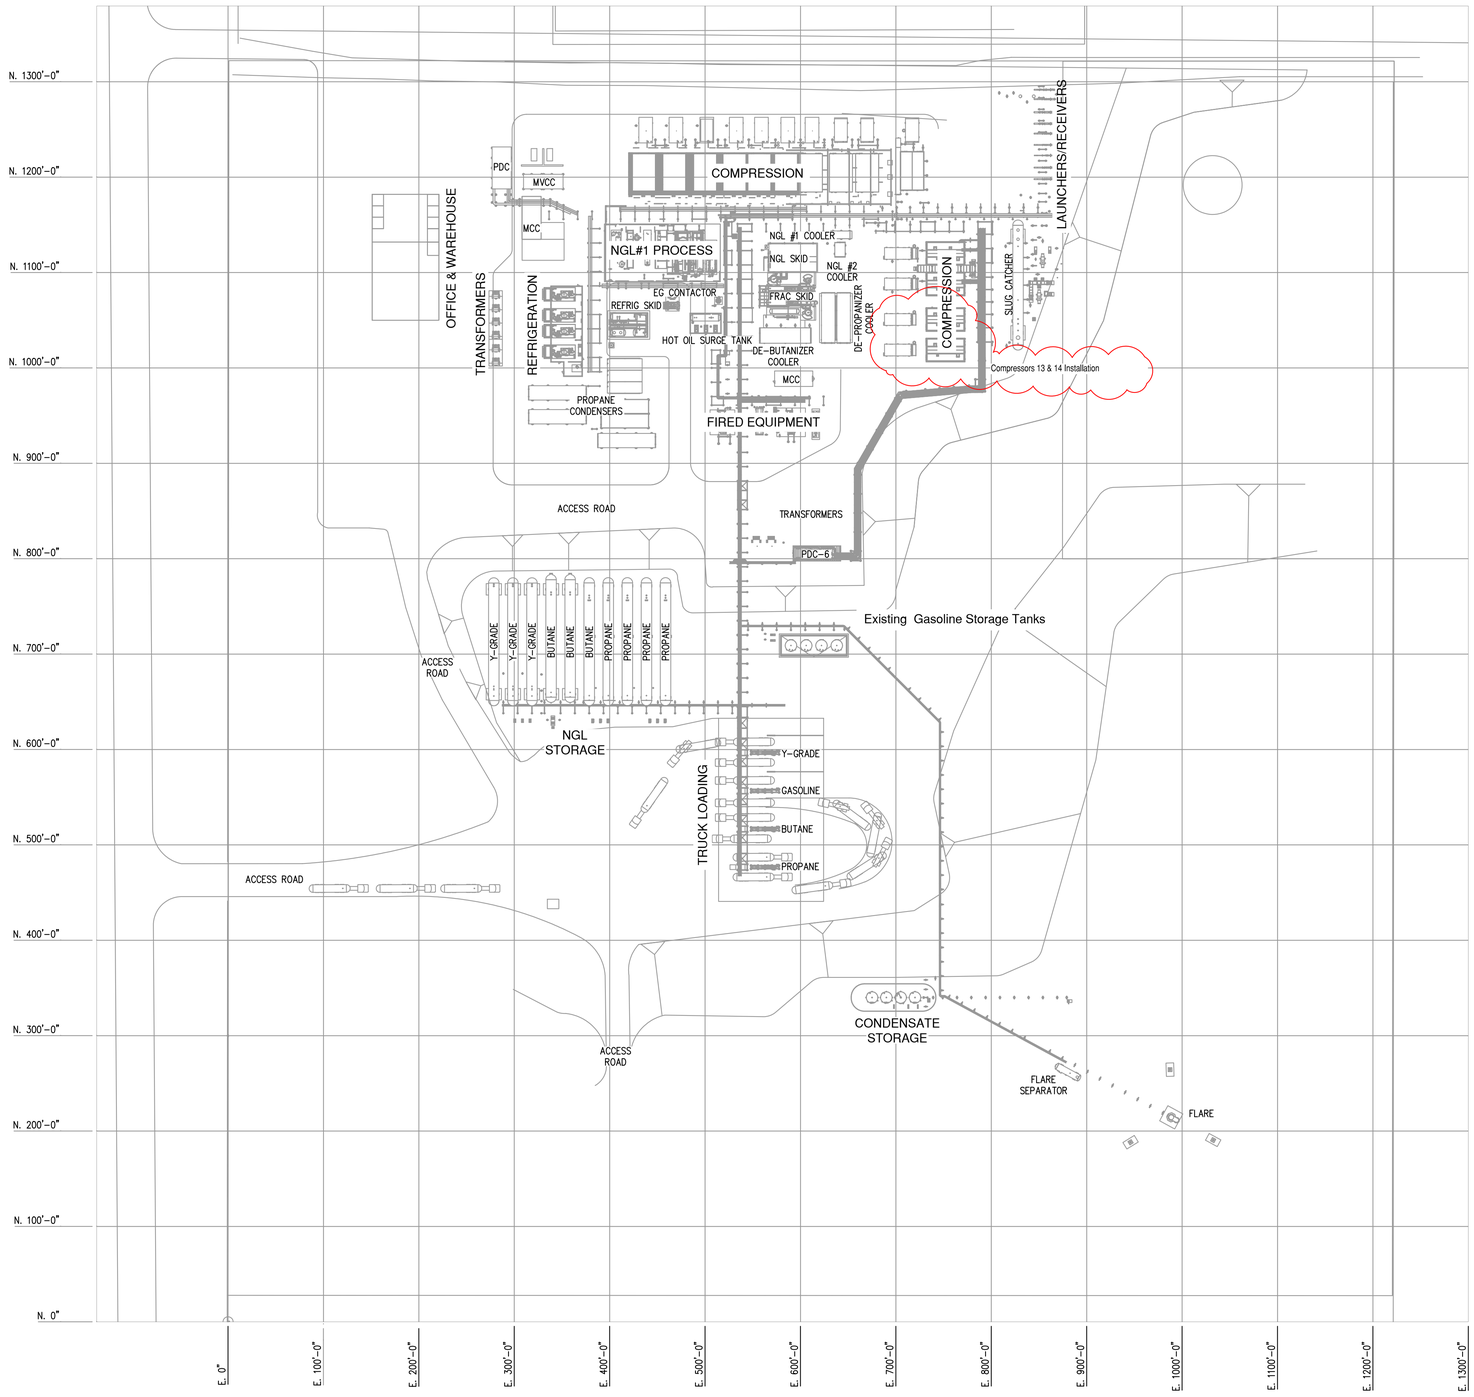

STV|GWD

621 17th St, Denver, CO | 303-951-9300

REFERENCE DRAWINGS		No	REVISIONS	BY	CHKD	PM	DATE
		A	ISSUED FOR REFERENCE	CDH	–	–	2/27/15

Whiting Petroleum Corporation

Mountrail County, North Dakota

ROBINSON LAKE GAS PLANT

PLOT PLAN

PROJ. NUMBER	DRAWING NUMBER	SCALE	REVISION
RL-PP-3000	RL-PP-3000	1"=75'	A