



Total Length of Adjustment: 23,446 ft
Length Outside Corridor: 18,309 ft

C G
 F
 E
 D
 C


Red Centerline ○ Mile Posts
Adjustment Fish & Wildlife Service Basin
Wetland Reserve Program - Easement Area Exclusion Areas
North Dakota Pipeline Company LLC

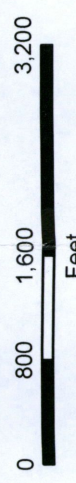

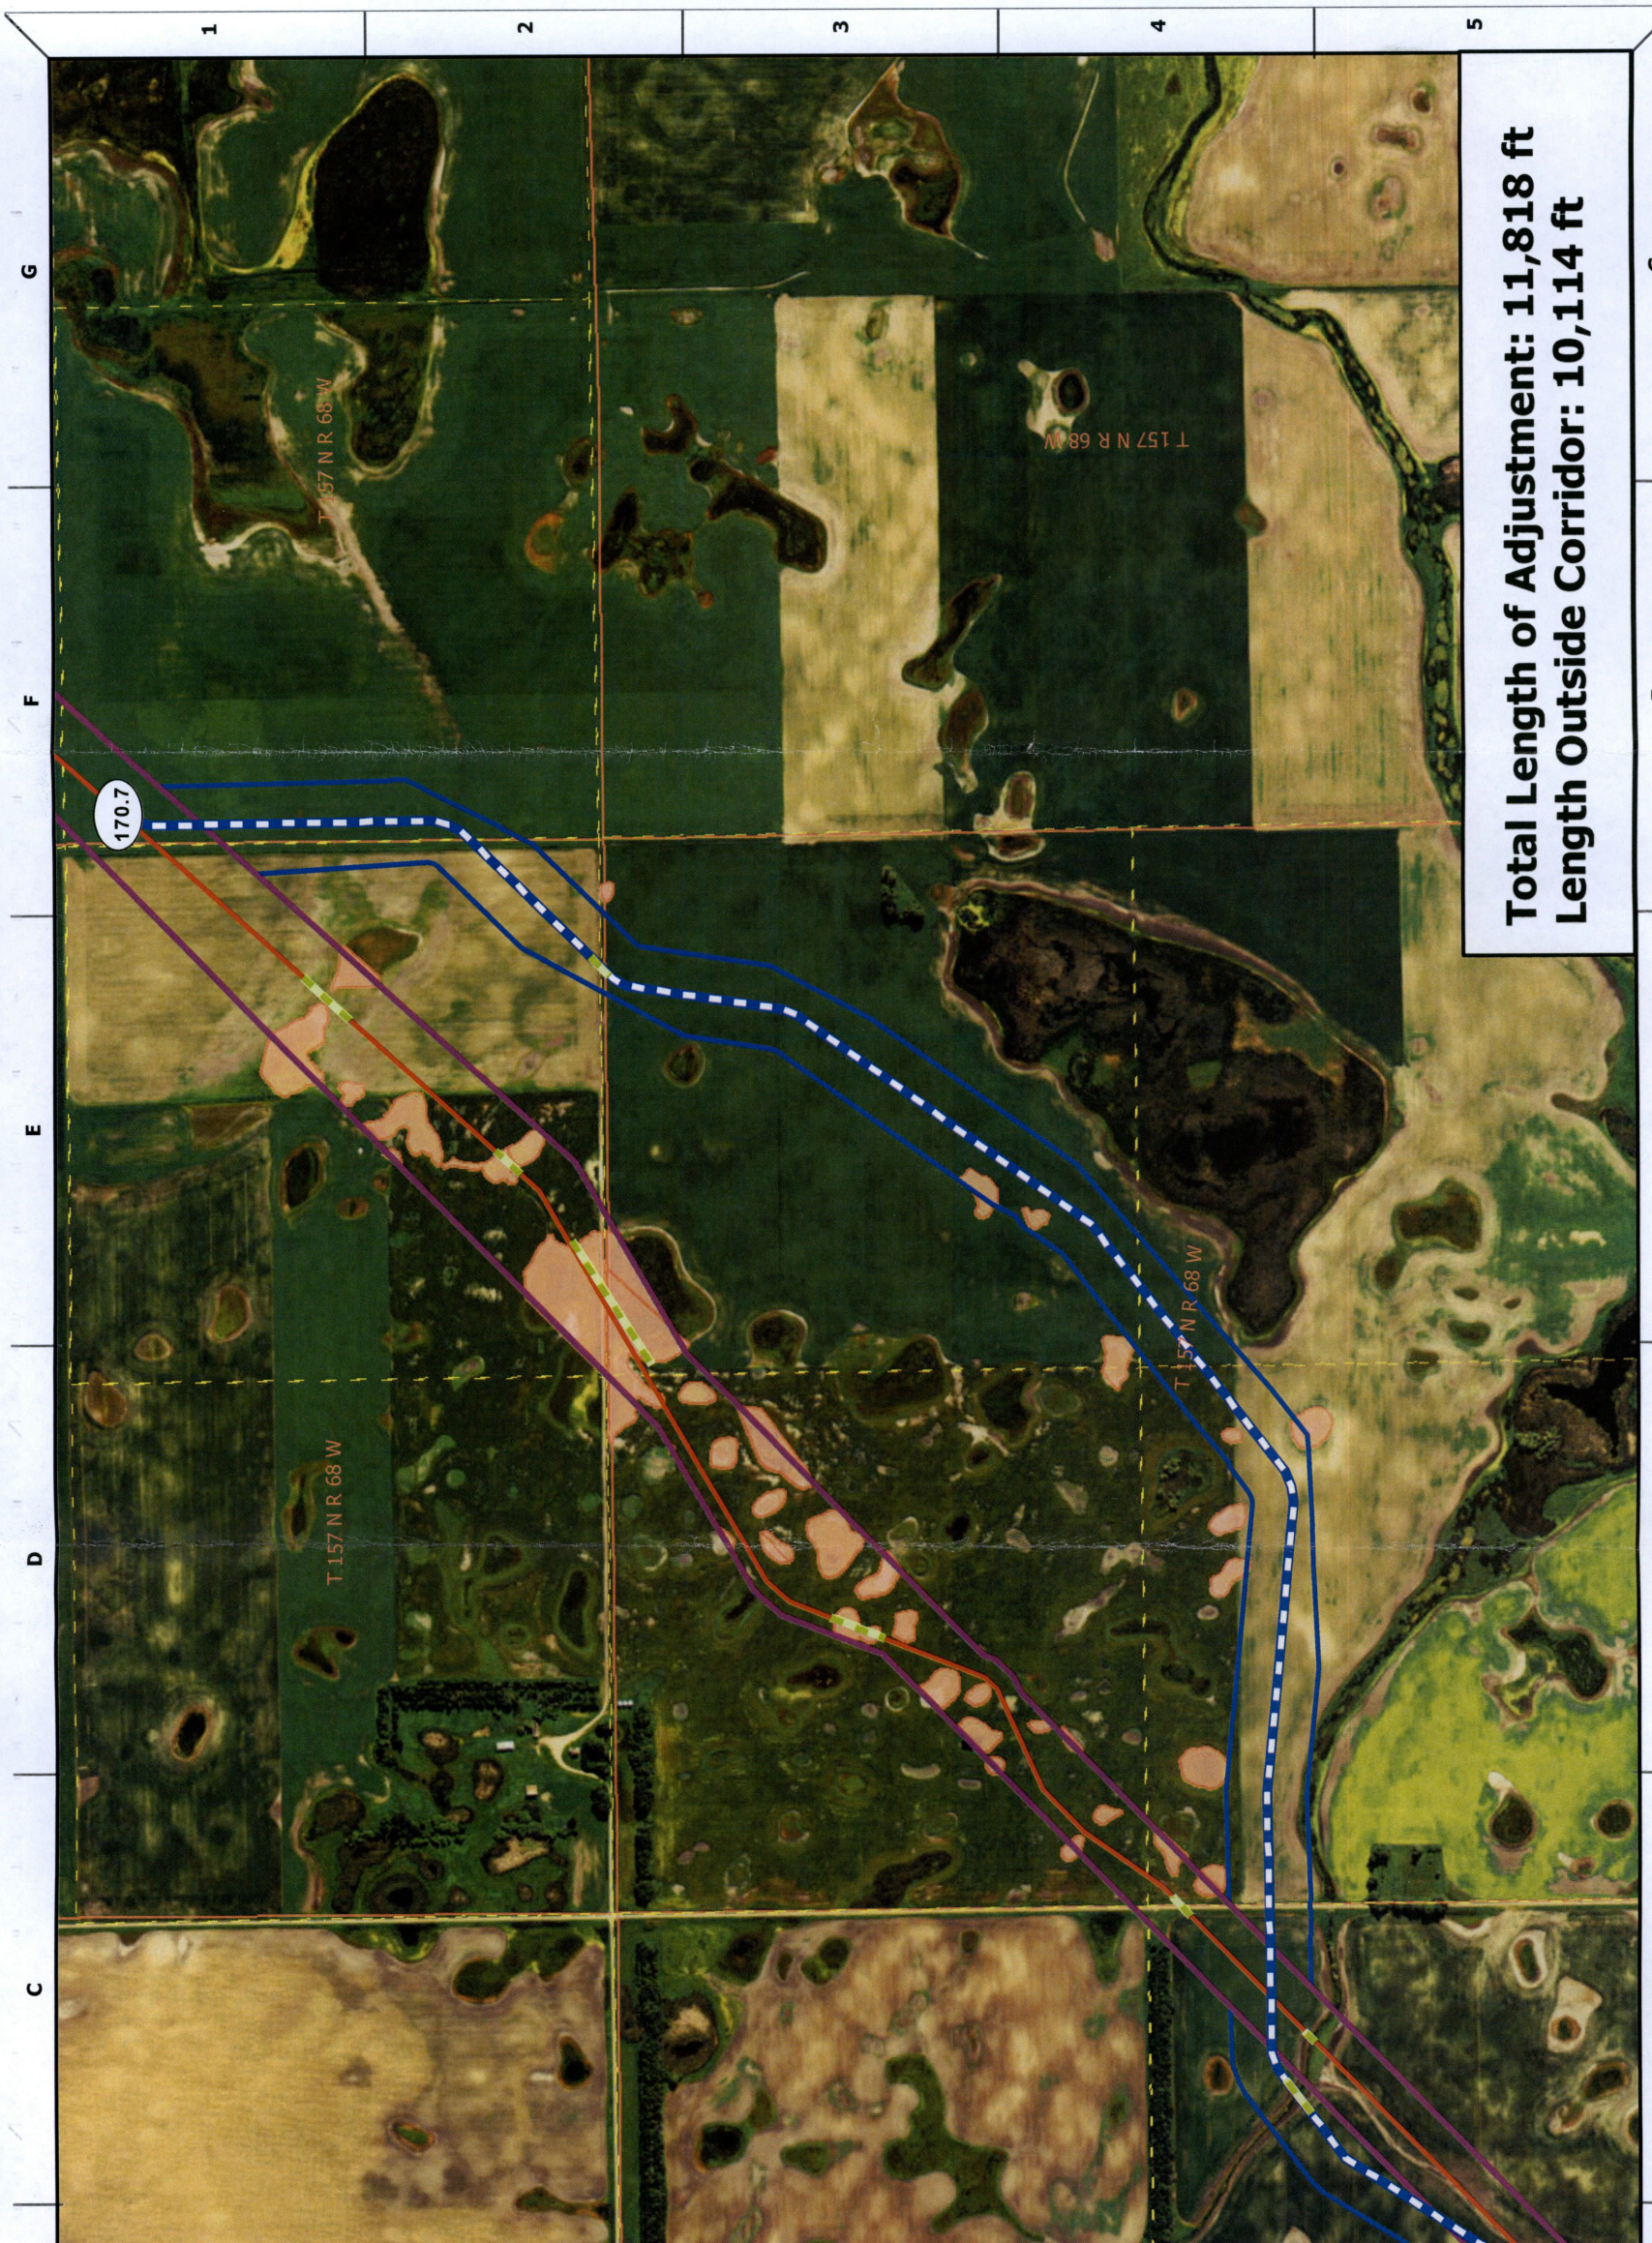

Total Length of Adjustment: 11,818 ft
Length Outside Corridor: 10,114 ft

**NORTH DAKOTA PIPELINE
 COMPANY LLC**

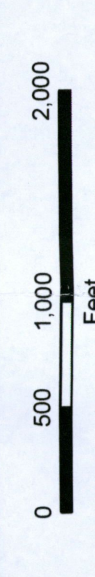

- d Centerline
- Mile Posts
- Fish & Wildlife Service Basin
- ▨ Adjustment
- ▨ Exclusion Areas