

Attn: Jerry Lein  
600 E. Boulevard, Dept. 408  
Bismarck, ND 58505-0480

Submittal via email to [ndpsc@nd.gov](mailto:ndpsc@nd.gov)  
Case Number: PU-14-105

Re: Sunflower Wind Project – Construction Site Access Road Adjustment

Dear Mr. Lein,

The Sunflower Wind Project has begun construction activities for 2016 and per the requirements set forth in the ND-03\_Sunflower\_PSC\_2014-05-19\_Certification of Provisions item number 34, Sunflower Wind is to make formal requests for approval of any design changes made to the project prior to installation. We would like to request written approval to make the following design changes:

1. Reroute the access road leaving turbine site 28 to follow the collection system routing on higher ground rather than making the 90-degree bend into the low lying area (Attachment 1). This change has been approved by the landowner, remains within the culturally surveyed corridor and will not affect any exclusionary or avoidance areas.
2. Reroute the access road approaching turbine 39 to border the existing fence line rather than removing a portion of the existing fence (Attachment 2). This change is within the leased disturbance area, remains within the culturally surveyed corridor and will not affect any exclusionary or avoidance areas.

If you require further explanation, my contact information is below. We look forward to hearing your response.

Sincerely,




Aron Anderson  
Senior Project Manager  
Solas Energy Consulting  
[aanderson@solasenergyconsulting.com](mailto:aanderson@solasenergyconsulting.com)  
612-599-4251

CC:

Jerry Lein	Jon Johnson
Todd Hartleben	Deron Lawrence
Sean Garry	Cindy Whitney
Jed Dailey	

## **Attachment 1 - Turbine 28 Access Road Re-route**

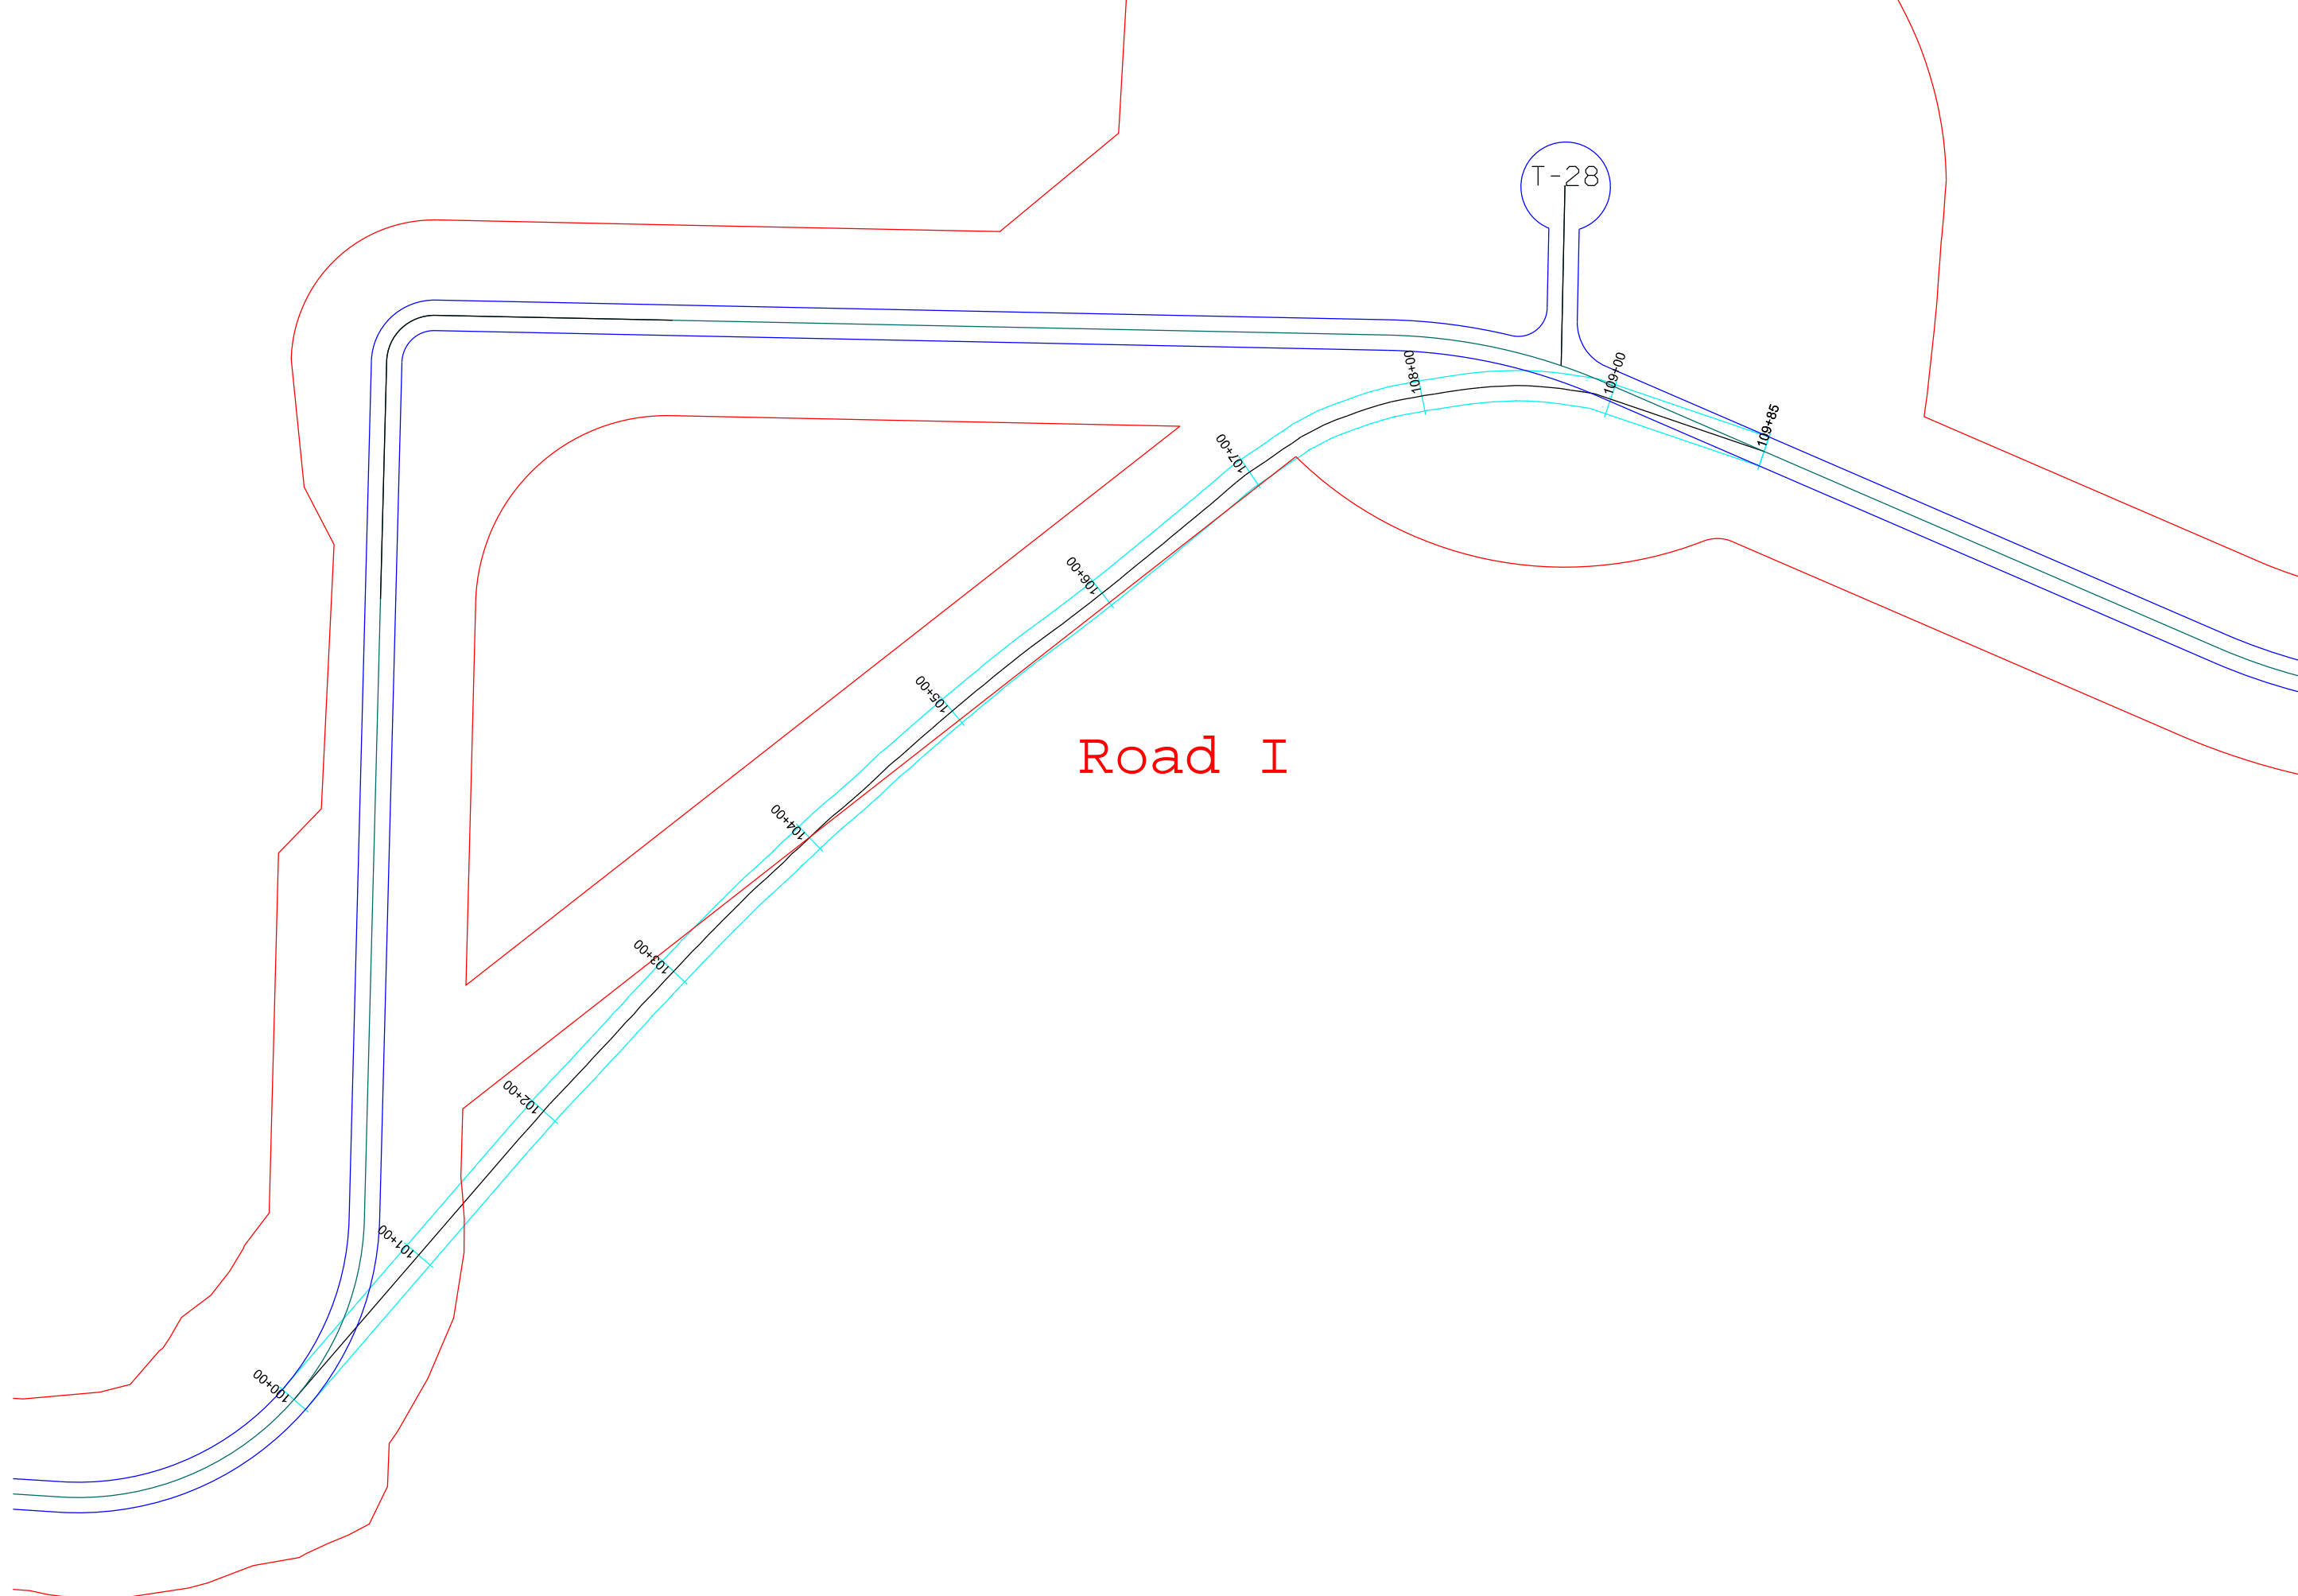

Road I

T-28

100+00

101+00

102+00

103+00

104+00

105+00

106+00


107+00

108+00

109+00

1109+85

## **Attachment 2 - Turbine 39 Access Road Re-route**

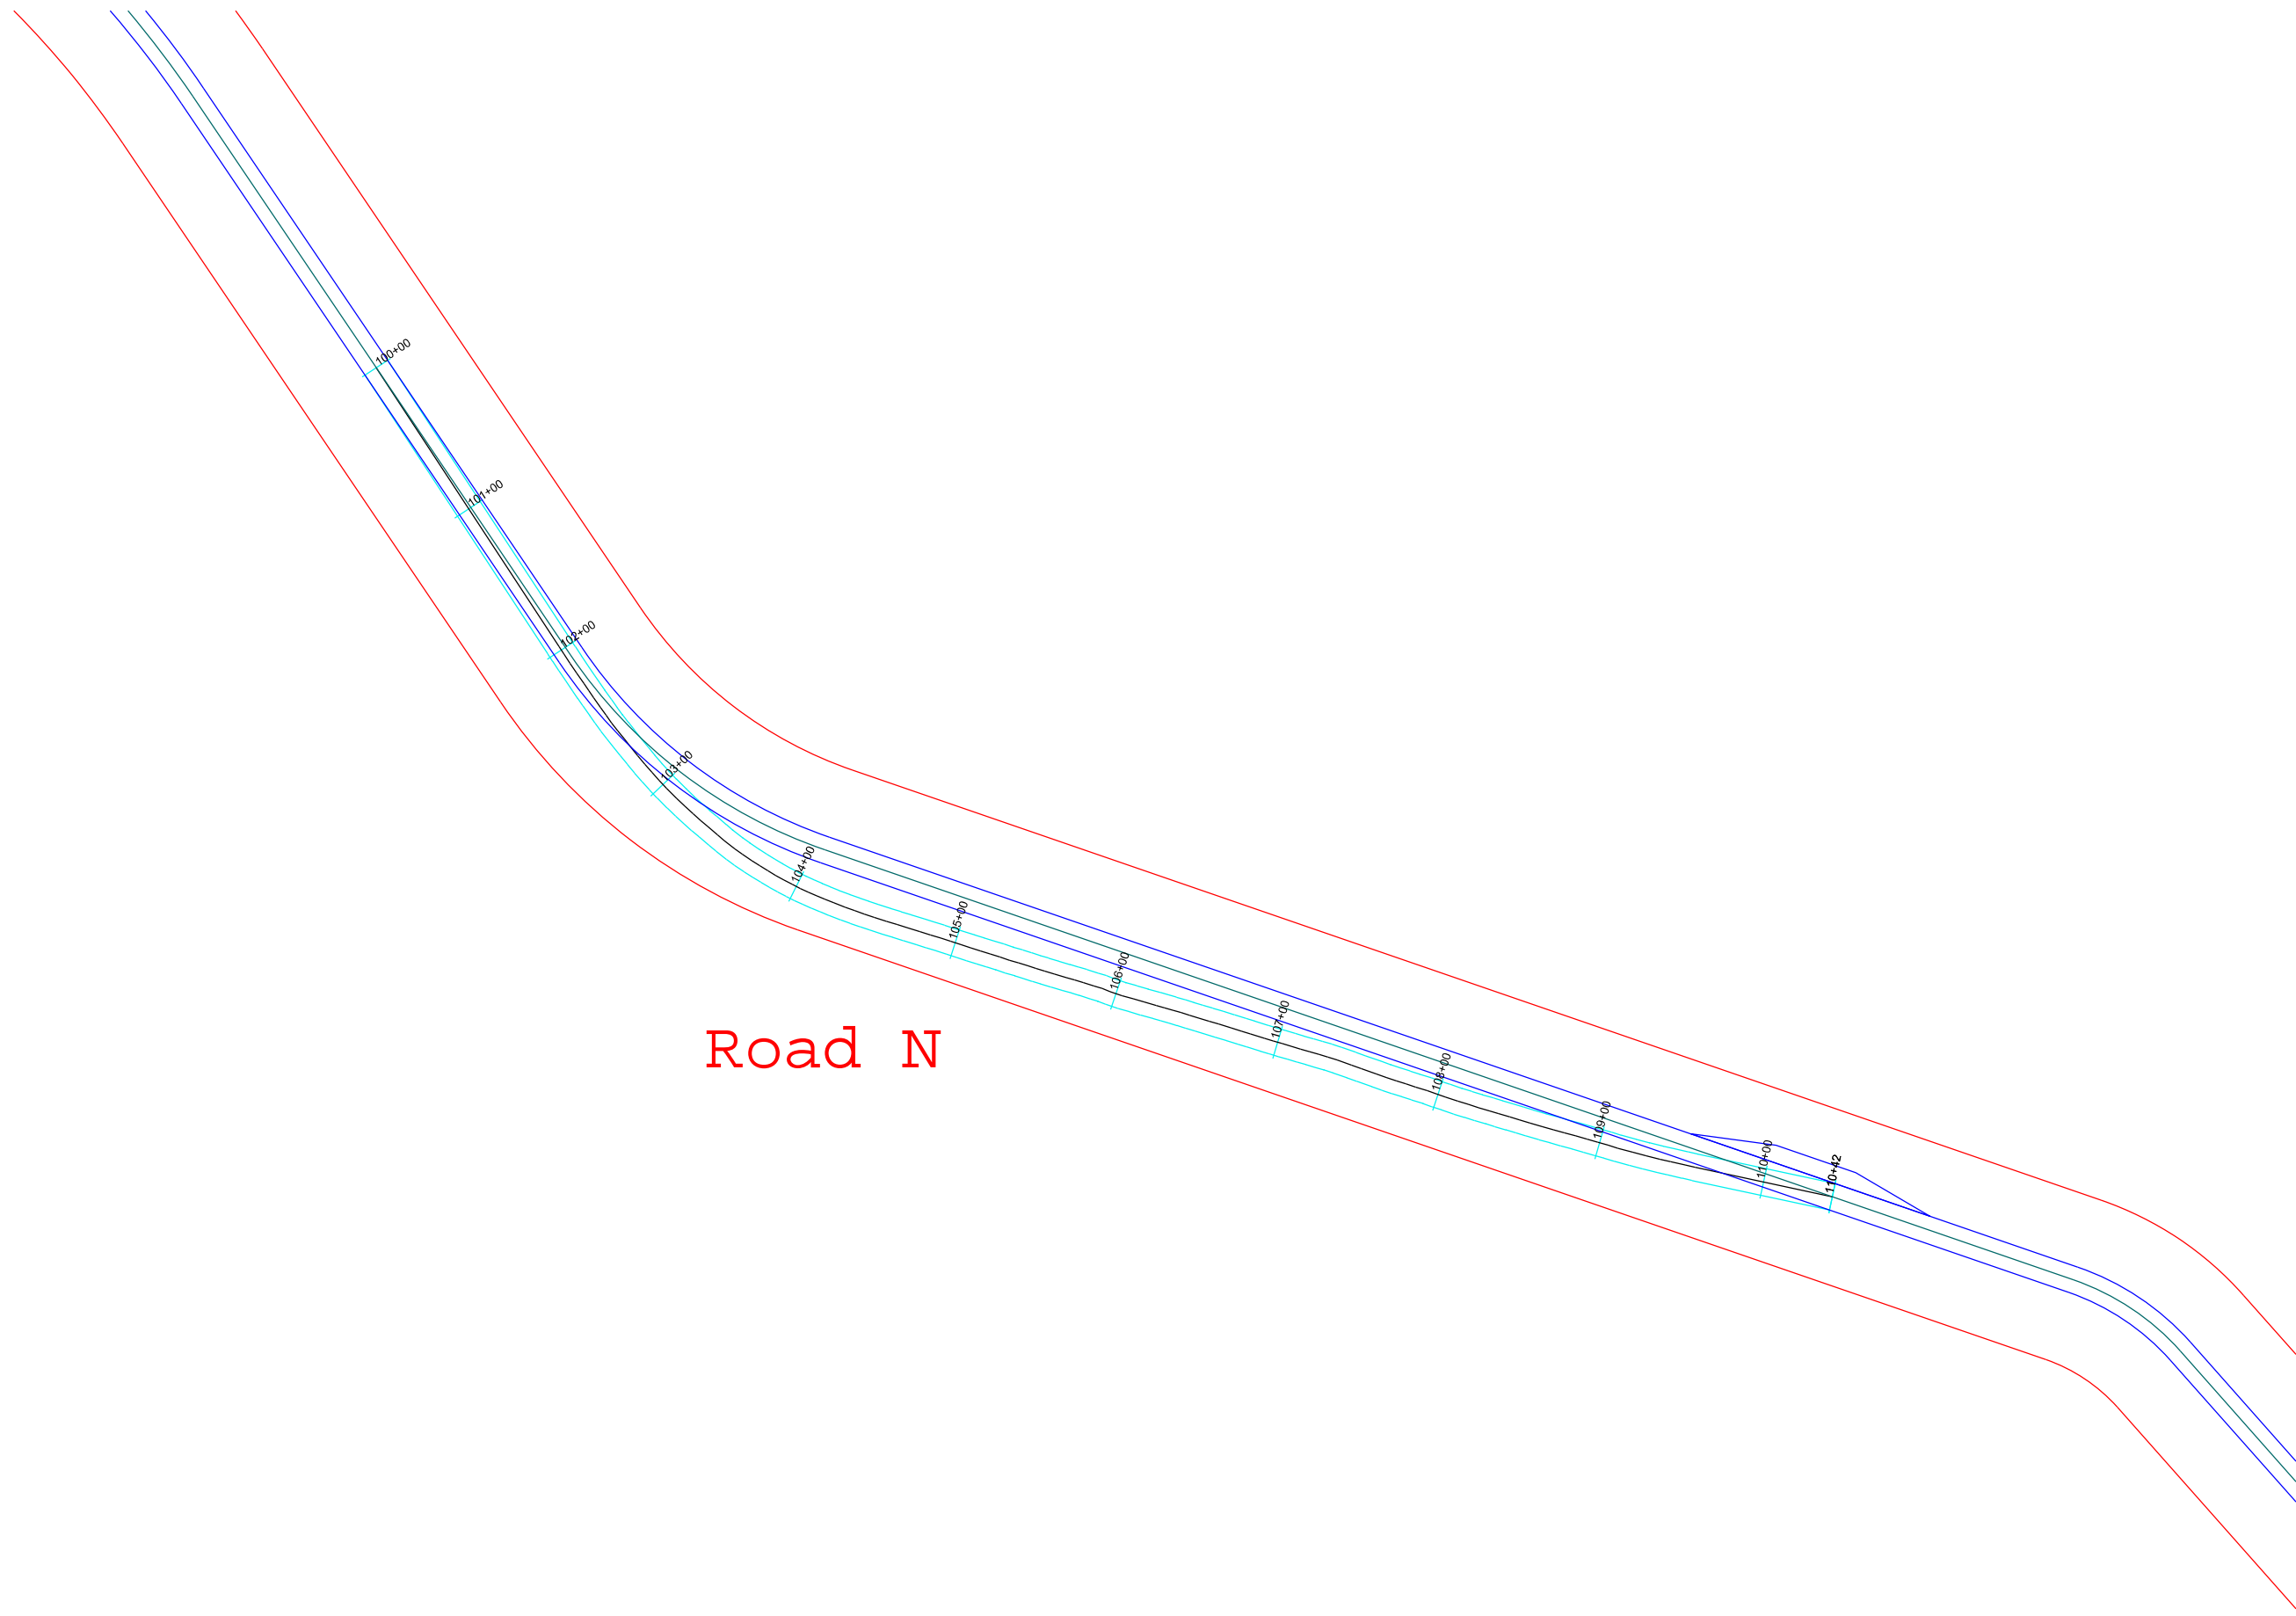

Road N