

-Info-Public Service Commission

From: Lein, Jerry R.
Sent: Wednesday, July 13, 2016 4:17 PM
To: Aron Anderson; 'sgarry@carlsonmccain.com'; 'thartleben@carlsonmccain.com'; -Info-Public Service Commission
Cc: Jed Dailey; Deron Lawrence; Cindy Whitney; Jon Johnson
Subject: RE: Sunflower Wind Project Weekly Construction Report - Case Number: PU-14-105
Attachments: Sunflower Wind - Layout Change Request 7.8.16.pdf

Dear Mr. Anderson:

Please consider this email as staff approval of the site plan changes requested below and described in the attachment.

Thank you,

Jerry Lein
701 328-1035

From: Aron Anderson [mailto:aanderson@solasenergyconsulting.com]
Sent: Friday, July 08, 2016 5:50 PM
To: Lein, Jerry R.; 'sgarry@carlsonmccain.com'; 'thartleben@carlsonmccain.com'; -Info-Public Service Commission
Cc: Jed Dailey; Deron Lawrence; Cindy Whitney; Jon Johnson
Subject: Sunflower Wind Project Weekly Construction Report - Case Number: PU-14-105

Jerry,

See attached layout change request we have previously discussed. In the attachments the dark blue lines are the approved design and the teal lines are the proposed changes. Please let me know if you have any questions.

Thank You,

Aron Anderson
Senior Project Manager
Solas Energy Consulting US Inc.
Mobile: (612) 599-4251
Email: aanderson@solasenergyconsulting.com

This transmission, email and any files transmitted with it, may be: (1) subject to the Attorney-Client Privilege, (2) an attorney work product, or (3) strictly confidential under federal or state law. If you are not the intended recipient of this message, you may not use, disclose, print, copy or disseminate this information. If you have received this transmission in error, notify the sender (only) and delete the message. This message may also be subject to disclosure under the North Dakota Open Records Laws.

85 **PU-14-105** Filed: 7/13/2016 Pages: 6
Staff approval of request for windfarm site revisions

Attn: Jerry Lein
600 E. Boulevard, Dept. 408
Bismarck, ND 58505-0480

Submittal via email to ndpsc@nd.gov
Case Number: PU-14-105

Re: Sunflower Wind Project – Construction Site Access Road Adjustment

Dear Mr. Lein,

The Sunflower Wind Project has begun construction activities for 2016 and per the requirements set forth in the ND-03_Sunflower_PSC_2014-05-19_Certification of Provisions item number 34, Sunflower Wind is to make formal requests for approval of any design changes made to the project prior to installation. We would like to request written approval to make the following design changes:

1. Reroute the access road leaving turbine site 28 to follow the collection system routing on higher ground rather than making the 90-degree bend into the low lying area (Attachment 1). This change has been approved by the landowner, remains within the culturally surveyed corridor and will not affect any exclusionary or avoidance areas.
2. Reroute the access road approaching turbine 39 to border the existing fence line rather than removing a portion of the existing fence (Attachment 2). This change is within the leased disturbance area, remains within the culturally surveyed corridor and will not affect any exclusionary or avoidance areas.

If you require further explanation, my contact information is below. We look forward to hearing your response.

Sincerely,




Aron Anderson
Senior Project Manager
Solas Energy Consulting
aanderson@solasenergyconsulting.com
612-599-4251

CC:

Jerry Lein	Jon Johnson
Todd Hartleben	Deron Lawrence
Sean Garry	Cindy Whitney
Jed Dailey	


Attachment 1 - Turbine 28 Access Road Re-route

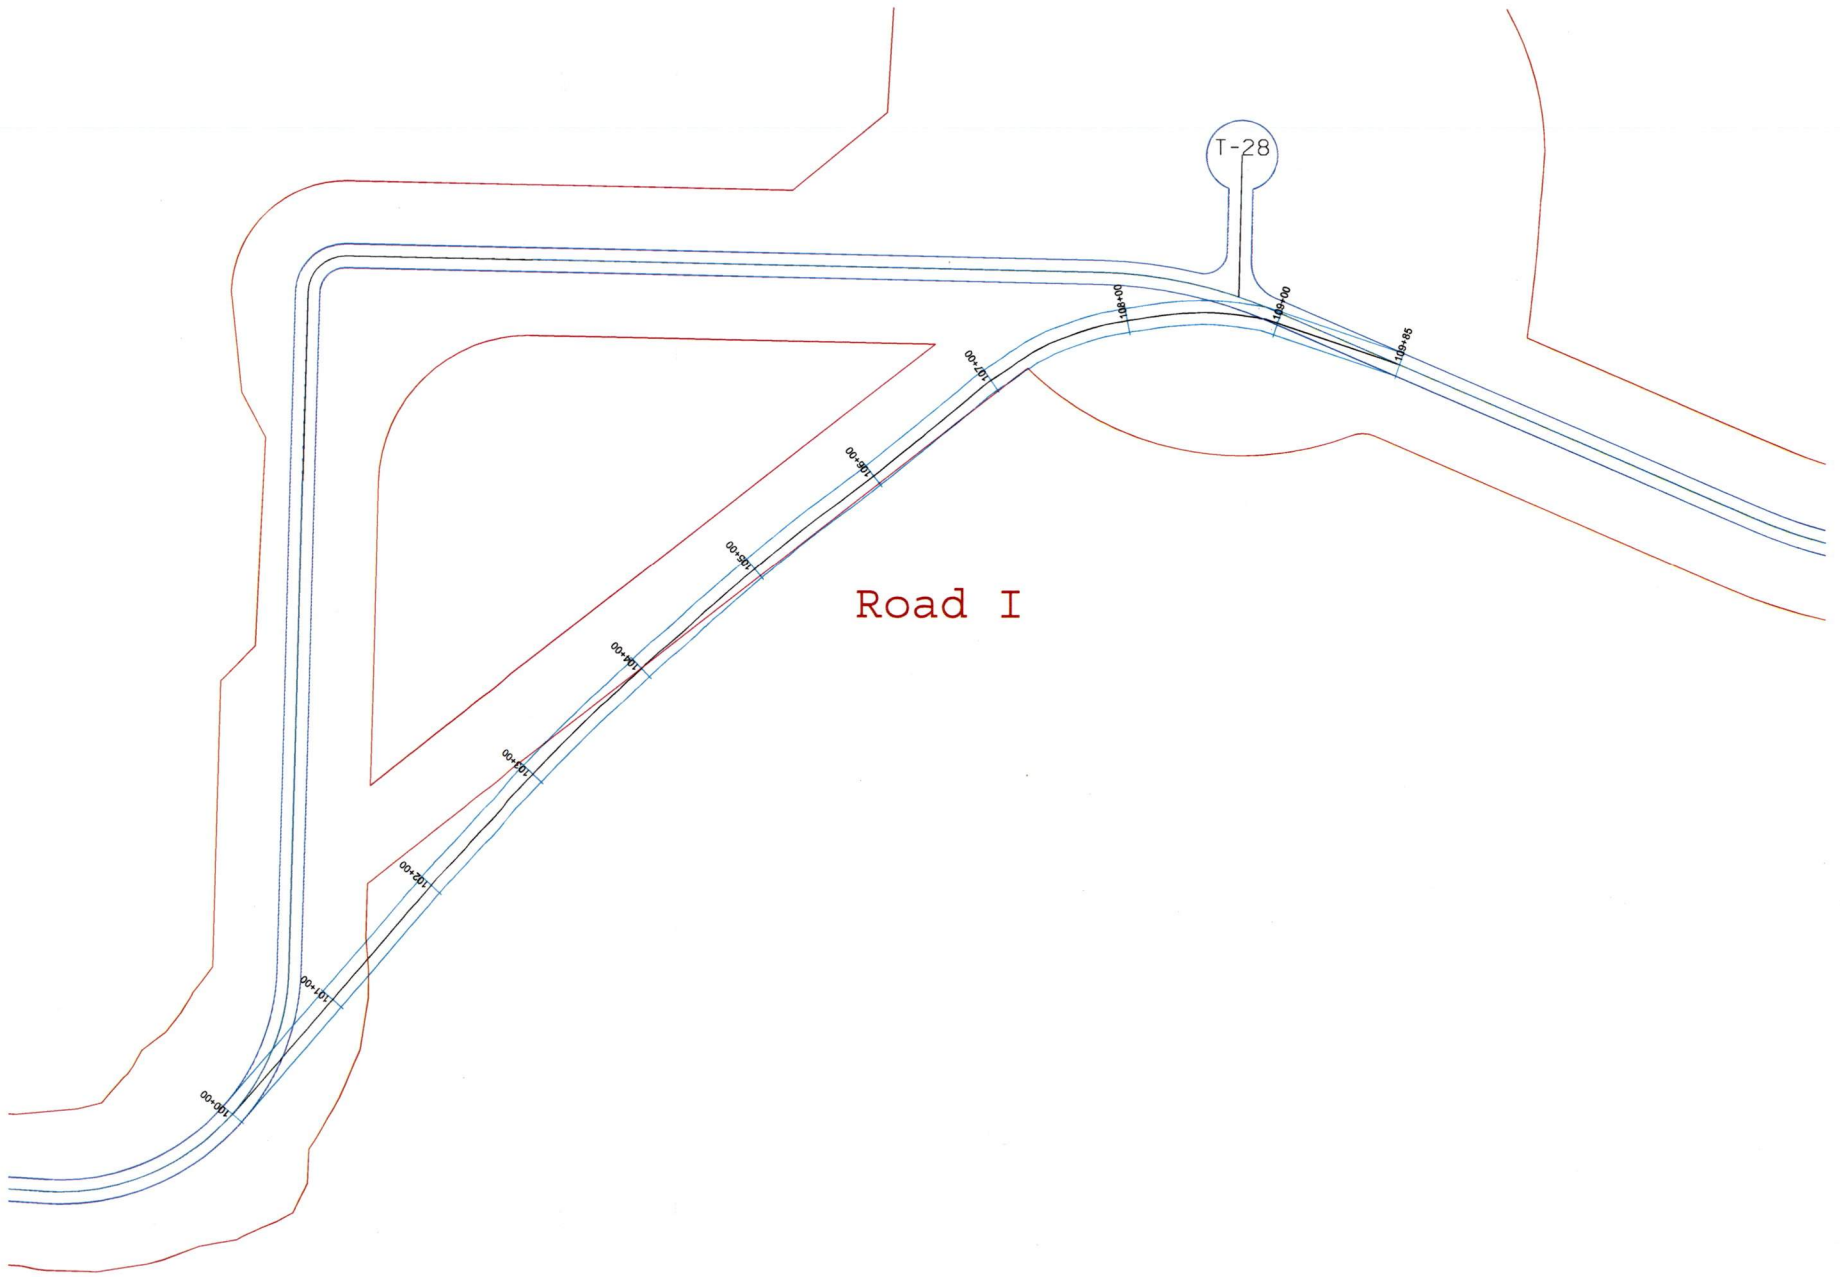

Road I

T-28

Attachment 2 - Turbine 39 Access Road Re-route

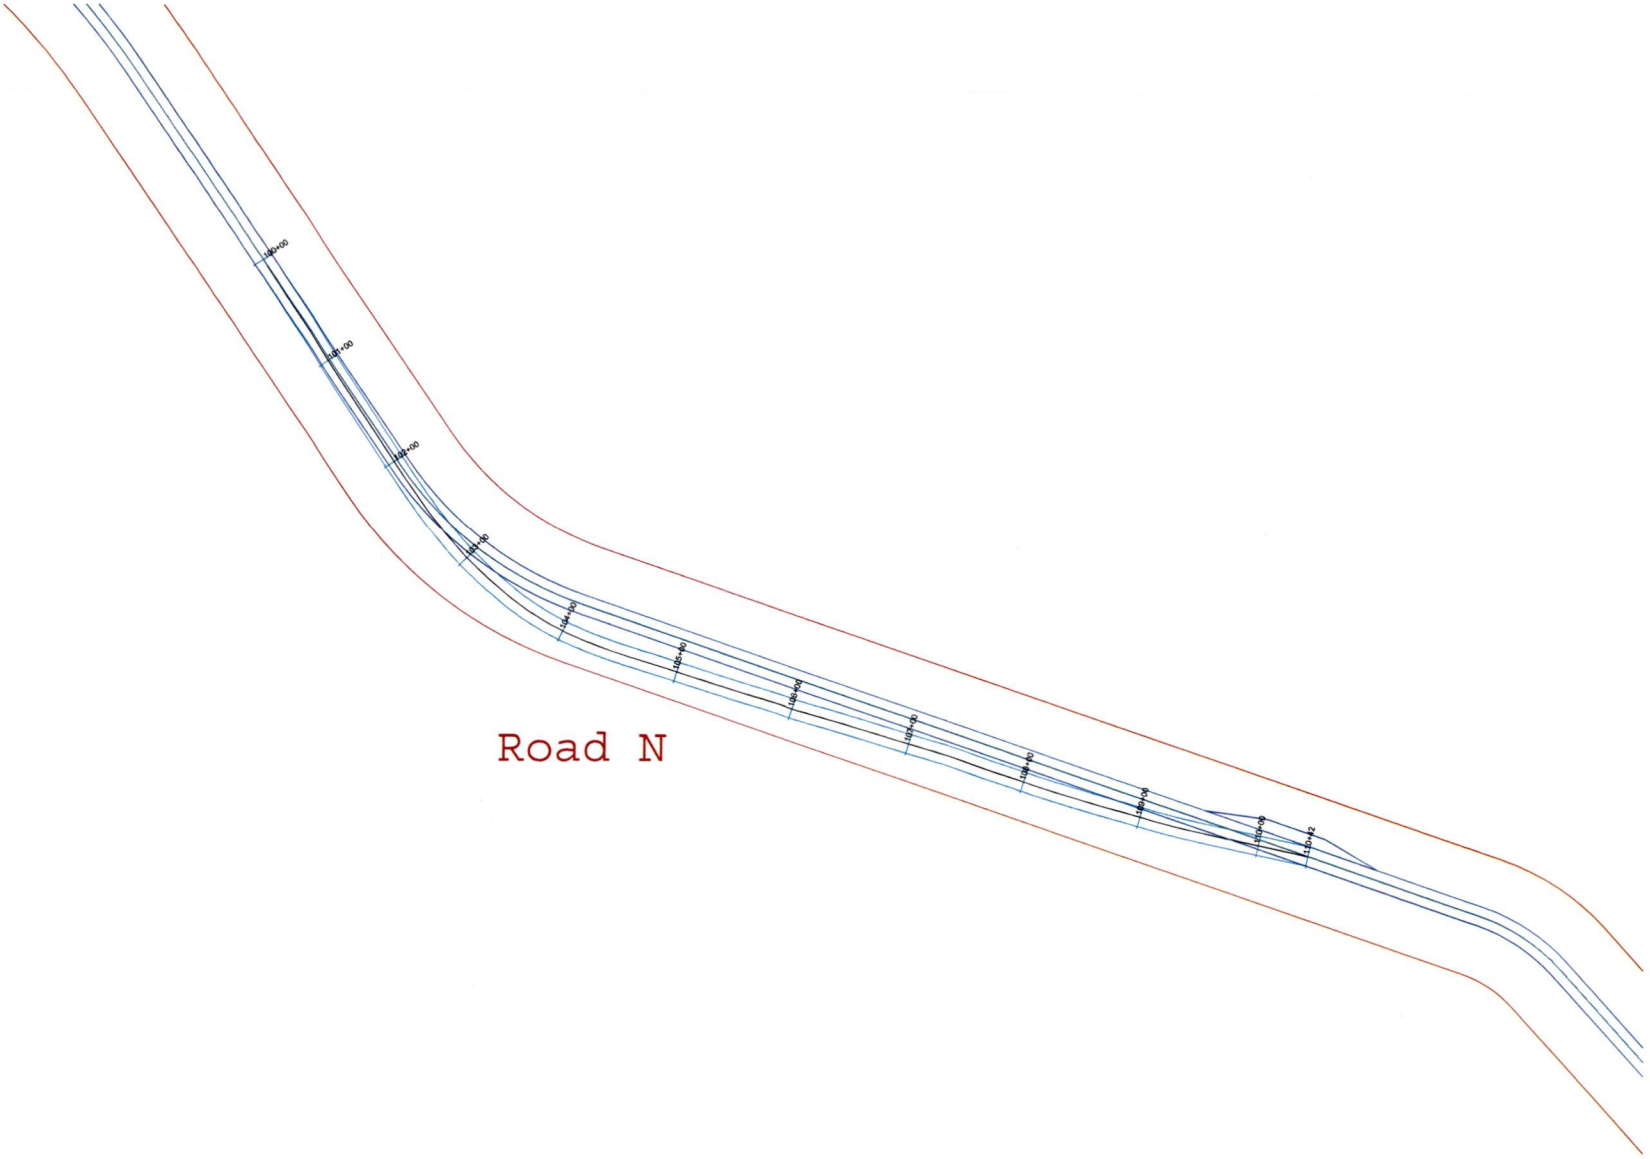

Road N