
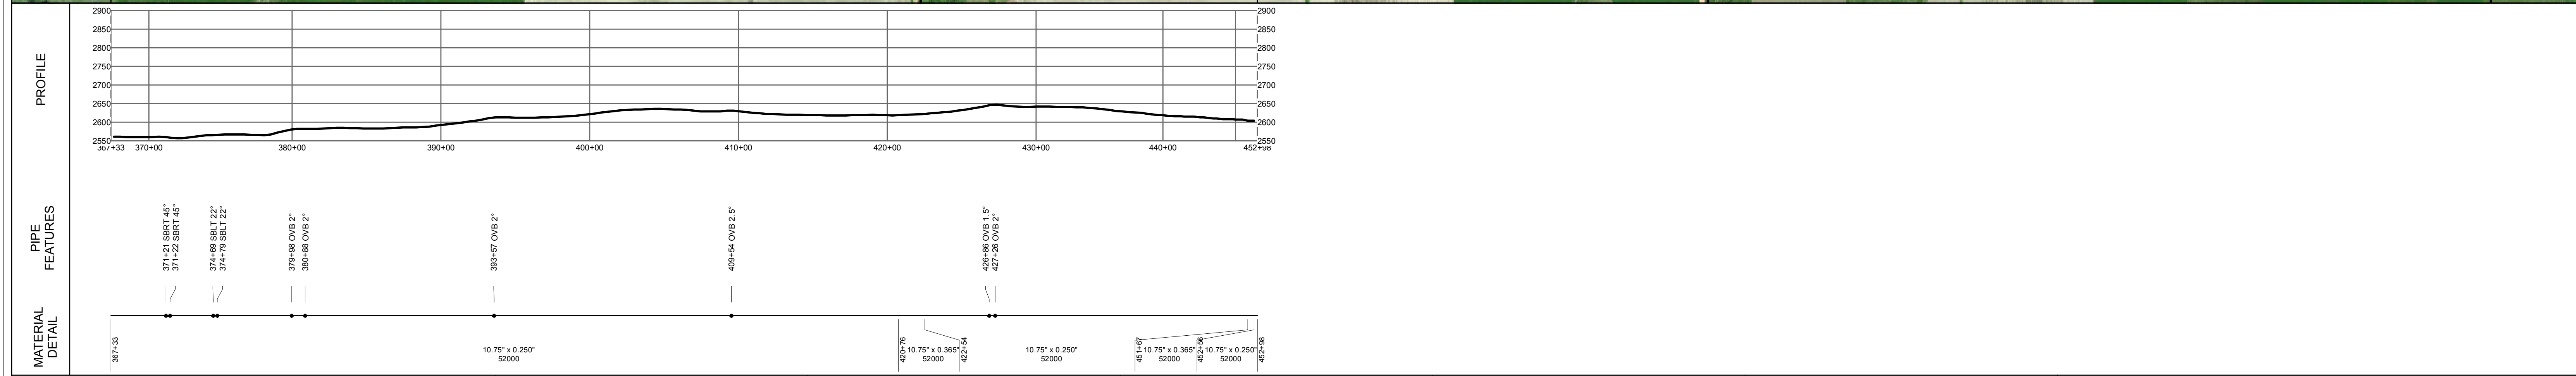


| | | | | | | | | | | | | | | |
|-------------------|--------|--------|------------------|--------|--------|--------------------|--------|------------------|-------------|---------|------------------|---------------|--------|------------------|
| OWNER | 367+33 | 2,804' | FAIMAN FARMS LTD | 395+37 | 2,589' | OUKROP FAMIL TRUST | 427+27 | 3,079' | COUNTY ROAD | 452+105 | 93' | OUKROP DANIEL | 452+98 | |
| CROSSINGS | | 372+49 | DRAINAGE | | 388+76 | DRAINAGE | | 395+38 | FENCE | | 415+98 | FENCE | | |
| FOREIGN LINE XING | | | | | | | 420+88 | Fiber Optic | | | | | | |

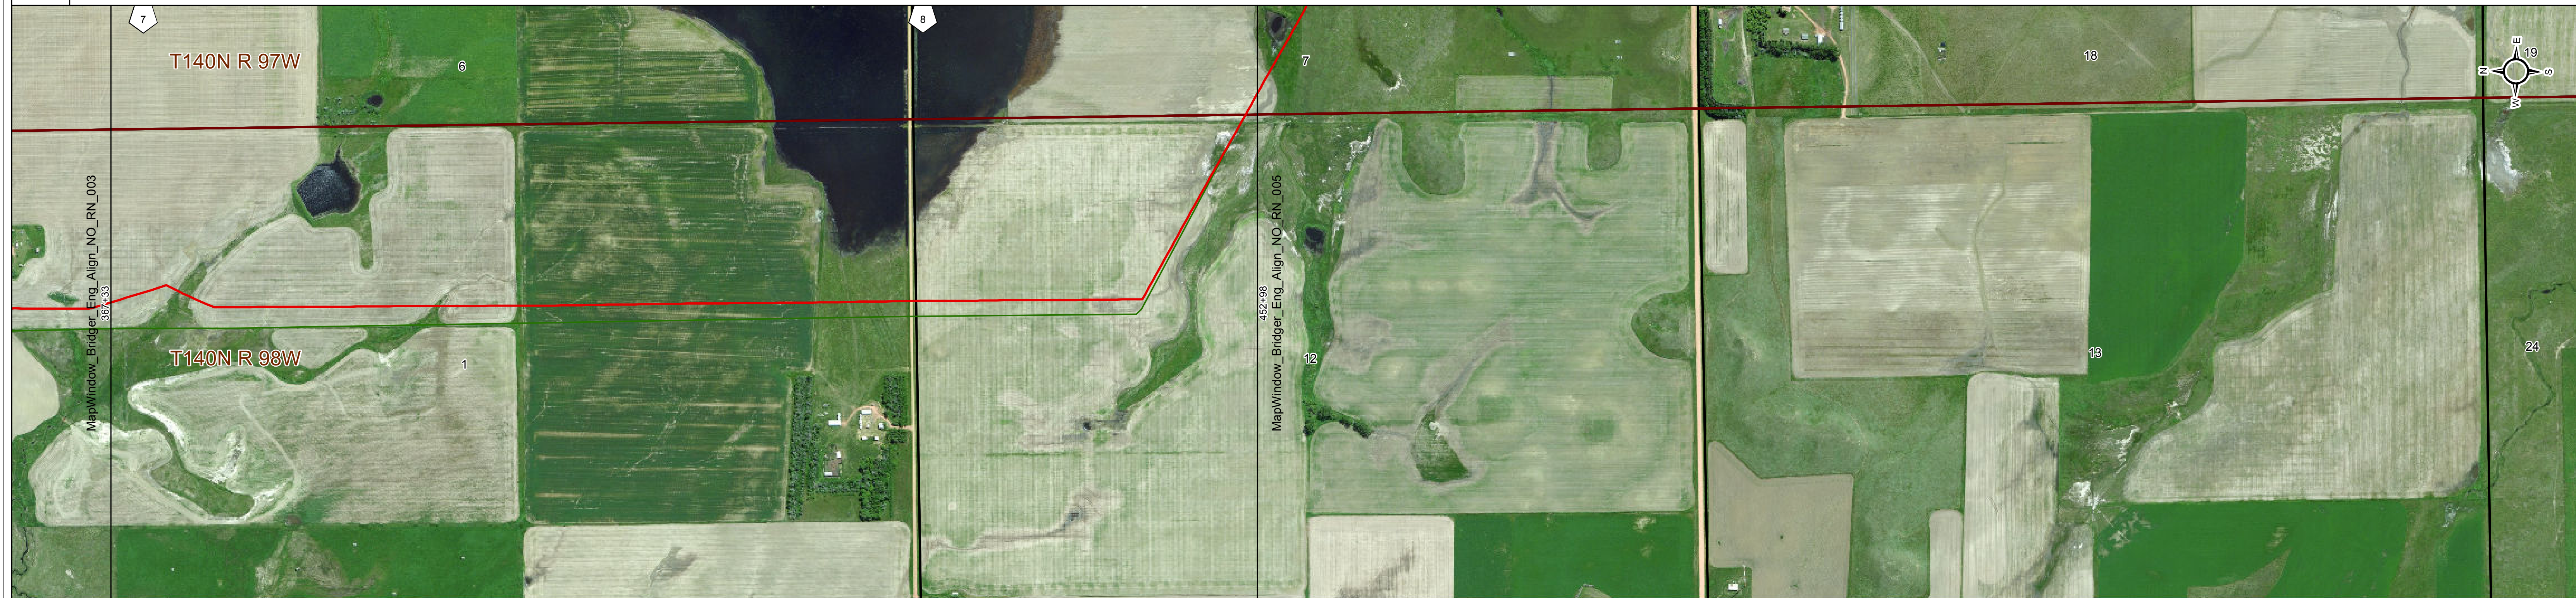

| | | |
|-------------------|--|---|
| LEGEND | PIPE DETAIL 367+33 420+76 10.75" x 0.250", 4/1/2015, 52000, (5,343) 420+76 422+54 10.75" x 0.365", 4/1/2015, 52000, (178) 422+54 451+67 10.75" x 0.250", 4/1/2015, 52000, (2,912) 451+67 452+56 10.
| | Scale: 1:8,000 MAOP RATING 1440 PSI Generate Date: 5/27/2015 Line Name: SKUNK HILL TO DICKINSON Sheet Number: 004 of 006 | |