



Northland Boring

Bore Profile: Road Bore

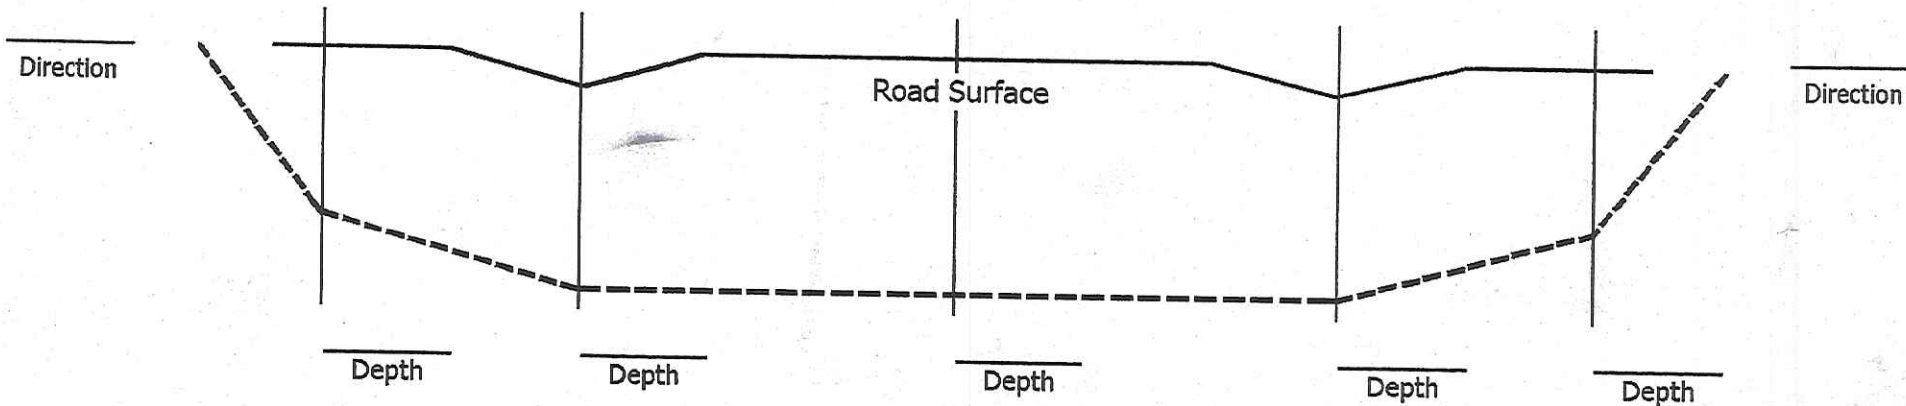

Bore Profile: Creek Bore

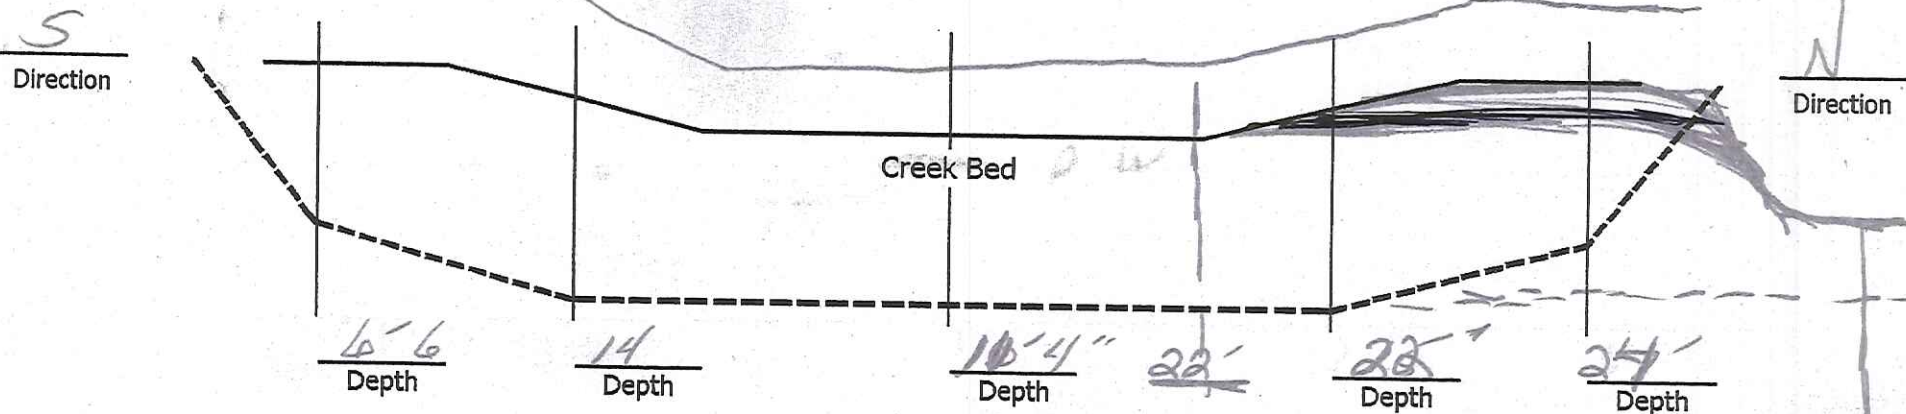

Project Name: SUMMIT MIDSTREAM 8"
 Bore Type: Double Wetlands STA. 2032+00
 Contractor: Loenbro
 Pipe Size & Type: 8" Steel
 Length of Bore: 1023'


Northland Boring LLC

Date: 22 Aug 2013
 Inspector: John Beshoff
 Foreman: Lee C. Masthardt
 In the field
 Brian


10' 5"
 7'

Northland Boring

Bore Profile: Road Bore

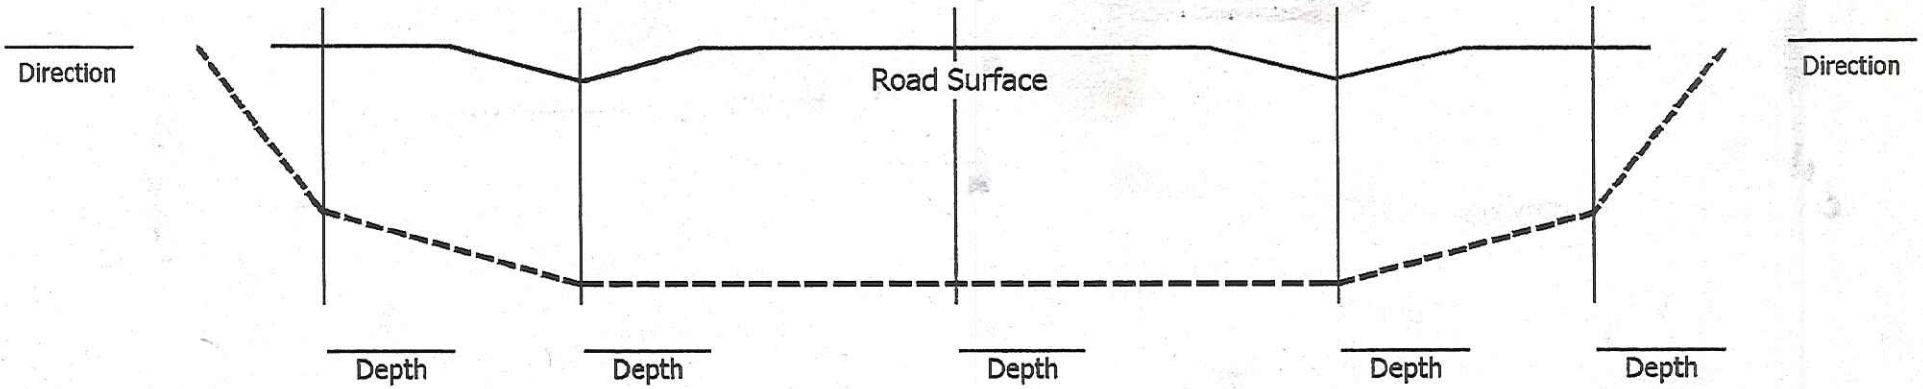

Bore Profile: Creek Bore

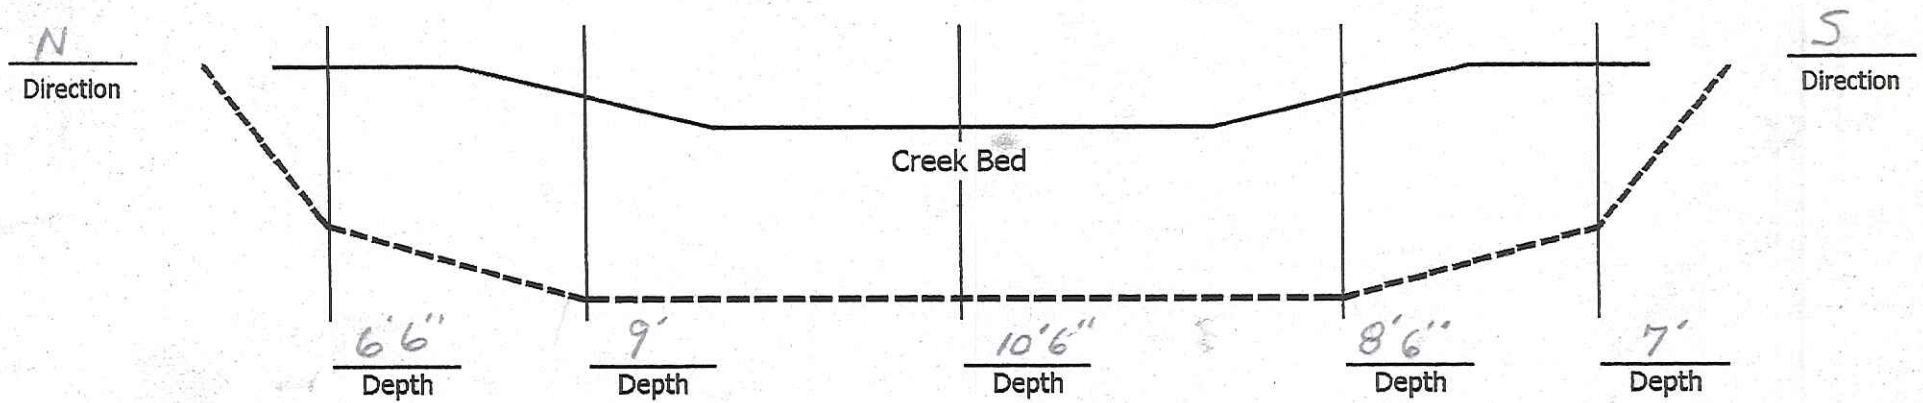

Project Name: STA 2016+49 - 2019+42

Bore Type: WET LAND CREEK

Contractor: LOE-N-BRO

Pipe Size & Type: 8" STEEL

Length of Bore: 310'

Northland Boring LLC


Date: 8-20-2013

Inspector: Keith Johnson


Foreman: Brian [Signature]

Northland Boring

Bore Profile: Road Bore

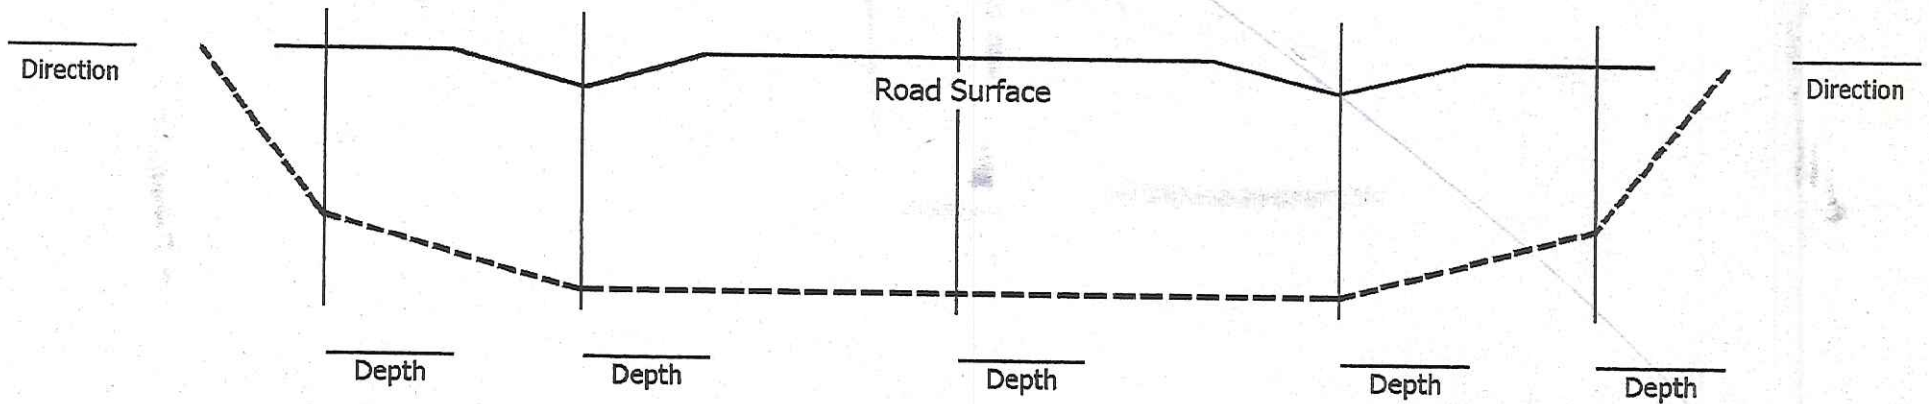

Bore Profile: Creek Bore

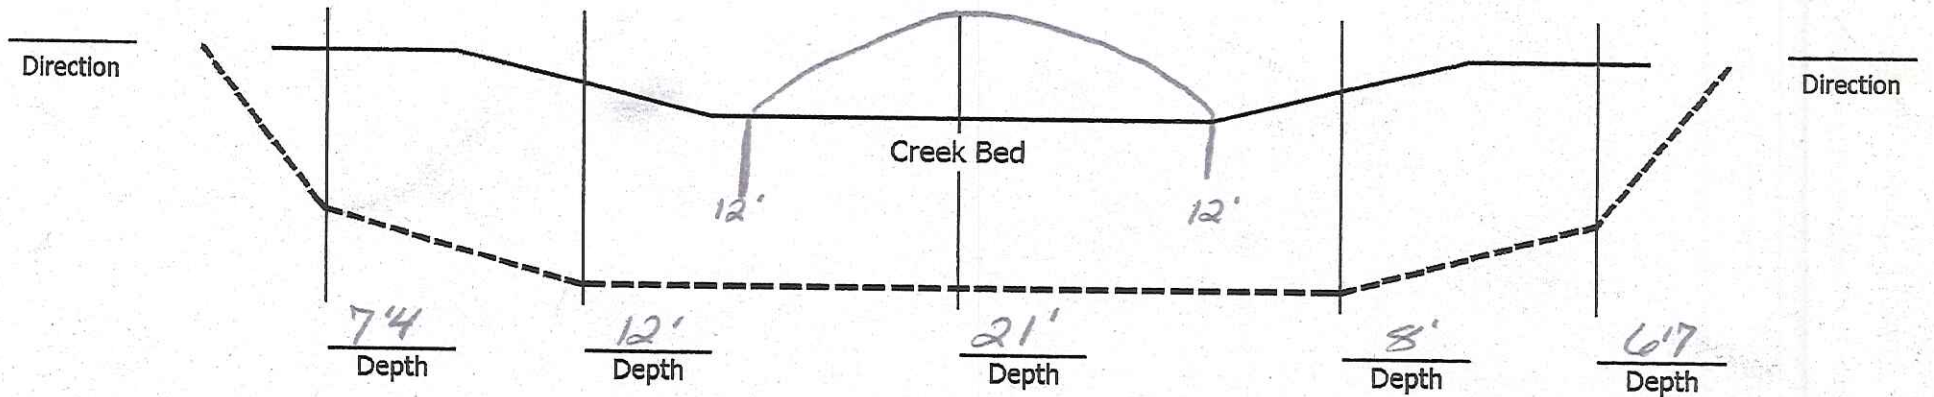

Project Name: Sta 2003+67 - 2012+20

Bore Type: Wet Land

Contractor: Loc-N-Bro

Pipe Size & Type: 8" Steel



Length of Bore: 965'

Northland Boring LLC

Date: 8-20-13

Inspector: Neil John Keith Jackson

Foreman: Leon Bachman

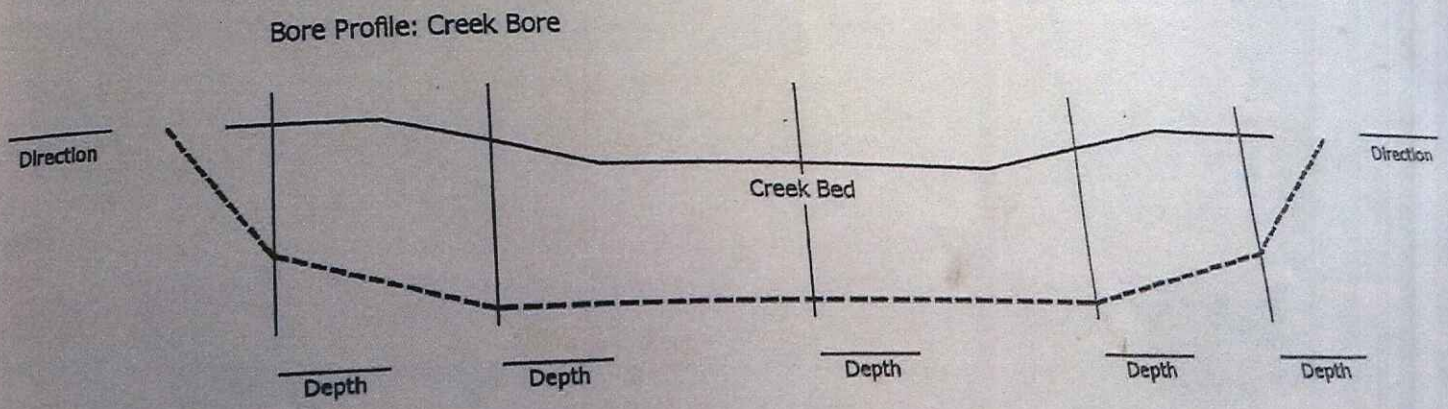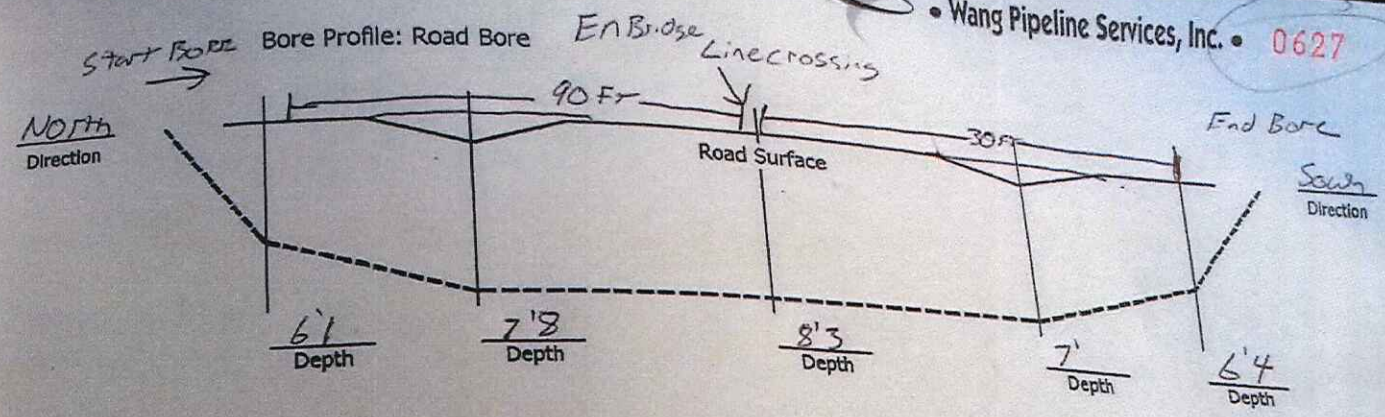

Location: SM 8" STA # 1602 + 17

Bore Type: EN bridge Line Crossing

Contractor: Loenbio

Pipe Size & Grade 8" Steel



Length of Bore: 120 FT

Date: 8/7/13

Inspector:

Foreman: Kacey Lawler

Customer:

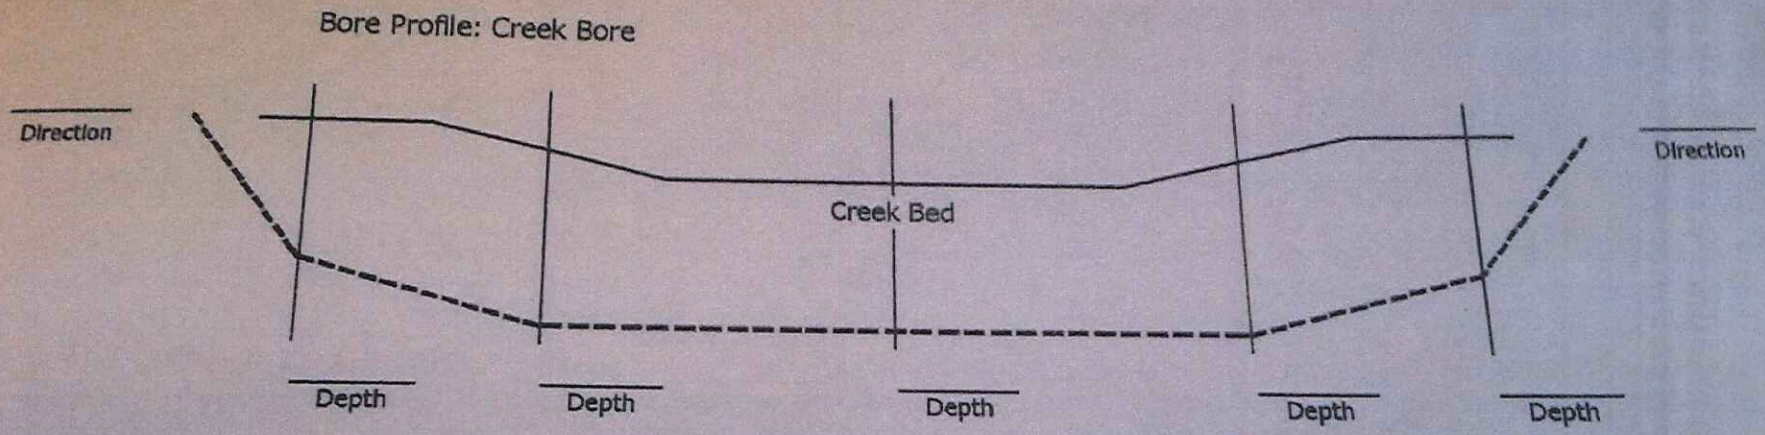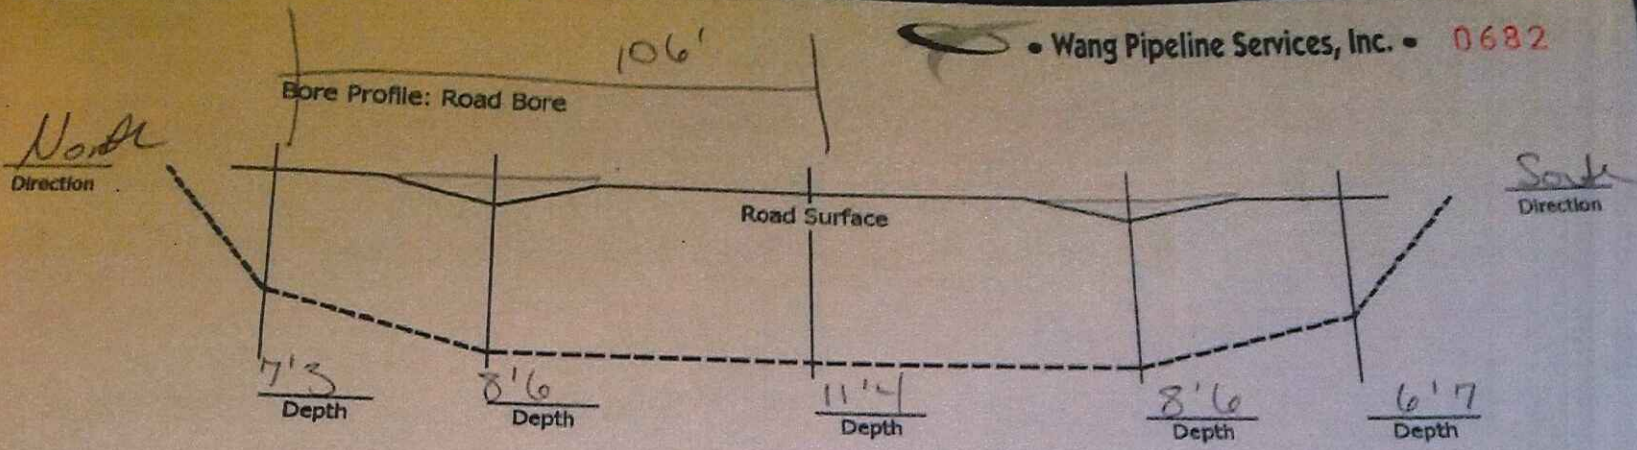

Location: 70th Ave

Bore Type: Road

Contractor: LOENBRO

Pipe Size & Grade: 8" steel

Length of Bore: 200'


Date: 8-17

Inspector: _____


Foreman: Ryan [Signature]

Customer: _____

Bore Profile: Road Bore

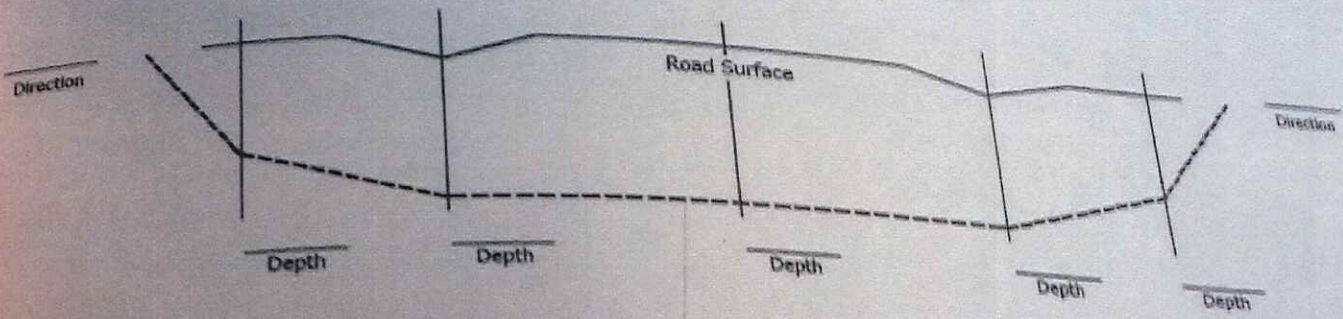


Bore Profile: Creek Bore

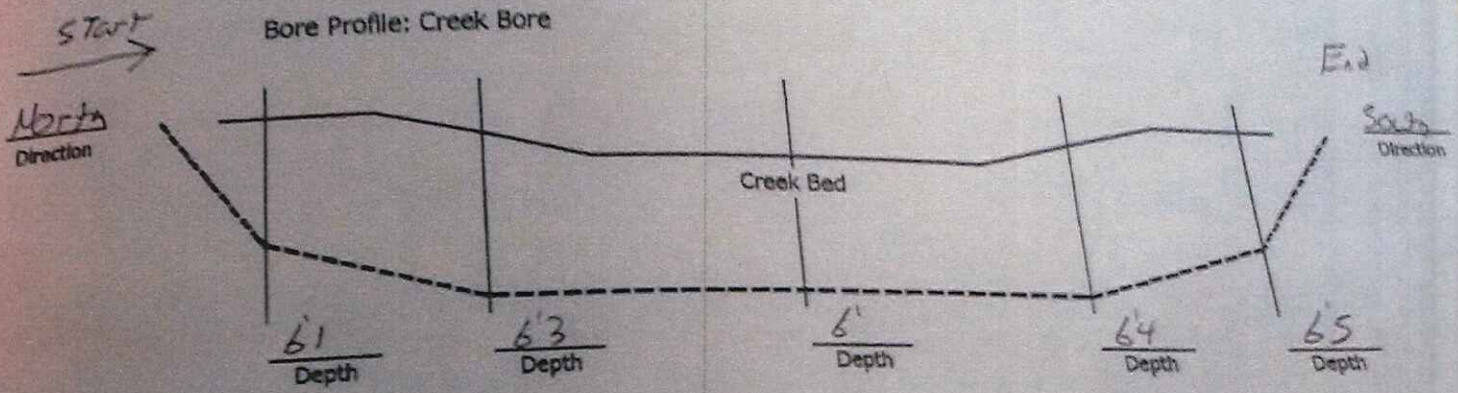


Location: SM 8" STA # 1669+27
 Bore Type: Wet Land
 Contractor: Loenbio
 Pipe Size & Grade: 8" Steel
 Length of Bore: 155 ft

Date: 8/8/13
 Inspector: _____
 Foreman: _____
 Customer: _____

Bore Profile: Road Bore

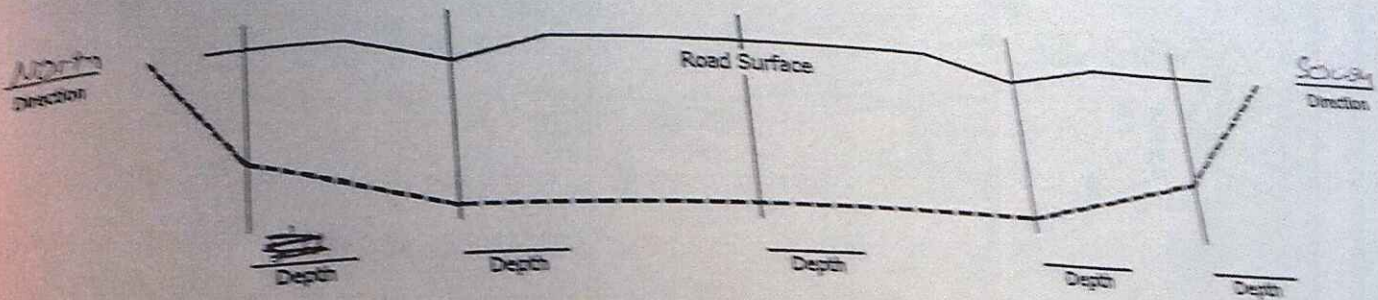

Bore Profile: Creek Bore

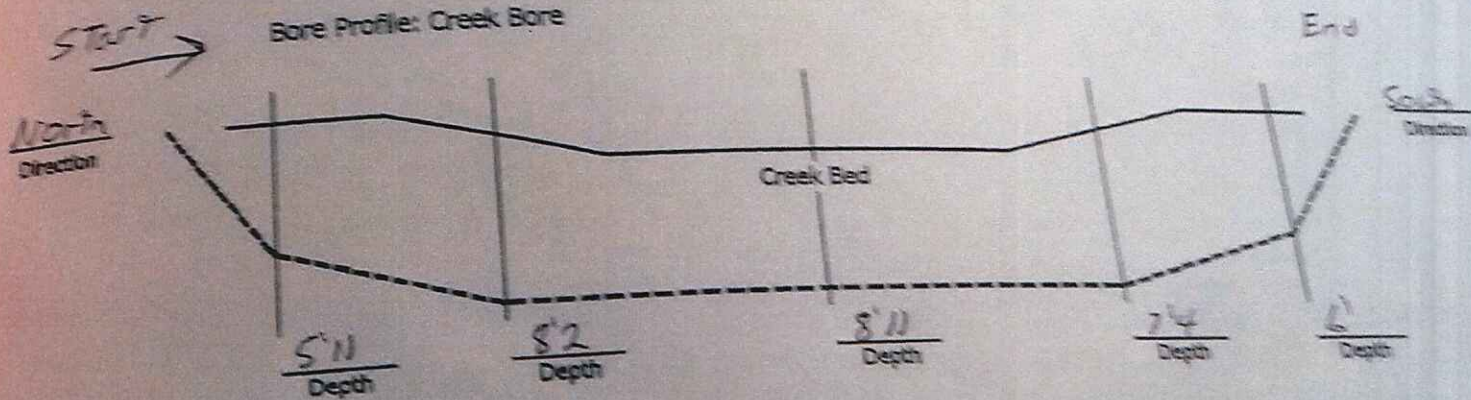

Location: SM 8" STA# 1681+79

Bore Type: Wet Low

Contractor: Loubio

Pipe Size & Grade 3" Steel

Length of Bore: 200 FT



Date: 8/15/13

Inspector:


Foreman:

Customer:

Bore Profile: Road Bore

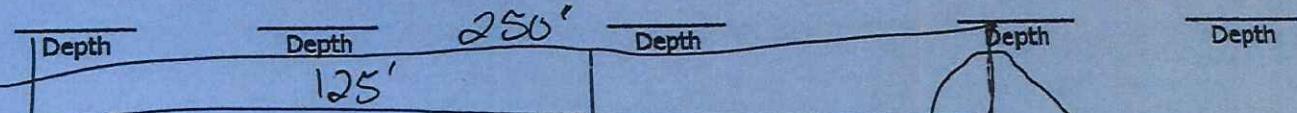
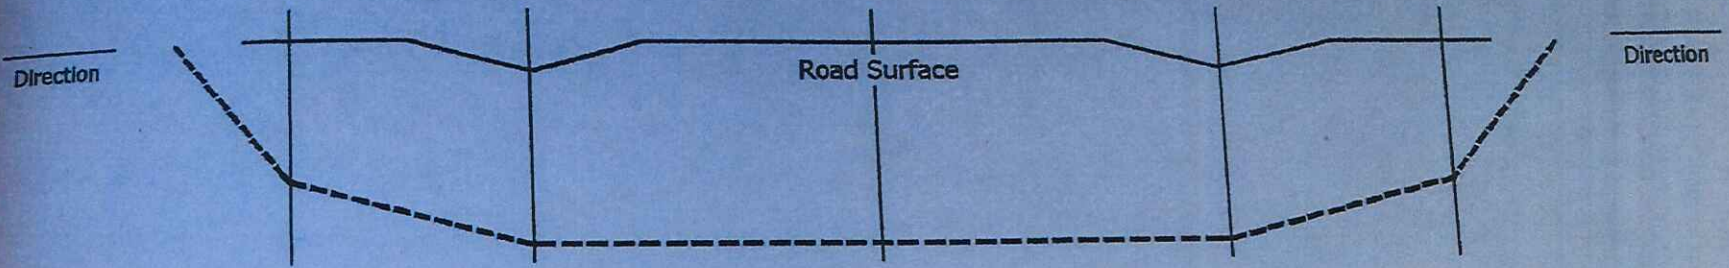


Bore Profile: Creek Bore

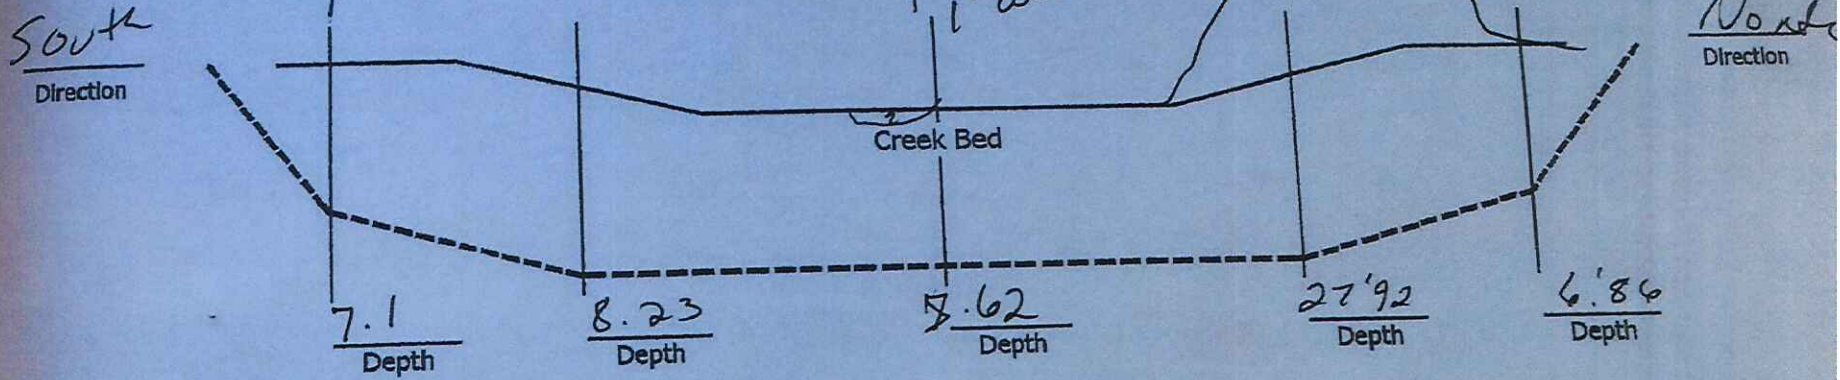

Location: Little Muddy River
 Bore Type: Wetland
 Contractor: LOENBRO
 Pipe Size & Grade: 8" steel
 Length of Bore: 390'

Date: Aug 10th
 Inspector: _____
 Foreman: _____
 Customer: _____

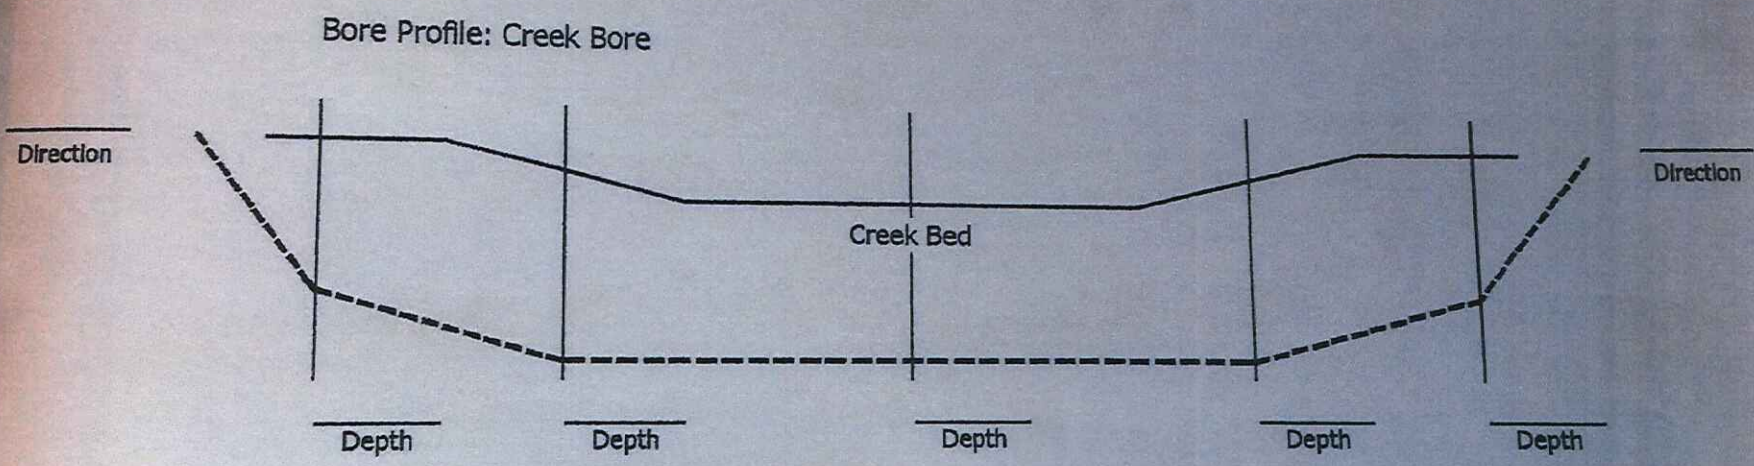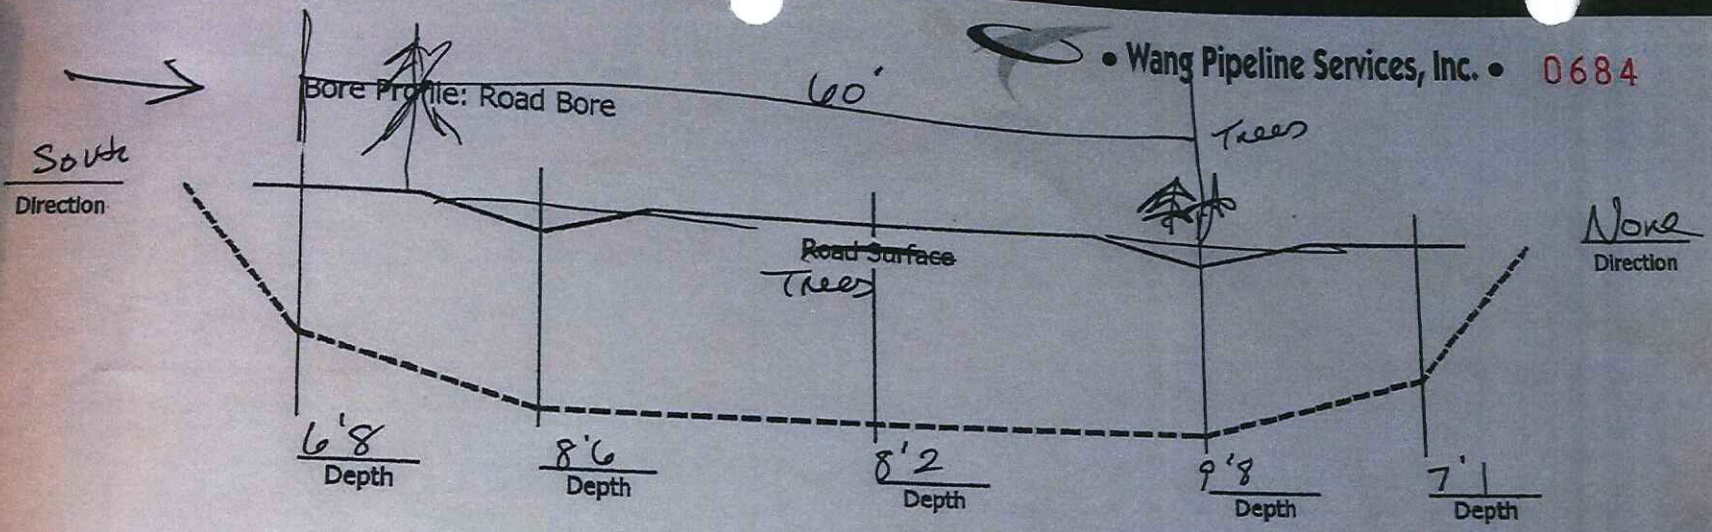

Location: Tree Bore

Bore Type: Tree Bore

Contractor: LOEMBRO

Pipe Size & Grade: 8" steel


Length of Bore: 760'

Date: 8-12

Inspector: _____


Foreman: hy ty

Customer: _____

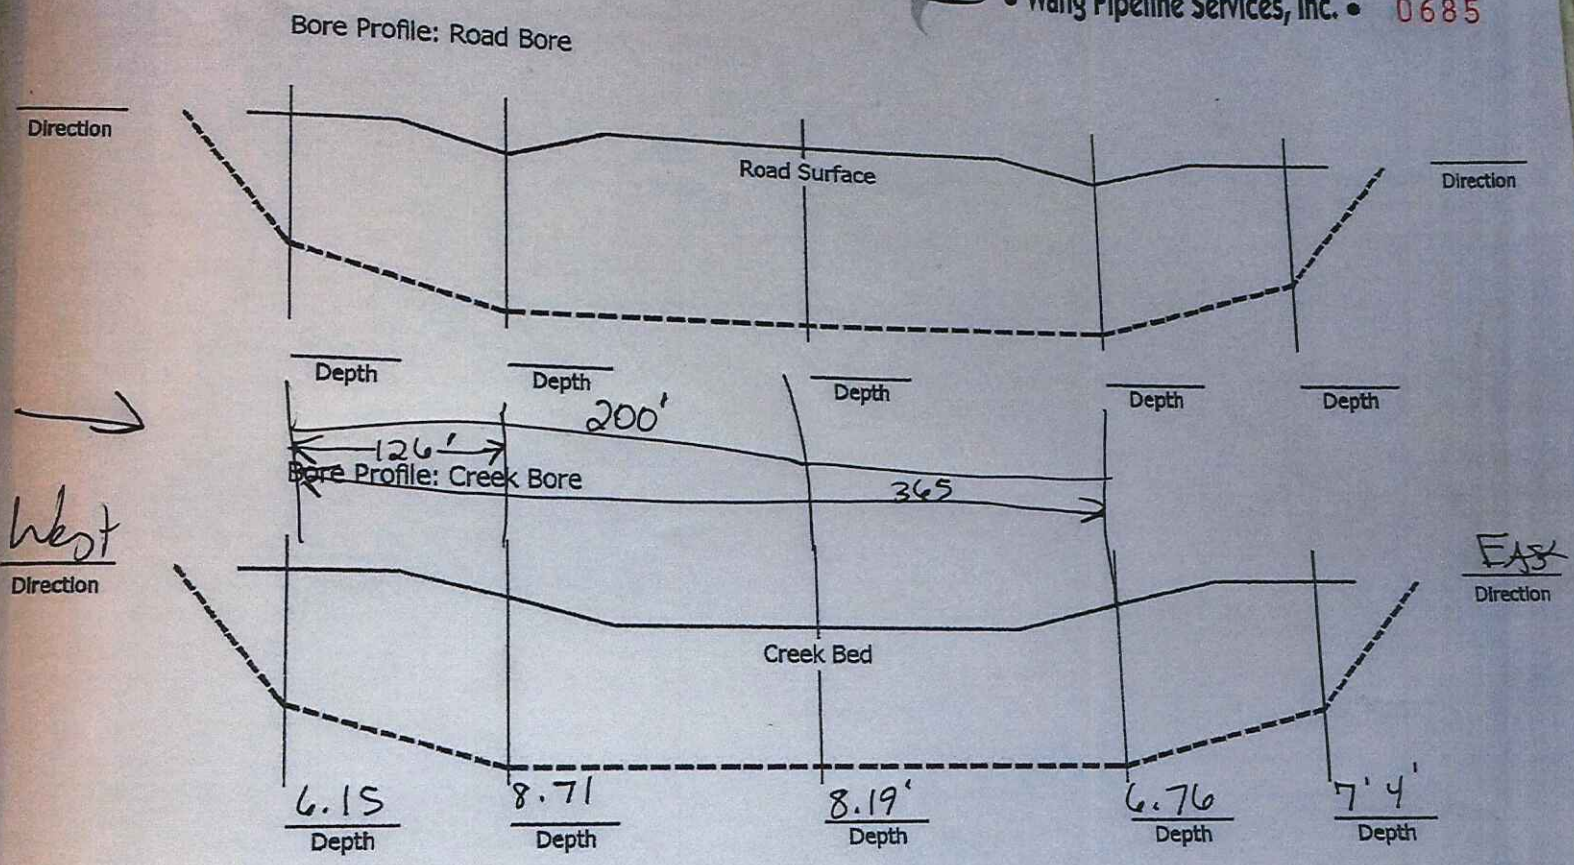

Location: Wetland after long tree bore
 Bore Type: Wetland
 Contractor: LOENBRO
 Pipe Size & Grade: 8" steel
 Length of Bore: ~~200' to~~ 400'

Date: 8-14
 Inspector: _____
 Foreman: _____
 Customer: _____

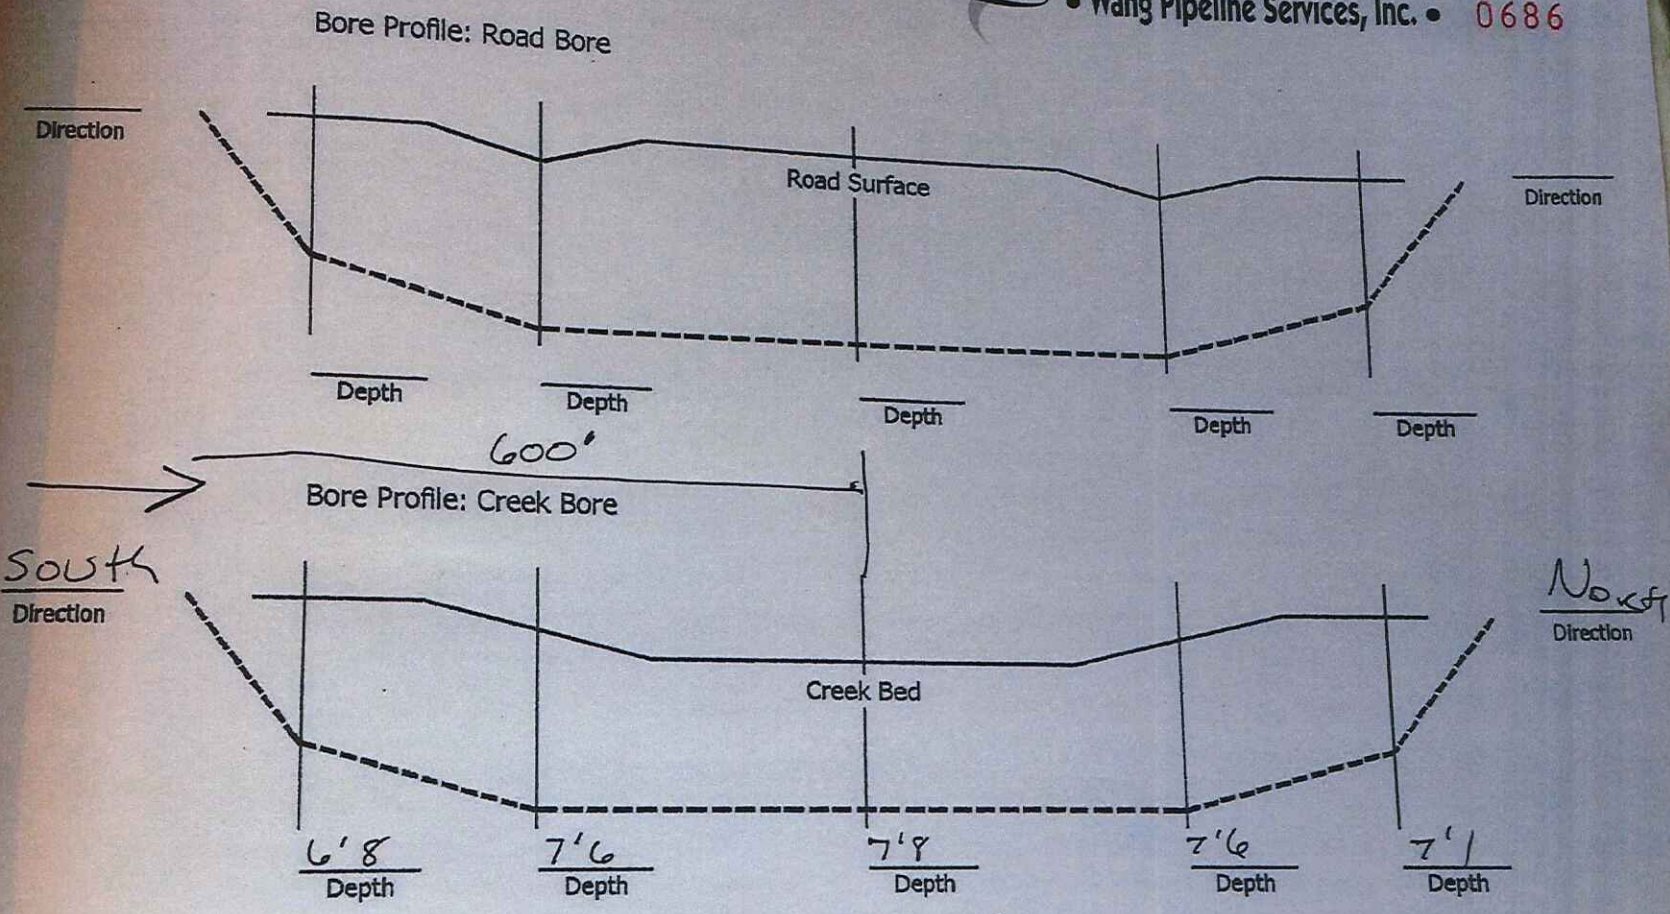

Location: Wetland

Bore Type: Wetland

Contractor: LOENBRO

Pipe Size & Grade 8" steel



Length of Bore: ~~8100~~ 920'

Date: 8-17

Inspector: _____

Foreman: Ryan [Signature]

Customer: _____

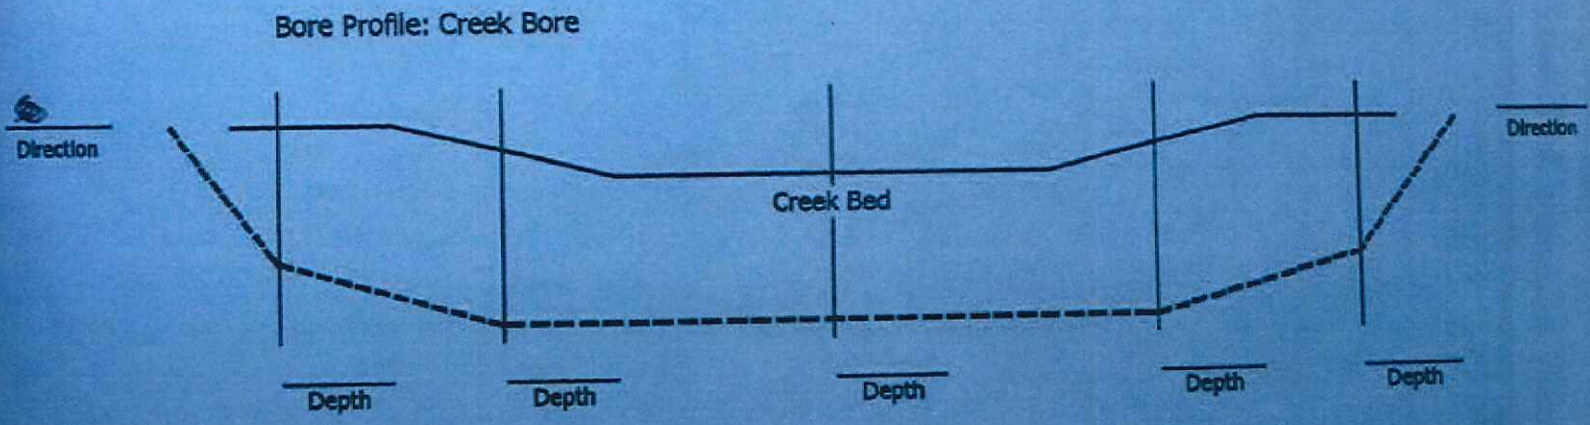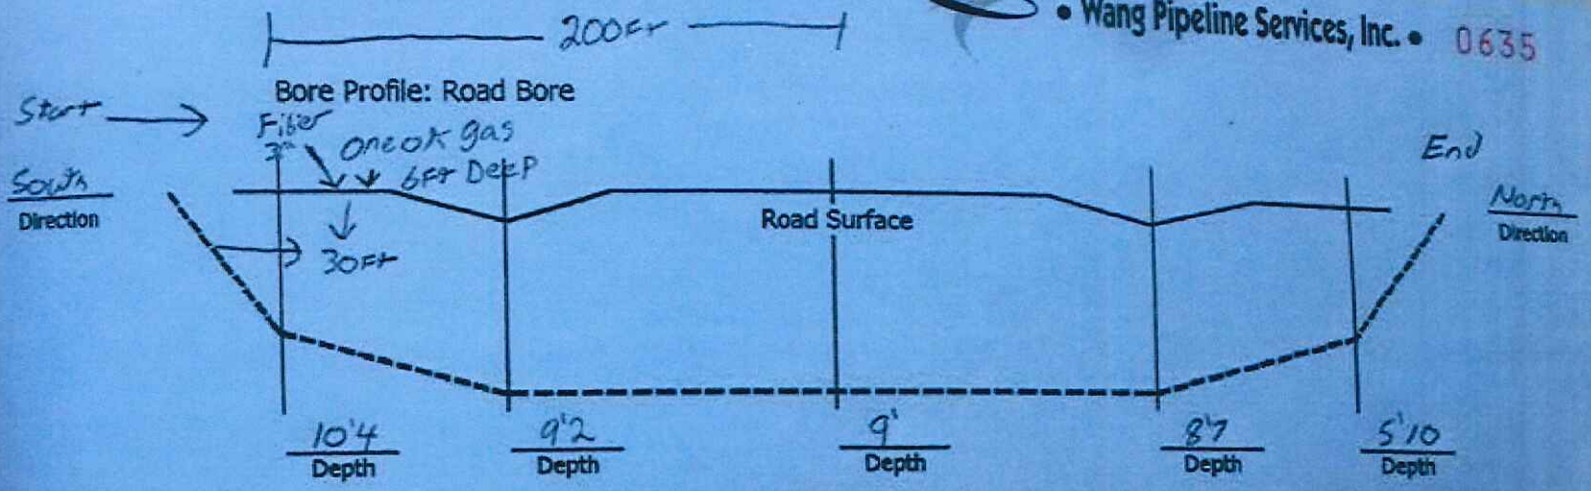

Location: SM 8" 125^D ST Bore

Bore Type: Road

Contractor: Lombro

Pipe Size & Grade 8" Steel

Length of Bore: 325 FT

Date: 8-16-13


Inspector:

Foreman:


Customer:

Kacey

Bore Profile: Road Bore

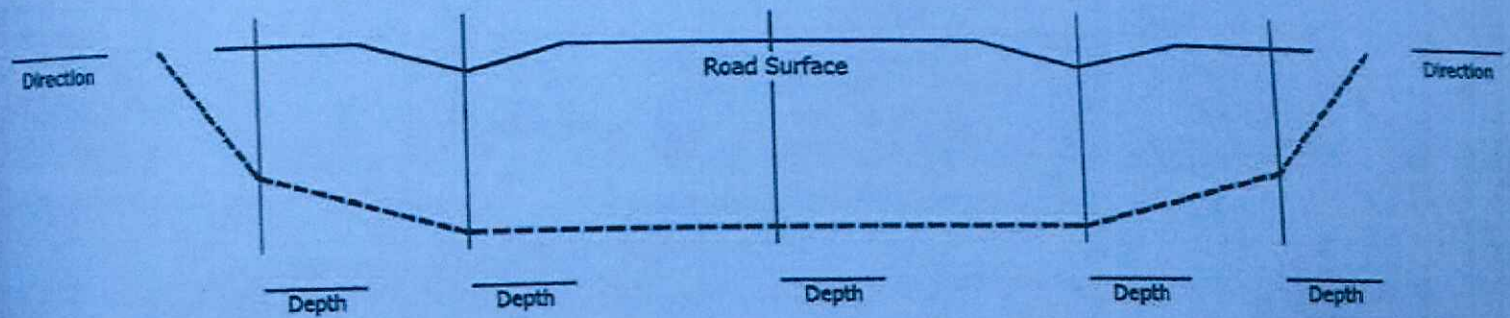

Bore Profile: Creek Bore

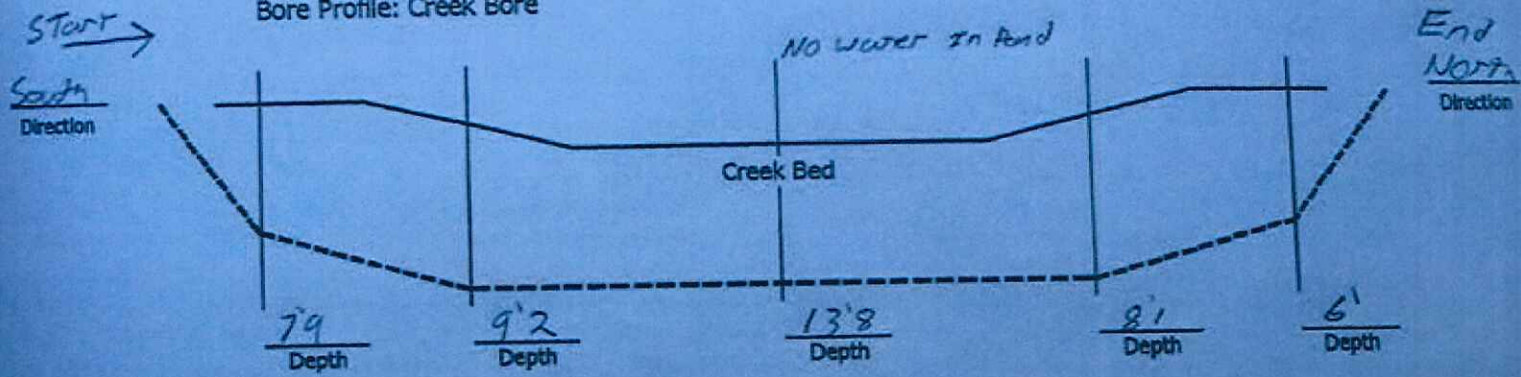


Location: SM 8" Pond south of 125th St
 Bore Type: Wet Land
 Contractor: Loebro
 Pipe Size & Grade: 8" Steel
 Length of Bore: 425 Feet

Date: 8-17-13
 Inspector: _____
 Foreman: _____
 Customer: _____

Depth Depth Depth Depth Depth

Bore Profile: Creek Bore

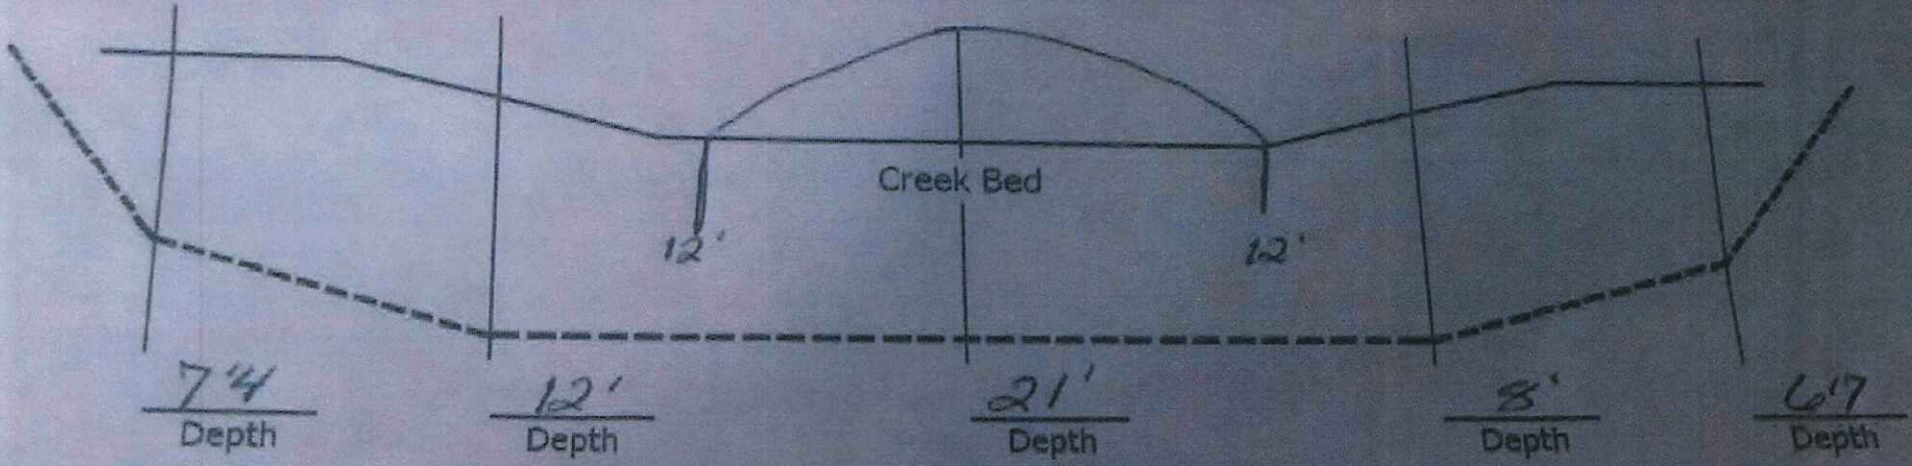

Location: STA 2003+67 - 2012+20
 Type: Wet Land
 Loc-N-Bro
 Type: 8" Steel
 Depth: 965'

Northland Boring LLC

Date: 8-20-13
 Inspector: Neil John Keith
 Foreman: Leon Bachman

Inspector: Neil John Keith

Depth


Depth

Depth

Depth

Depth

Bore Profile: Creek Bore

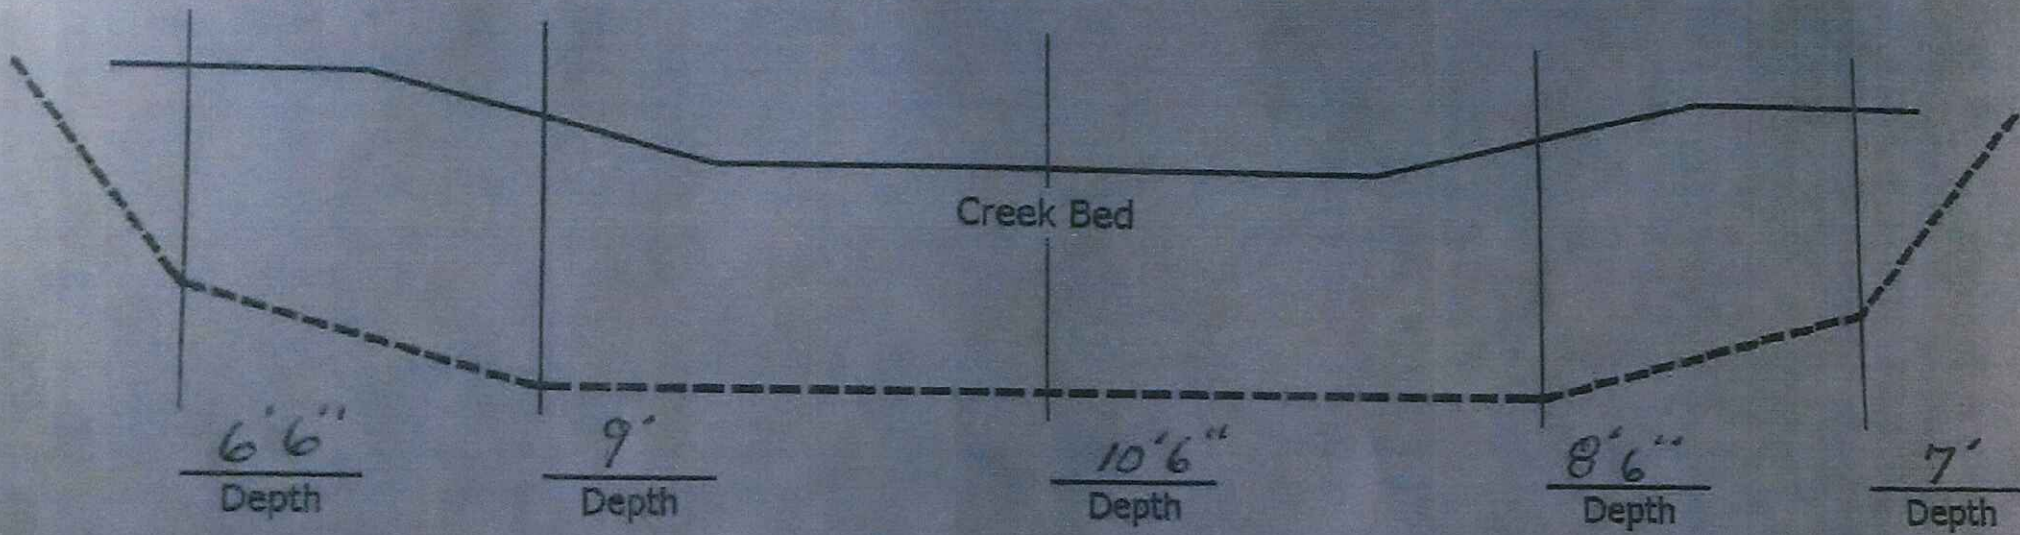

Location: STA 2016+49 - 2019+42

WET LAND CREEK

LOE - N - BRO

Type: 8" STEEL

Length: 310'

Northland Boring L


Date: 8-20-2013

Inspector: Keith J. Keith


Foreman: Brian Jones

Northland Boring

Bore Profile: Road Bore

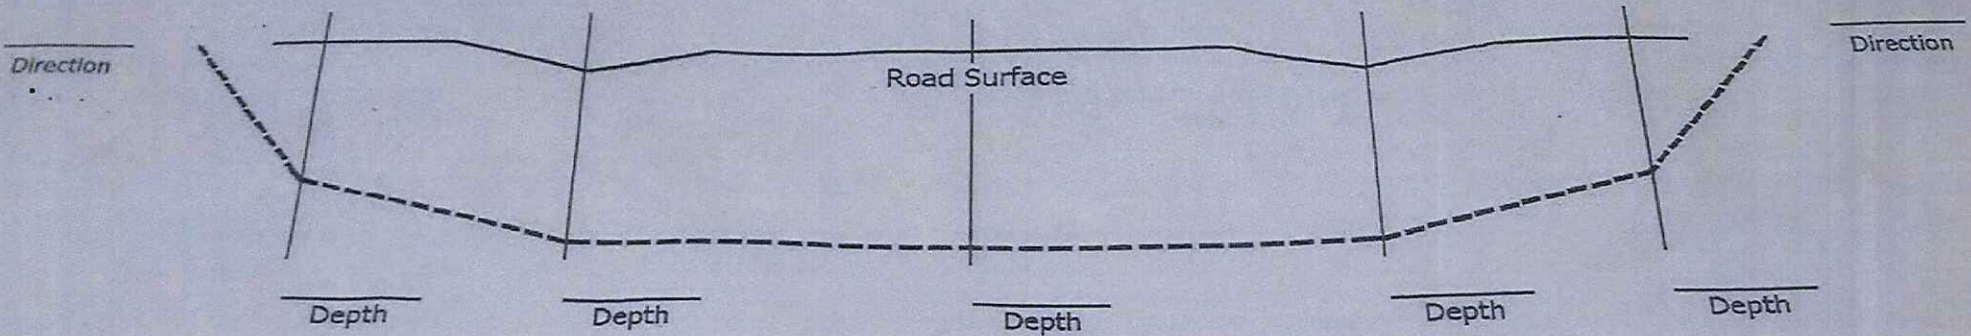



Bore Profile: Creek Bore

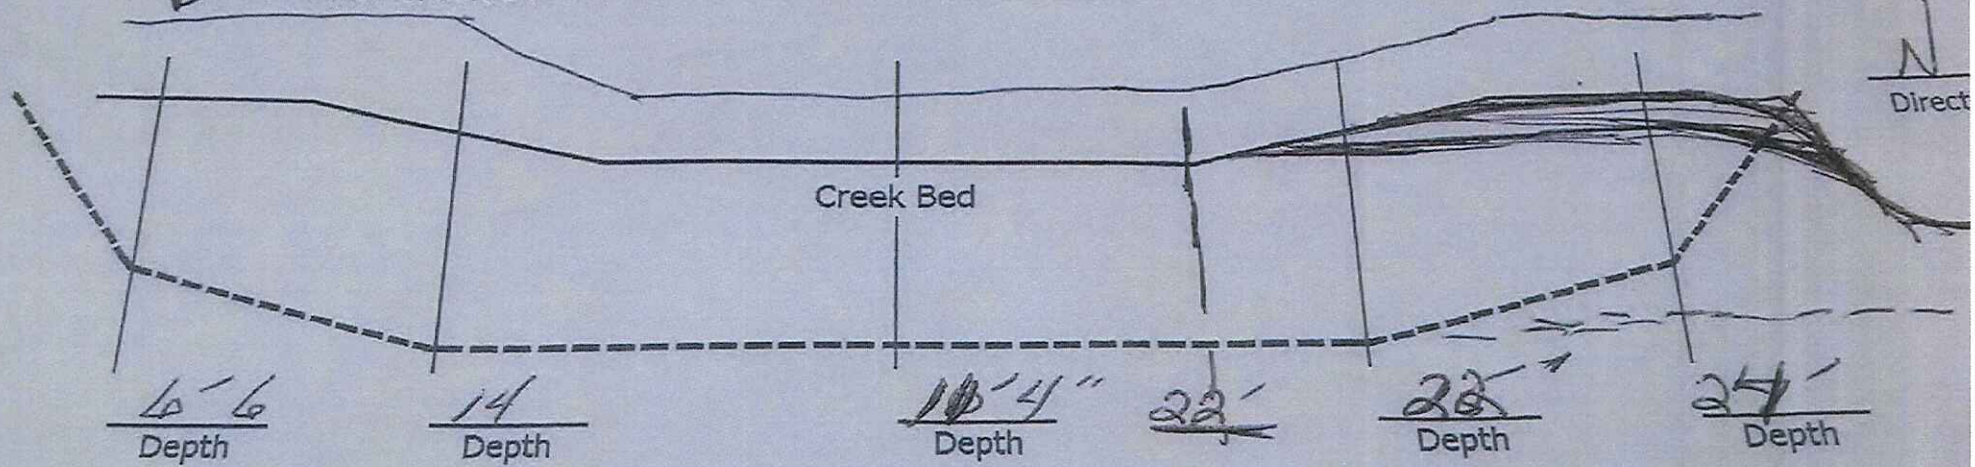

Northland Boring LLC

SUMMIT MIDSTREAM 8"
 Wetlands STA. 2032+00
 Loenbro
 e: 8" Steel
 1023'

Date: 22 Aug 2013
 Inspector: John Bedell
 Foreman: Lee C. Masten
 Julien 1023
 105

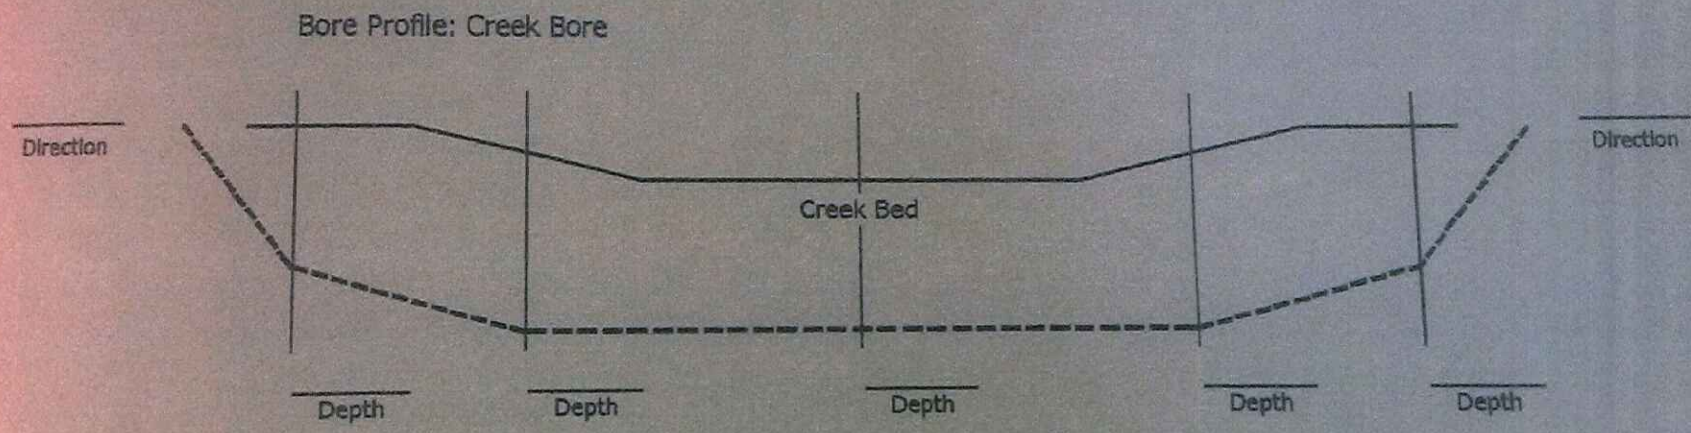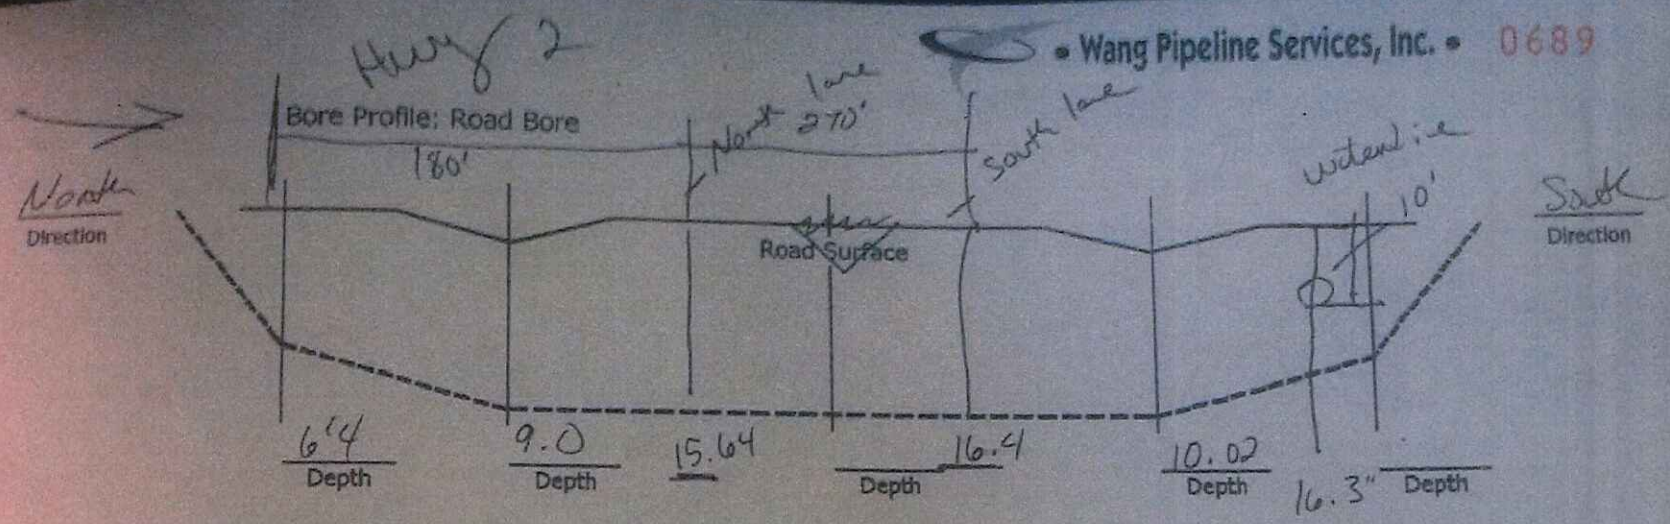

Location: *Hwy 2*

Bore Type: *Road*

Contractor: *LOENBRO*

Pipe Size & Grade: *8" Steel*

Length of Bore: *660'*


Date: *5-20-2013*

Inspector:


Foreman: *Ryan*

Customer:

Bore Profile: Road Bore

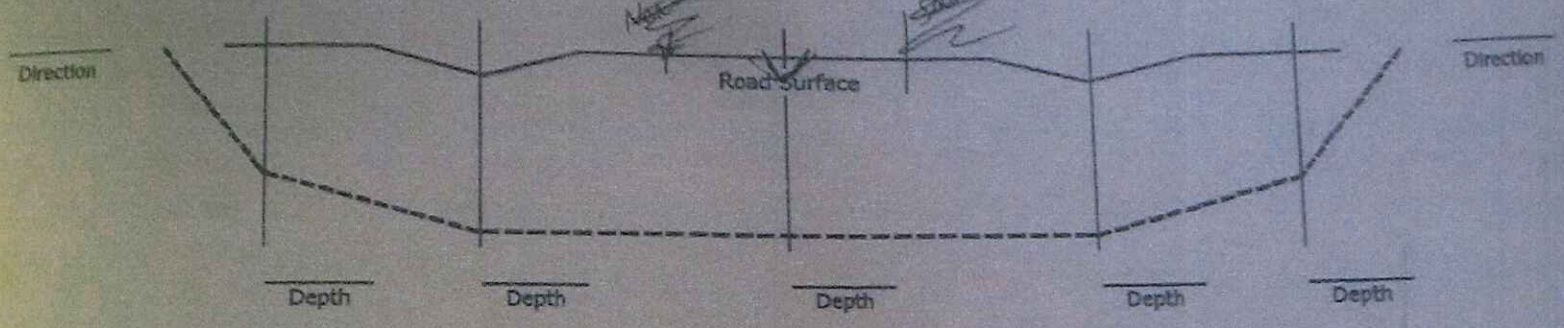



Bore Profile: Creek Bore

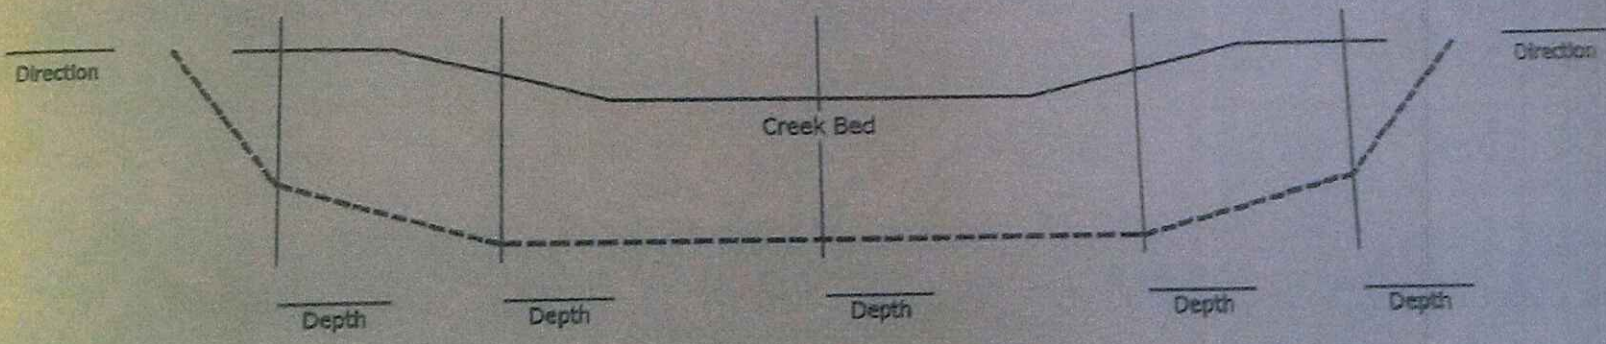

Location: 602nd St NW 21771#0
Bore Type: Road
Contractor: LOENBRO
Pipe Size & Grade: 8" steel
Length of Bore: 310'



Date: 8-20-2013
Inspector: _____
Foreman: Ryan W
Customer: _____

Bore Profile: Road Bore

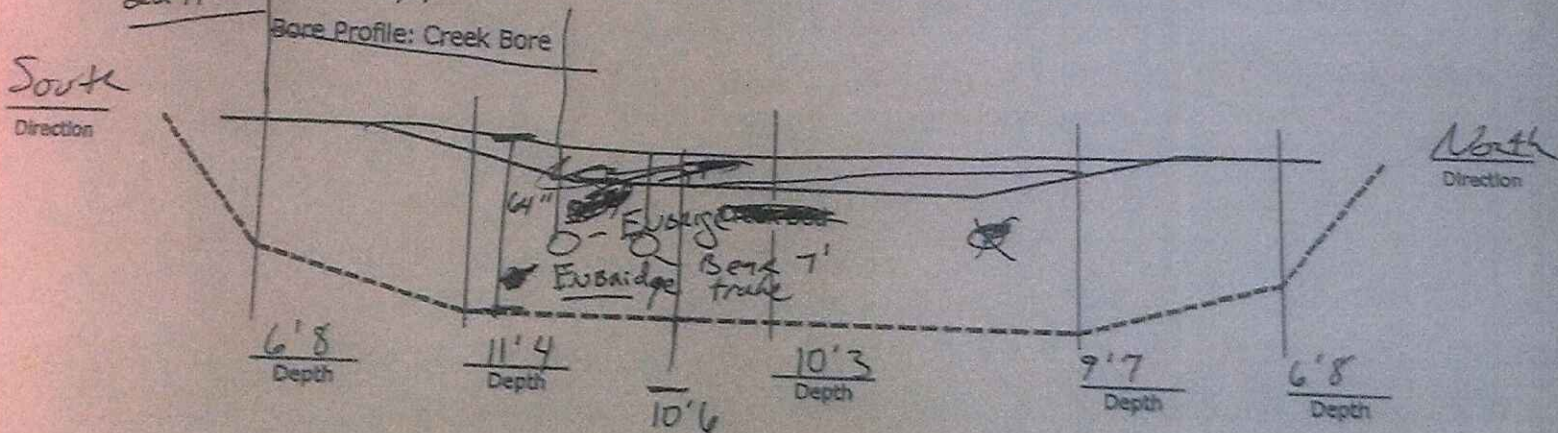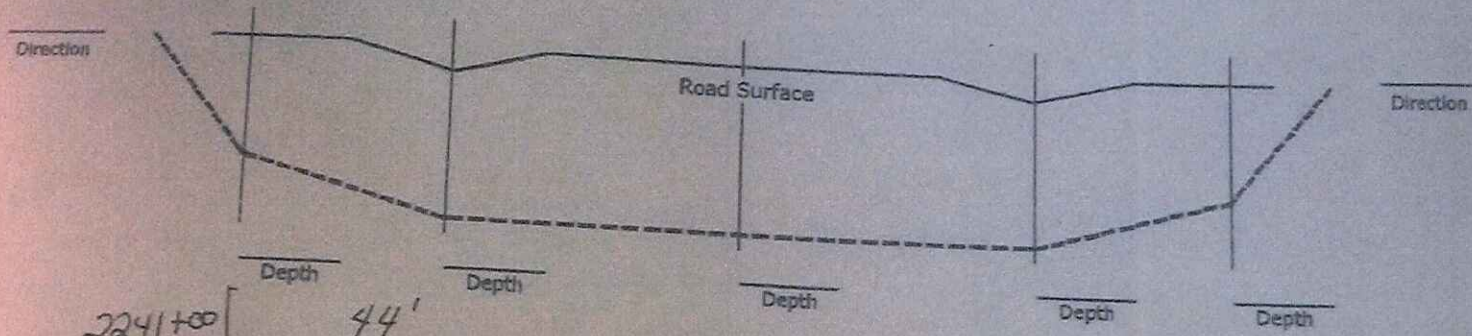

Location: 2241+00
Bore Type: EUBridge line Crossing
Contractor: LOENBRO
Pipe Size & Grade: 8" steel
Length of Bore: 120'

Date: Aug 24th
Inspector: _____
Foreman: Ryan
Customer: _____

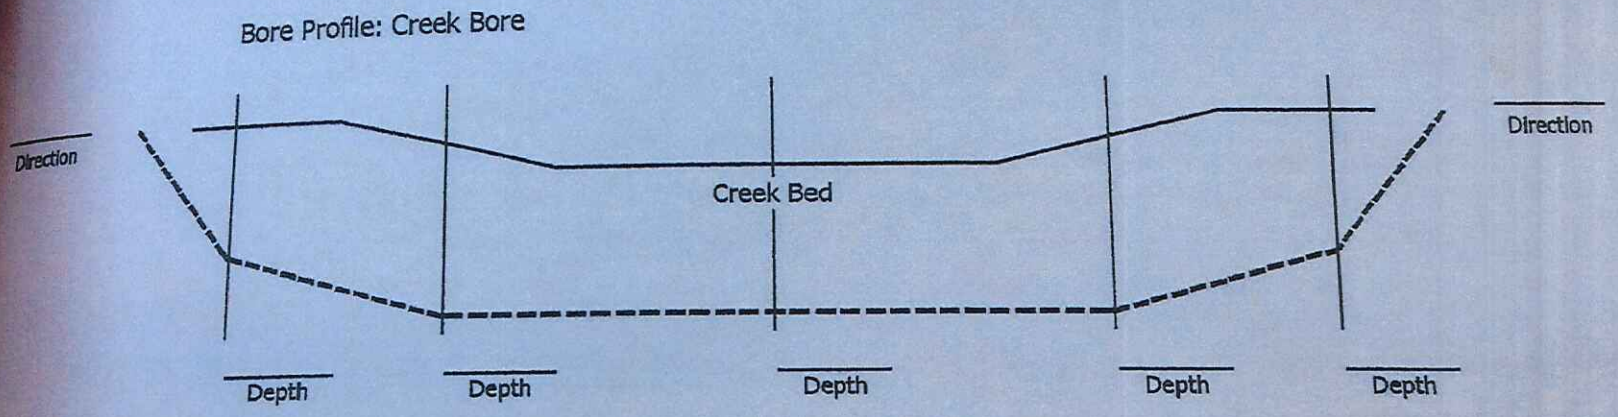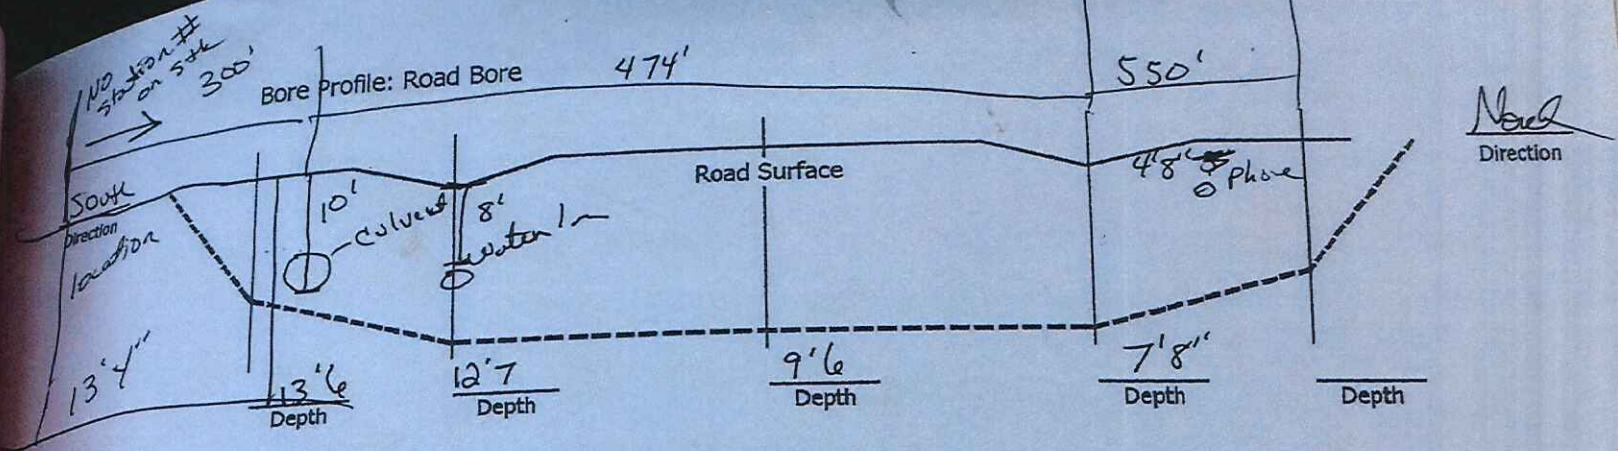

Location: Location/Hay EPPING

Bore Type: Road

Contractor: LOENBRO

Pipe Size & Grade 8" steel

Length of Bore: 600'


Date: Sept 5th

Inspector: _____

Foreman: [Signature]



Customer: _____

Bore Profile: Road Bore

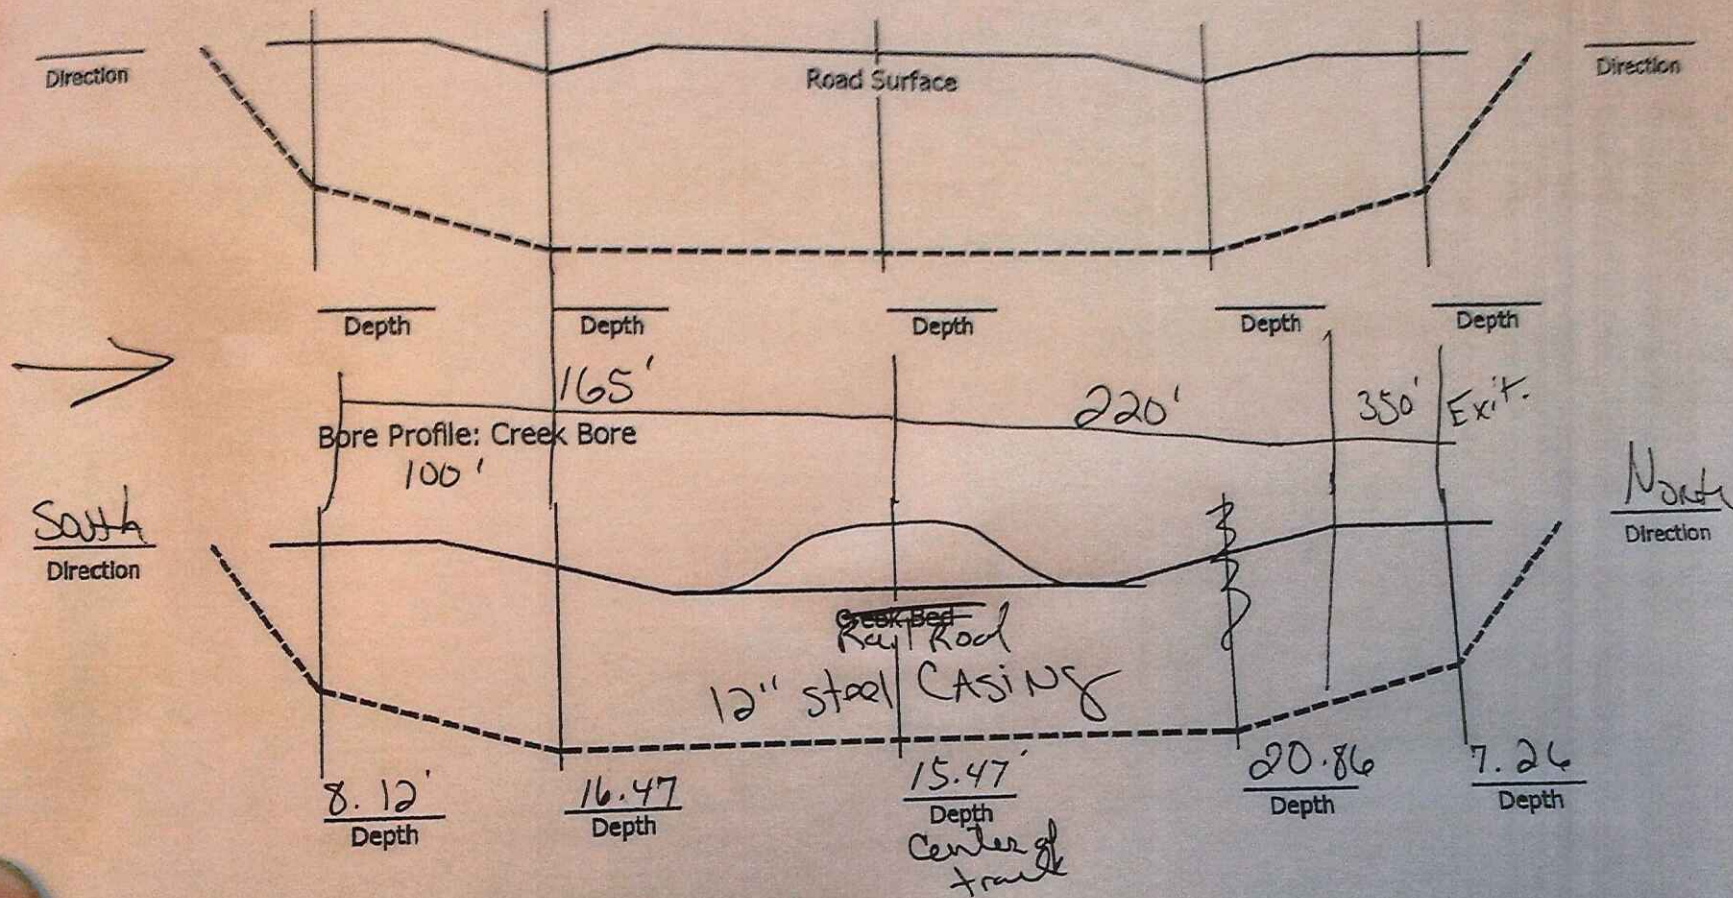

Location: Epping Rail Road Crossing
 Bore Type: RR 8" Sm steel Project
 Contractor: LOENBRO
 Pipe Size & Grade: 12" steel CASING
 Length of Bore: 350'

Date: 9-17-2013
 Inspector: _____
 Foreman: Ryan Way
 Customer: _____

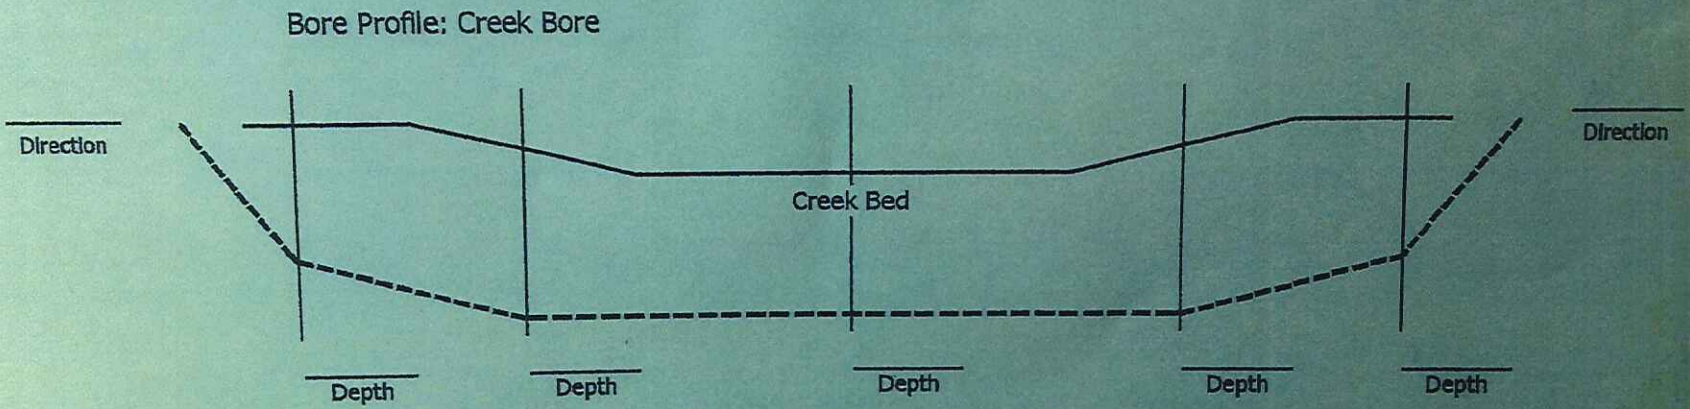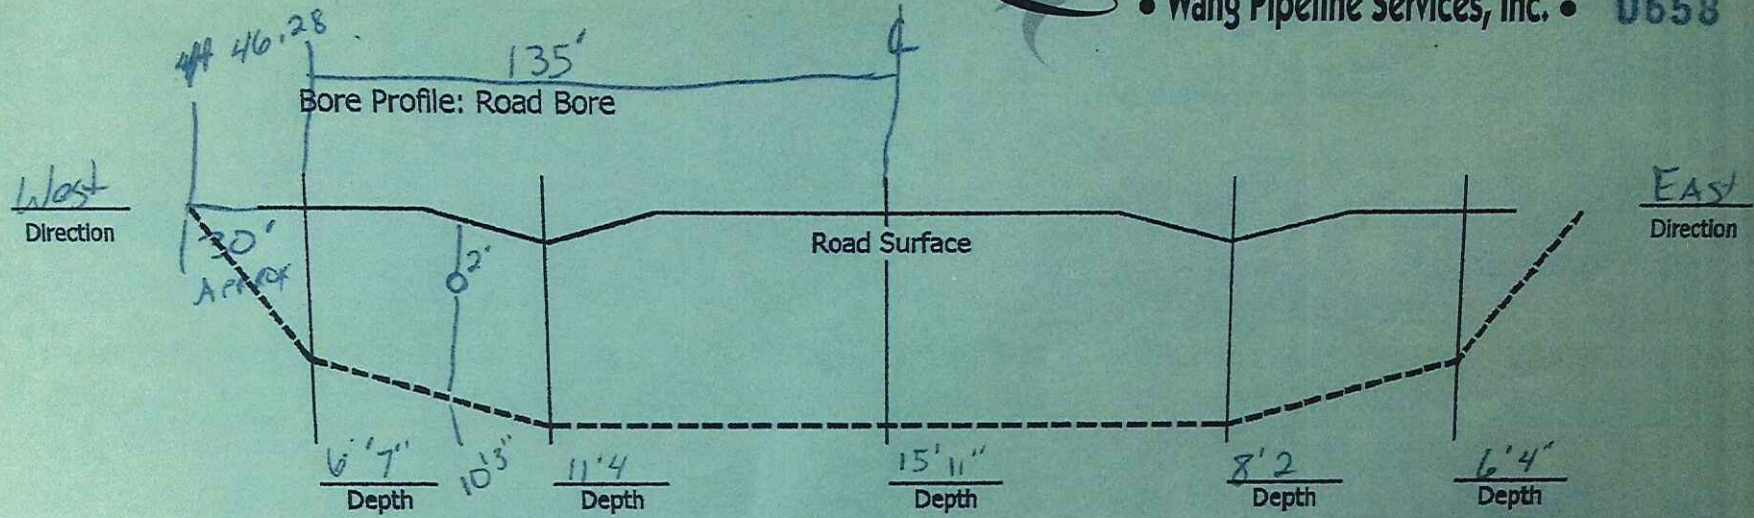

Location: 4+46.28

Bore Type: Hwy 85'

Contractor: LOENBRD

Pipe Size & Grade: 8" steel

Length of Bore: 300'


Date: June 27th

Inspector: _____


Foreman: [Signature]

Customer: _____

Bore Profile: Road Bore

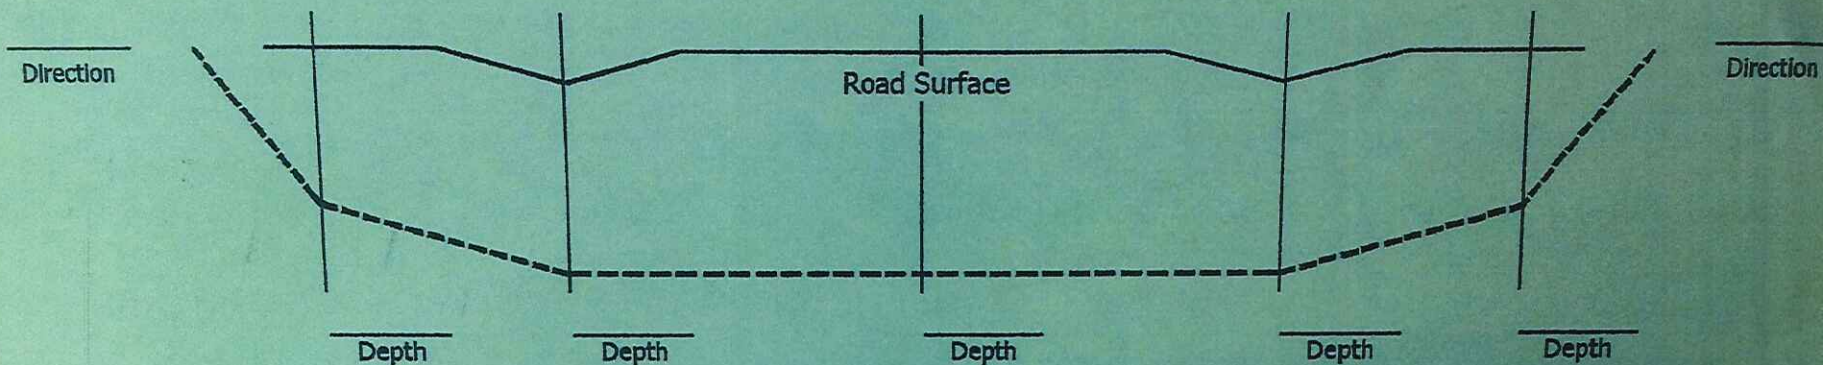


Bore Profile: Creek Bore

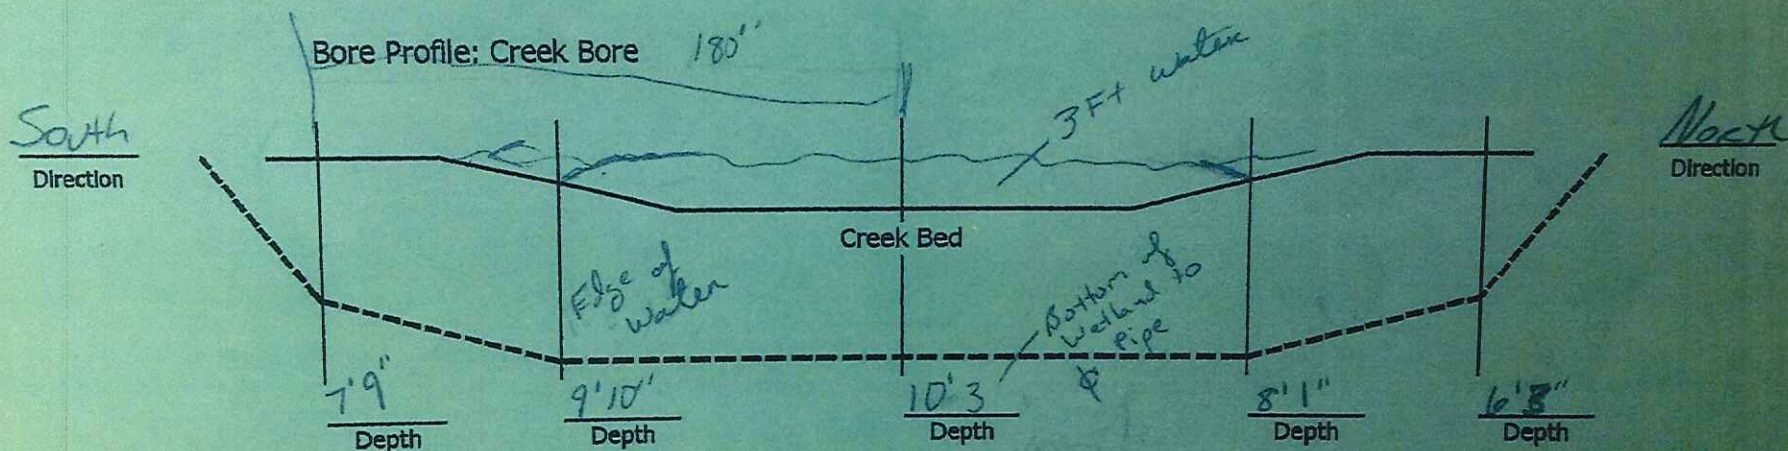


Location: 34+54.65 SM Project
 Bore Type: Wetland
 Contractor: _____
 Pipe Size & Grade: 3" steel
 Length of Bore: 450'

Date: JUNE 26th
 Inspector: _____
 Foreman: Ryan Wang
 Customer: _____

Bore Profile: Road Bore

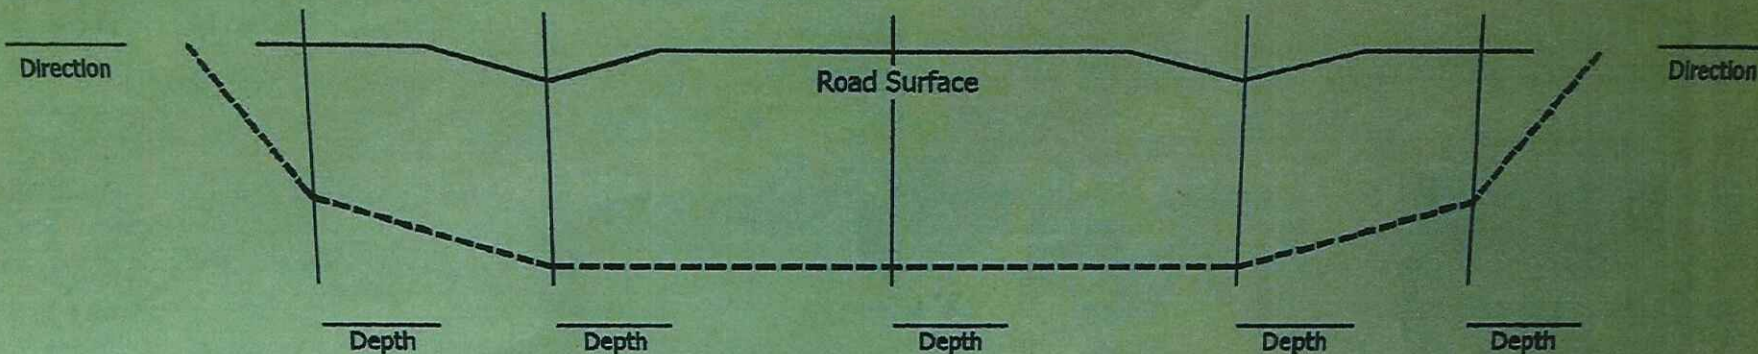

Bore Profile: Creek Bore

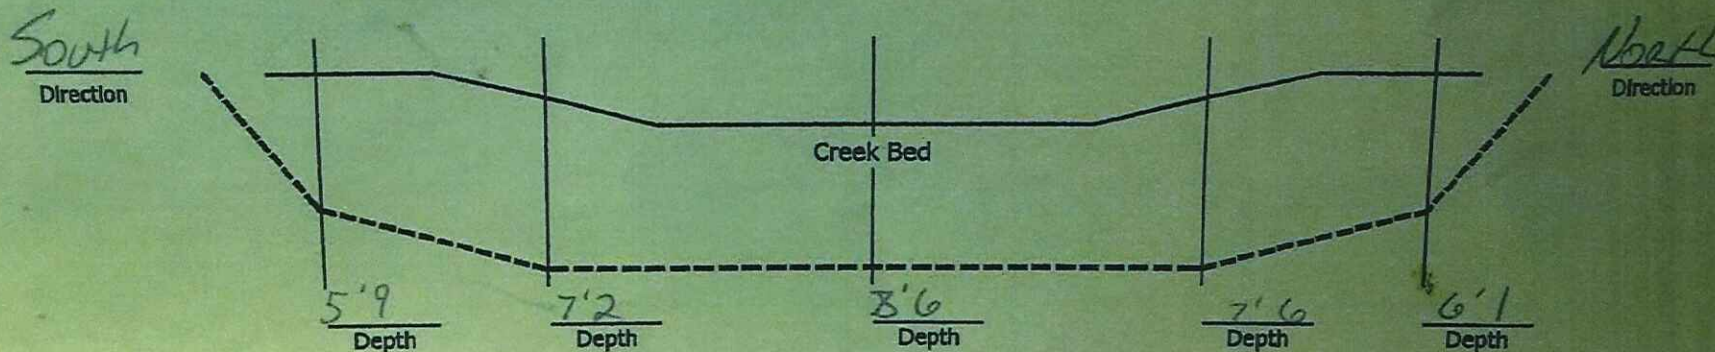

Location: St# 34154.65 S/W Project

Bore Type: Wetland

Contractor: LOENBRO

Pipe Size & Grade: 8" steel

Length of Bore: 450'

Date: June 18th


Inspector: [Signature]

Foreman: [Signature]


Customer: CJ Fisher



Bore Profile: Road Bore

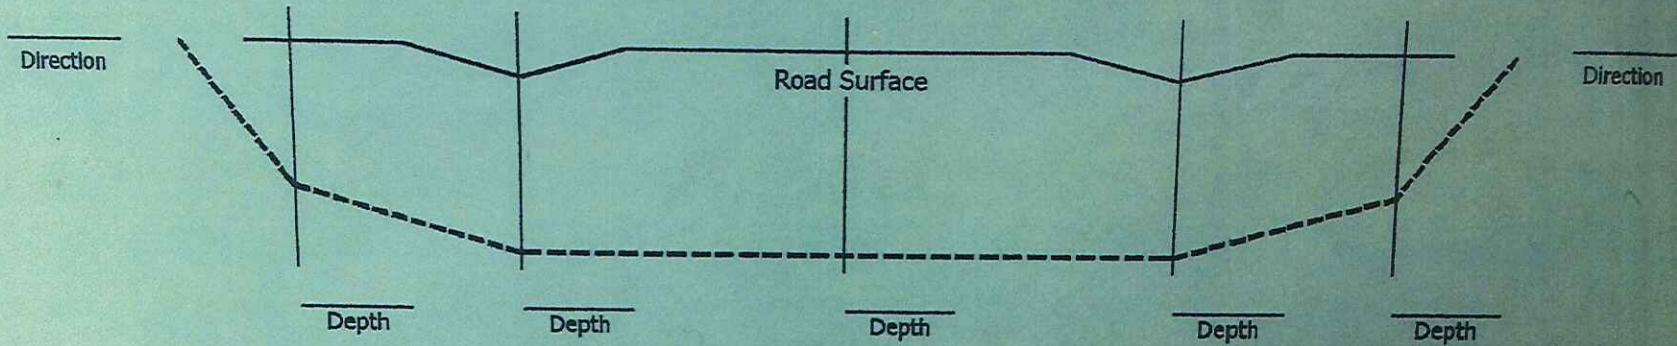


Bore Profile: Creek Bore

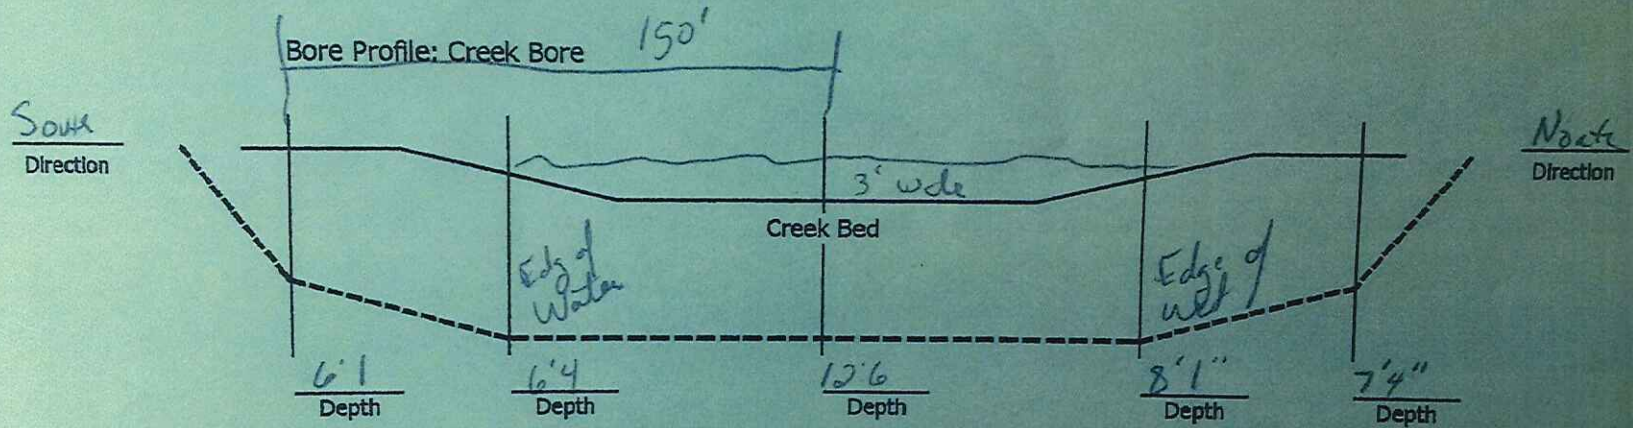


Location: 410 + 89.24 SM Project
Bore Type: Wetland
Contractor: LOENBRO
Pipe Size & Grade: 3" steel
Length of Bore: 300'

Date: JUNE 25th
Inspector:
Foreman: Ryan Wang
Customer:

Bore Profile: Road Bore

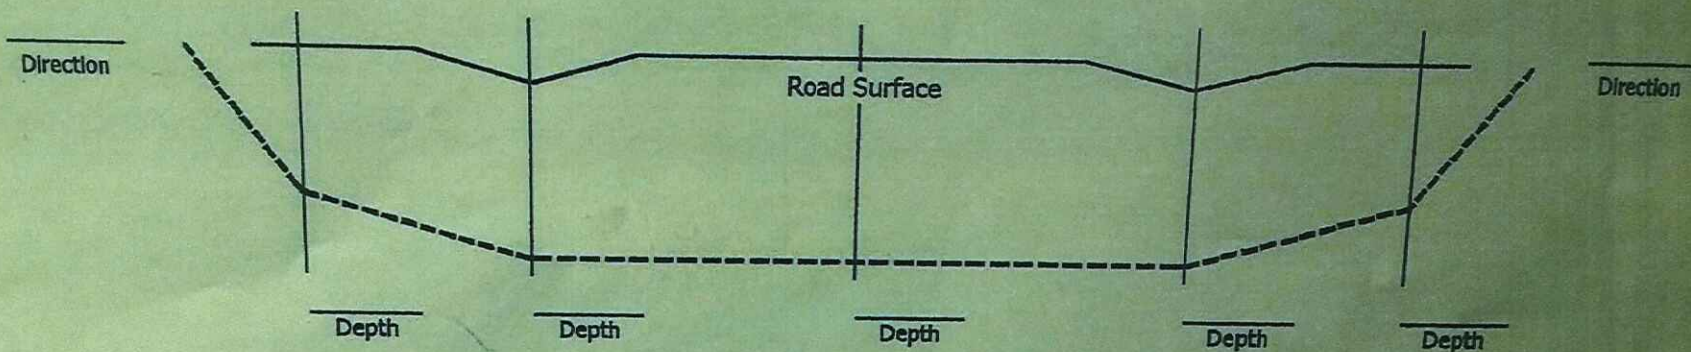

Bore Profile: Creek Bore

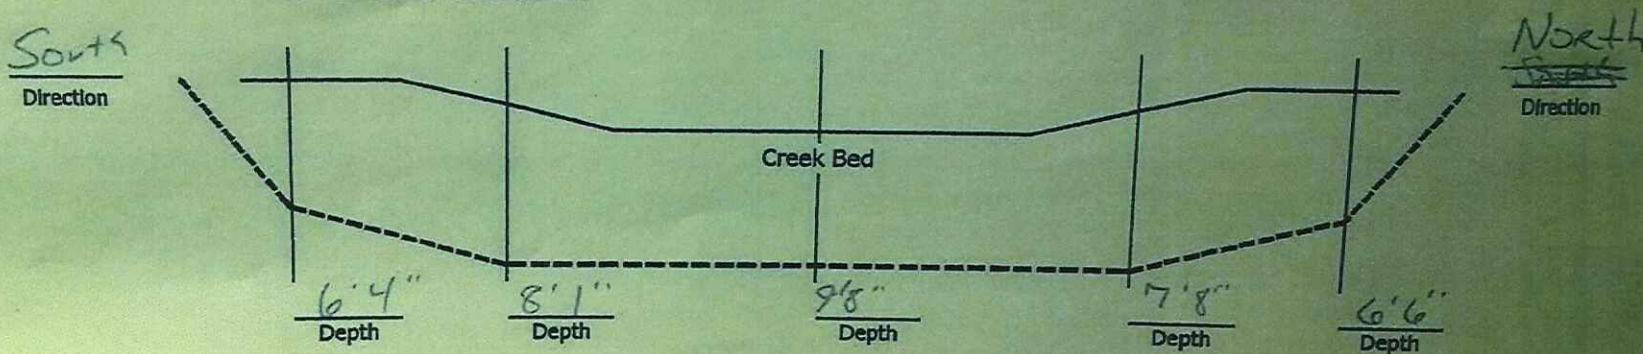

Location: St # 40+89.24 SM Project

Bore Type: Wetland

Contractor: LOENBRD

Pipe Size & Grade: 8" Steel SM

Length of Bore: 300'


Date: June 18th

Inspector: [Signature]


Foreman: [Signature]

Customer: [Signature]

Bore Profile: Road Bore


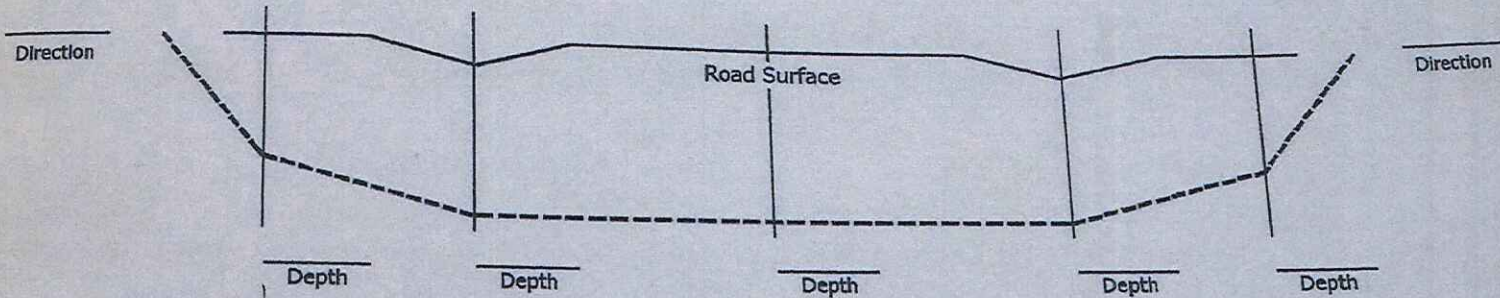


Bore Profile: Creek Bore

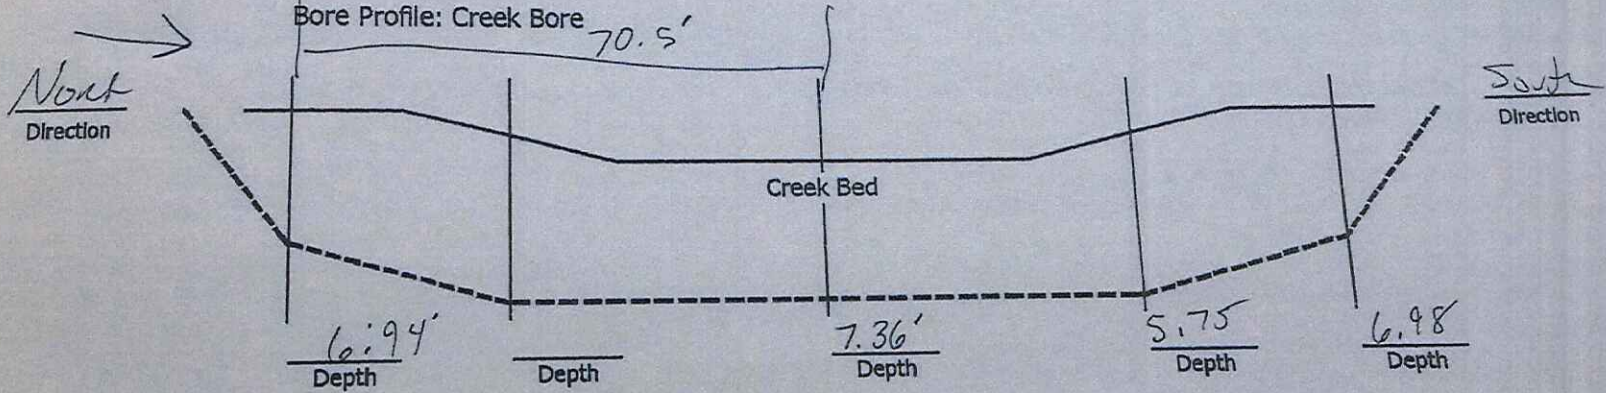



Location: 303+69.2 south of 85
 Bore Type: Wetland
 Contractor: LOENBRO
 Pipe Size & Grade: 8" Steel
 Length of Bore: 100'

Date: July 9th
 Inspector:
 Foreman: Ryan Wolf
 Customer:

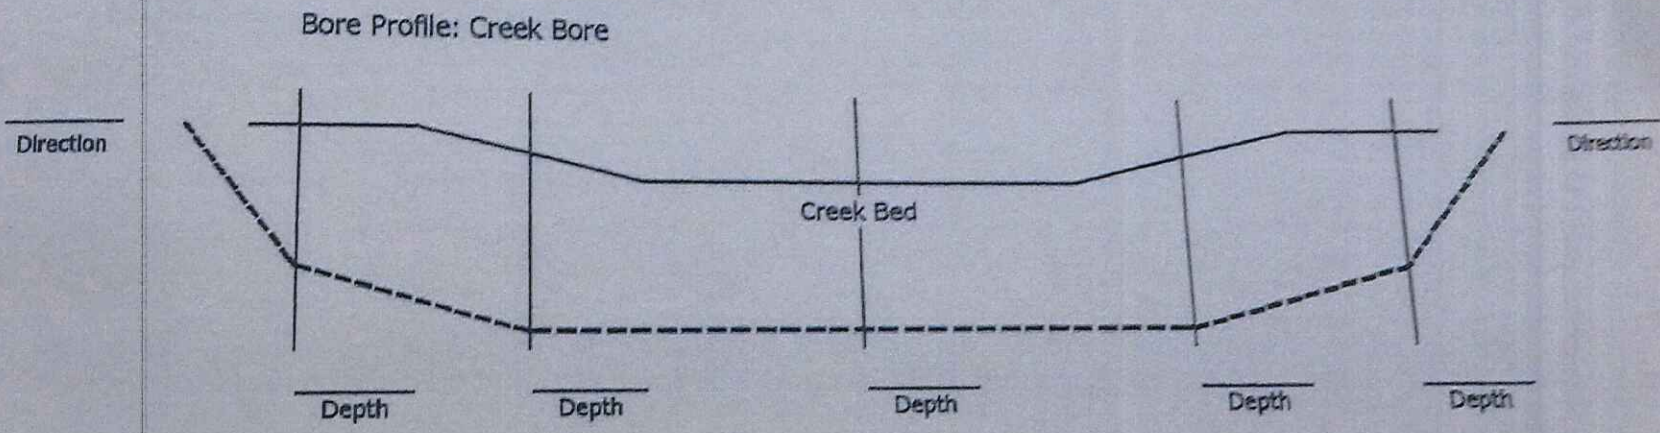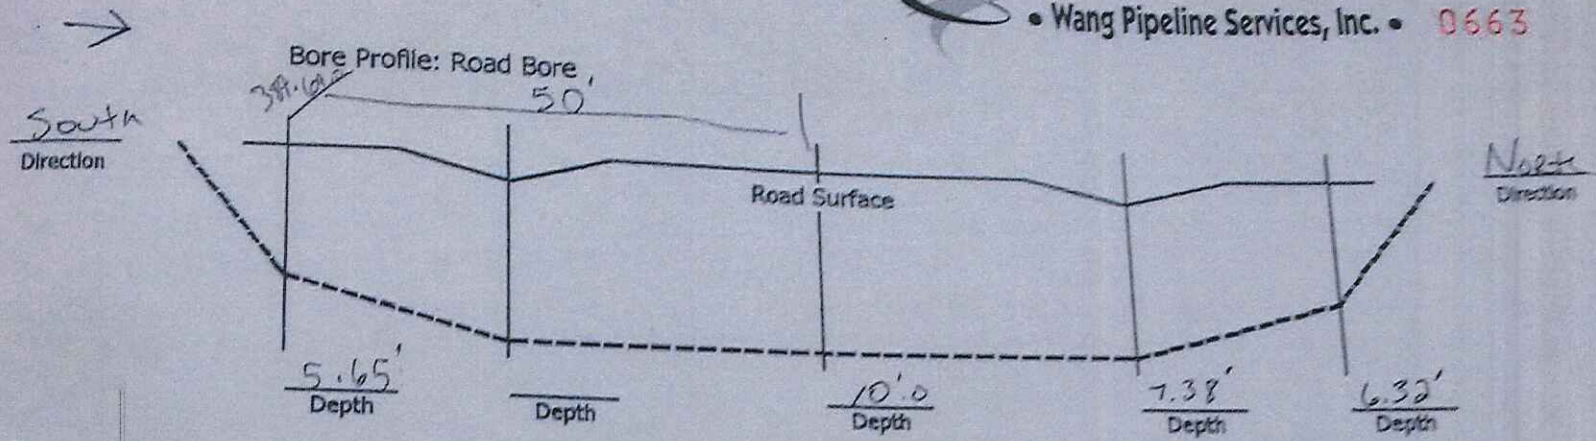

Location: 389+69 0
Bore Type: Road
Contractor: LOENBRO
Pipe Size & Grade: 8" steel
Length of Bore: 120'

Date: July 6th
Inspector:
Foreman: Ryan Wa
Customer:

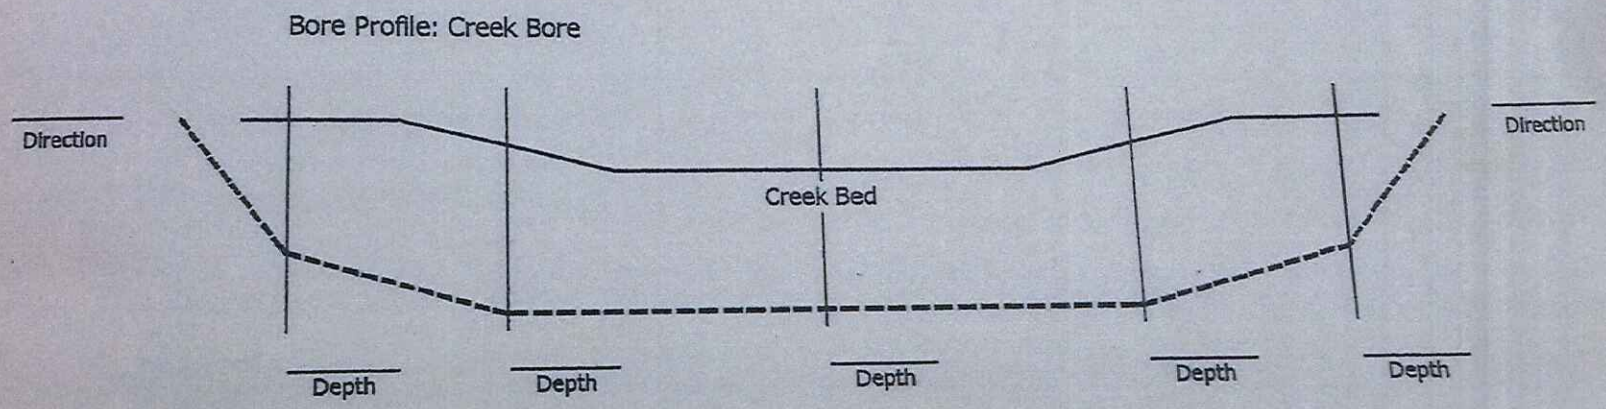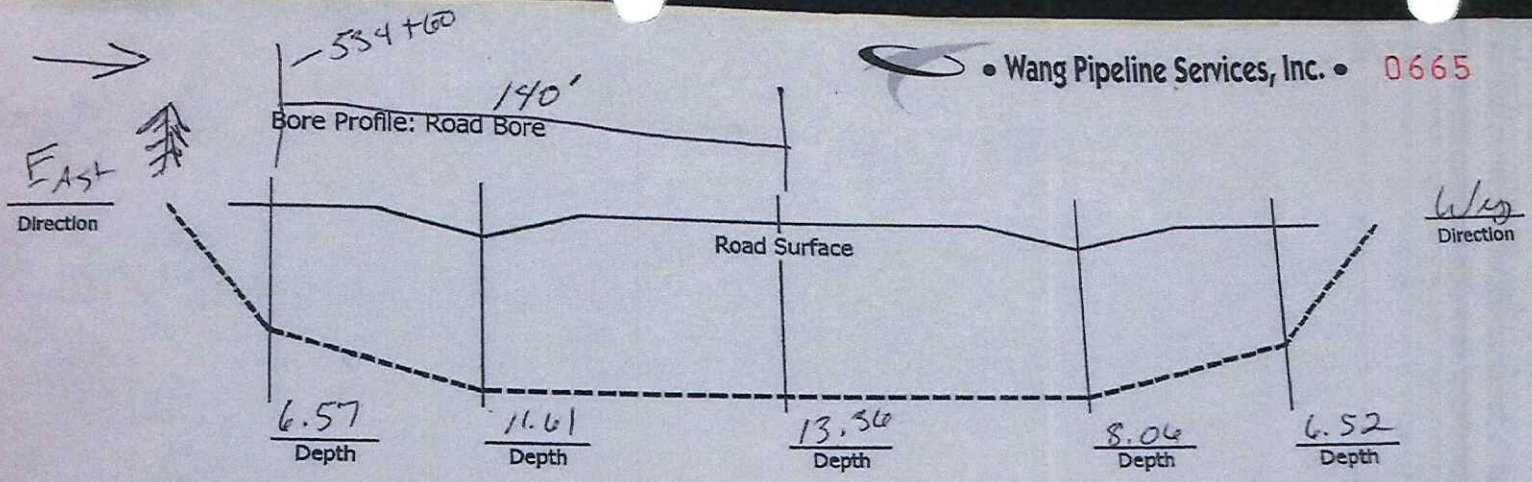

Location: 534+60

Bore Type: Road Next to trees

Contractor: LOENBKO

Pipe Size & Grade: 8" steel



Length of Bore: 250'

Date: 7/10/2015

Inspector:

Foreman: Ryan Wang

Customer:

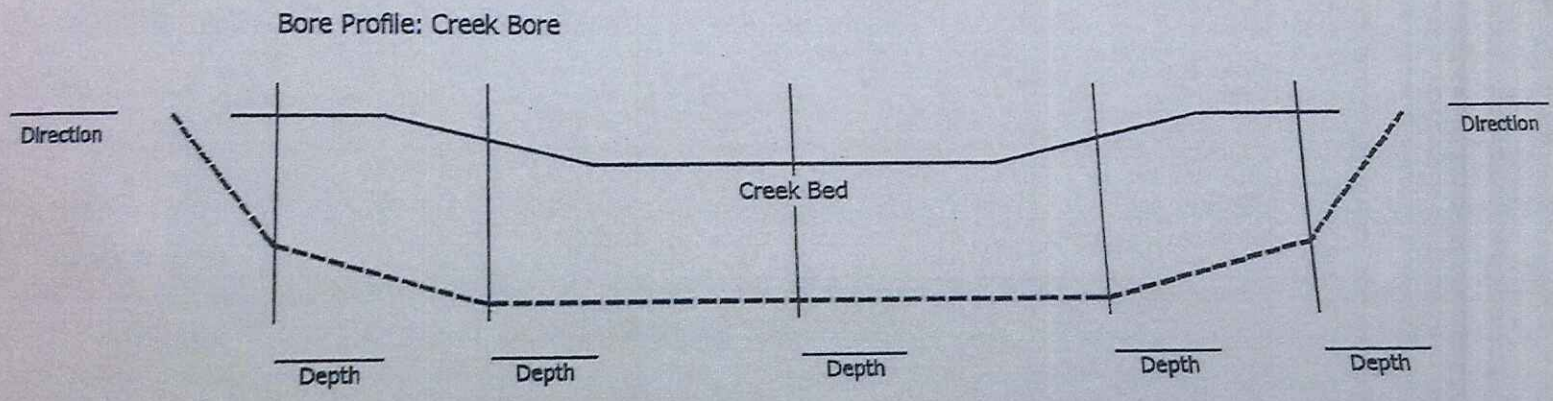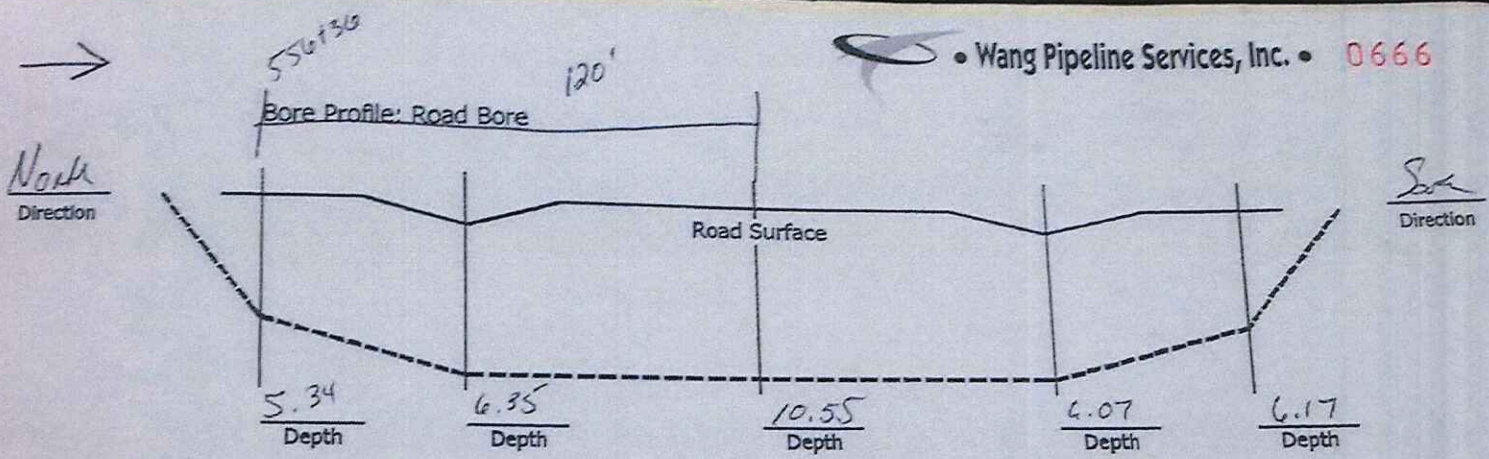

Location: 556+36

Bore Type: Road

Contractor: LOENBRO

Pipe Size & Grade: 8" steel



Length of Bore: 200'

Date: July 12th

Inspector:



Foreman: Ryan Hef

Customer:

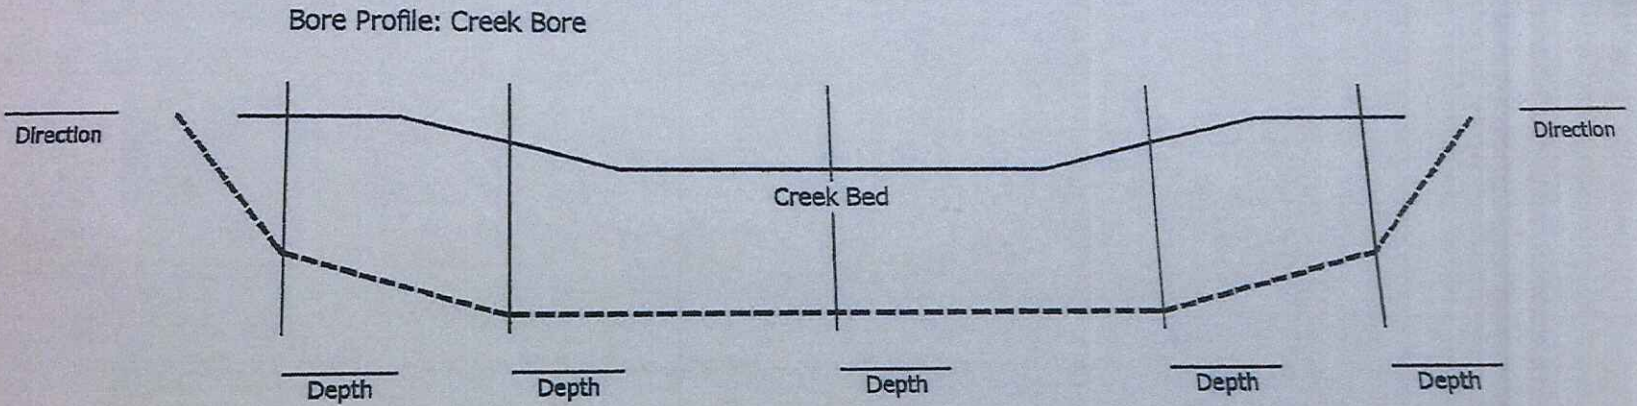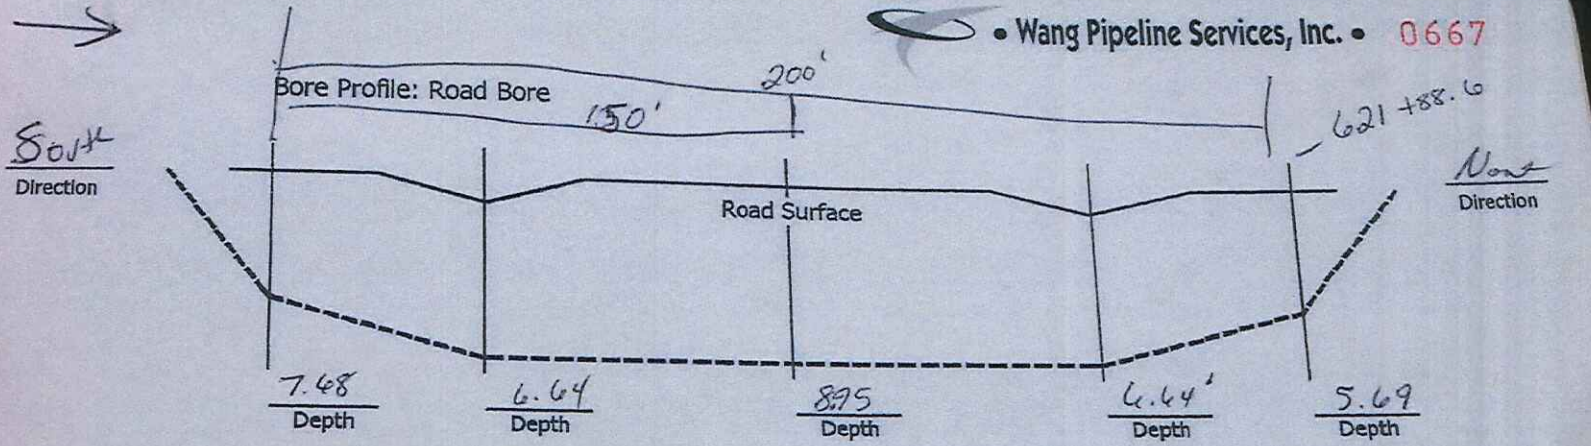

Location: 621 + 88.6
 Bore Type: Road / May Beles
 Contractor: LOEWBRO
 Pipe Size & Grade: 8" steel
 Length of Bore: 200'

Date: July 12
 Inspector:
 Foreman: Ryan Wang
 Customer:

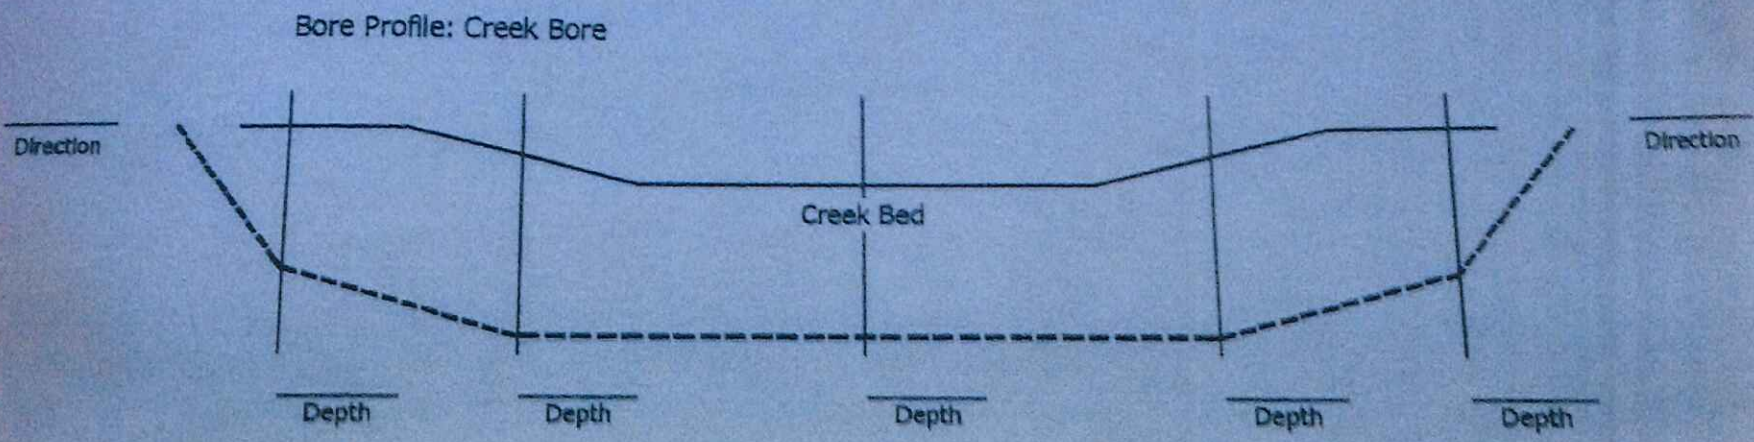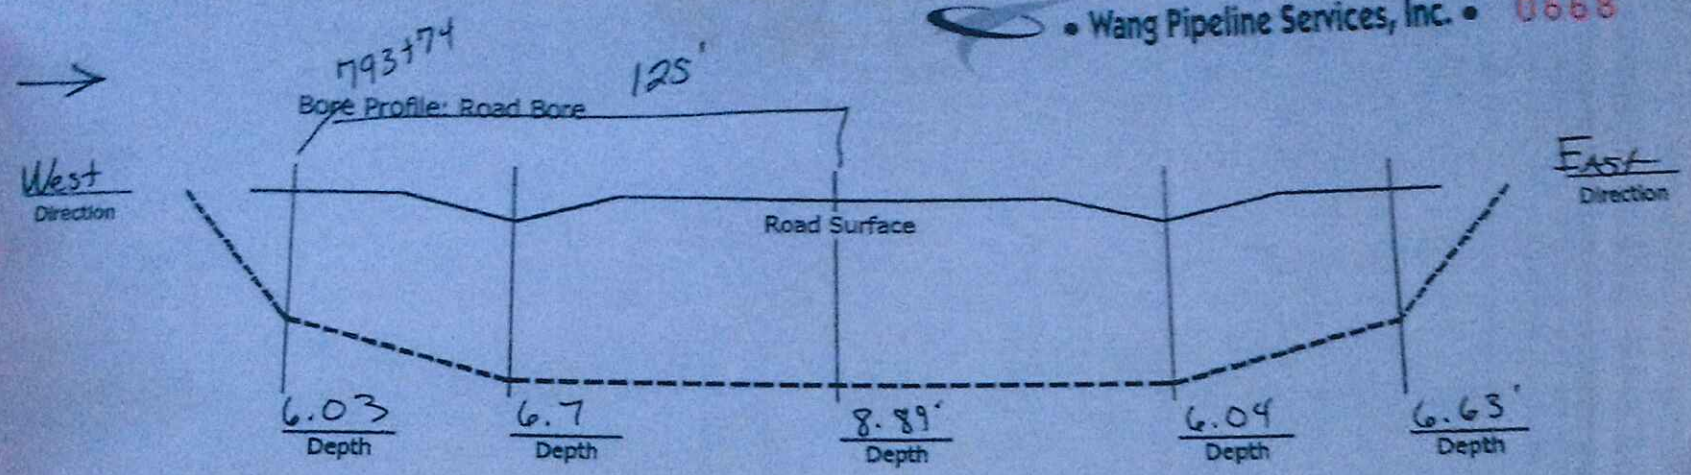

Location: 793+74

Bore Type: 133rd Ave County Rd

Contractor: LOENBRD

Pipe Size & Grade: 8" steel


Length of Bore: 250'

Date: July 17th

Inspector:

Foreman: Ryan Wang

Customer:

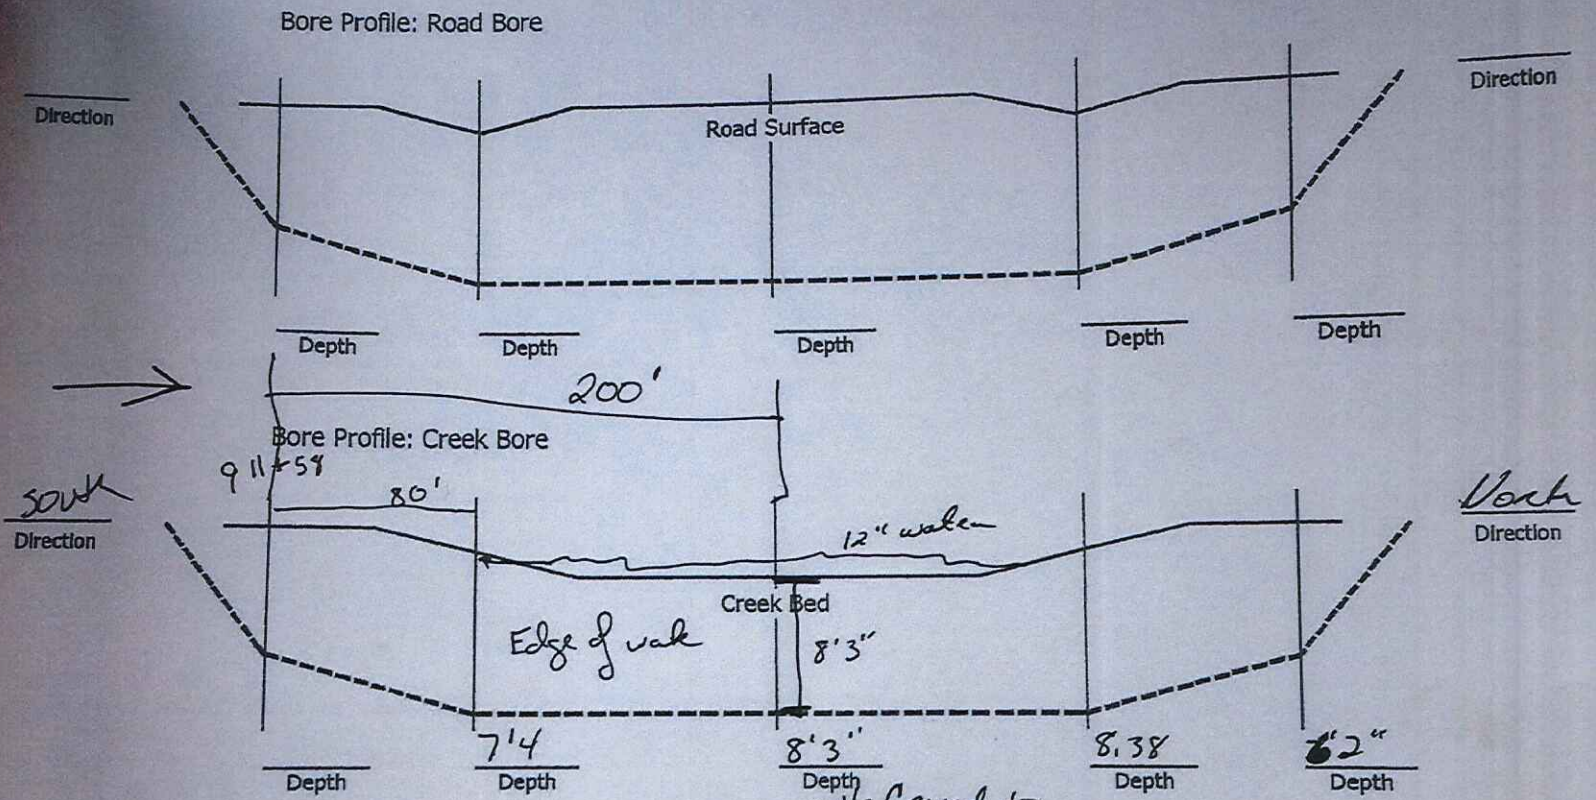

Ground to
~~bed~~ ϕ of pipe

Location: 911+58

Bore Type: Wetland

Contractor: LOENBRO

Pipe Size & Grade 8" steel



Length of Bore: 400'

Date: 7-23-2013

Inspector:

Foreman: Ryan Dy

Customer:

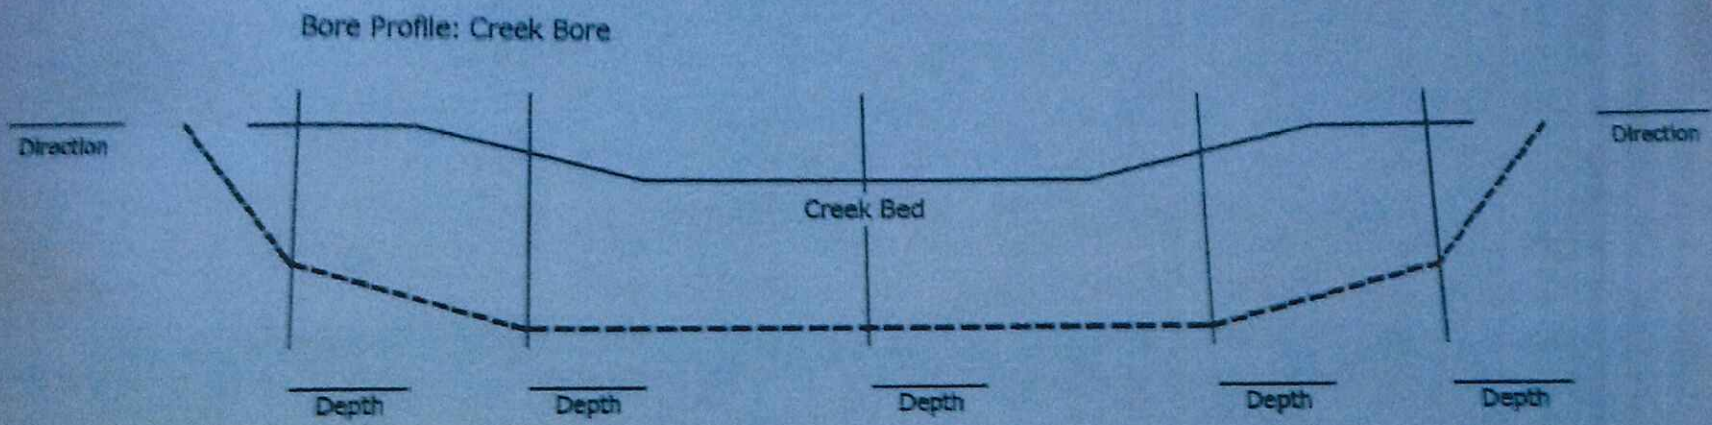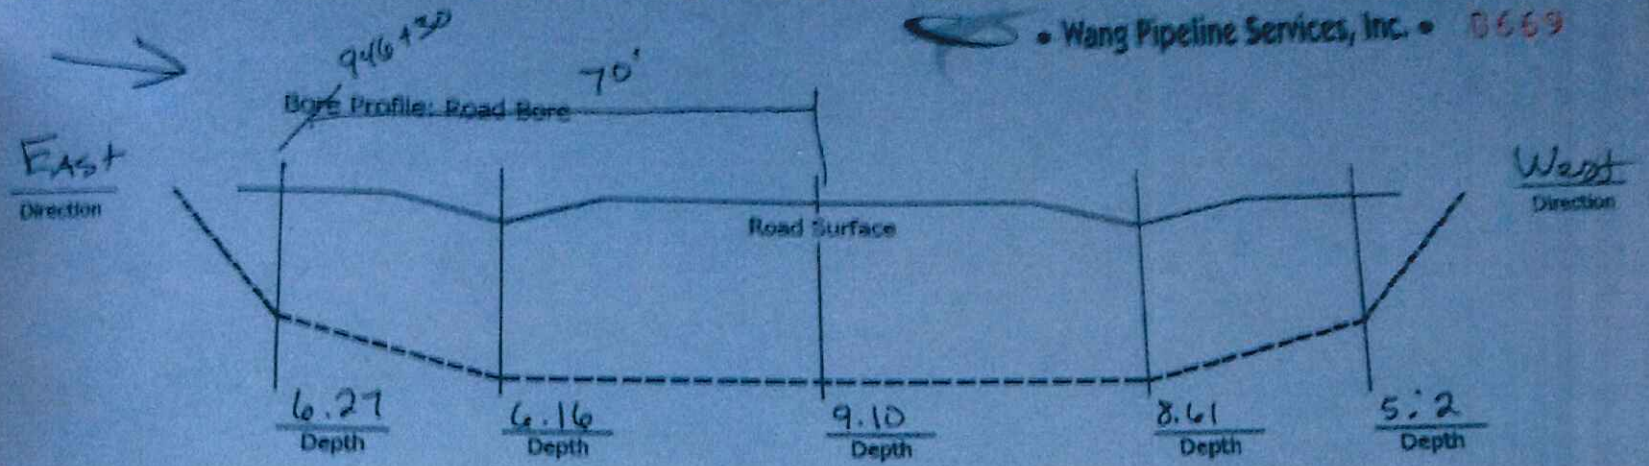

Location: 131st Ave. 946+30

Bore Type: Road

Contractor: LOENBRD

Pipe Size & Grade: 8" steel



Length of Bore: 150'

Date: July 28th 19th

Inspector:

Foreman: Roger [Signature]

Customer:

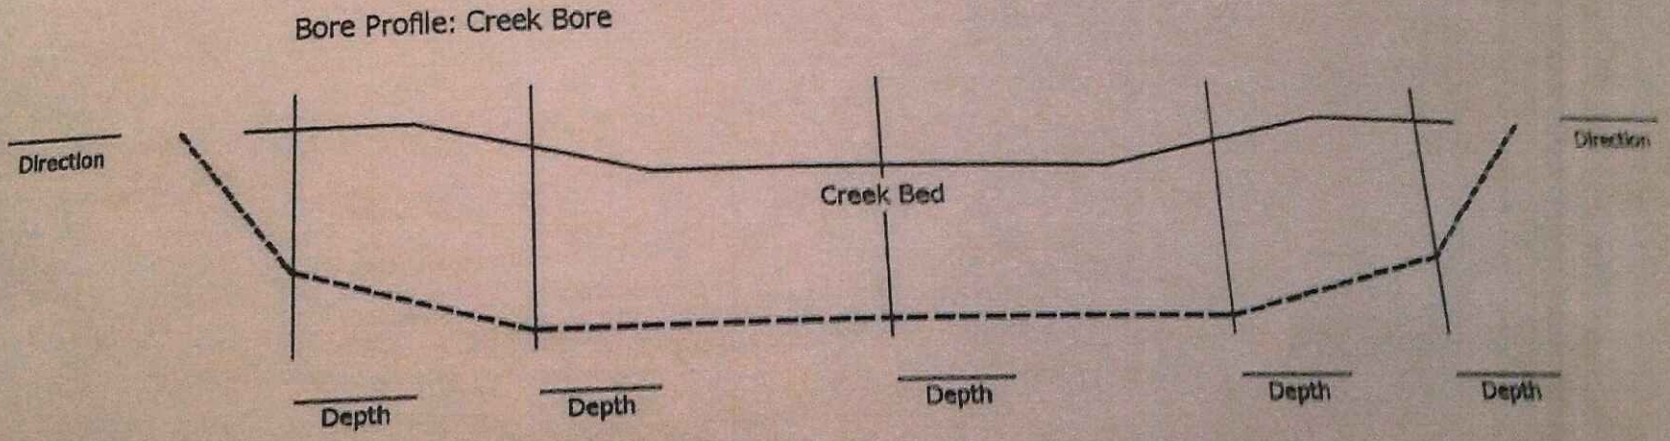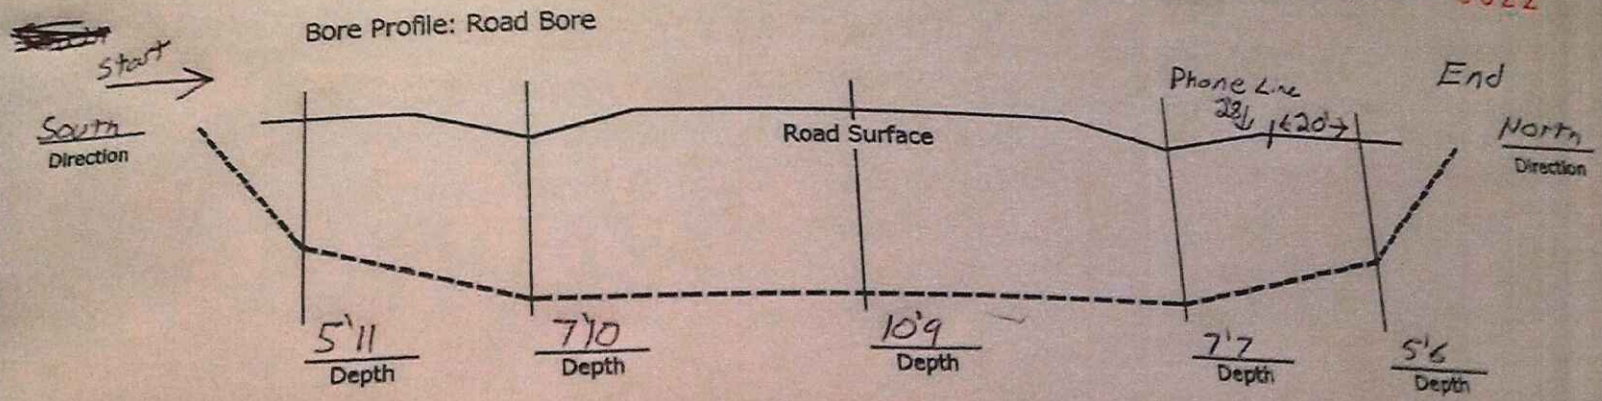

Location: SM 8in, Hwy 50 Sta # 1009+50

Bore Type: Road

Contractor: Loebro

Pipe Size & Grade 8" steel



Length of Bore: 120 Feet

Date: 7-24-13

Inspector:

Foreman:

Customer:

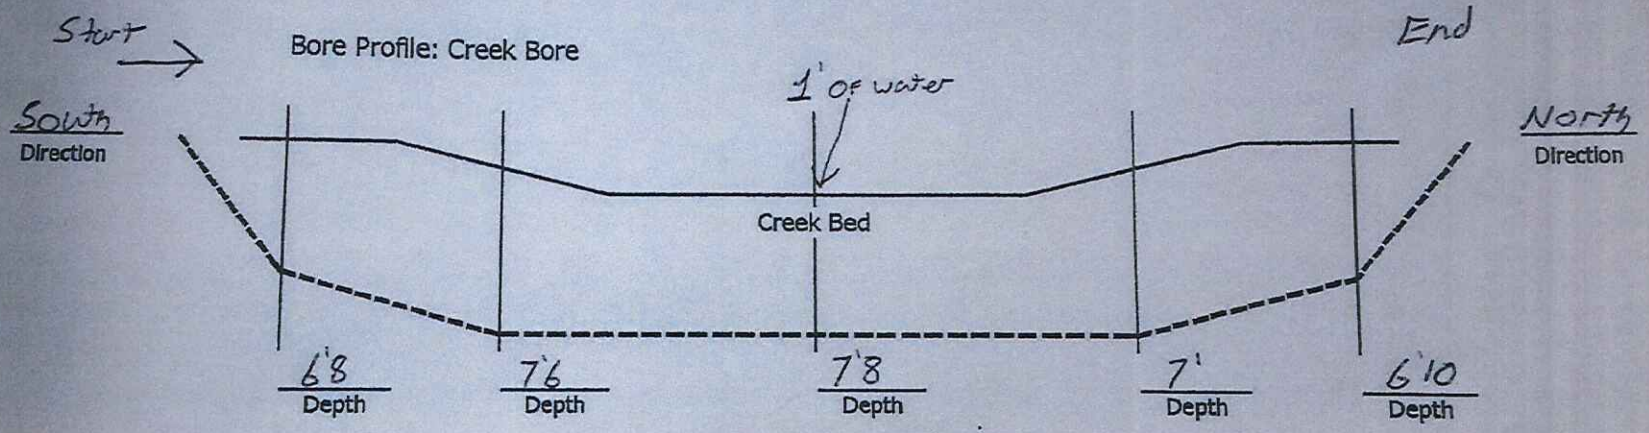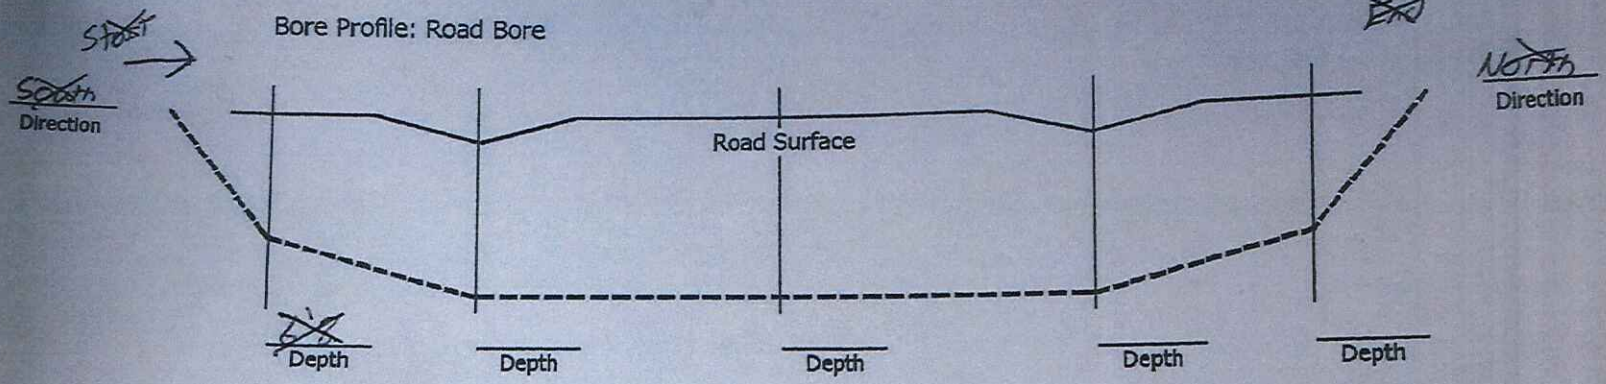

Between Hwy 50 & 78th St

Location: SM 8" STA# 1067+81

Bore Type: Wet Land

Contractor: Loembro

Pipe Size & Grade: 8" Steel

Length of Bore: 115 FT


Date: 7-29-13

Inspector: _____

Foreman: _____



Customer: _____

Kacey

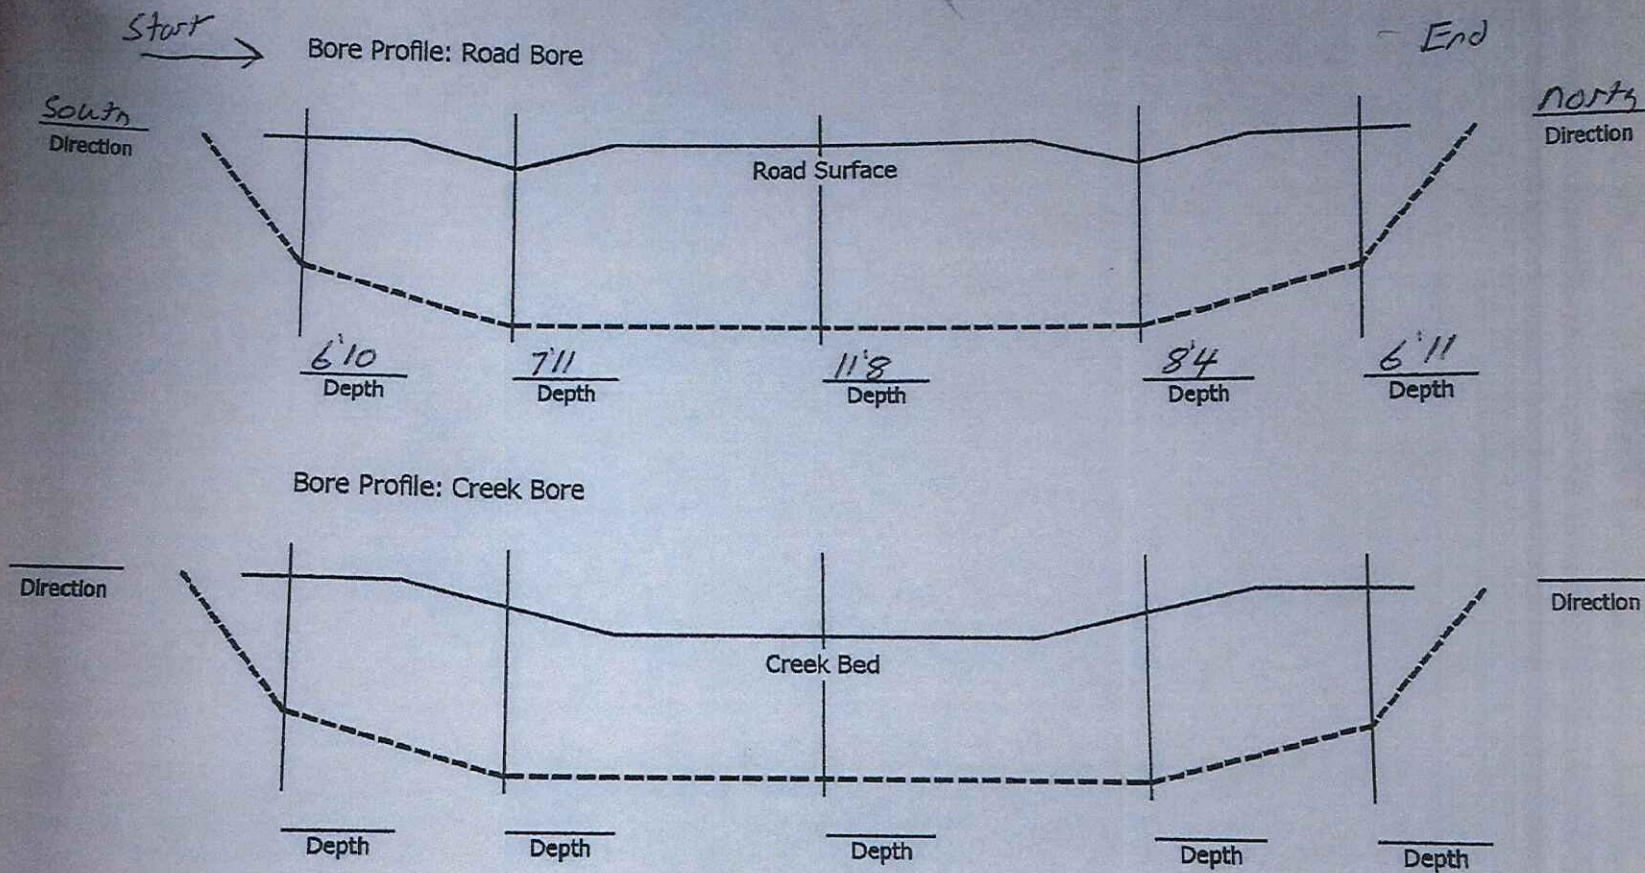



Location: SM 8' STA # 1116 + 83 ^{78th ST}
Bore Type: Road
Contractor: Loebro
Pipe Size & Grade: 8" Steel
Length of Bore: 150 Feet

Date: 7-29-13
Inspector: _____
Foreman: _____
Customer: _____

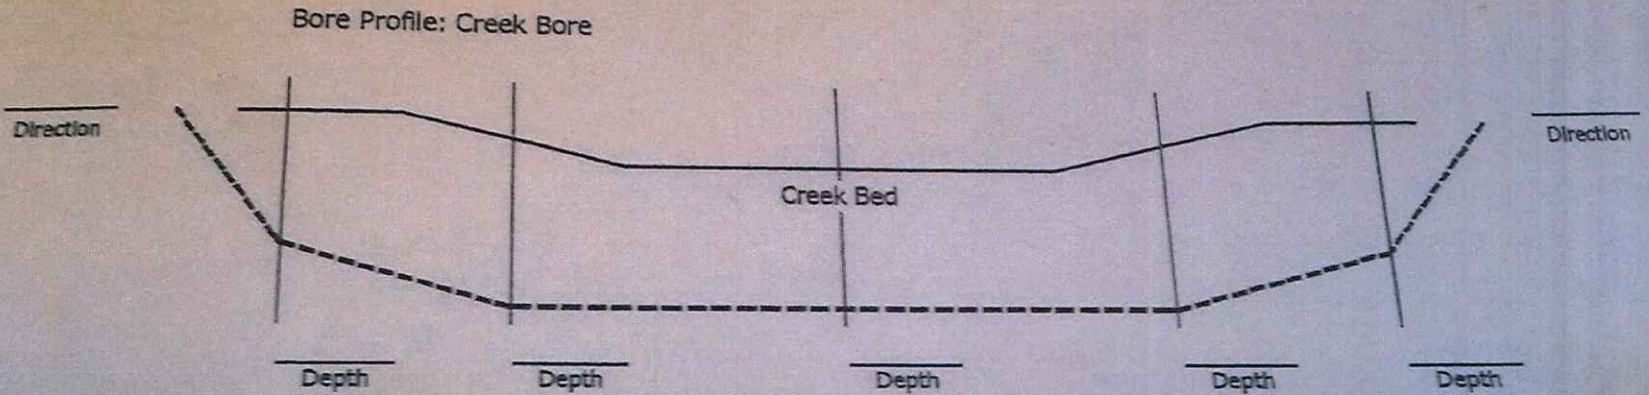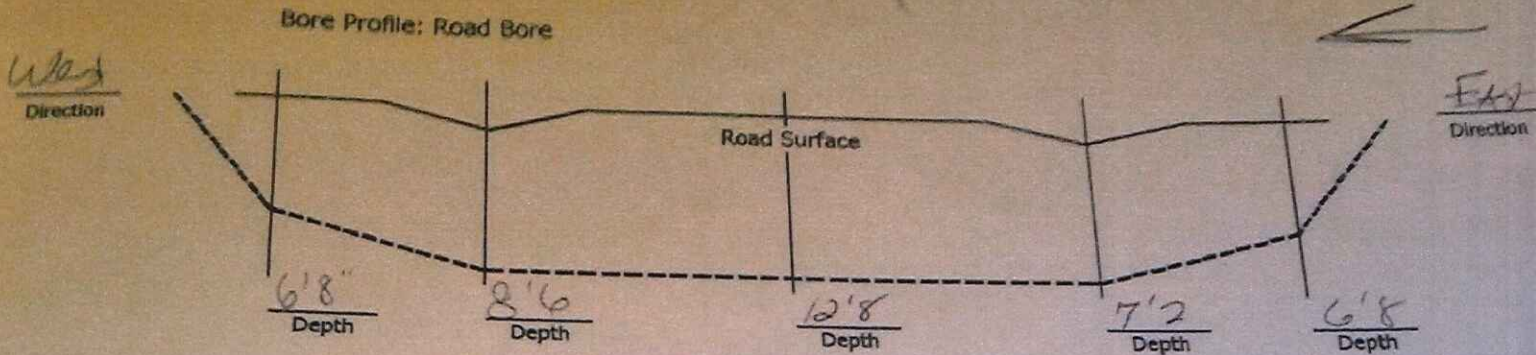

Location: 130 Ave NW 156+35
Bore Type: Wetland / Road
Contractor: LOENBO
Pipe Size & Grade: 8" Steel
Length of Bore: ~~450~~ 480'

Date: 7-27-
Inspector: _____
Foreman: Ryan Wang
Customer: _____

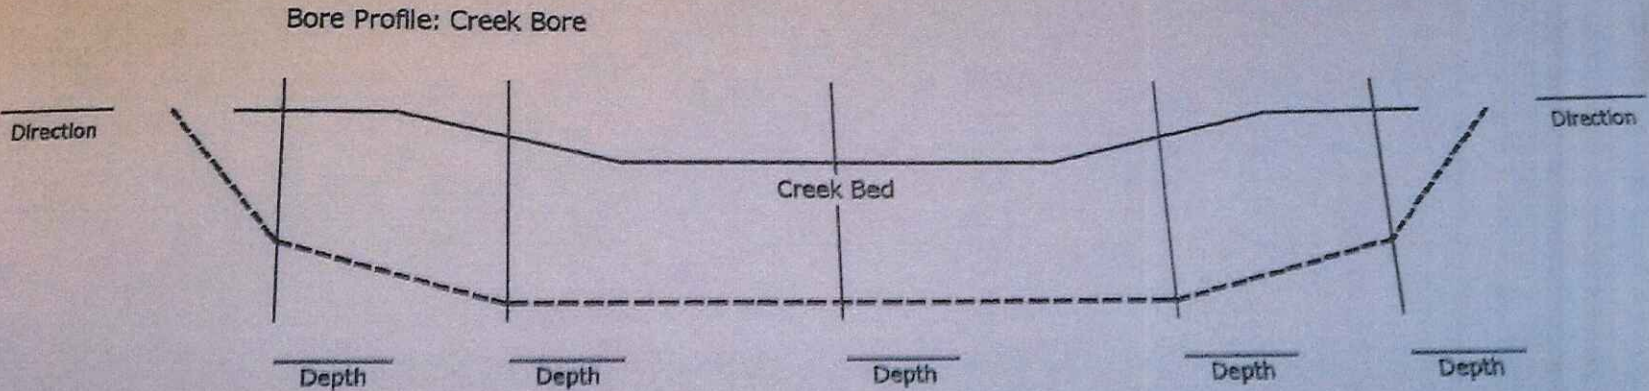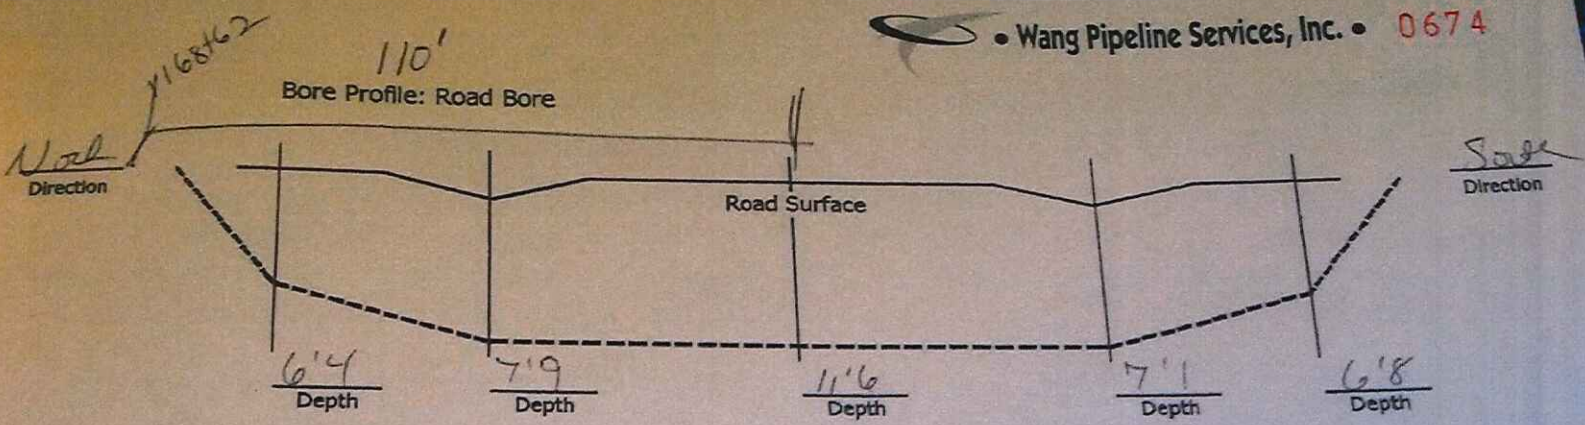

Location: 77th St NW 1168162

Bore Type: Road

Contractor: LOEN BRO

Pipe Size & Grade: 8" steel



Length of Bore: 206'

Date: 7-

Inspector: _____

Foreman: [Signature]

Customer: _____

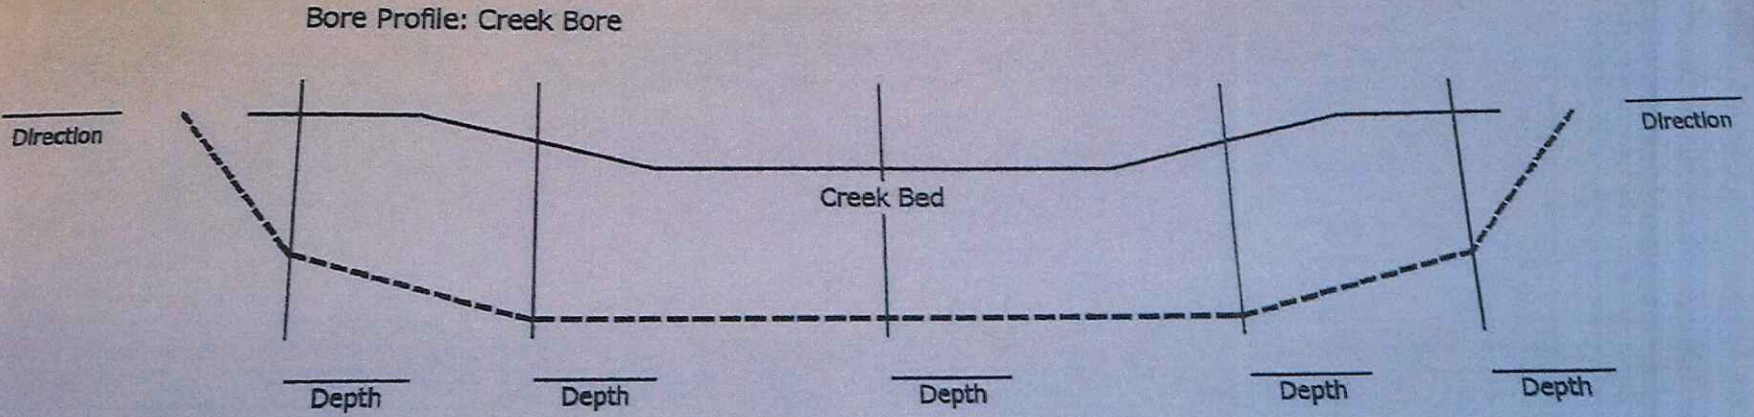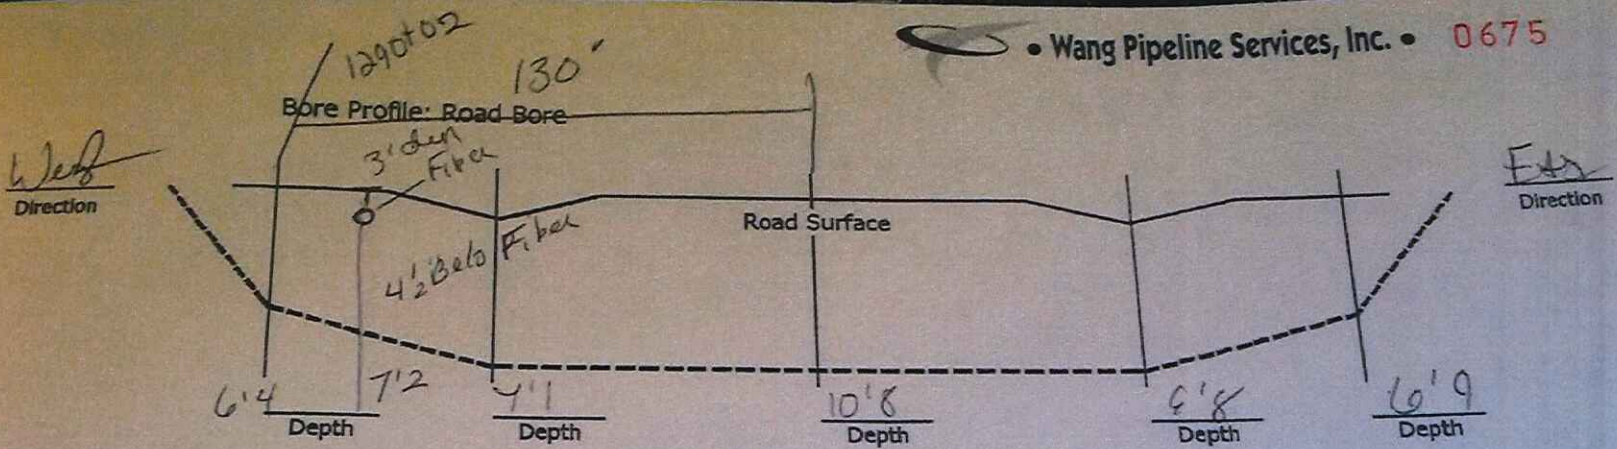

Location: CR-11 129th St# 1290+02

Bore Type: Road

Contractor: LOENBRO

Pipe Size & Grade 8" Steel

Length of Bore: 240'


Date: 7-

Inspector:


Foreman: [Signature]

Customer:

Bore Profile: Road Bore

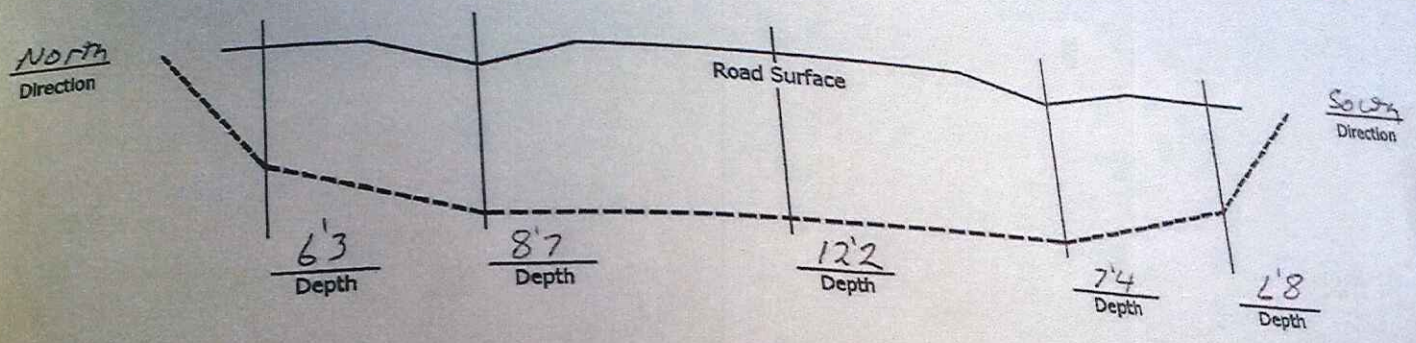

Bore Profile: Creek Bore

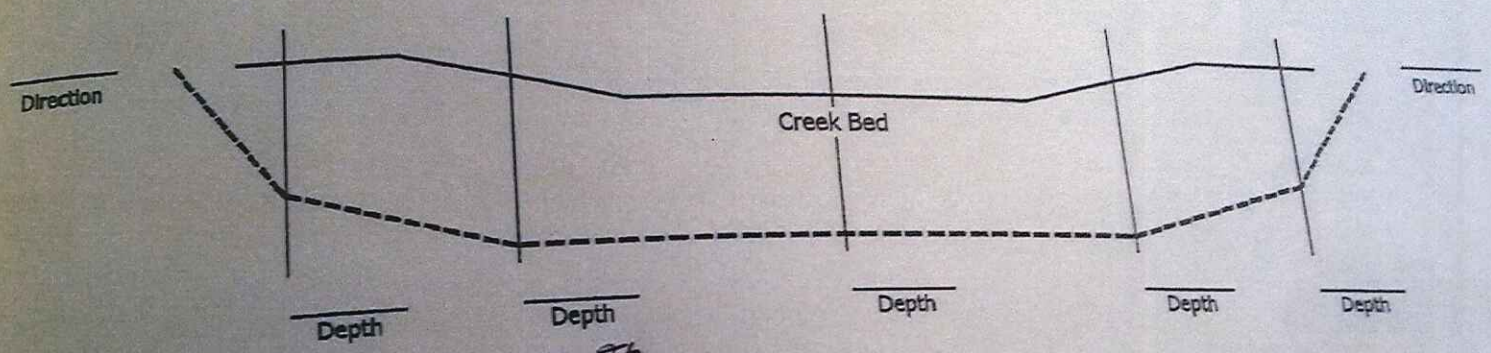


75TH
Location: SM 8" STA#1316+87
Bore Type: Road
Contractor: Loenbio
Pipe Size & Grade 8" Steel
Length of Bore: 150 FT

Date: 7/3/13
Inspector:
Foreman:
Customer:

APR 137025


North
Direction

Bore Profile: Road Bore 40

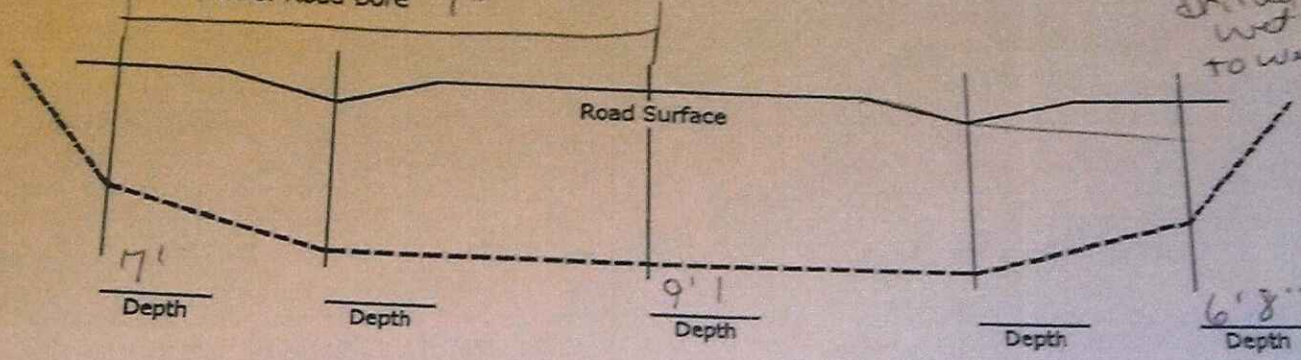

Drilled
wet spot
to west spot
South
Direction


Bore Profile: Creek Bore

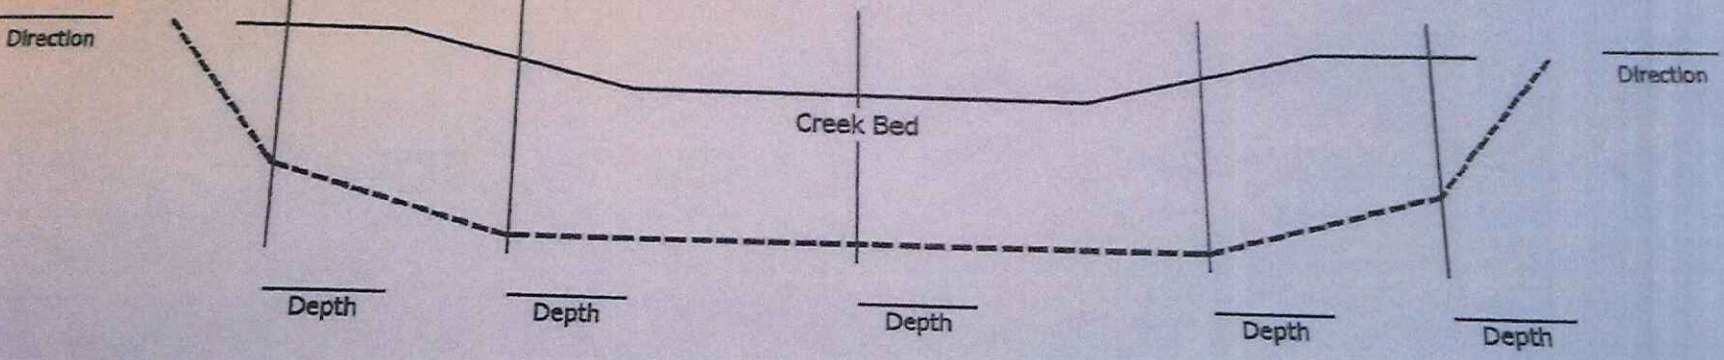


Location: 74th two track
 Bore Type: two track road
 Contractor: 20EN/BTD
 Pipe Size & Grade: 8" steel
 Length of Bore: 80'

Date: 8-1-2013
 Inspector: _____
 Foreman: [Signature]
 Customer: _____

Bore Profile: Road Bore

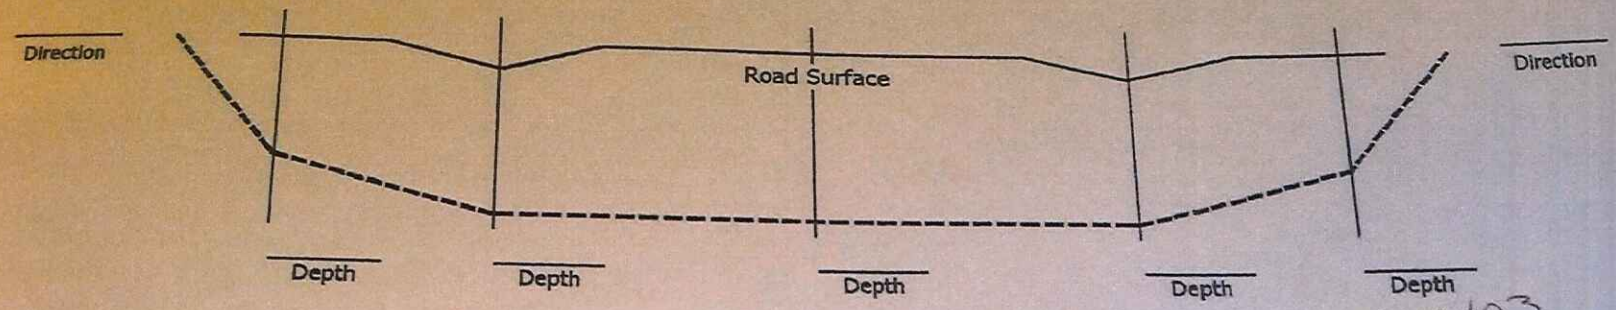


Bore Profile: Creek Bore

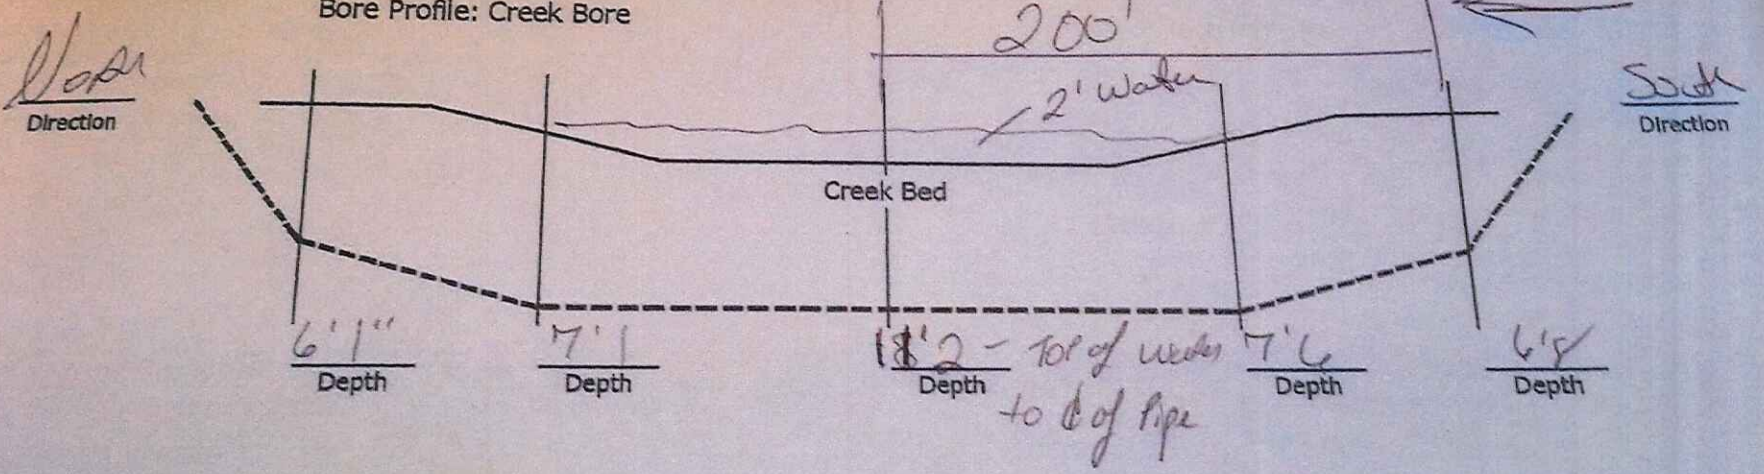

Location: 1413 + 03
 Bore Type: Wetland
 Contractor: Loen Bros
 Pipe Size & Grade: 8" Dtoel
 Length of Bore: 440

Date: 8-2-13
 Inspector: _____
 Foreman: Bye Jeff
 Customer: _____

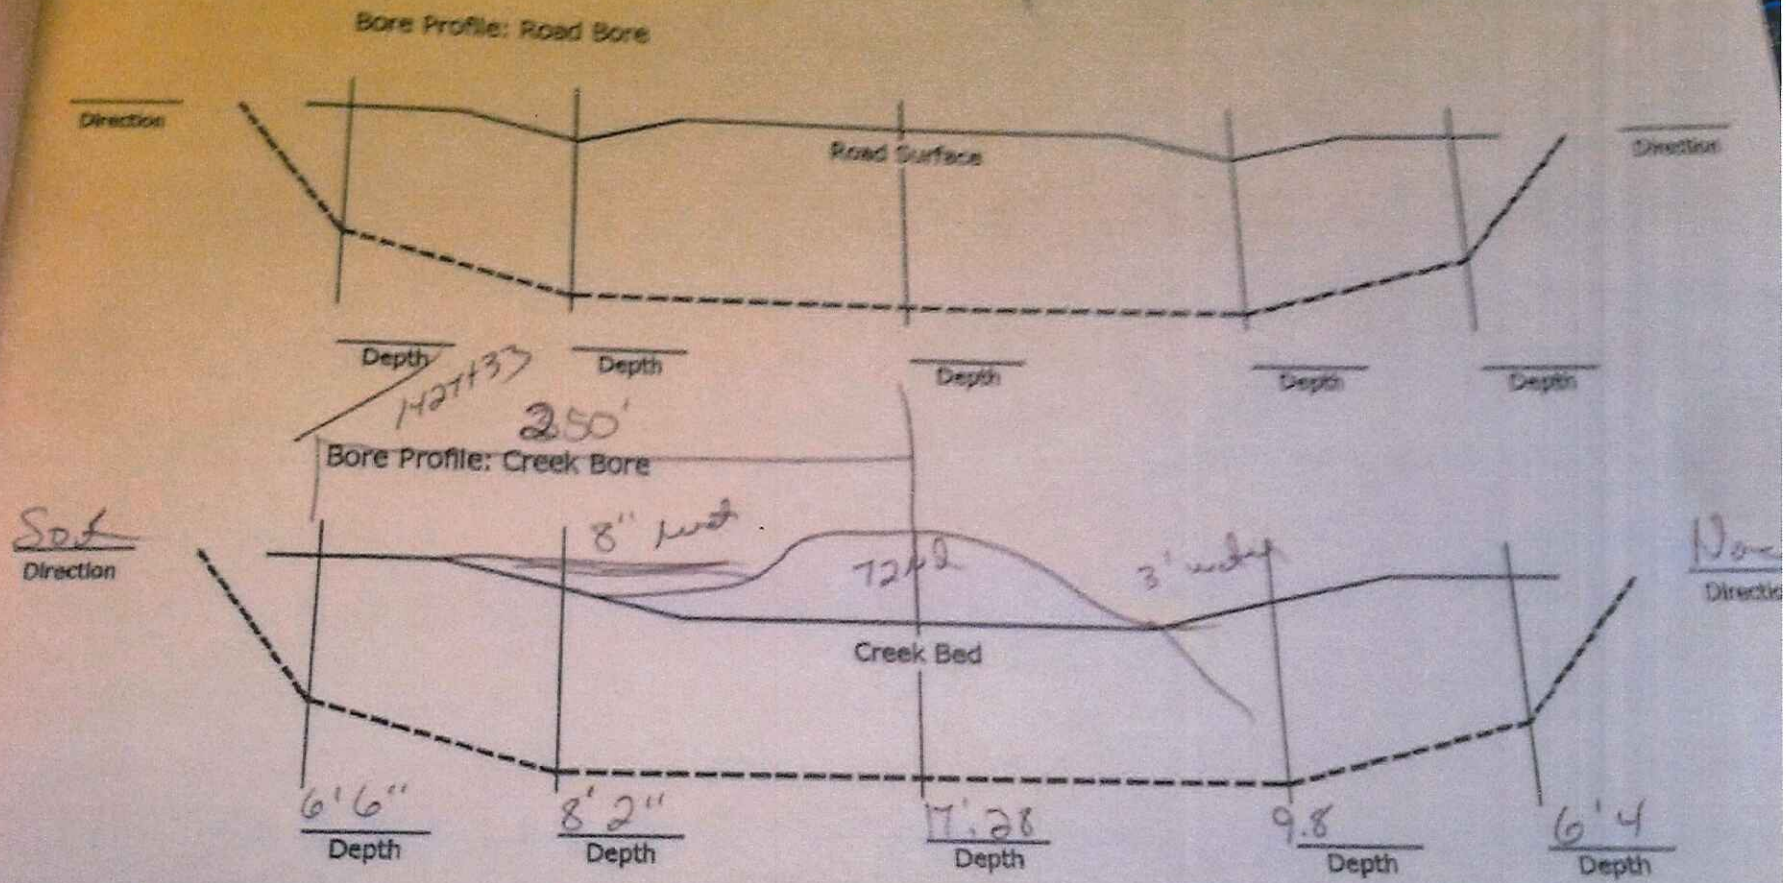

Location: 1427+33 7242 steel

Bore Type: Road Wetline

Contractor: Loenbro

Pipe Size & Grade 8" steel

Length of Bore: 600


Date: 8-3

Inspector:


Foreman: [Signature]

Customer:

Bore Profile: Road Bore


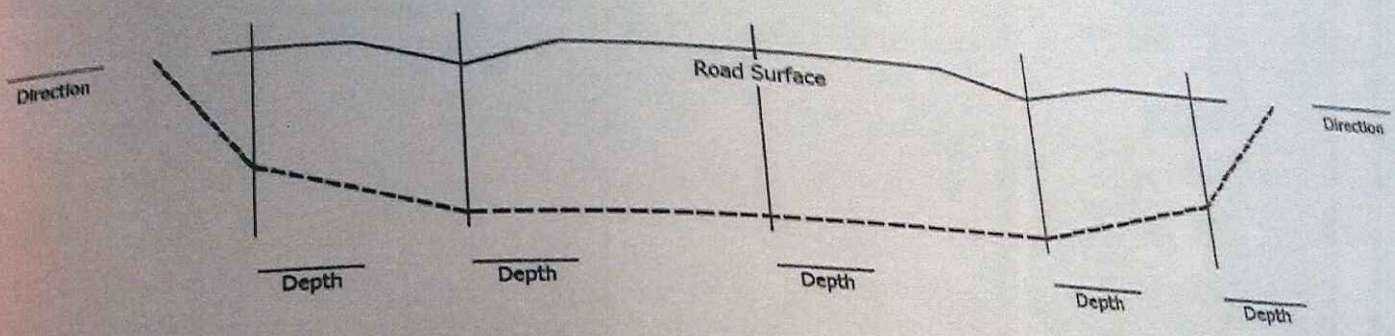


Bore Profile: Creek Bore

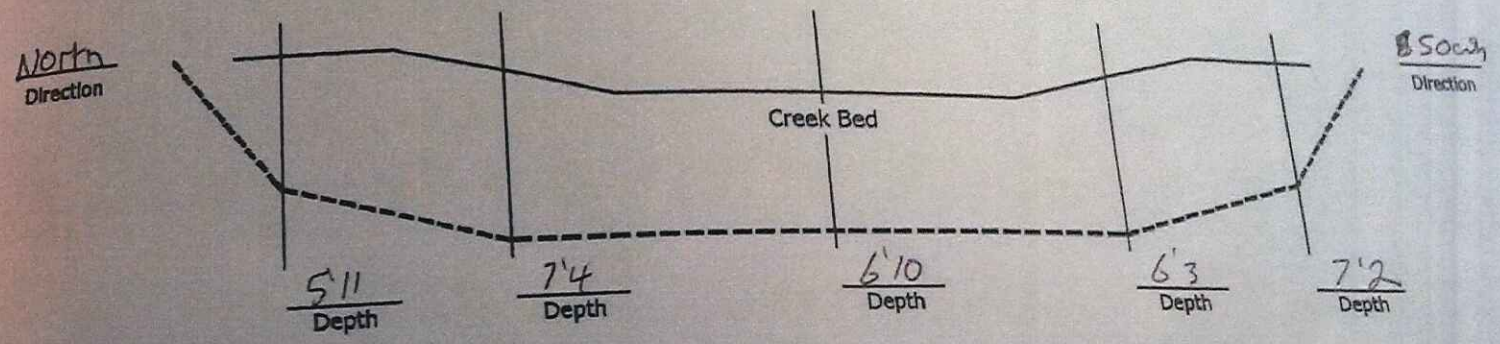

Location: SM 8" STA # 1476+33
Bore Type: Wet Land
Contractor: Loebio
Pipe Size & Grade 8" Steel
Length of Bore: 180 FT

Date: 8/1/13
Inspector: _____
Foreman: _____
Customer: _____

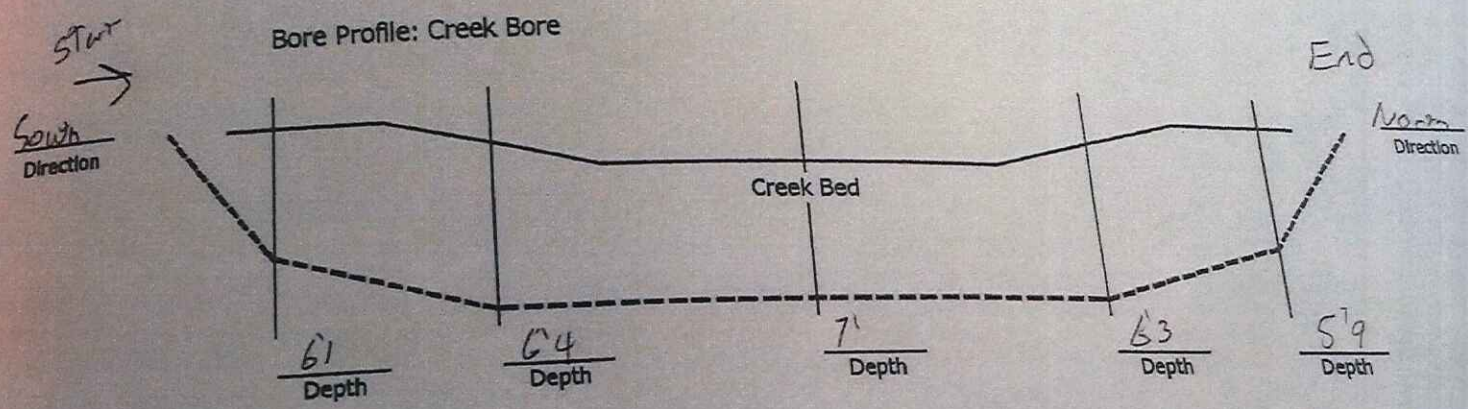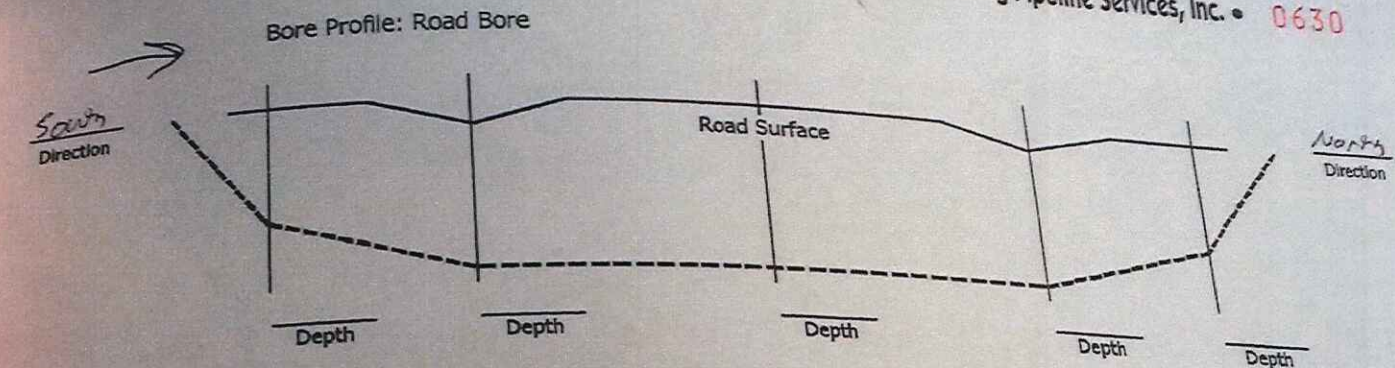

Location: ASM 8" STA 1490 +64

Bore Type: Wet Land

Contractor: Loenbro

Pipe Size & Grade 8" Steel

Length of Bore: 170 FT



Date: 8/2/13

Inspector: _____

Foreman: _____

Customer: _____

1501 + 32

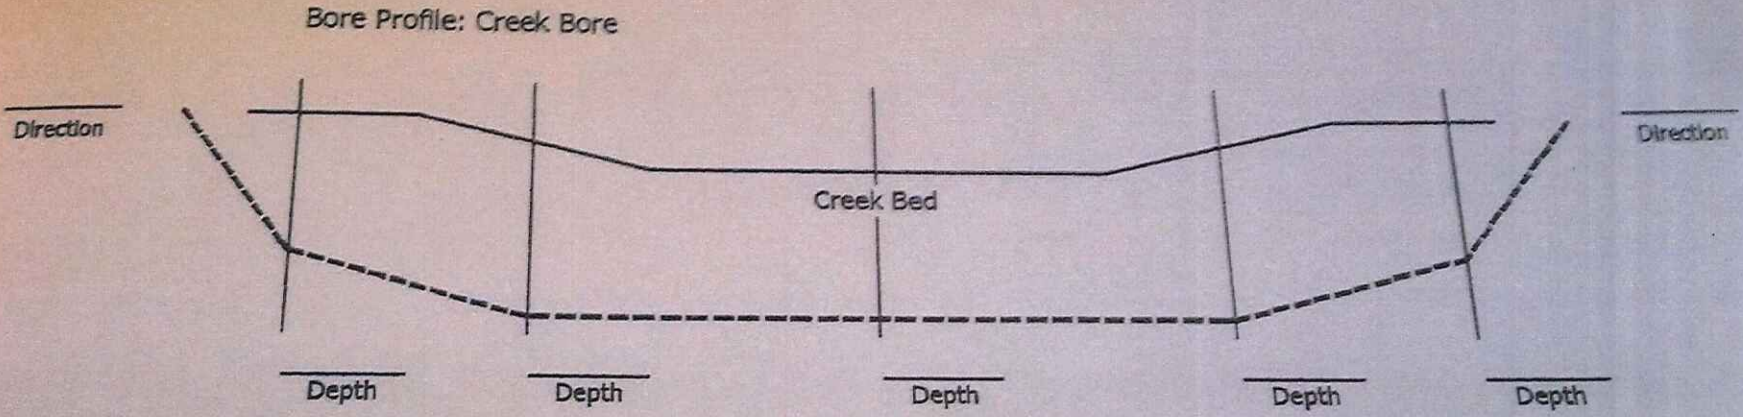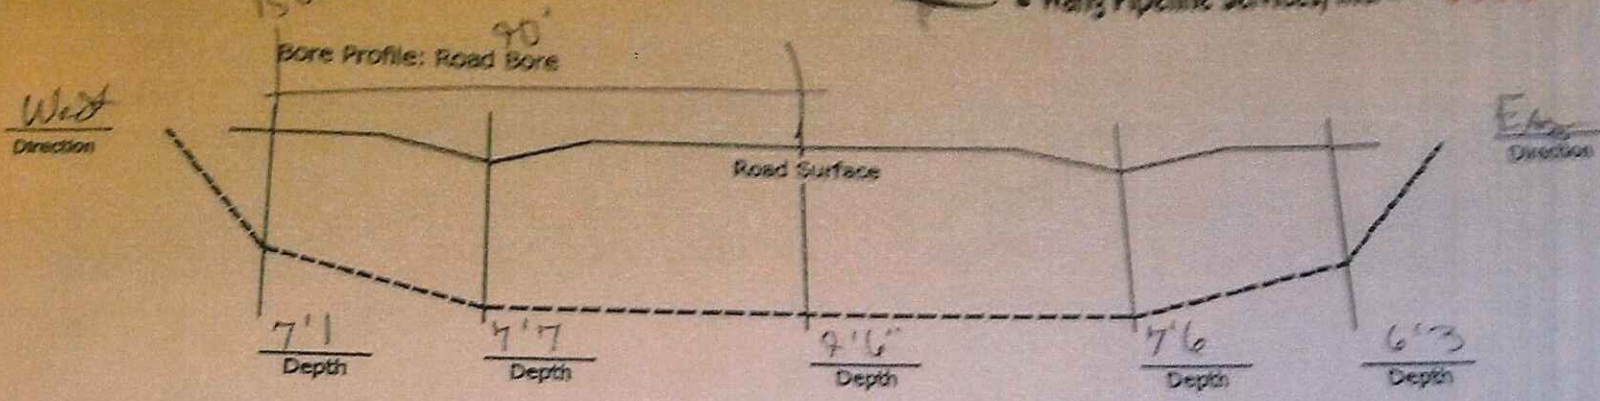

Location: 128th 1501 + 32

Bore Type: Road

Contractor: LOEUBAO

Pipe Size & Grade: 8" steel



Length of Bore: 166'

Date: 8-4

Inspector: _____

Foreman: [Signature]

Customer: _____

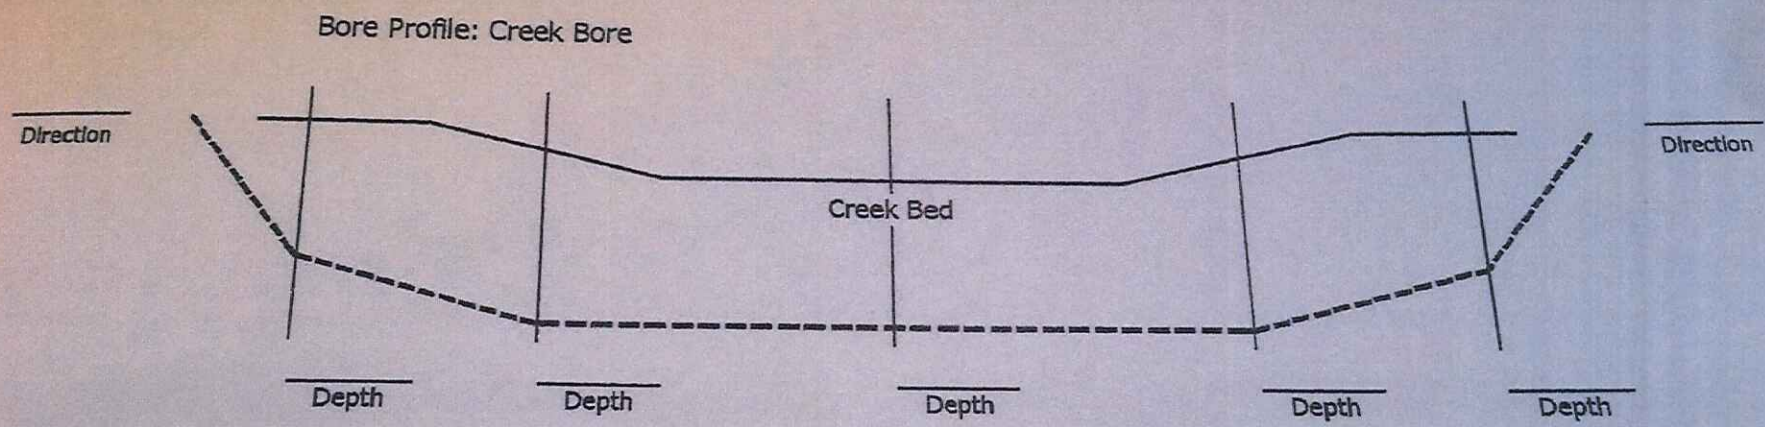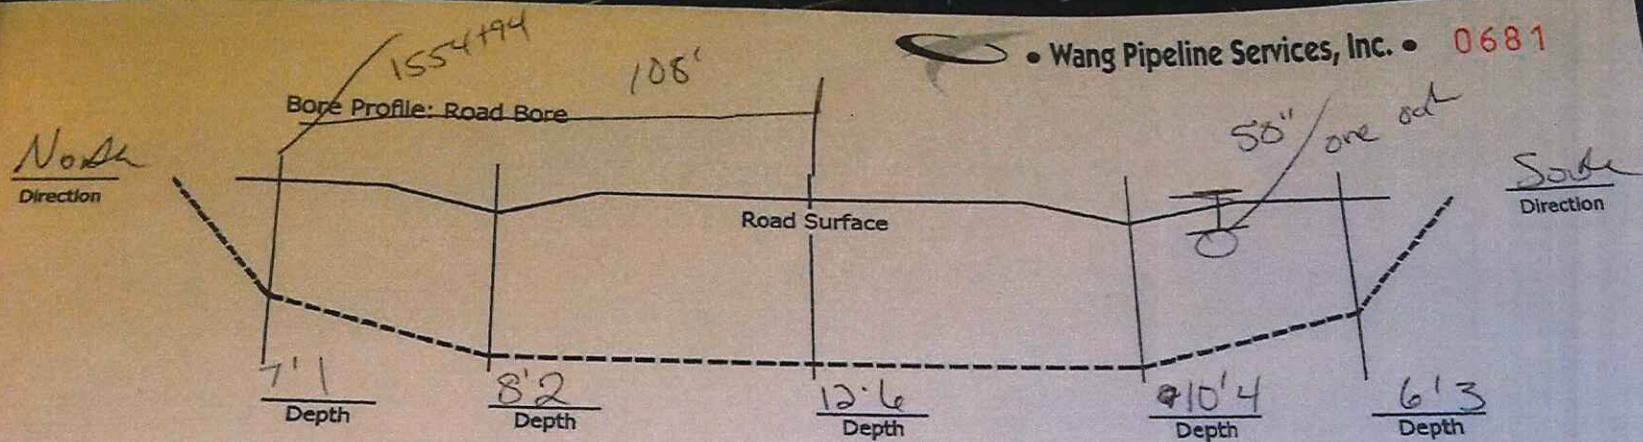

Location: 72nd Street

Bore Type: Road

Contractor: LOEN BO

Pipe Size & Grade: 8" steel



Length of Bore: 210

Date: 8-5

Inspector: _____

Foreman: [Signature]

Customer: _____

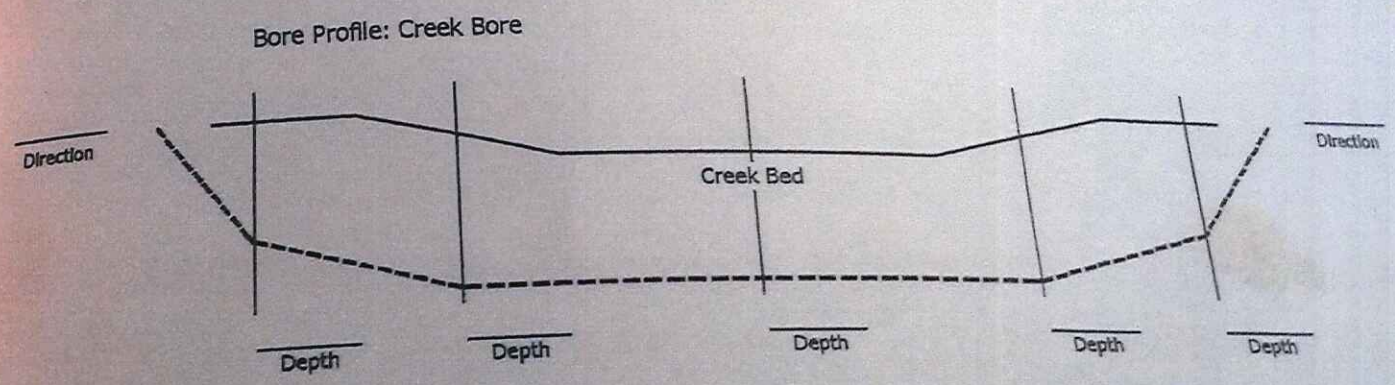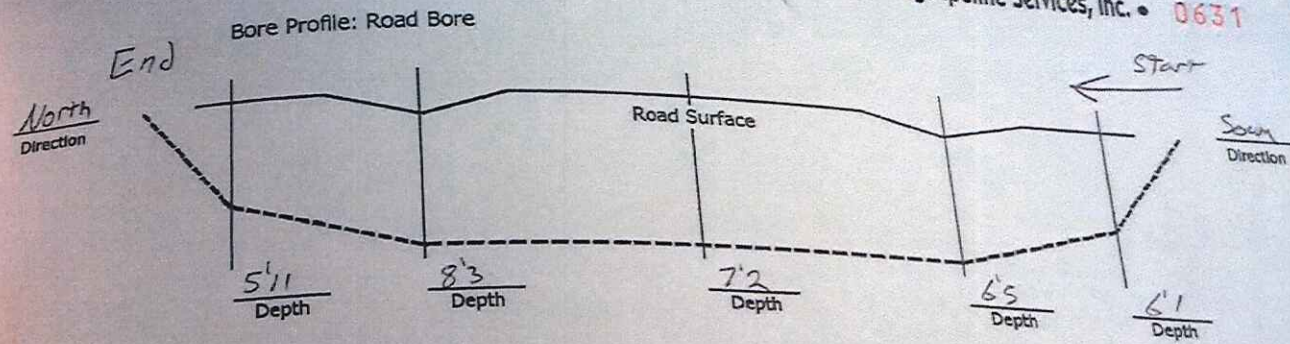

Location: SM 8" STA # 1581+50

Bore Type: Rock Pile

Contractor: Loembro

Pipe Size & Grade: 8" Steel

Length of Bore: 315

Date: 8/6/13

Inspector: _____

Foreman: _____

Customer: _____