


Data Source(s): World Imagery (Accessed 2015); Westwood (2015).


Westwood

Toll Free (888) 937-5150 westwoodps.com
Westwood Professional Services, Inc.

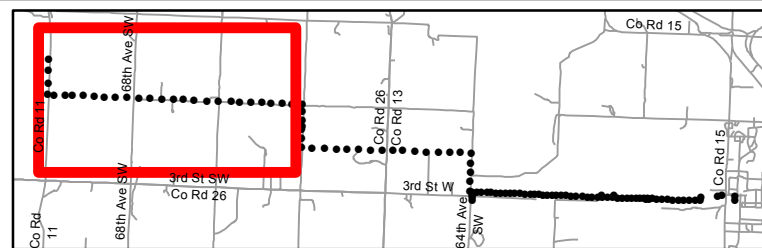

Legend

- Current Design T-line Structure
- PSC Approved T-line Structure
- Project Substation
- ▭ Gen-Tie Current Design 150ft Corridor (Solid Blue)
- ▭ Gen-Tie PSC Approved 150ft Corridor (Dashed)

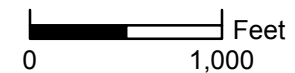

Antelope Hills

Mercer County, ND

Transmission Line Comparison

Page 1


July 20, 2015



Data Source(s): World Imagery (Accessed 2015); Westwood (2015).

Westwood

Toll Free (888) 937-5150 westwoodps.com
Westwood Professional Services, Inc.

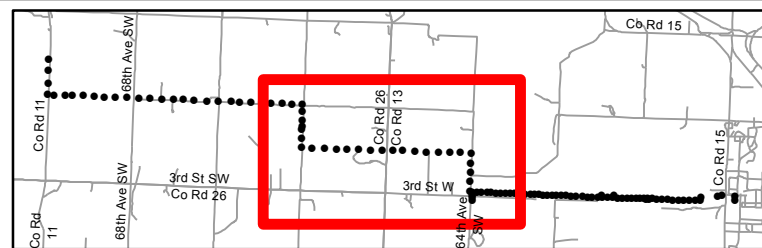

Legend


- Current Design T-line Structure
- PSC Approved T-line Structure
- Project Substation
- ▭ Gen-Tie Current Design 150ft Corridor (Solid Blue)
- ▭ Gen-Tie PSC Approved 150ft Corridor (Dashed)



Antelope Hills

Mercer County, ND


Transmission Line Comparison

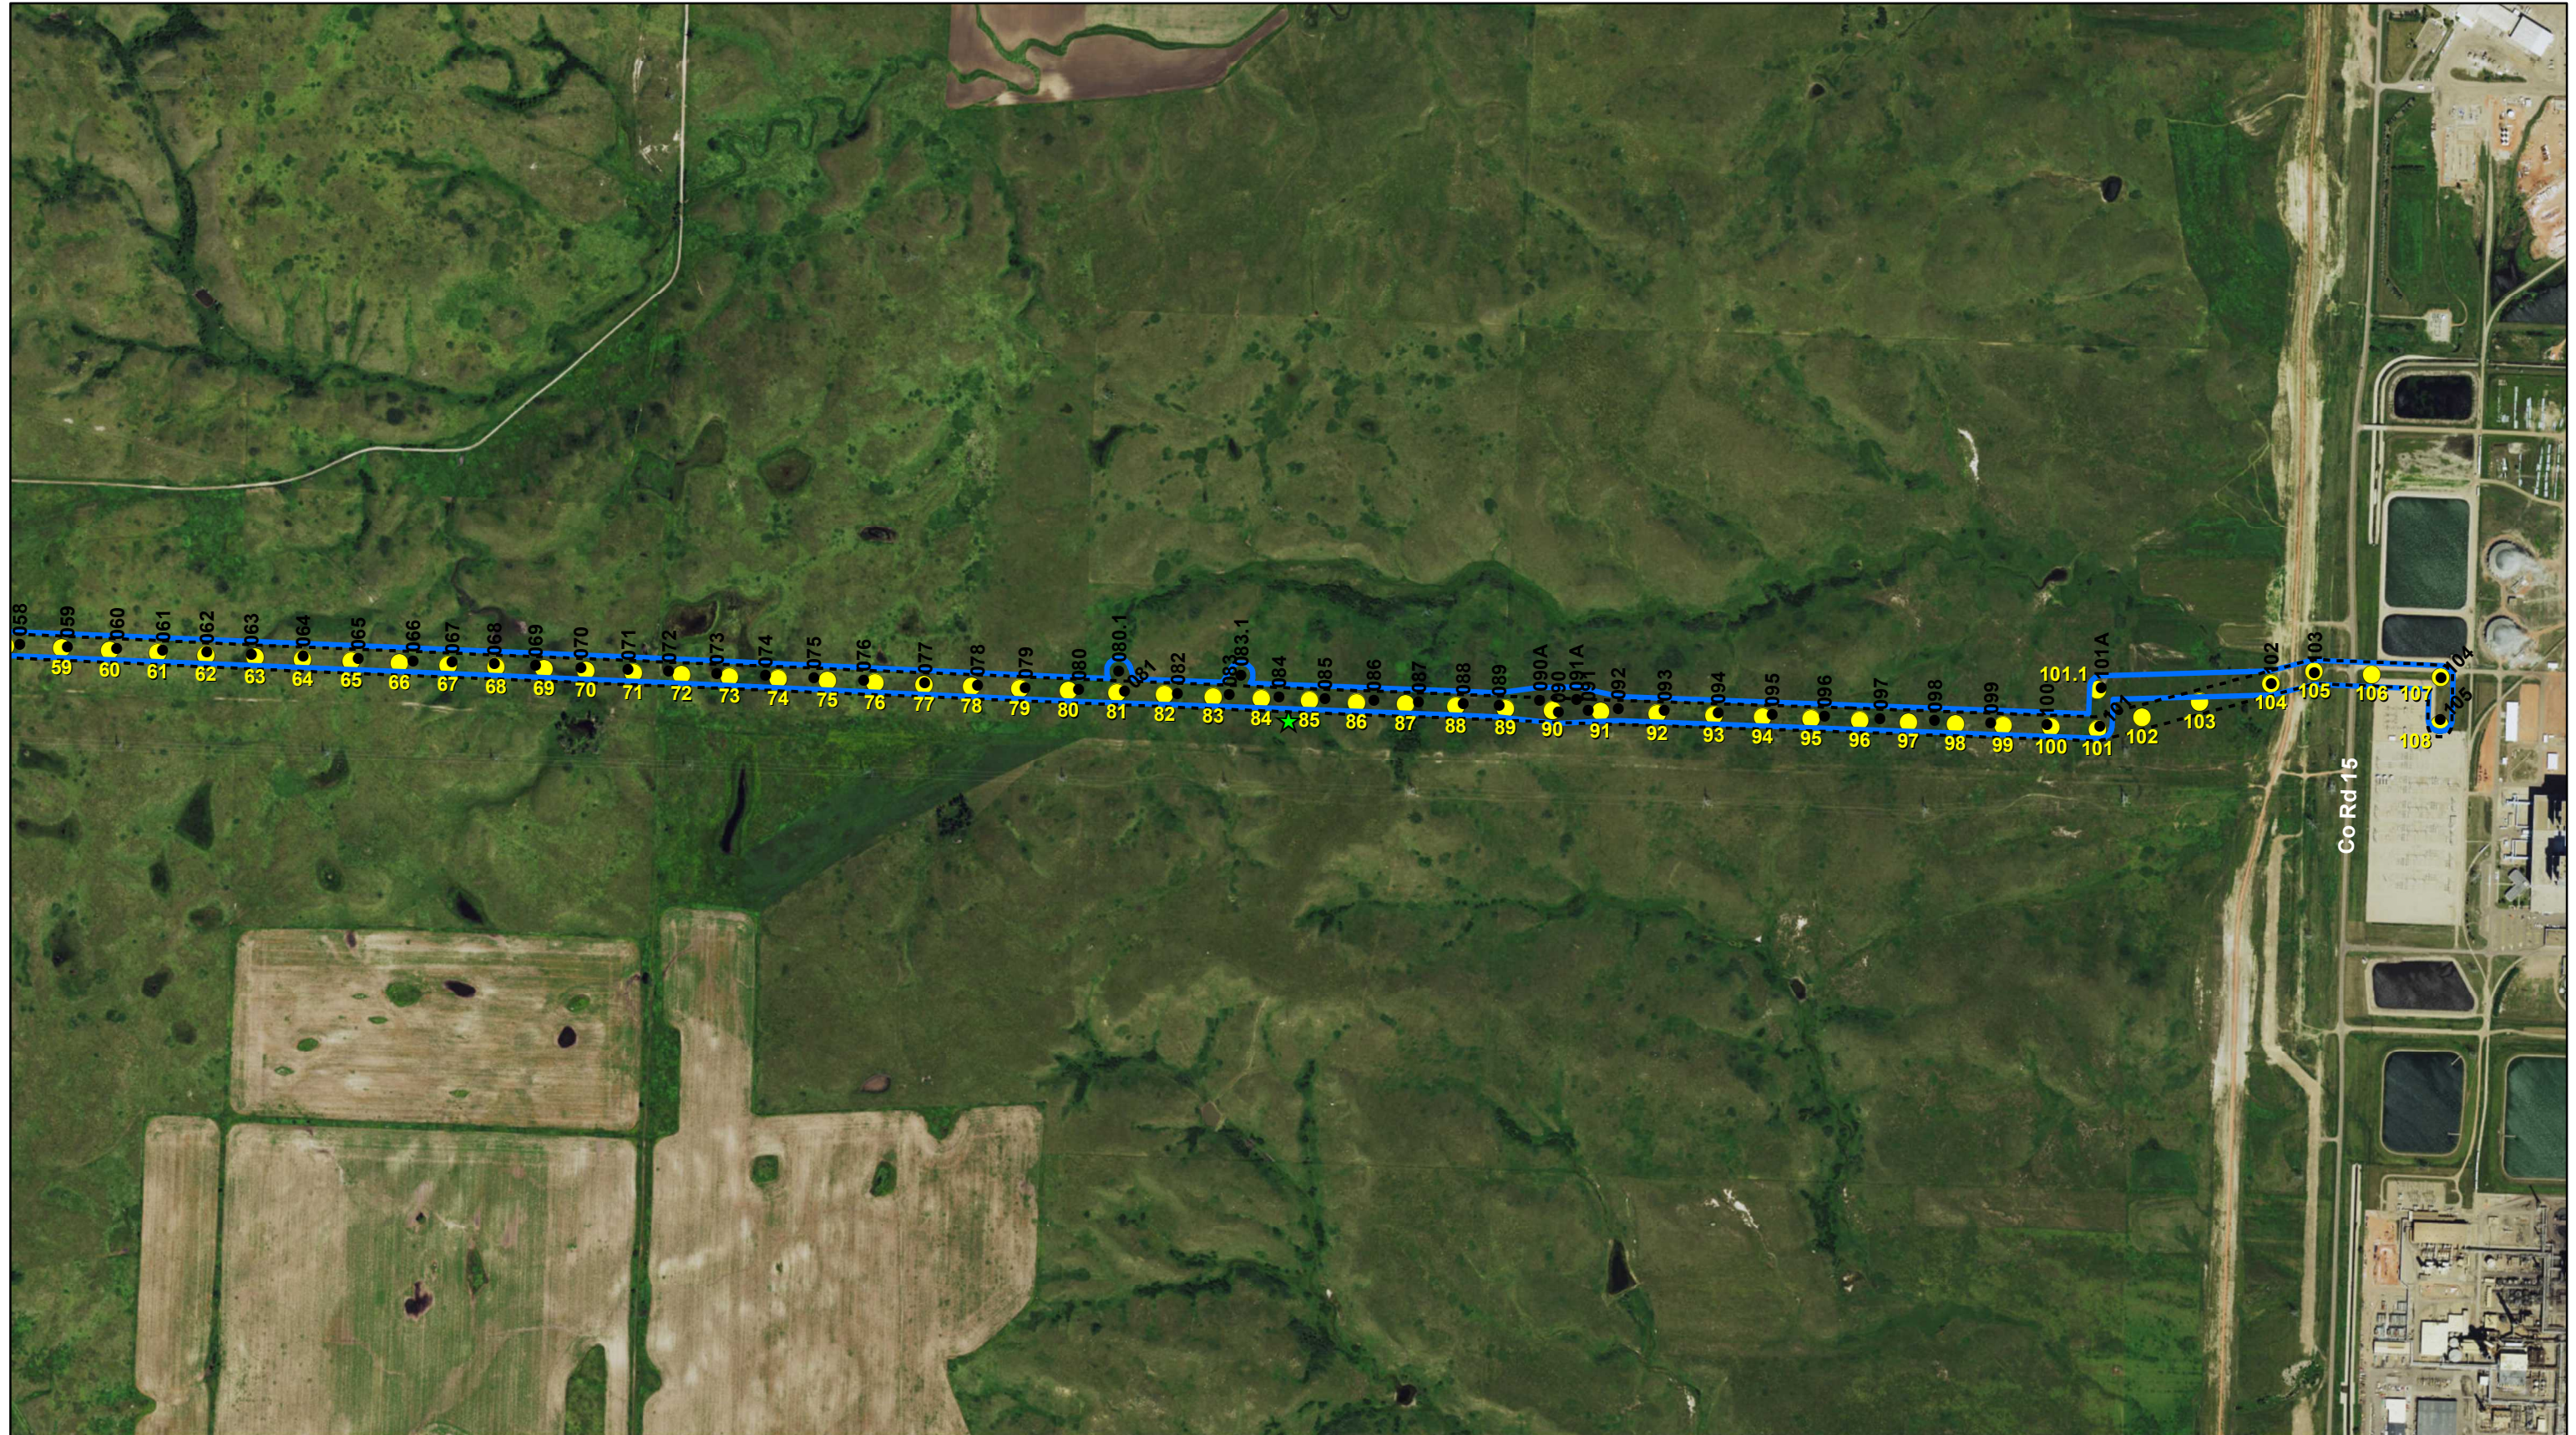

Data Source(s): World Imagery (Accessed 2015); Westwood (2015).


Westwood

Toll Free (888) 937-5150 westwoodps.com
Westwood Professional Services, Inc.

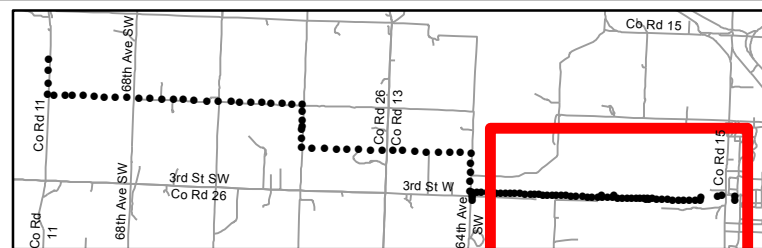

Legend

- Current Design T-line Structure
- PSC Approved T-line Structure
- Project Substation
- ▭ Gen-Tie Current Design 150ft Corridor (Solid Blue)
- ▭ Gen-Tie PSC Approved 150ft Corridor (Dashed)

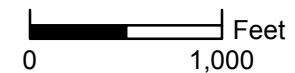

Antelope Hills

Mercer County, ND

Transmission Line Comparison

Page 3

July 20, 2015