

Hamre, John G.

From: Lein, Jerry R.
Sent: Monday, August 03, 2015 3:36 PM
To: Jeremy Miller (jmiller1@sunedison.com) (jmiller1@sunedison.com)
Cc: Hamre, John G.; -Info-Public Service Commission
Subject: Re: Antelope Hills Transmission Line
Attachments: AH_TLineComparison_11x17_150720.pdf

Dear Mr. Miller:

Please consider this email as commission staff approval of the attached transmission line structure relocations as requested below, Case No. PU-14-678. Thanks.

Jerry Lein
701 328-1035

From: Jeremy Miller [<mailto:jmiller1@sunedison.com>]
Sent: Monday, July 20, 2015 5:21 PM
To: Lein, Jerry R.
Subject: Antelope Hills Transmission Line

Hi Jerry,

Pursuant to our discussion and meeting a few weeks ago, please find attached the transmission line exhibit that depicts the proposed pole locations within the transmission corridor compared to the PSC approved pole locations. As we discussed, the route has not changed, just the pole locations within the route itself. Please let me know if you have any questions or would like to further discuss the changes.

Thanks,

Jeremy Miller
Development Manager

Phone: (949) 243-6456
Email: jmiller1@sunedison.com

SunEdison
600 Clipper Drive
Belmont, CA 94002
www.sunedison.com


Confidentiality Statement of SunEdison and its subsidiaries: The contents of this message, together with any attachments, are intended only for the use of the individual or entity to which they are addressed and may contain information that is legally privileged and confidential. If you are not the intended recipient, you are hereby notified that any dissemination, distribution, or copying of this message, or any attachment, is strictly prohibited. If you have received this message in error, please notify the original sender and delete this message, along with any attachments, from your computer. No Contract: Regardless of content, this email shall not operate to order or contract unless pursuant to a written agreement signed by the use of email for such purpose.

48 **PU-14-678** Filed: 8/3/2015 Pages: 5
E-mail staff approval of transmission line structure relocations request

Public Service Commission Staff


Jerry Lein

This transmission, email and any files transmitted with it, may be: (1) subject to the Attorney-Client Privilege, (2) an attorney work product, or (3) strictly confidential under federal or state law. If you are not the intended recipient of this message, you may not use, disclose, print, copy or disseminate this information. If you have received this transmission in error, notify the sender (only) and delete the message. This message may also be subject to disclosure under the North Dakota Open Records Laws.

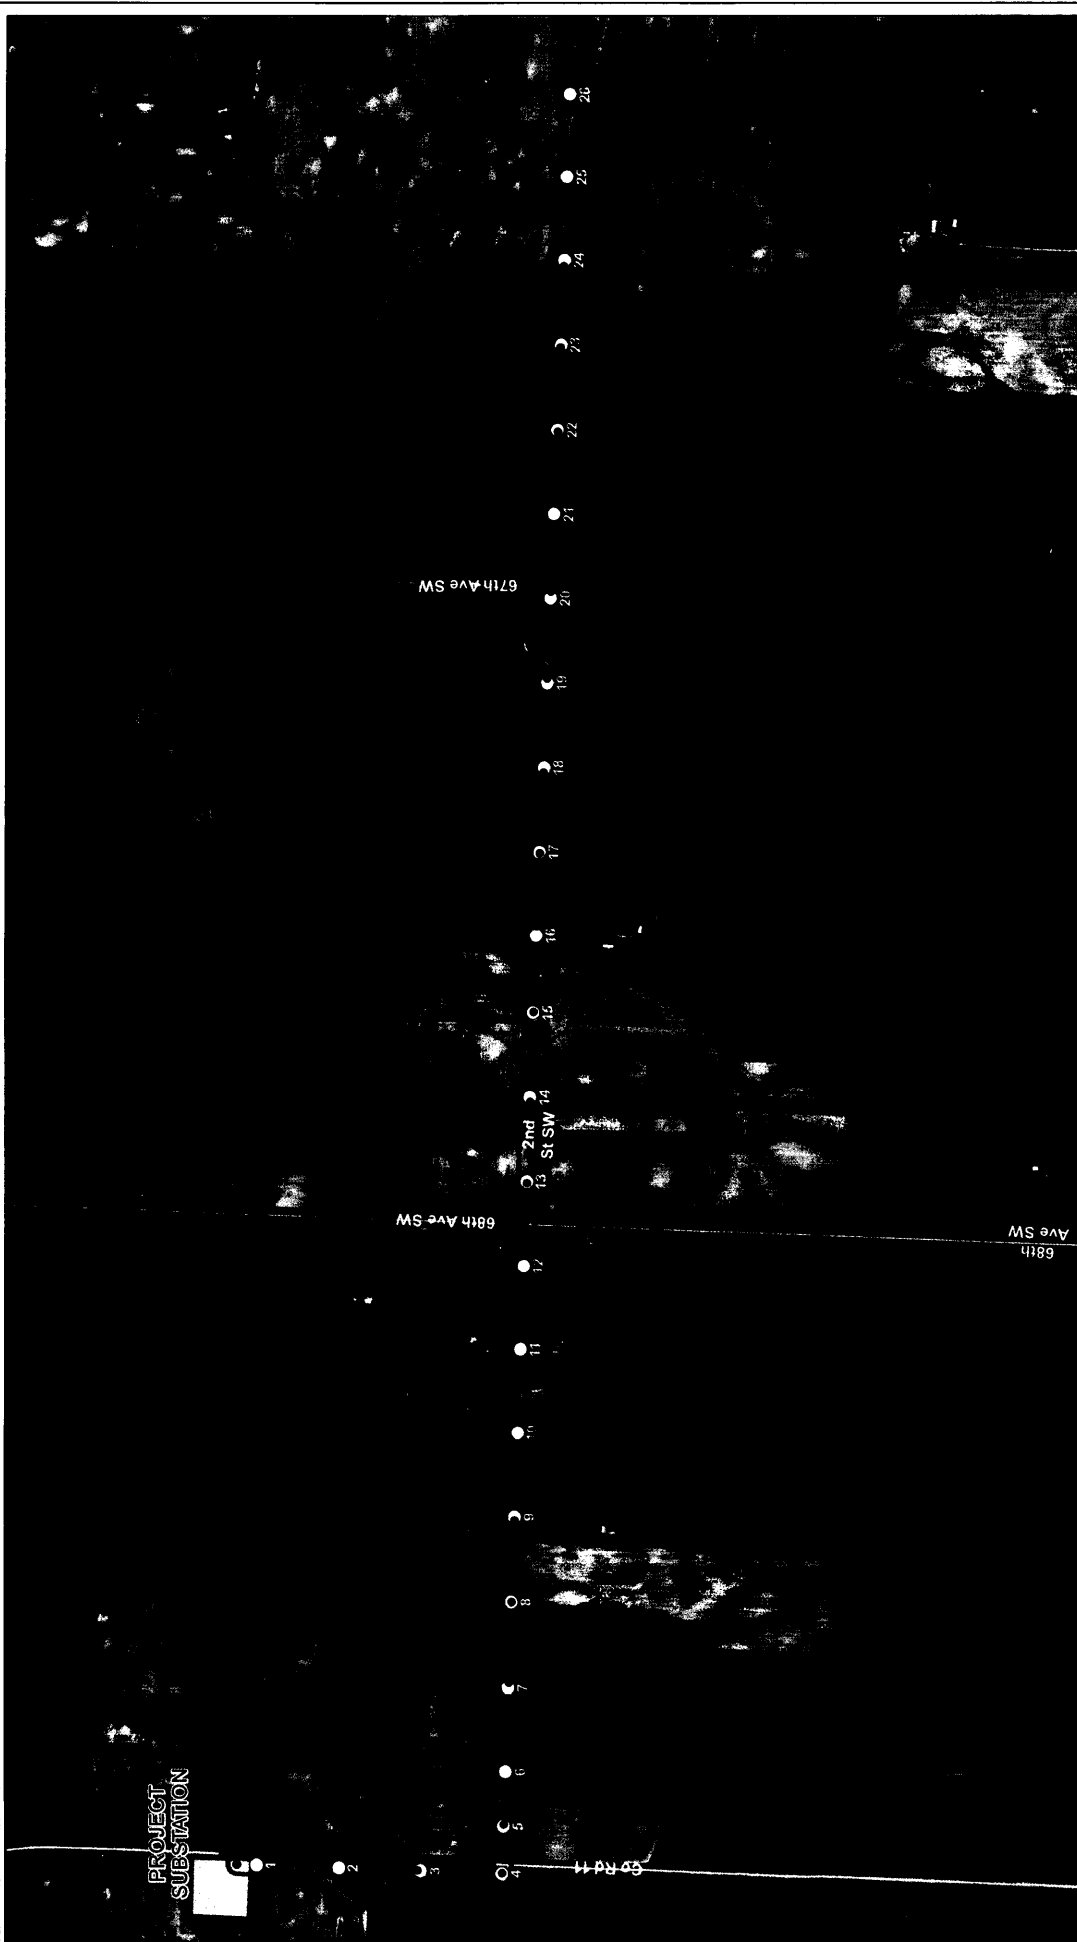


Westwood
 Toll Free (888) 937-6150 westwoodps.com
 Westwood Professional Services, Inc.

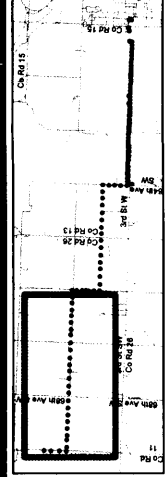

Legend

- Current Design T-line Structure
- PSC-Approved T-line Structure
- Project Substation
- Gen-Tie Current Design 150ft Corridor (Solid Blue)
- Gen-Tie PSC Approved 150ft Corridor (Dashed)














Date: 7/20/2015 4:58:35 PM

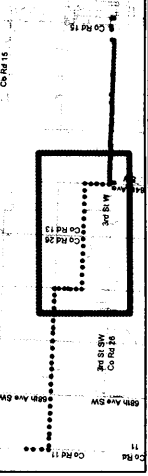

Legend


- Current Design T-line Structure
- PSC-Approved T-line Structure
- Project Substation
- Gen-Tie Current Design 150ft Corridor (Solid Blue)
- Gen-Tie PSC Approved 150ft Corridor (Dashed)



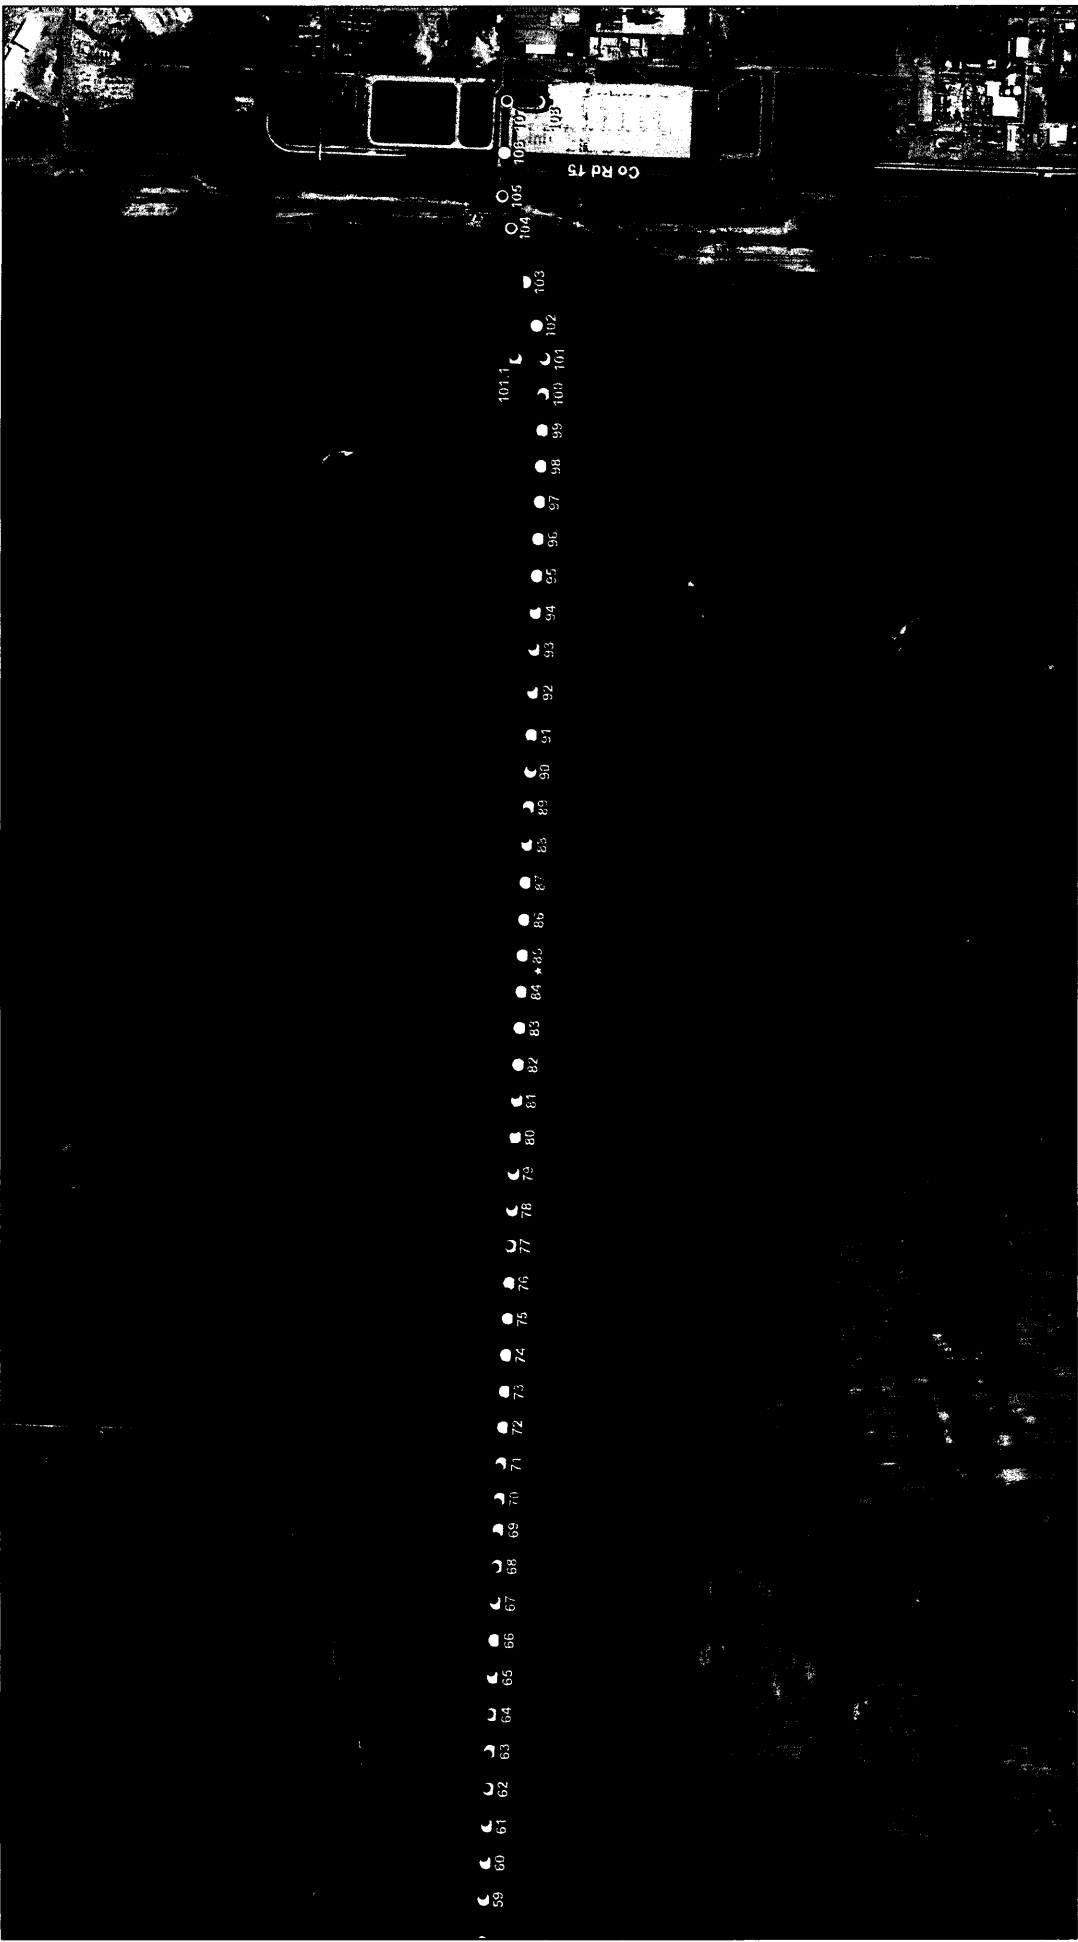

Data Source(s): World Imagery (Acquired 2015), Westwood (2015).

Westwood
 Toll Free (888) 937-5150 westwoodps.com
 Westwood Professional Services, Inc.

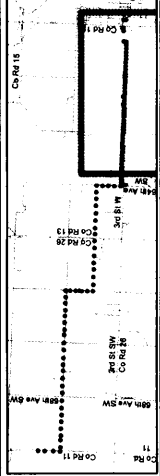

Legend

- Current Design T-line Structure
- PSC-Approved T-line Structure
- Project Substation
- Gen-Tie Current Design 150ft Corridor (Solid Blue)
- Gen-Tie PSC Approved 150ft Corridor (Dashed)

