

Brian R. Bjella
100 West Broadway, Suite 250
P.O. Box 2798
Bismarck, ND 58502-2798
701.223.6585
bbjella@crowleyfleck.com

November 19, 2014

Mr. Darrell Nitschke
Executive Director
NORTH DAKOTA PUBLIC
SERVICE COMMISSION
600 E. Boulevard Avenue, Dept. 408
Bismarck, ND 58505-0480



Dear Mr. Nitschke:

In re: Antelope Hills Wind Project, LLC
Antelope Hills Wind Energy Project
Mercer County, North Dakota
Case No. PU-14-679

Enclosed for filing is one copy of Late Filed Exhibit No. 6, which is the revised project area for the Antelope Hills Wind Energy Project.

Please call should you have any questions.


Very truly yours,

A handwritten signature in blue ink, appearing to read "BRB".

BRIAN R. BJELLA

bw
Enc.

P:\GIS_PROJECTS\Infinity_Wind_Power\AntelopeHills_Wind\MapXDoc\CSC\Exhibit_5_Gliffinity_Exhibits_Revised_ProjectArea_17111_20141030.mxd - Last Saved 10/30/2014

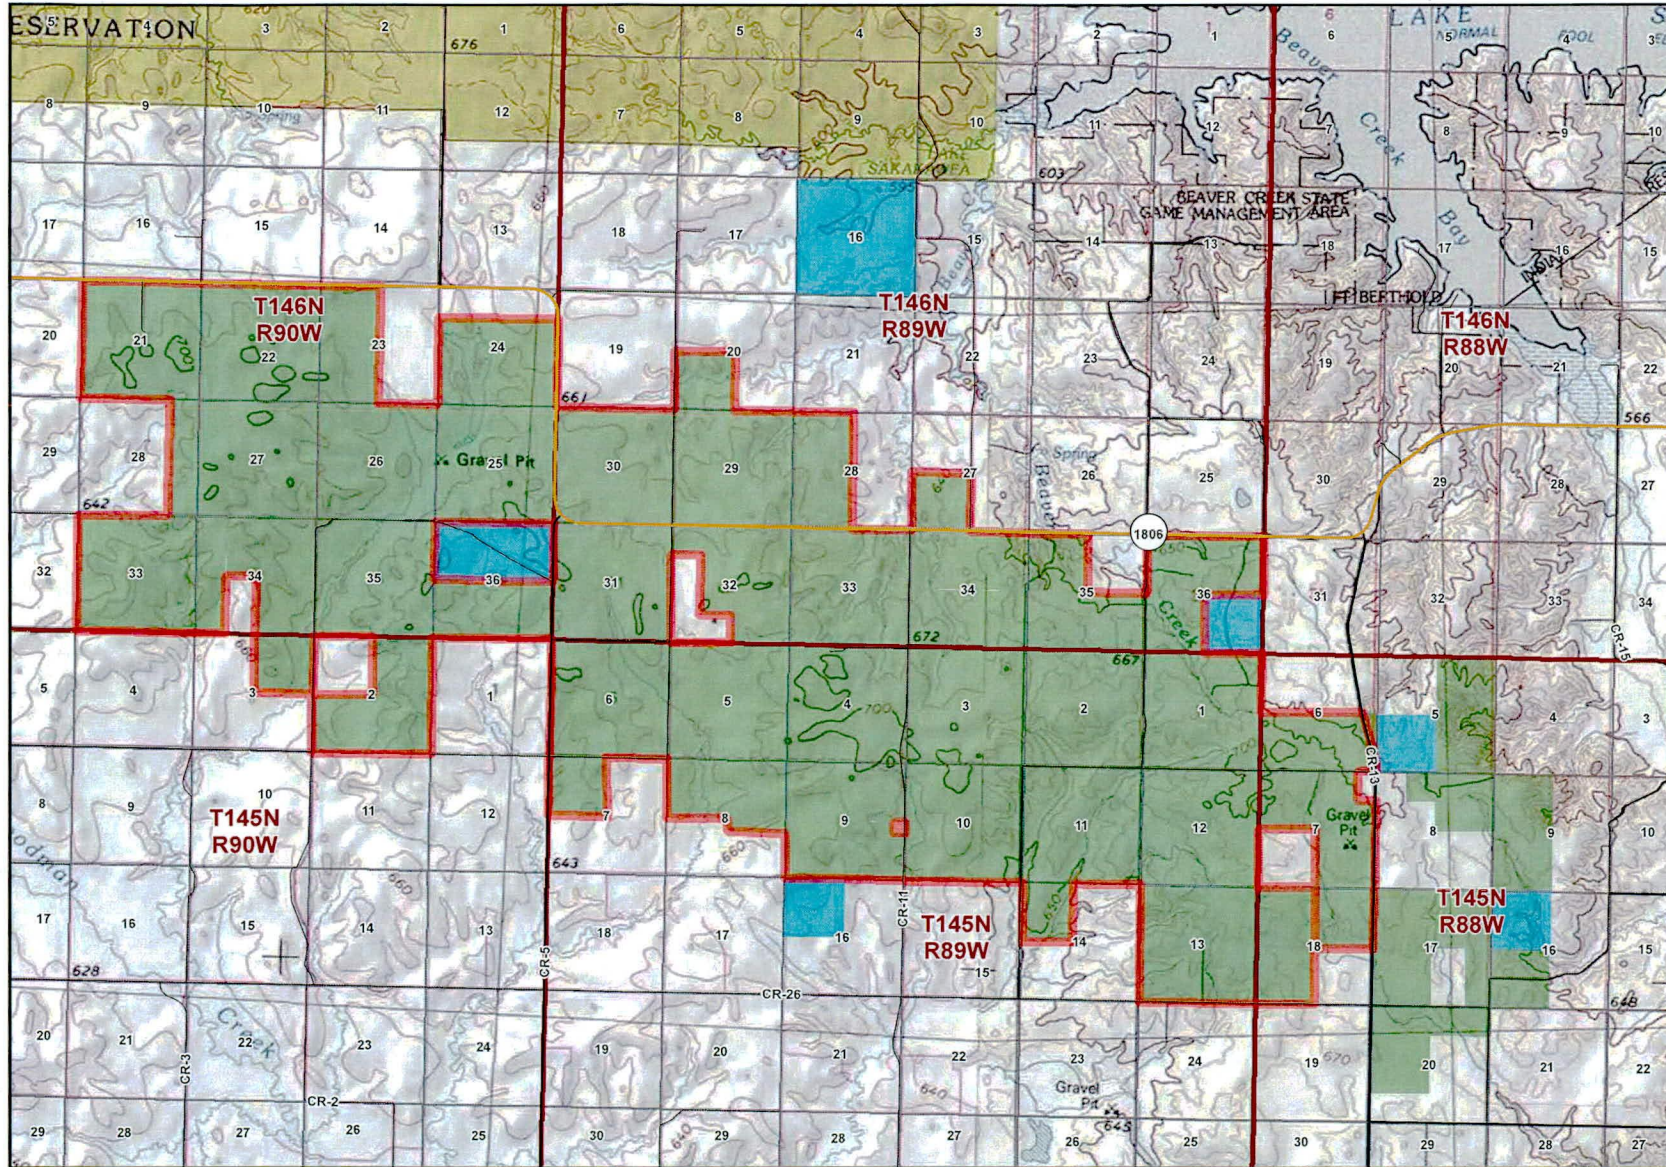


Antelope Hills Wind Project
Application for North Dakota
Certificate of
Site Compatibility

Exhibit 6
Project Area
Participating Landowners by
Township, Range and Section

Mercer County, ND
October 30, 2014

- Updated Project Boundary
- Participating Landowner
- State Land
- Township/Range
- Section
- State Highway
- County Major Collector Road
- Other County Road

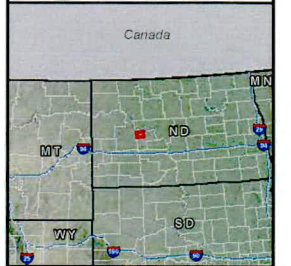

1:65,000 NAD_1983_StatePlane_North_Dakota_South_FIPS_3302_Feet 0 2 4 Miles